
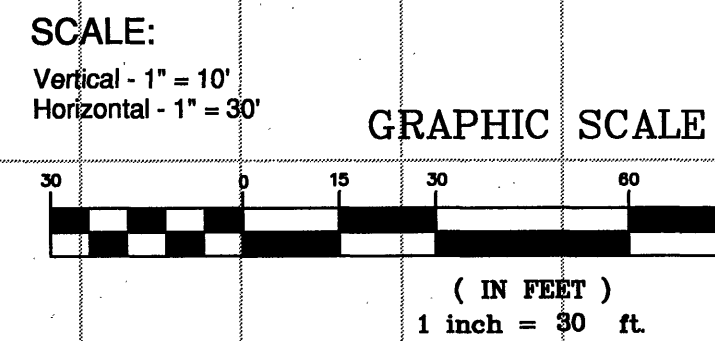
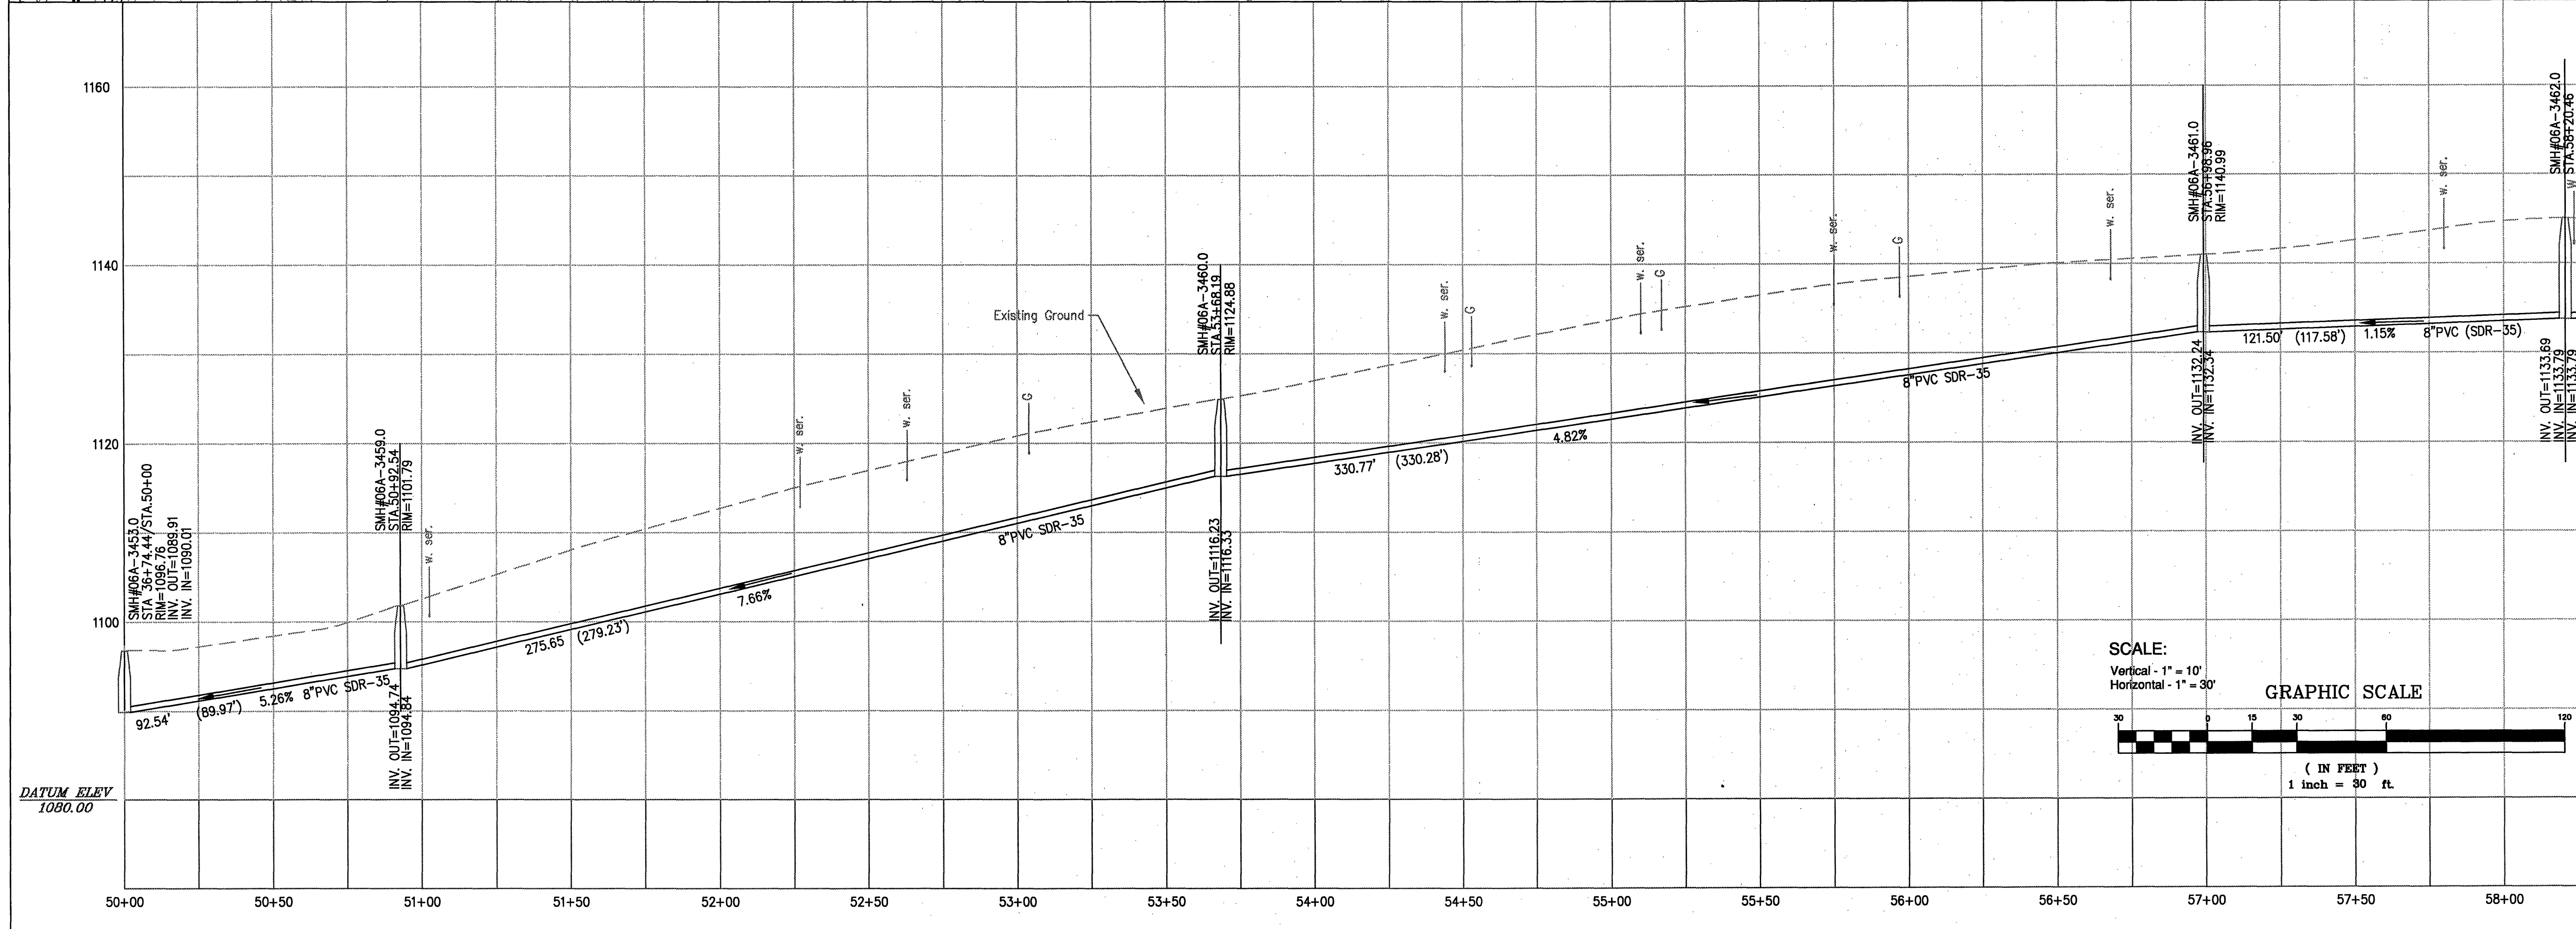


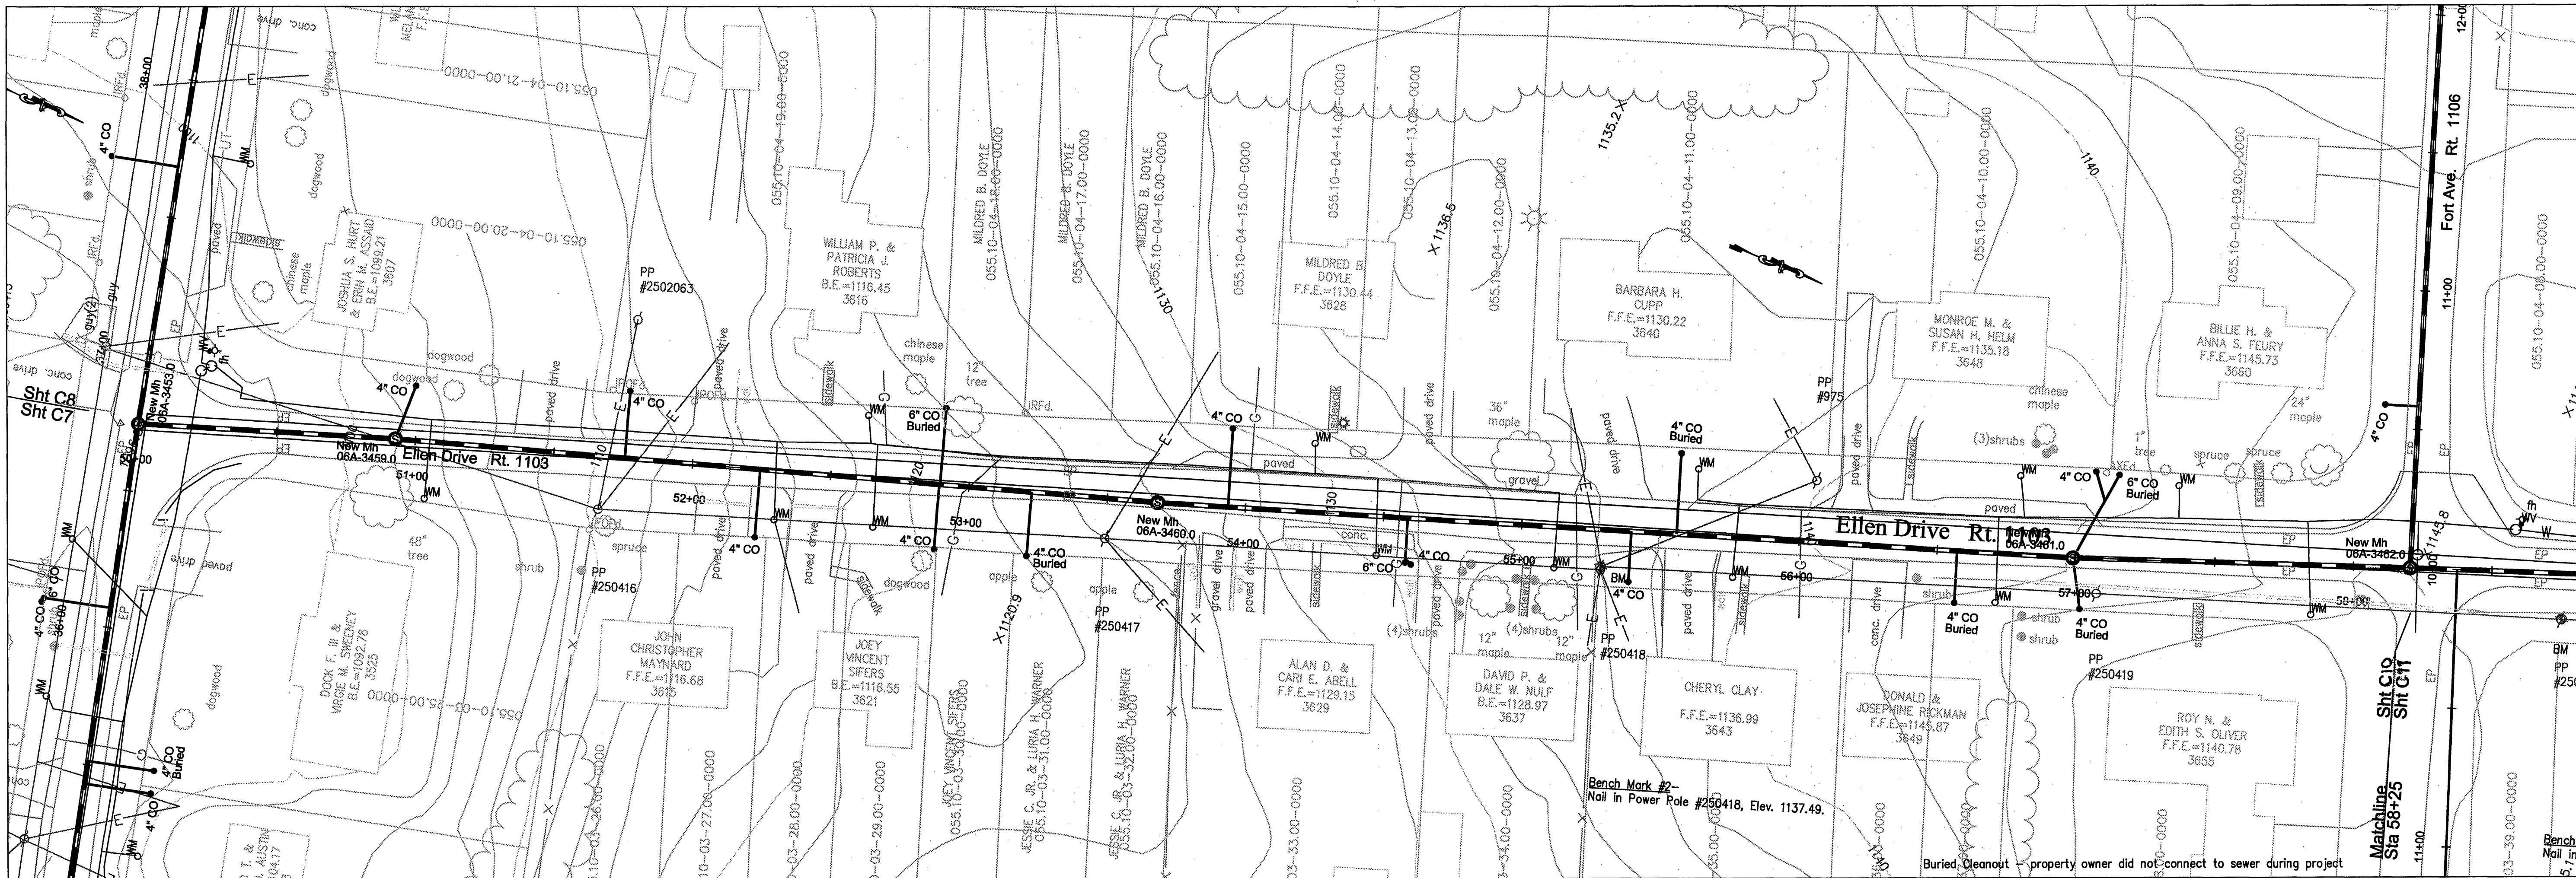

ASBUILT

**WESTERN VIRGINIA
WATER AUTHORITY**
ENGINEERING SERVICES
601 S JEFFERSON ST, SUITE 300
ROANOKE, VA 24011
540-853-5700

STATE OF VIRGINIA
Cassandra Altice
No. 035867
PROFESSIONAL ENGINEER

ANDREW LEWIS PLACE
SANITARY SEWER EXTENSION
CIVIL/SITEWORK PLAN

Rev	Description	Date	By

Designed: CDA
Drawn: CDA
Checked: CDA
Approved: JGR
Date: 02 MAR 2009
Project: C10

Sheet 10 of 16