
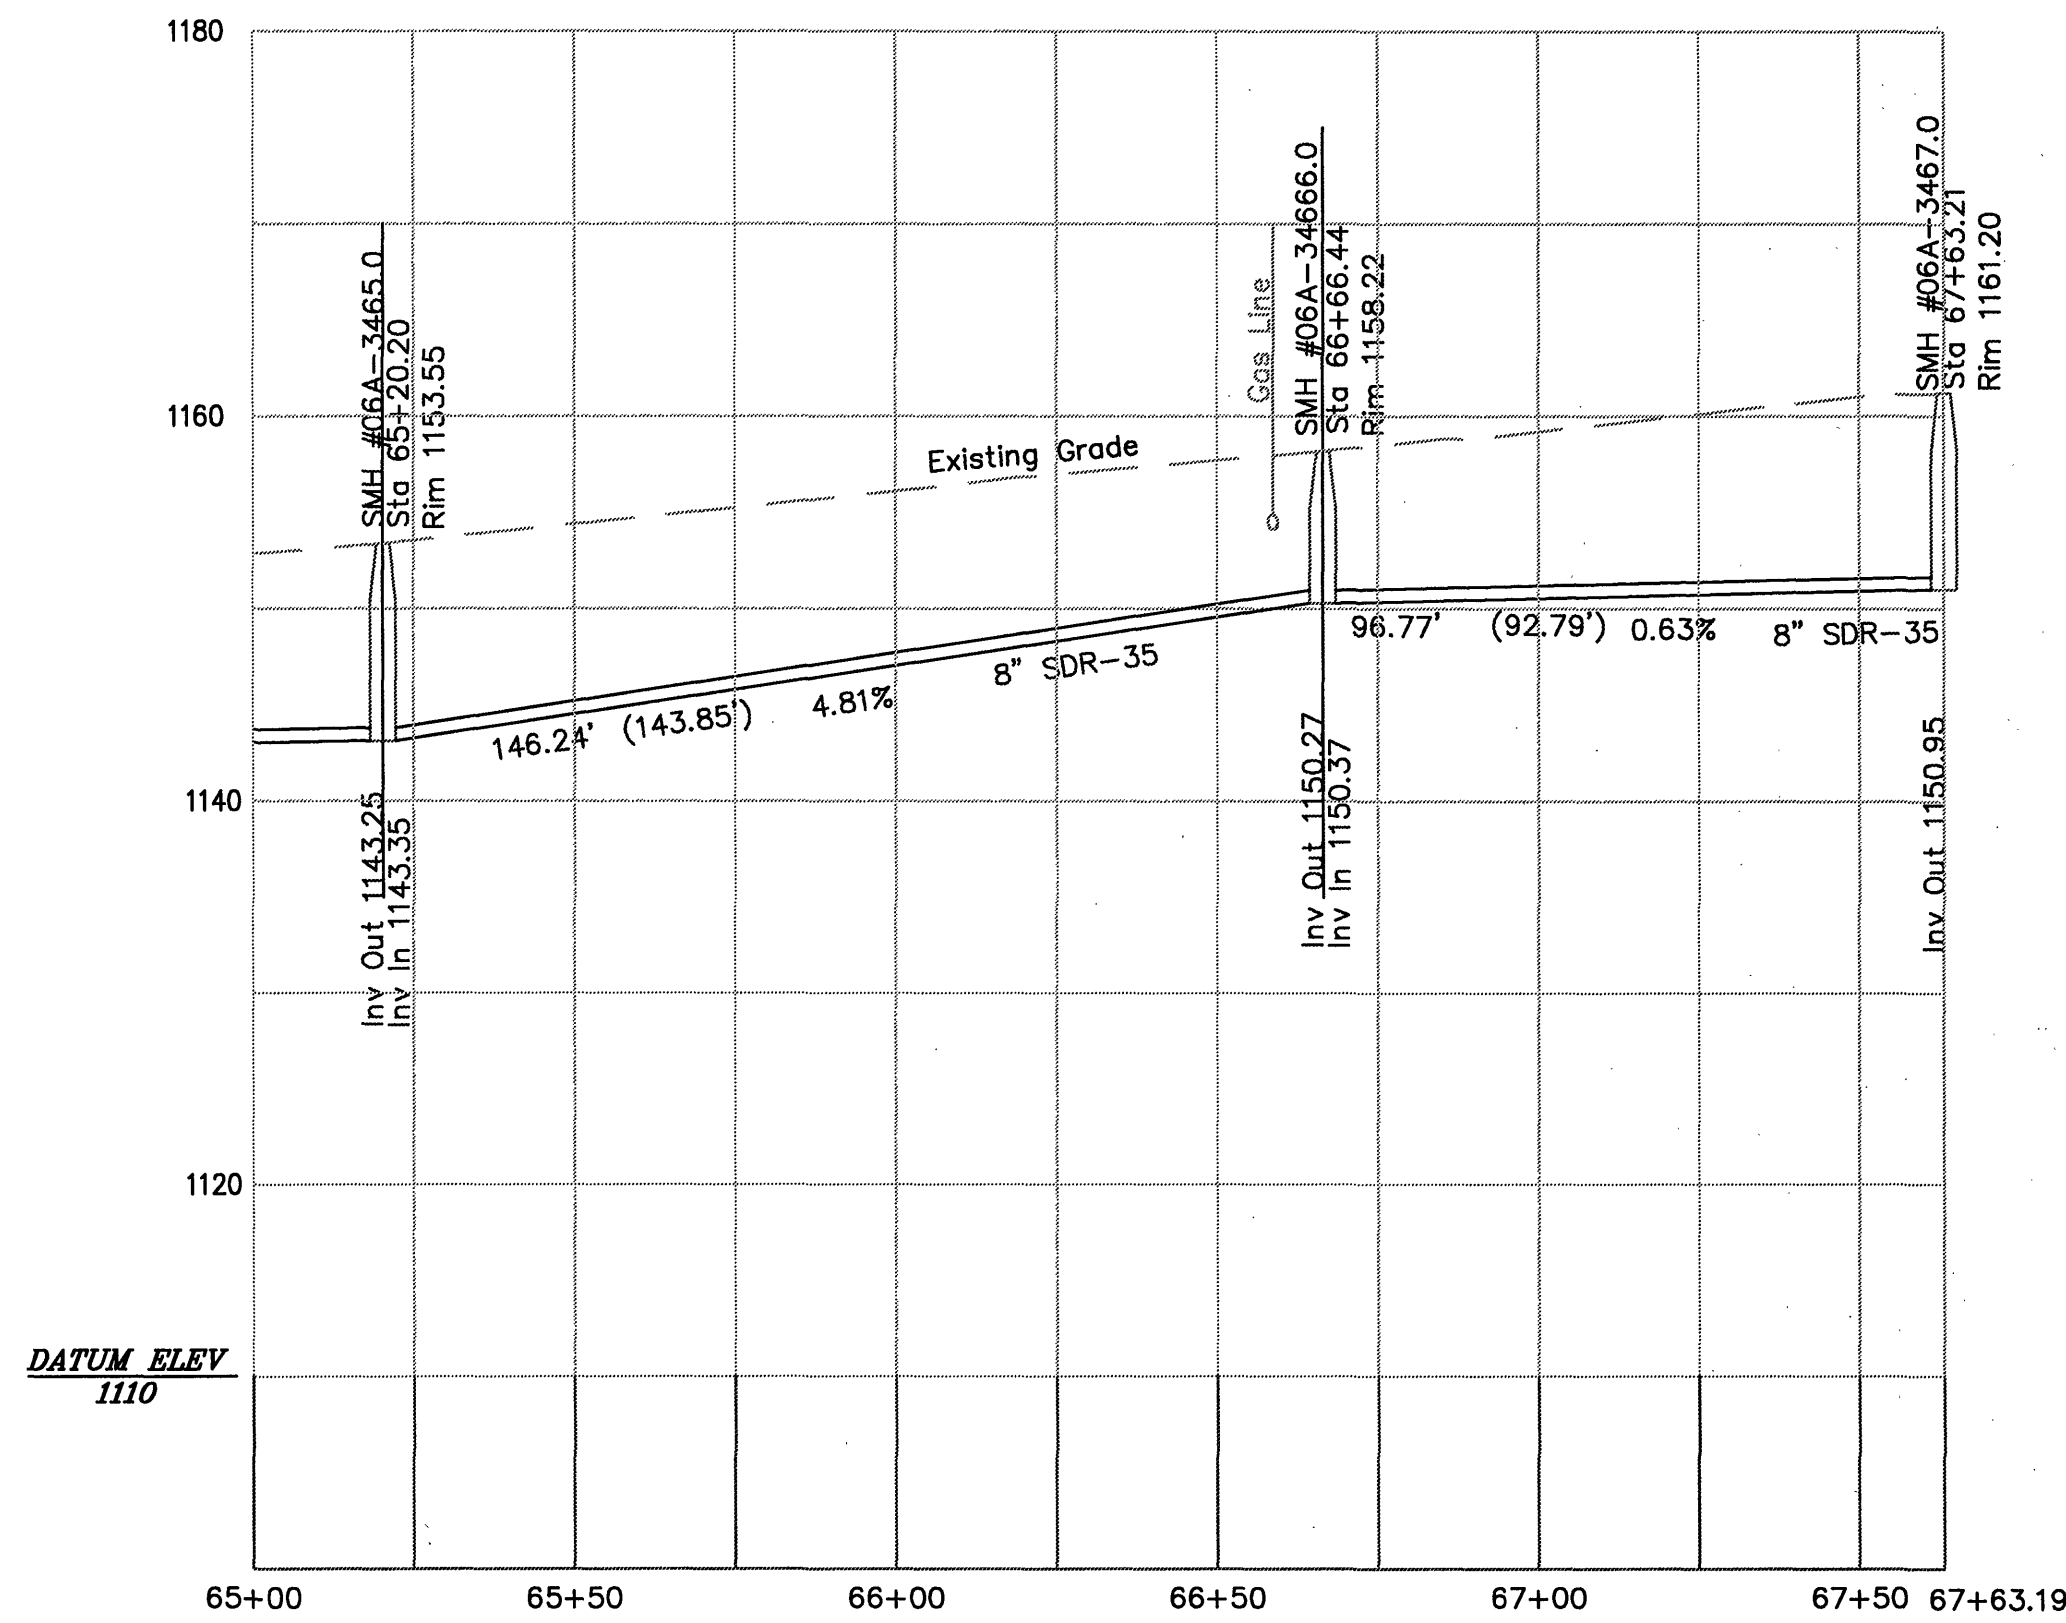
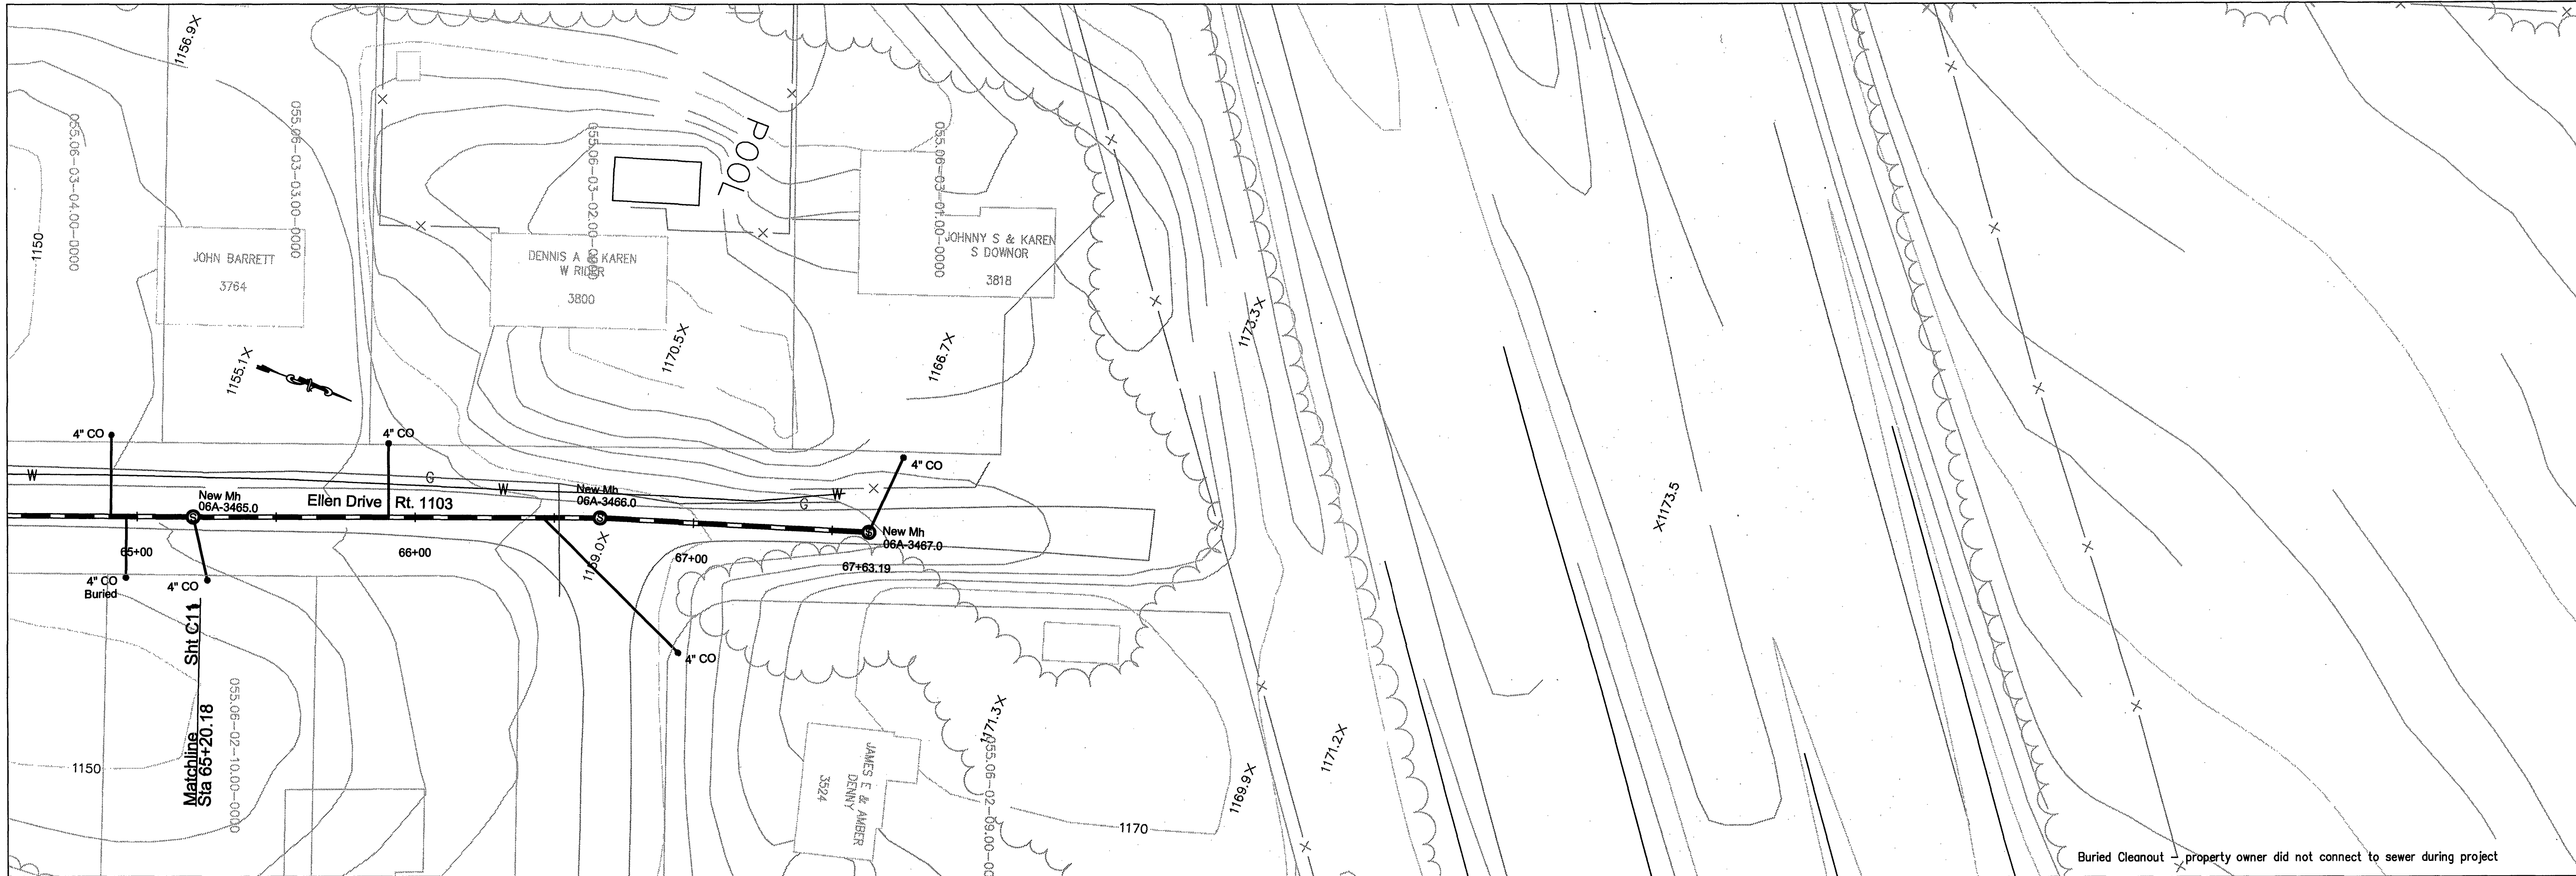


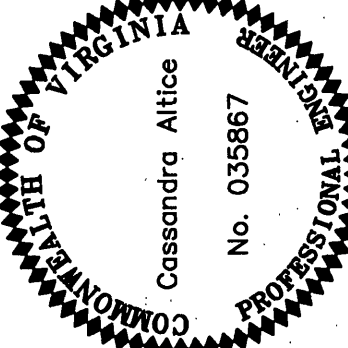

 WESTERN VIRGINIA WATER AUTHORITY		ENGINEERING SERVICES 601 S JEFFERSON ST, SUITE 300 ROANOKE, VA 24011 540-853-5700	
			
ANDREW LEWIS PLACE SANITARY SEWER EXTENSION		CIVIL/SITEWORK PLAN	
Rev	Description	Date	By
Designed: CDA			
Drawn: CDA			
Checked: CDA			
Approved: JGR			
Date: 02 MAR 2009			
Project:			
ASBUILT		C12 Sheet 12 of 16	