




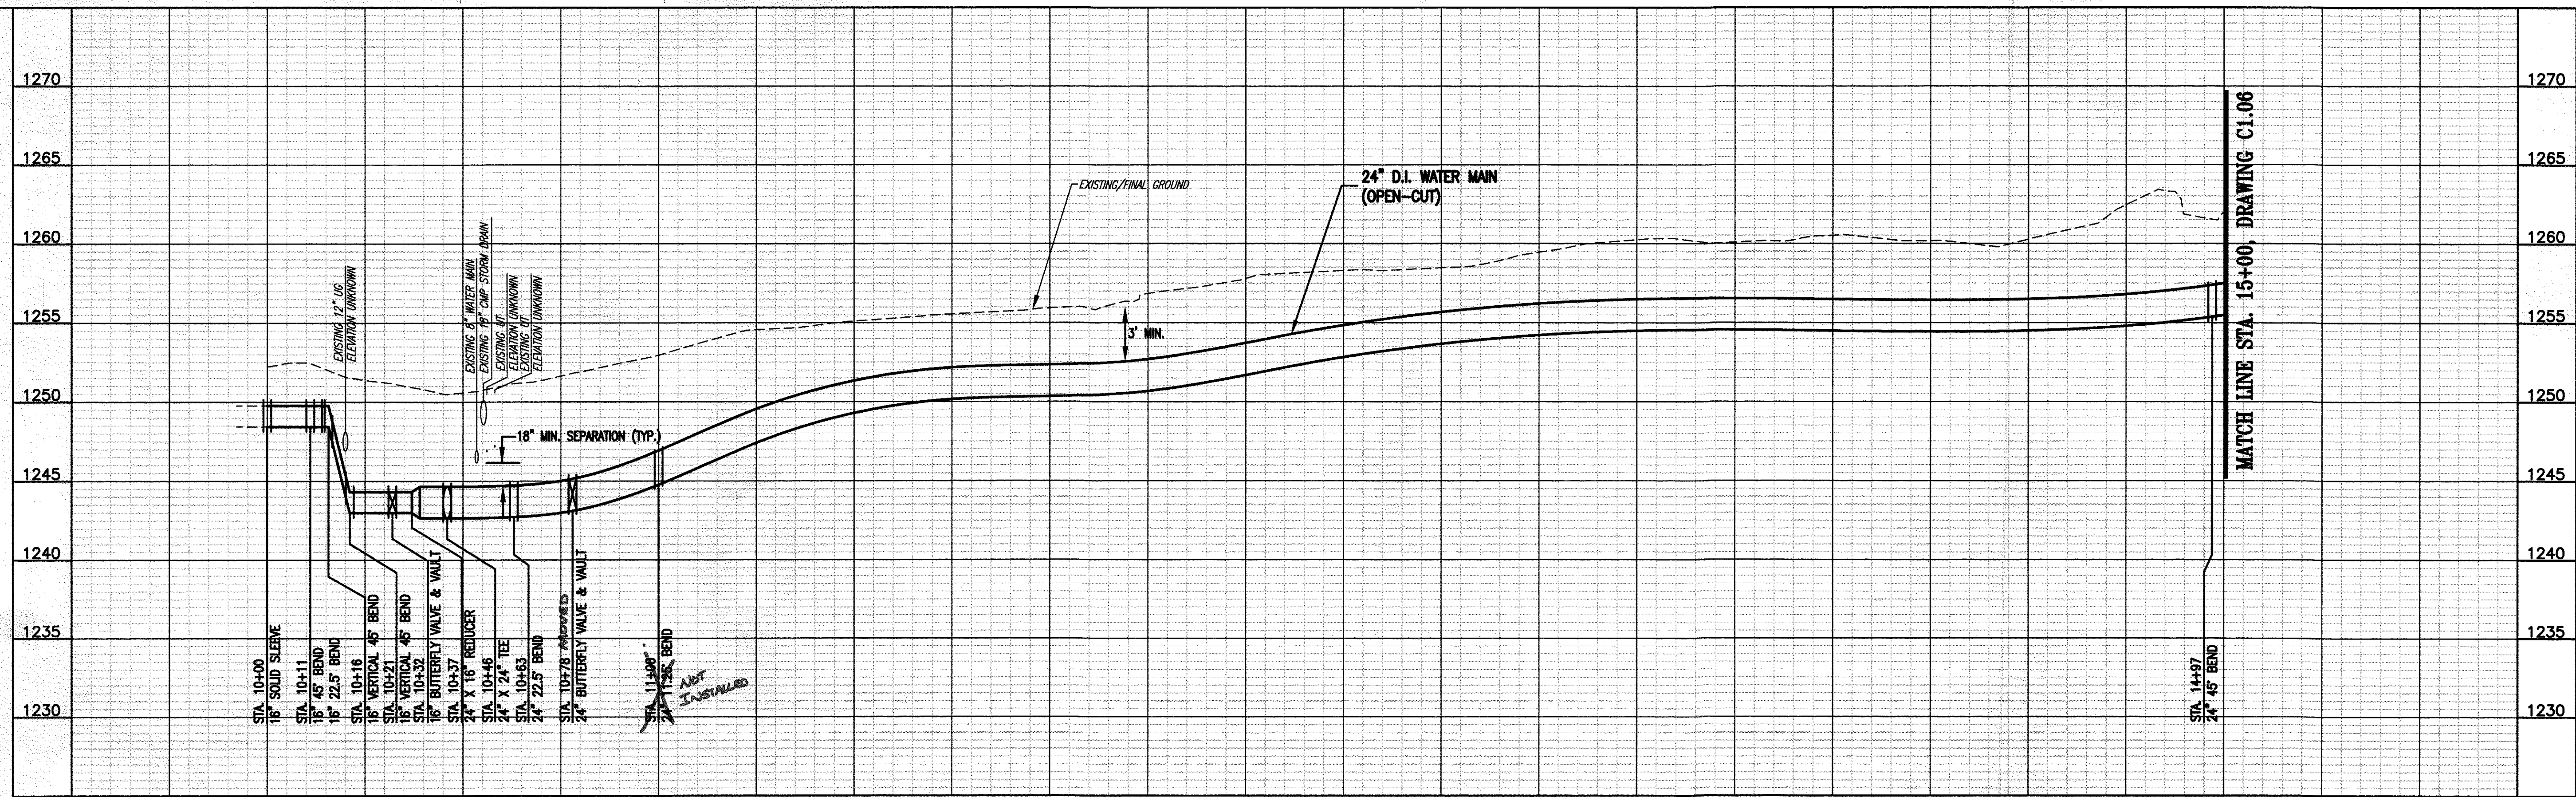

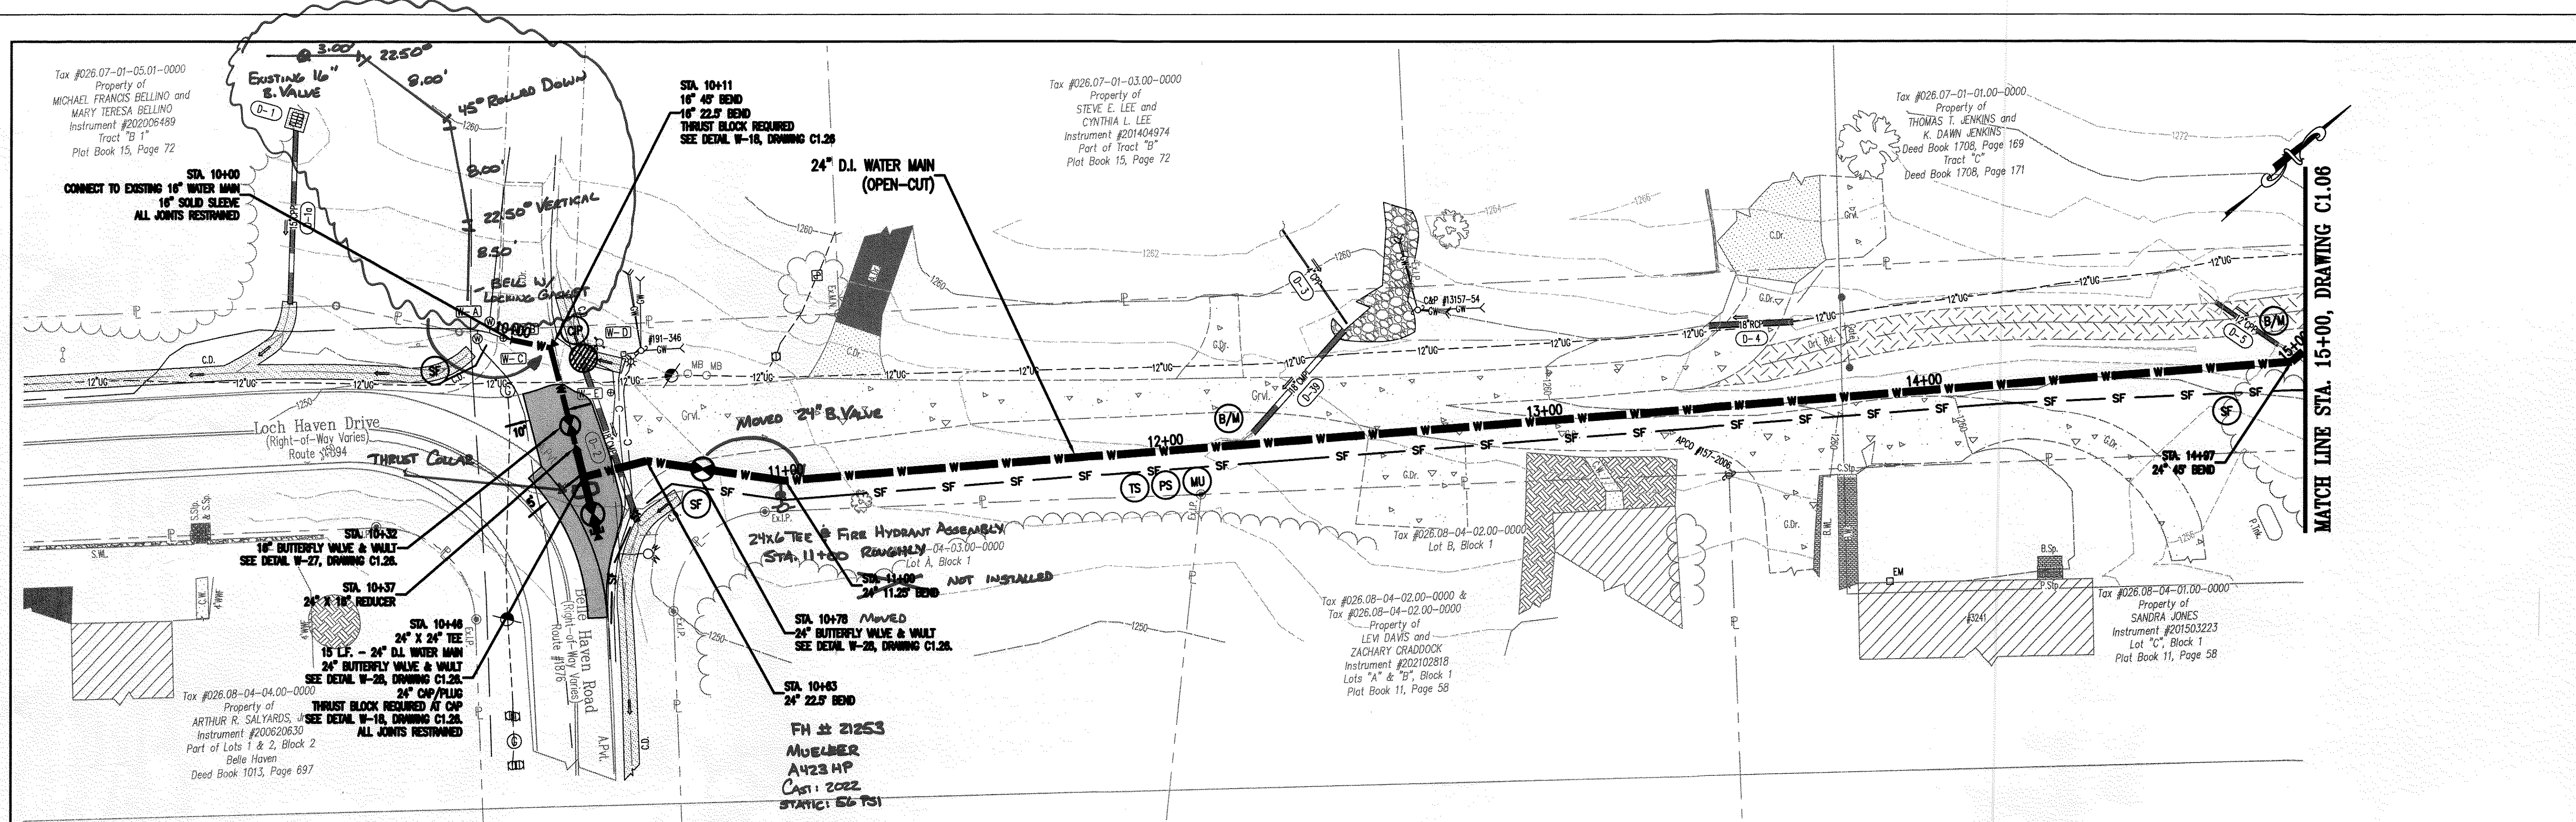

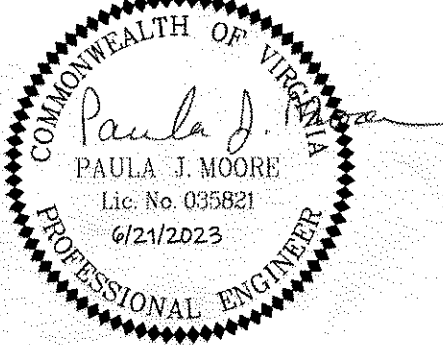

Whitman, Requardt & Associates, LLP
1700 Kraft Dr, Suite 1200, Blacksburg, VA 24060

WESTERN VIRGINIA WATER AUTHORITY
601 South Jefferson Street, Suite 300
Roanoke, Virginia 24011

DES: **BF**

DRAWN: **JES**

CHECK: **PJM**

DATE: **6/20/23**

SCALE: **AS SHOWN**

HORIZ: **1" = 20'**

VERT: **1" = 5'**

ANGEL LANE INTERCONNECTION

24" WATER MAIN PLAN - PROFILE
STA. 10+00 TO STA. 15+00

REV DATE DESCRIPTION

DRAWING

C1.05

SHEET

5