




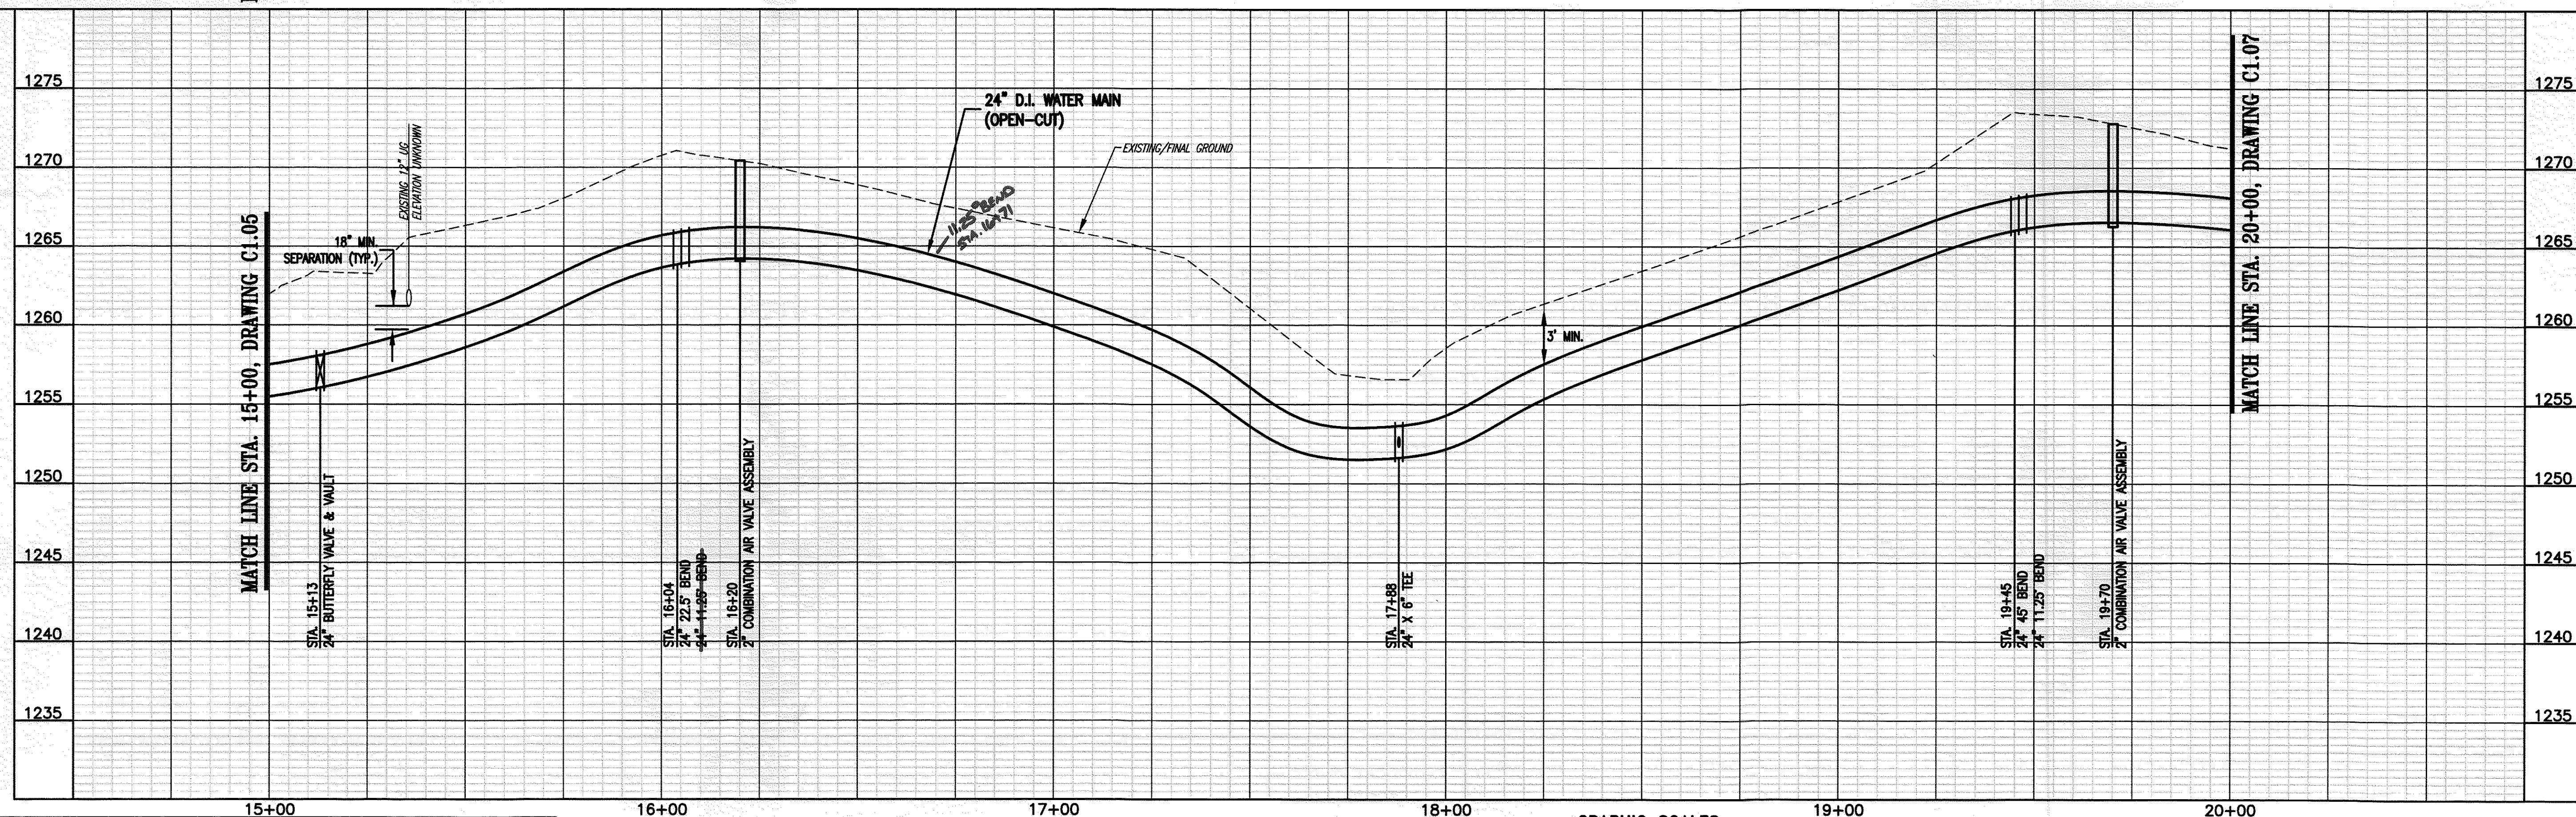

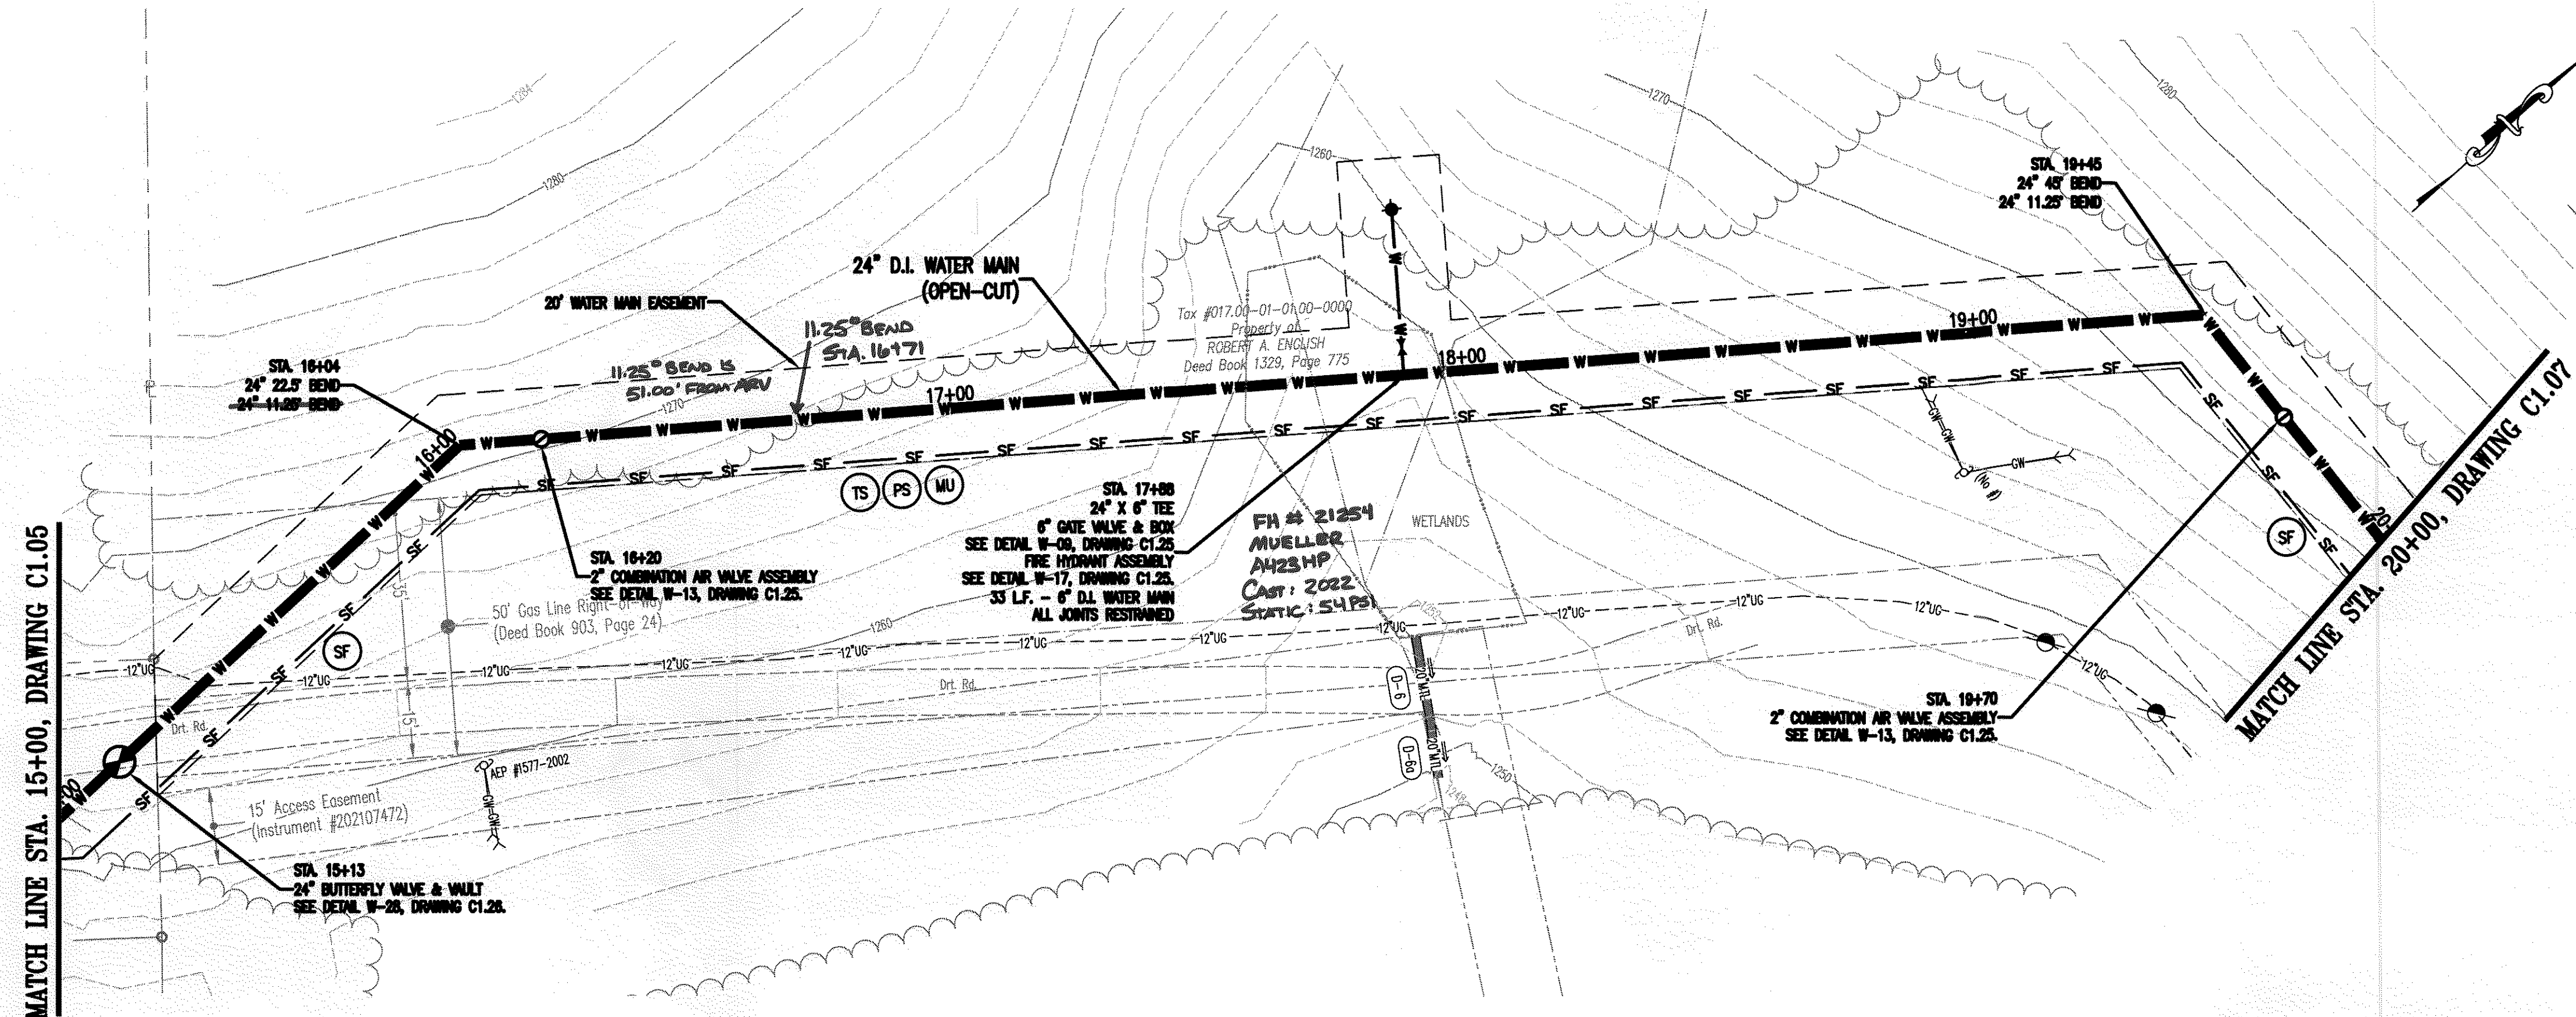

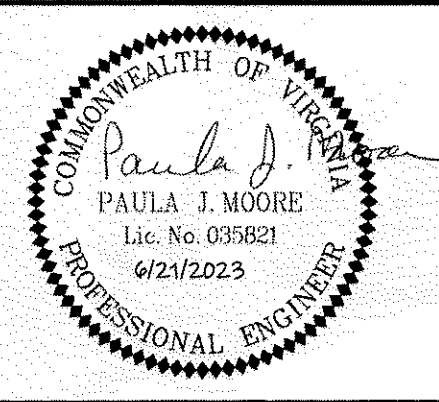

Whitman, Requardt & Associates, LLP
1700 Kraft Dr, Suite 1200, Blacksburg, VA 24060

WESTERN VIRGINIA WATER AUTHORITY
601 South Jefferson Street, Suite 300
Roanoke, Virginia 24011

DES: BP

DRAWN: JES

CHECK: PJM

DATE: 6/20/23

SCALE: AS SHOWN

HORIZ: 1" = 20'

VERT: 1" = 5'

GRAPHIC SCALES

HORIZ. 1 inch = 20 feet

VERT. 1 inch = 5 feet

ANGEL LANE INTERCONNECTION

24" WATER MAIN PLAN - PROFILE
STA. 15+00 TO STA. 20+00

REV	DATE	DESCRIPTION

DRAWING

C1.06

SHEET

6