
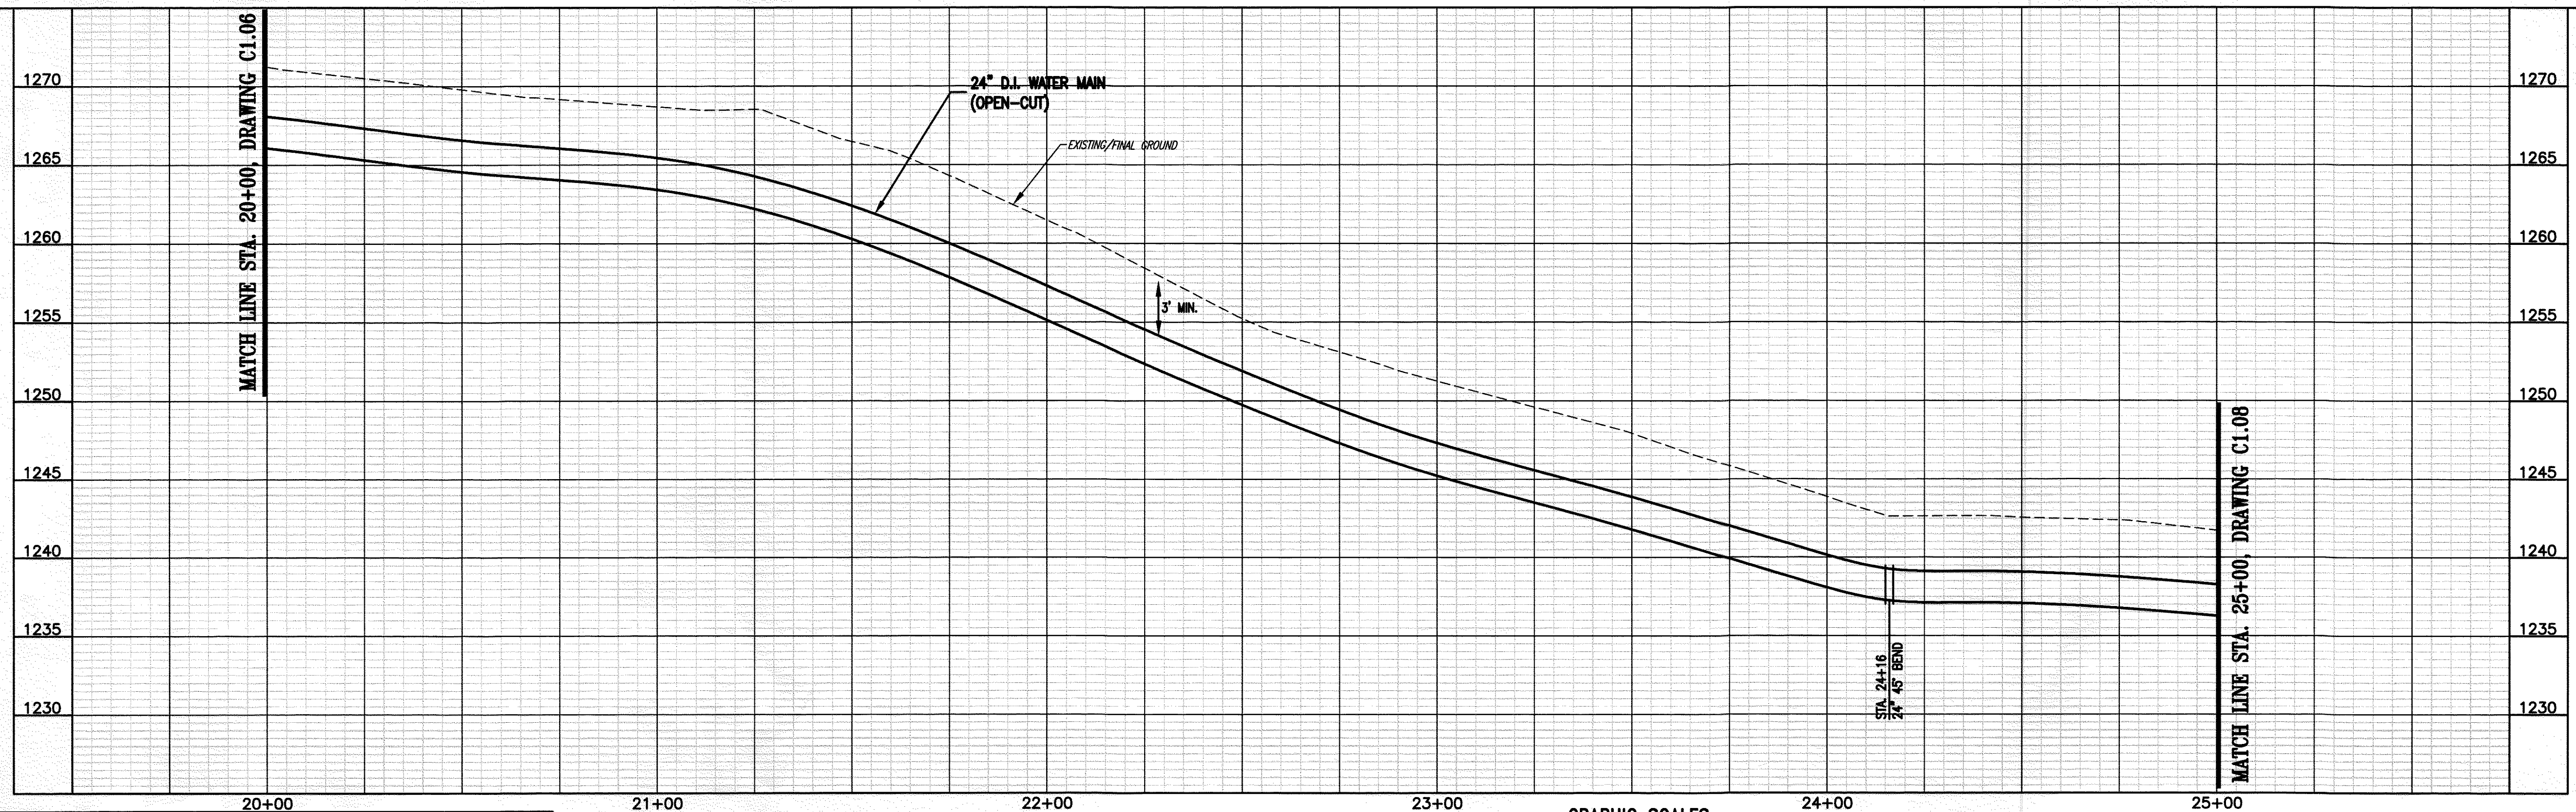


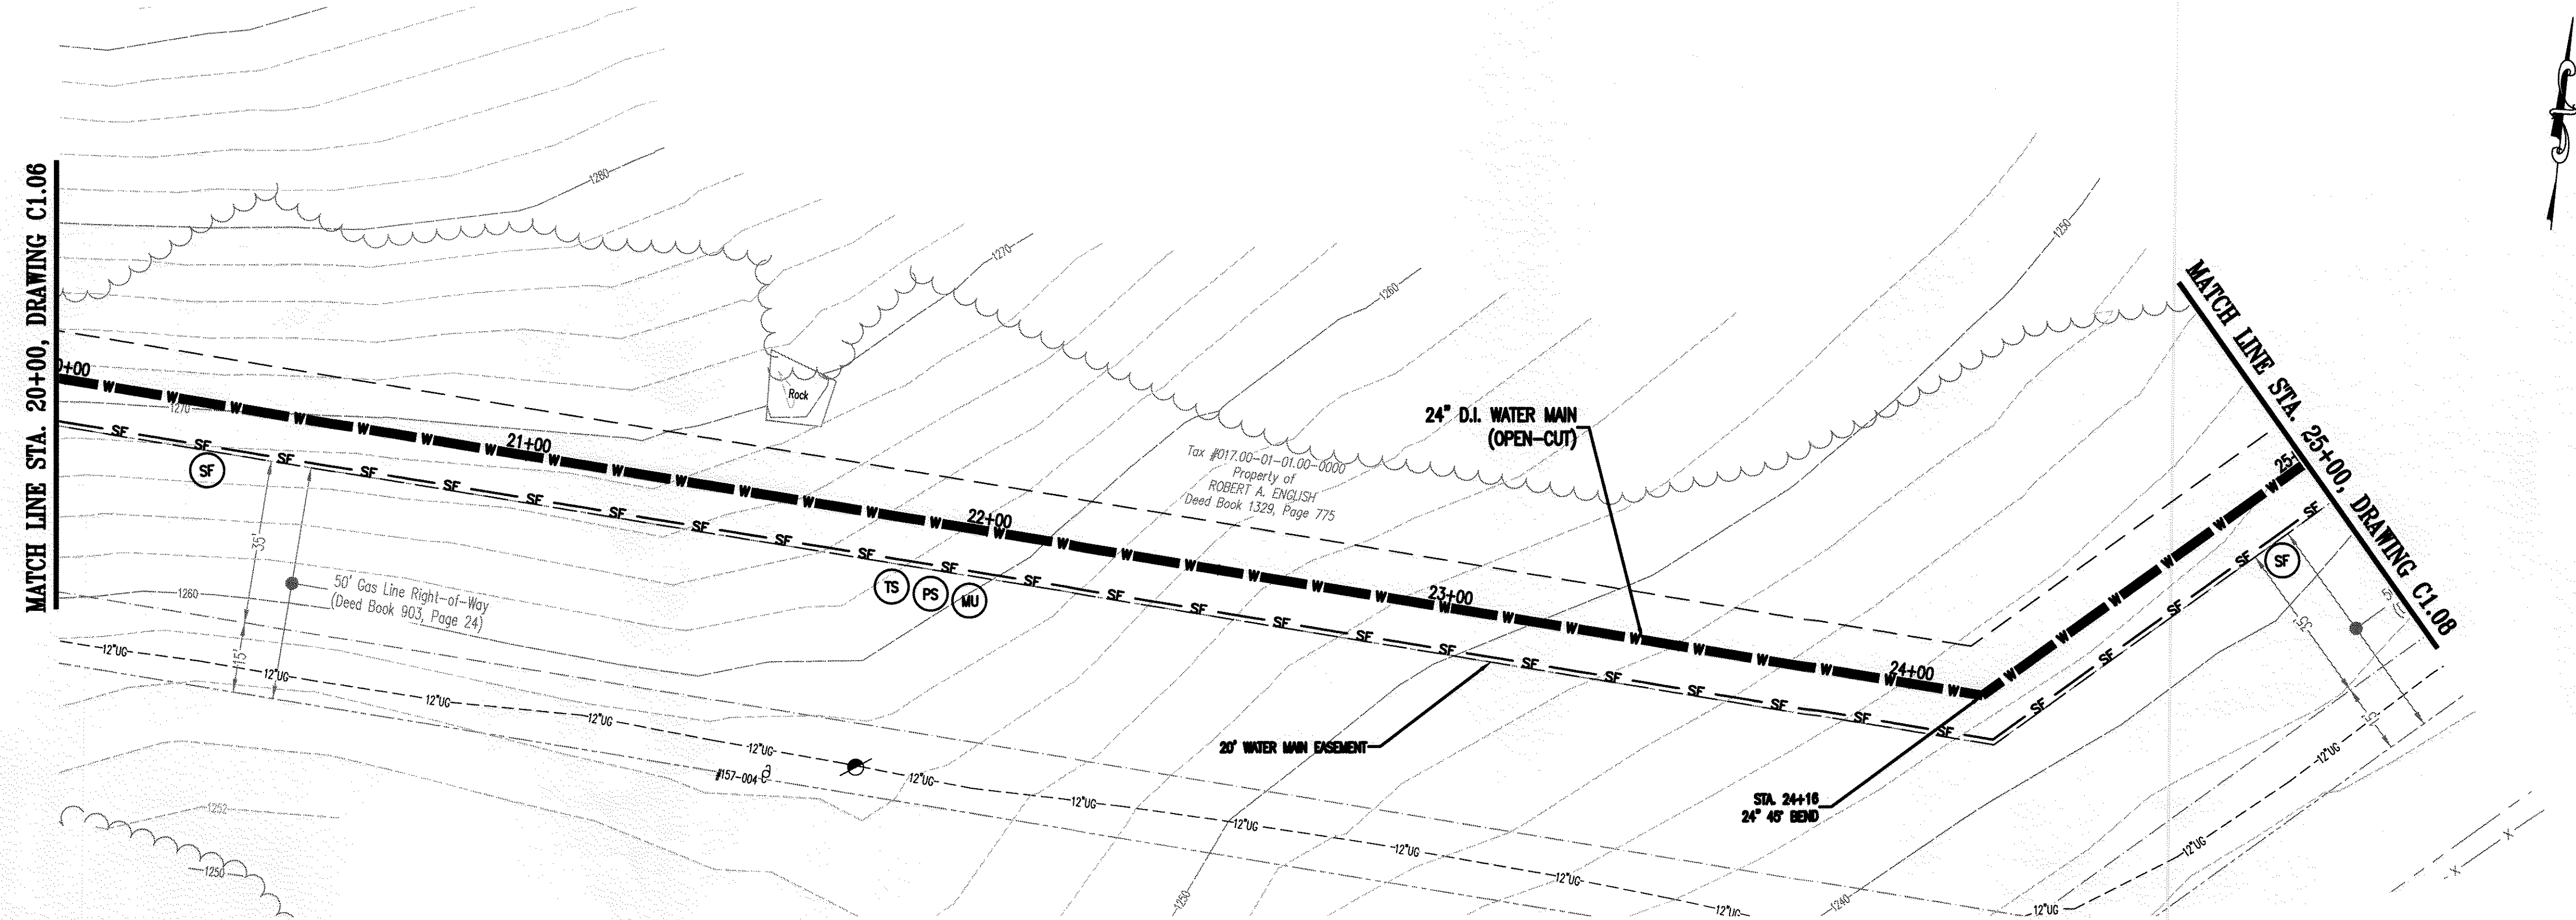

WRAX
Whitman, Requardt & Associates, LLP
1700 Kraft Dr, Suite 1200, Blacksburg, VA 24060

WESTERN VIRGINIA WATER AUTHORITY
601 South Jefferson Street, Suite 300
Roanoke, Virginia 24011

DES: **BF**
DRAWN: **JES**
CHECK: **PJM**
DATE: **6/20/23**

SCALE: **AS SHOWN**
HORIZ: **1" = 20'**
VERT: **1" = 5'**

ANGEL LANE INTERCONNECTION

24" WATER MAIN PLAN - PROFILE
STA. 20+00 TO STA. 25+00

DRAWING
C1.07

SHEET
7

(IN FEET)
HORIZ. 1 inch = 20 feet

(IN FEET)
VERT. 1 inch = 5 feet

REV	DATE	DESCRIPTION