



MATCH LINE STA. 25+00, DRAWING C1.07

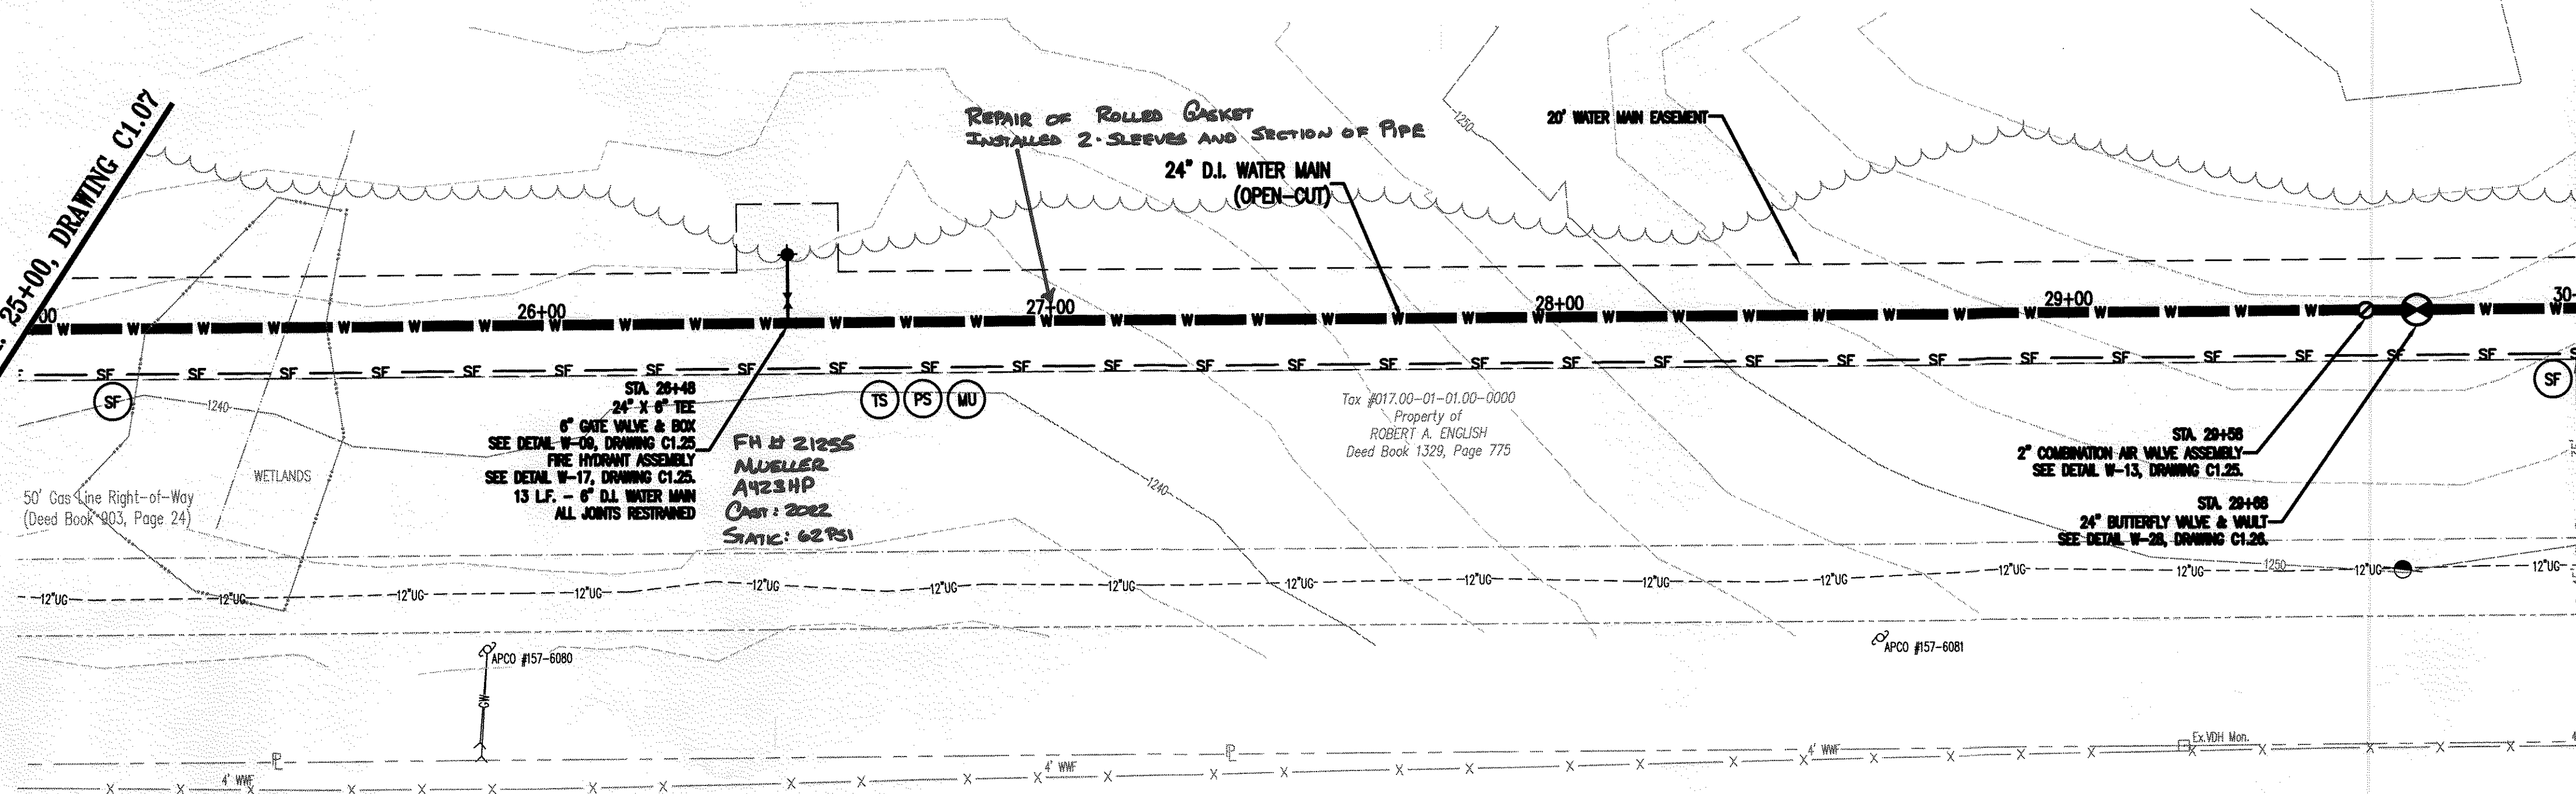

MATCH LINE STA. 30+00, DRAWING C1.09

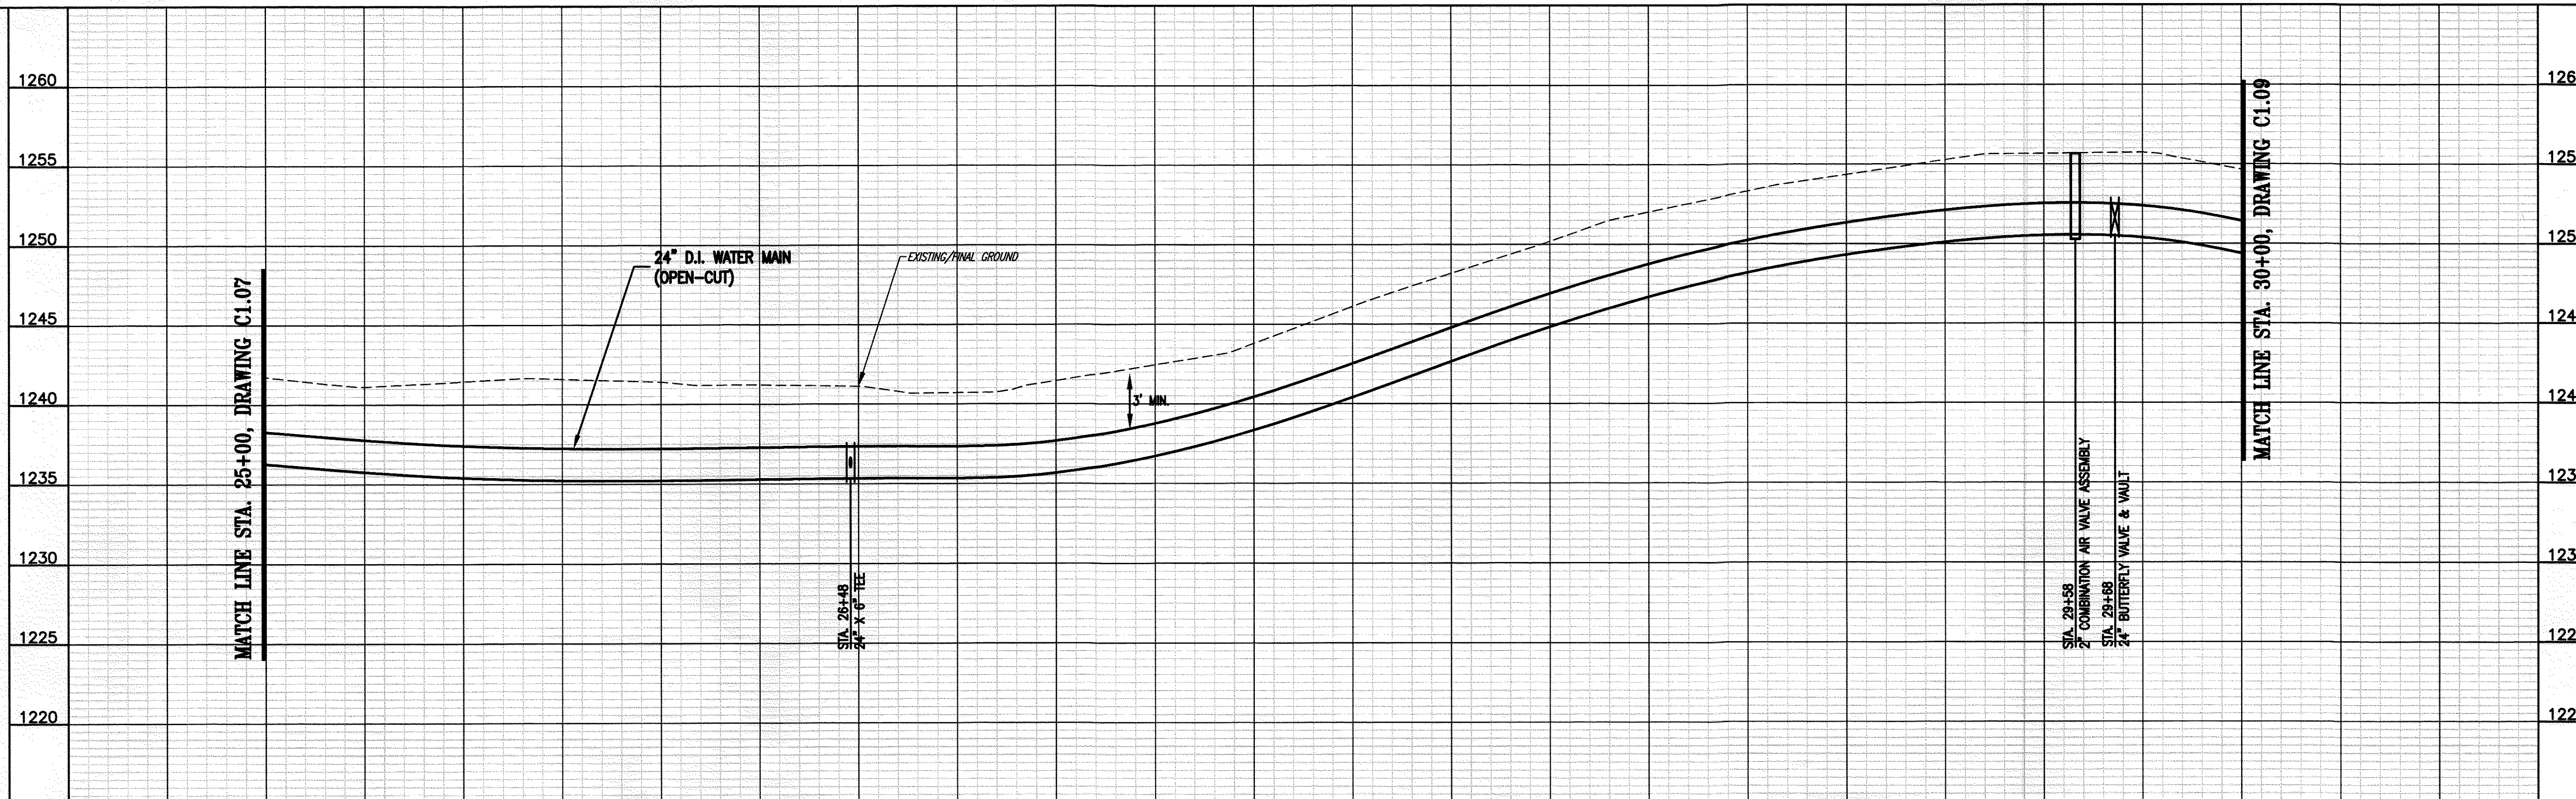

25+00

26+00

27+00


28+00

29+00

30+00

MATCH LINE STA. 25+00, DRAWING C1.07

MATCH LINE STA. 30+00, DRAWING C1.09

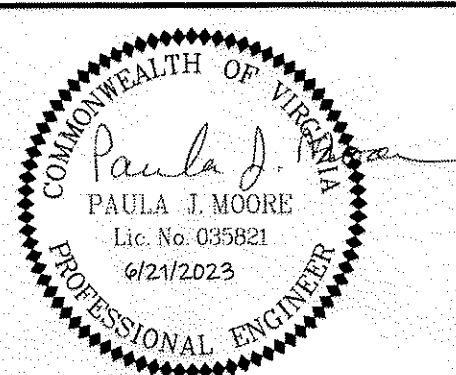

WESTERN VIRGINIA WATER AUTHORITY
601 South Jefferson Street, Suite 300
Roanoke, Virginia 24011

DES: BF
DRAWN: JES
CHECK: PJM
DATE: 6/20/23

SCALE: AS SHOWN
HORIZ: 1" = 20'
VERT: 1" = 5'

ANGEL LANE INTERCONNECTION

24" WATER MAIN PLAN - PROFILE
STA. 25+00 TO STA. 30+00

DRAWING
C1.08

SHEET
8