




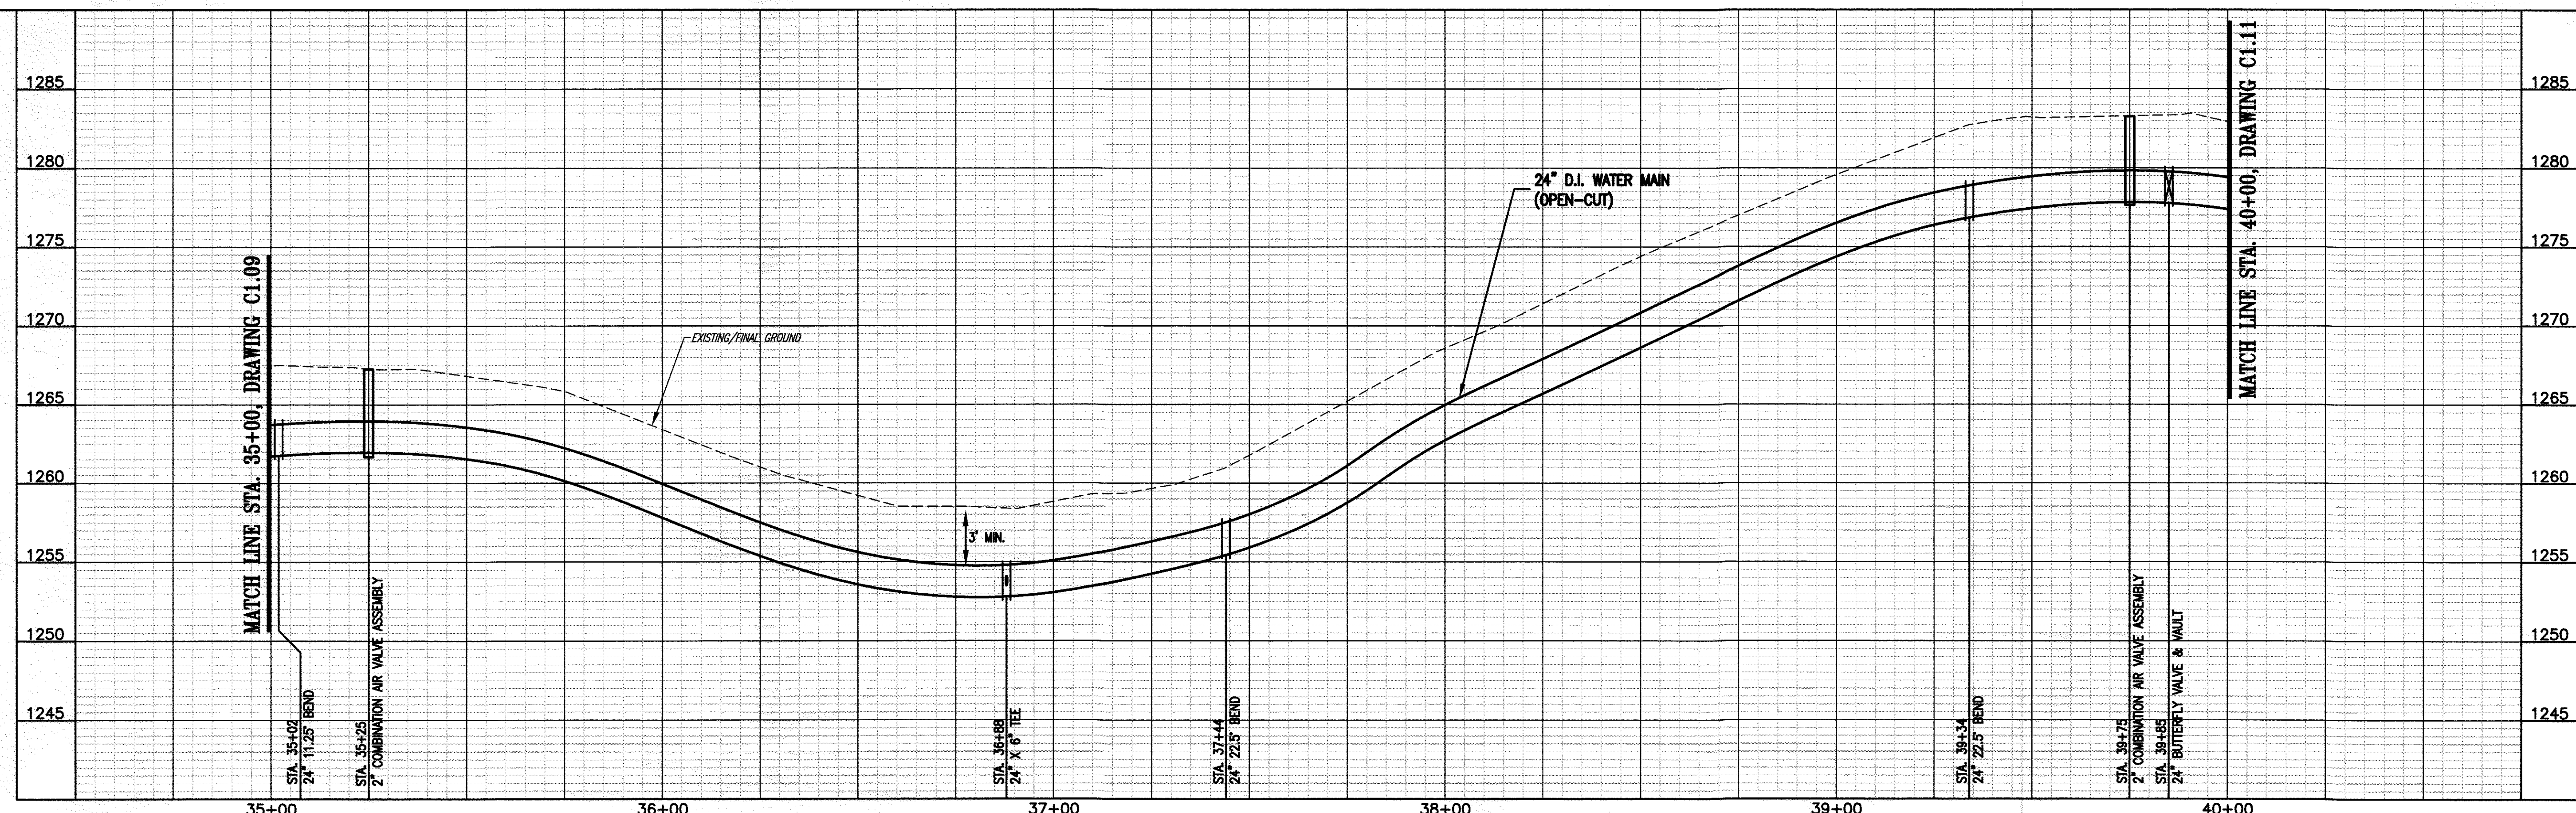

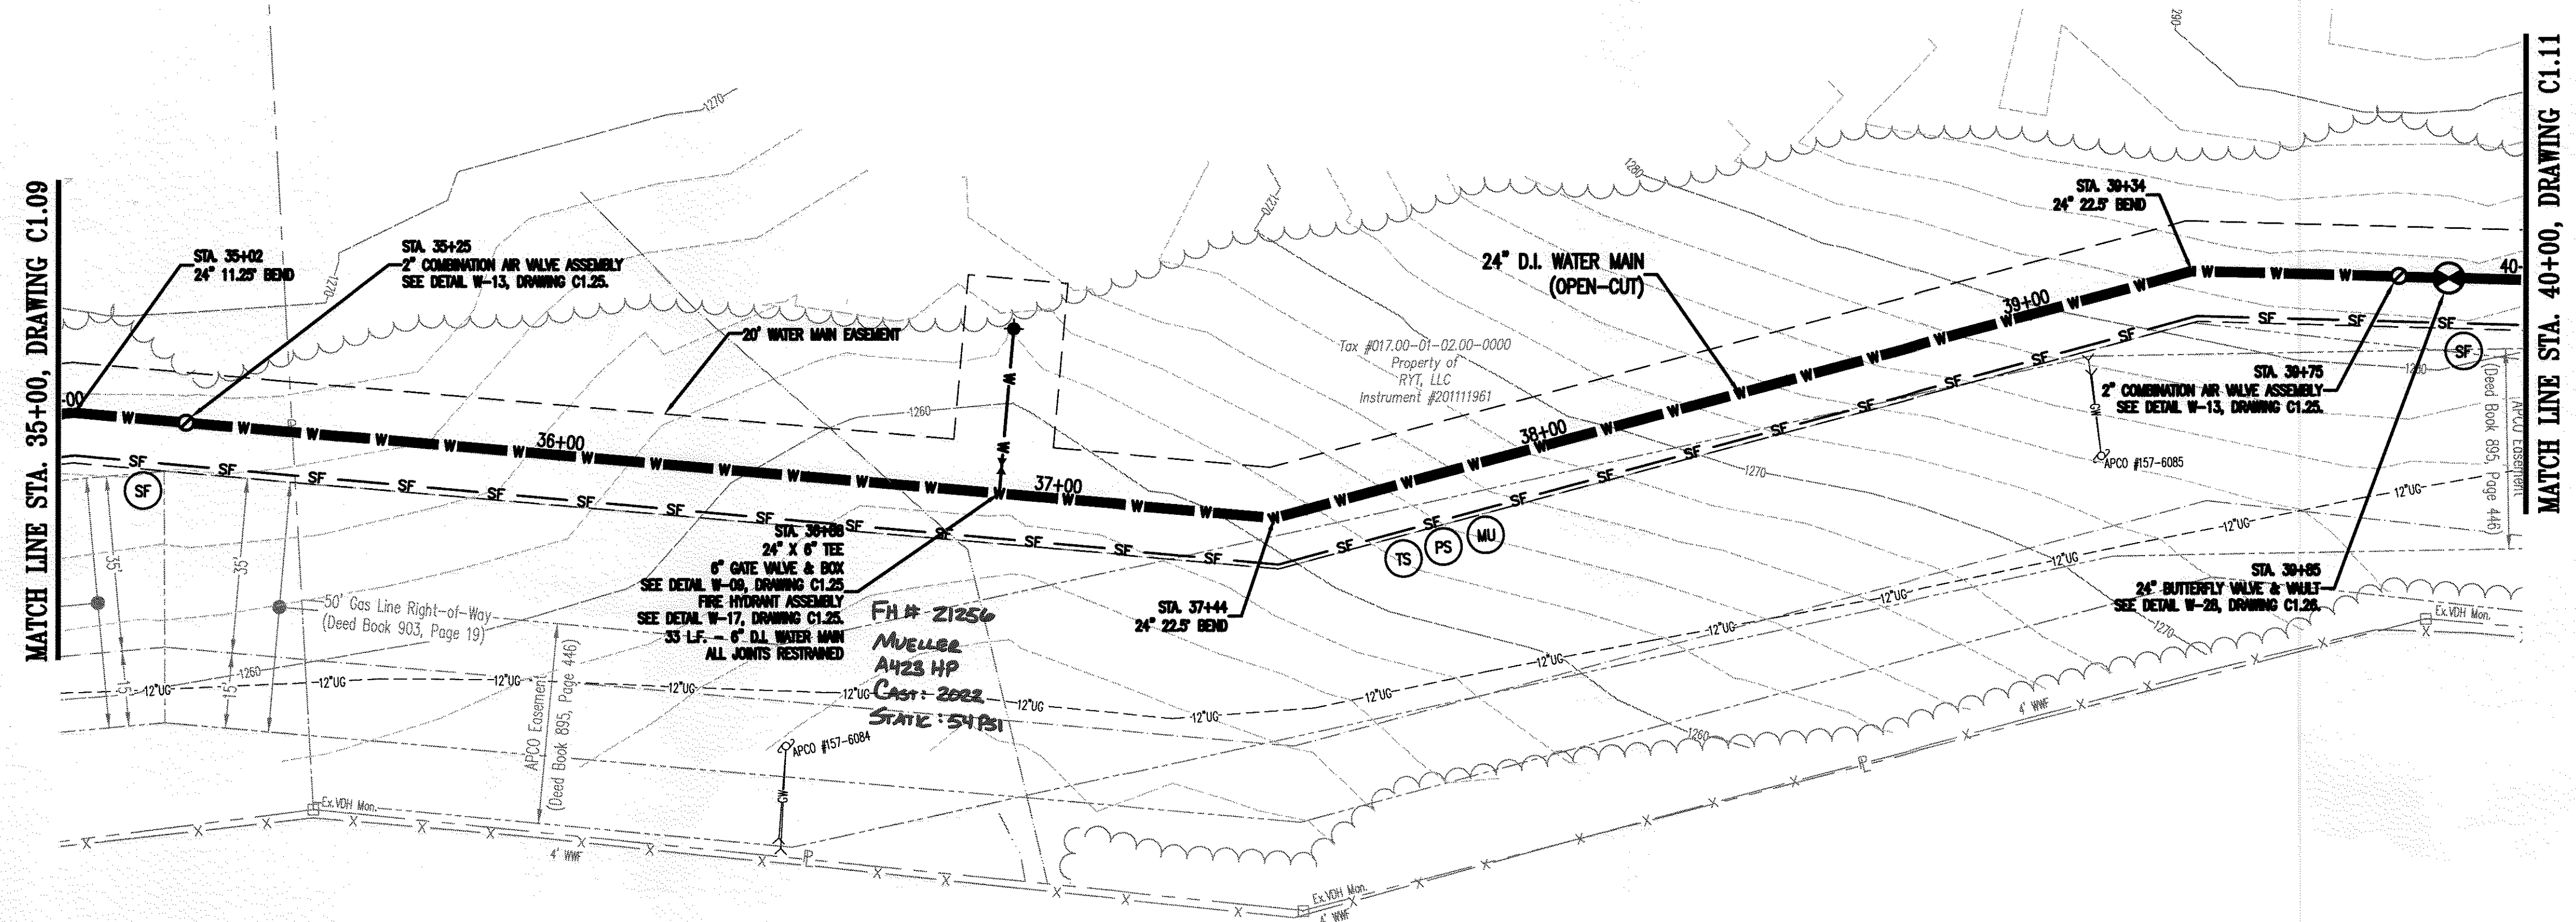

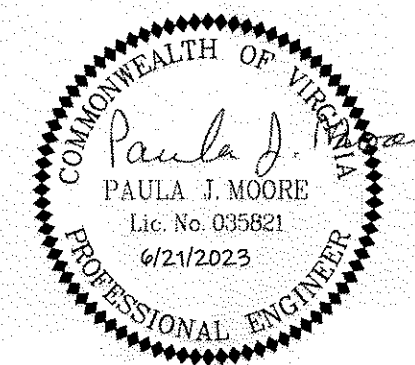

Whitman, Requardt & Associates, LLP
1700 Kraft Dr, Suite 1200, Blacksburg, VA 24060

WESTERN VIRGINIA WATER AUTHORITY
601 South Jefferson Street, Suite 300
Roanoke, Virginia 24011

DES: BF
DRAWN: JES
CHECK: PJM
DATE: 6/20/23

SCALE: AS SHOWN
HORIZ: 1" = 20'
VERT: 1" = 5'

ANGEL LANE INTERCONNECTION

24" WATER MAIN PLAN - PROFILE
STA. 35+00 TO STA. 40+00

DRAWING
C1.10

SHEET
10