

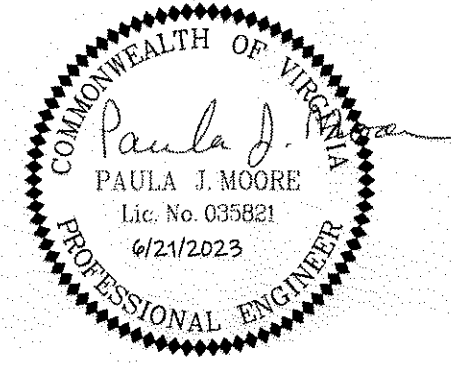
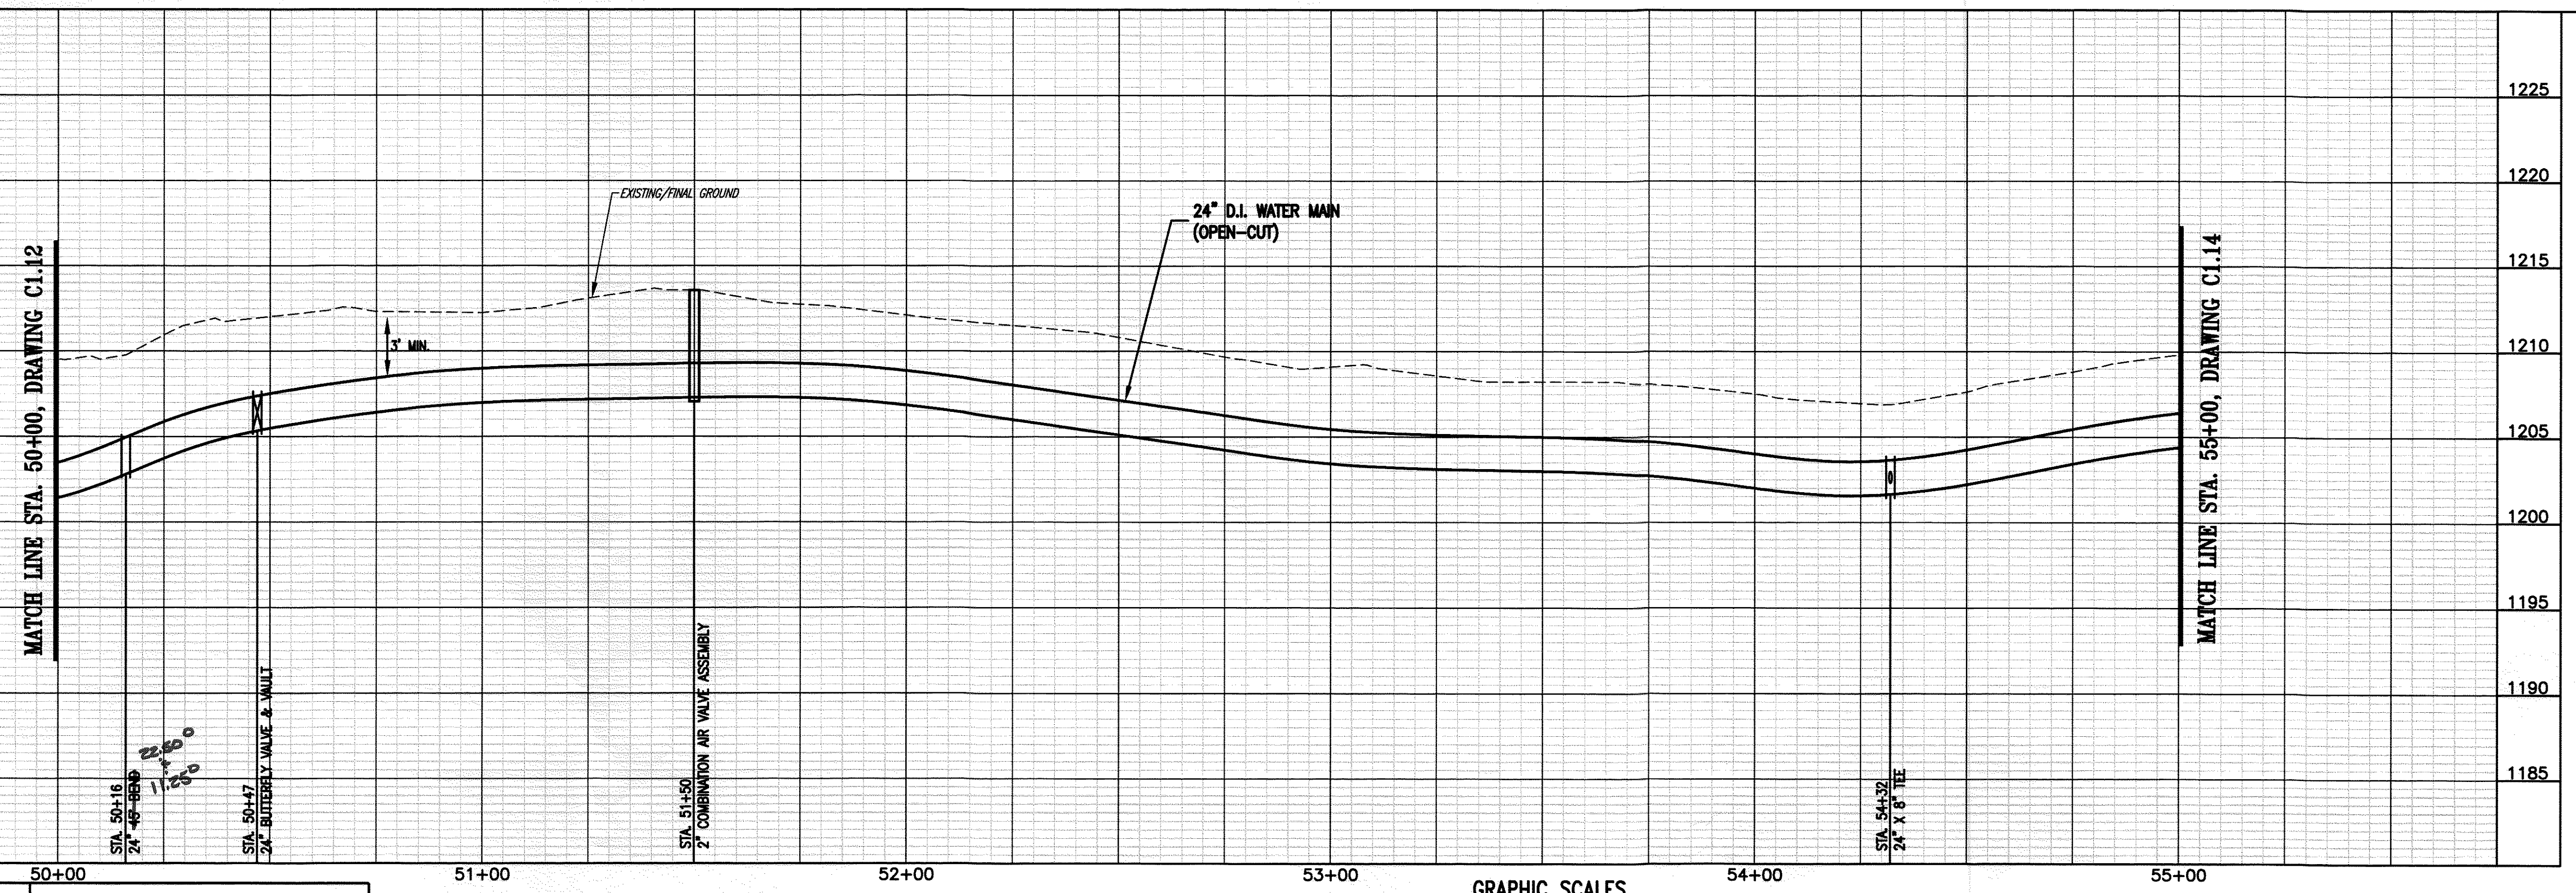


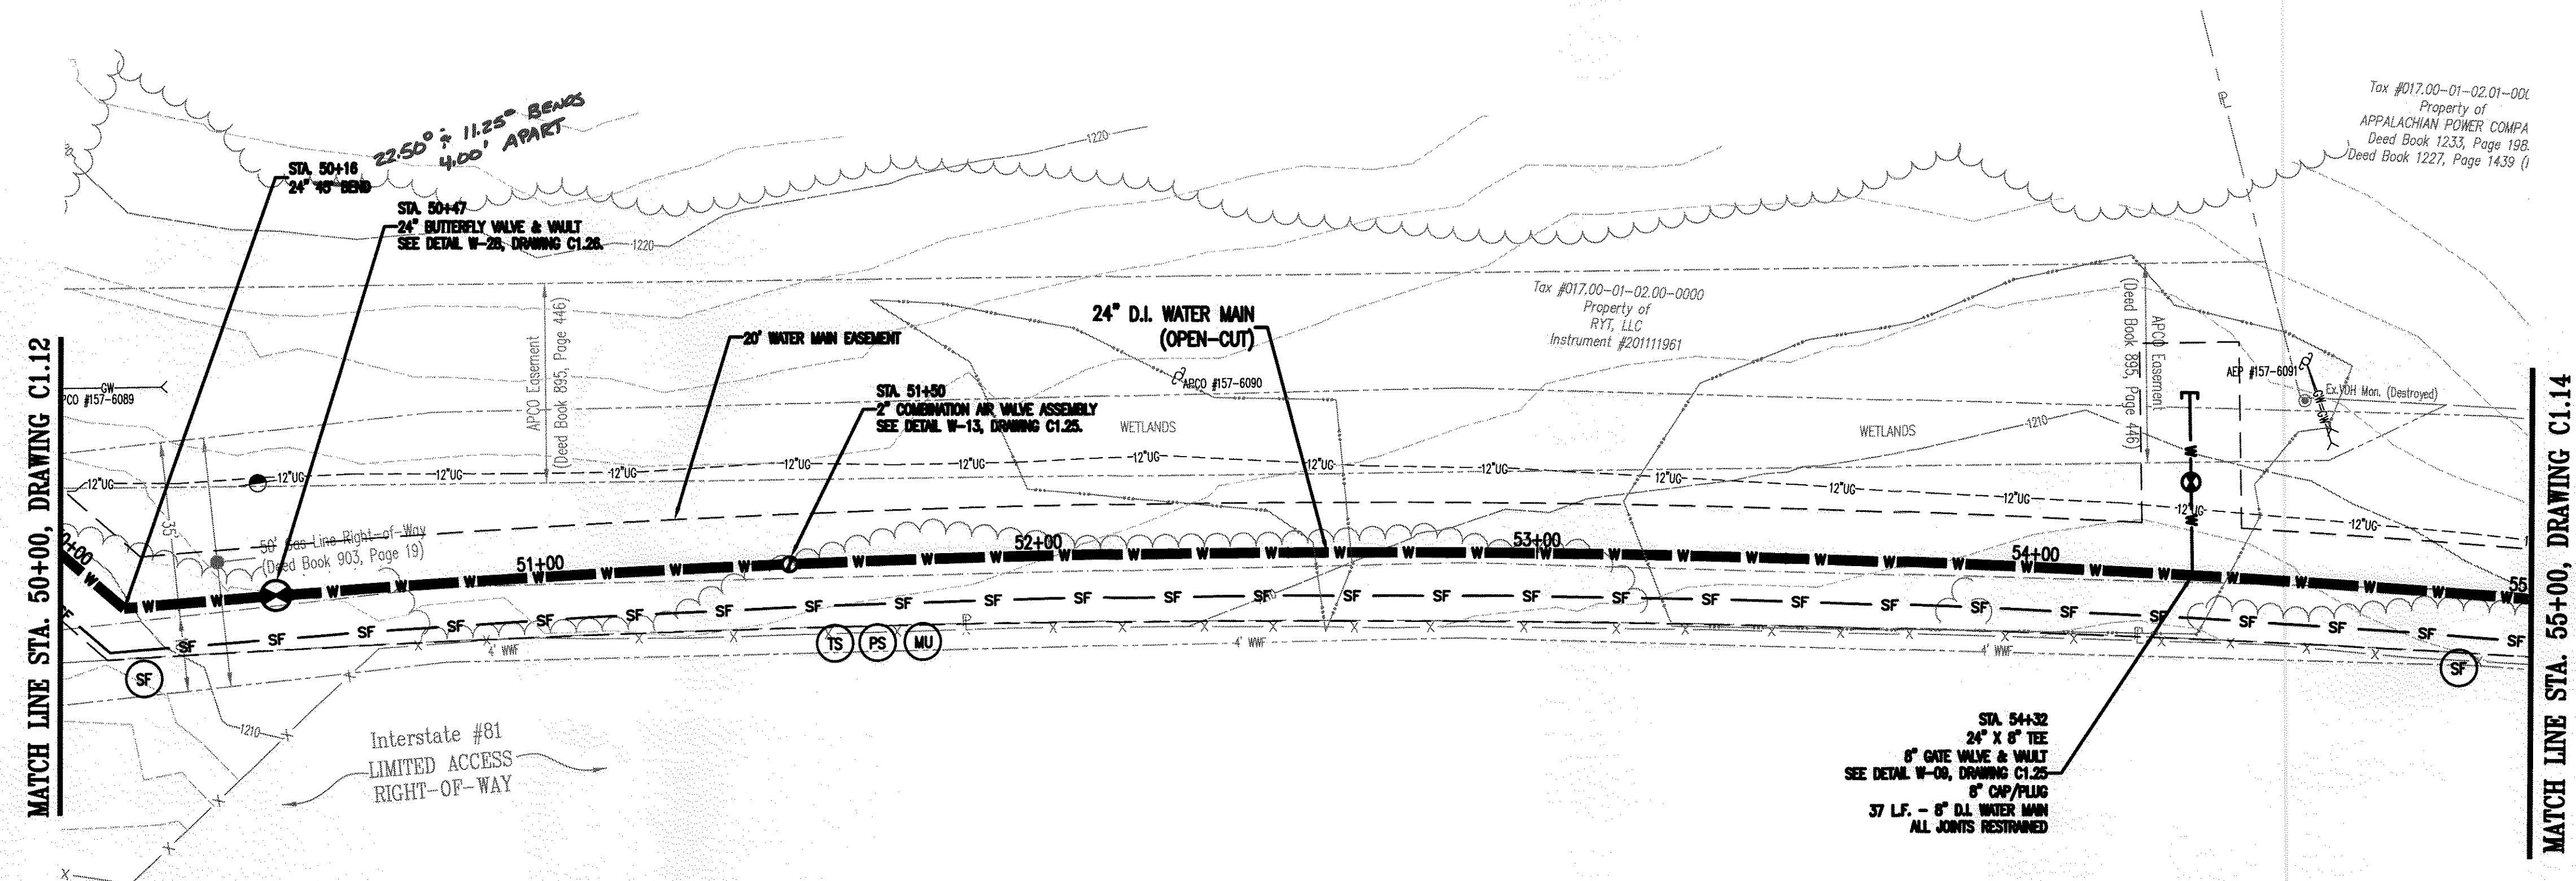

WESTERN VIRGINIA WATER AUTHORITY
 601 South Jefferson Street, Suite 300
 Roanoke, Virginia 24011

DES: **BF**
 DRAWN: **JES**
 CHECK: **PJM**
 DATE: **6/20/23**

SCALE: **AS SHOWN**
 HORIZ: **1" = 20'**
 VERT: **1" = 5'**

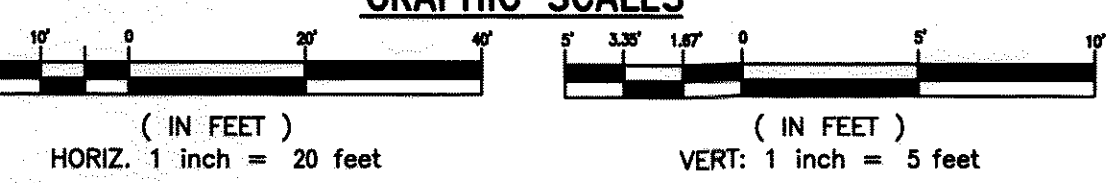

ANGEL LANE INTERCONNECTION

24" WATER MAIN PLAN - PROFILE
STA. 50+00 TO STA. 55+00

REV	DATE	DESCRIPTION

DRAWING	SHEET
C1.13	13