
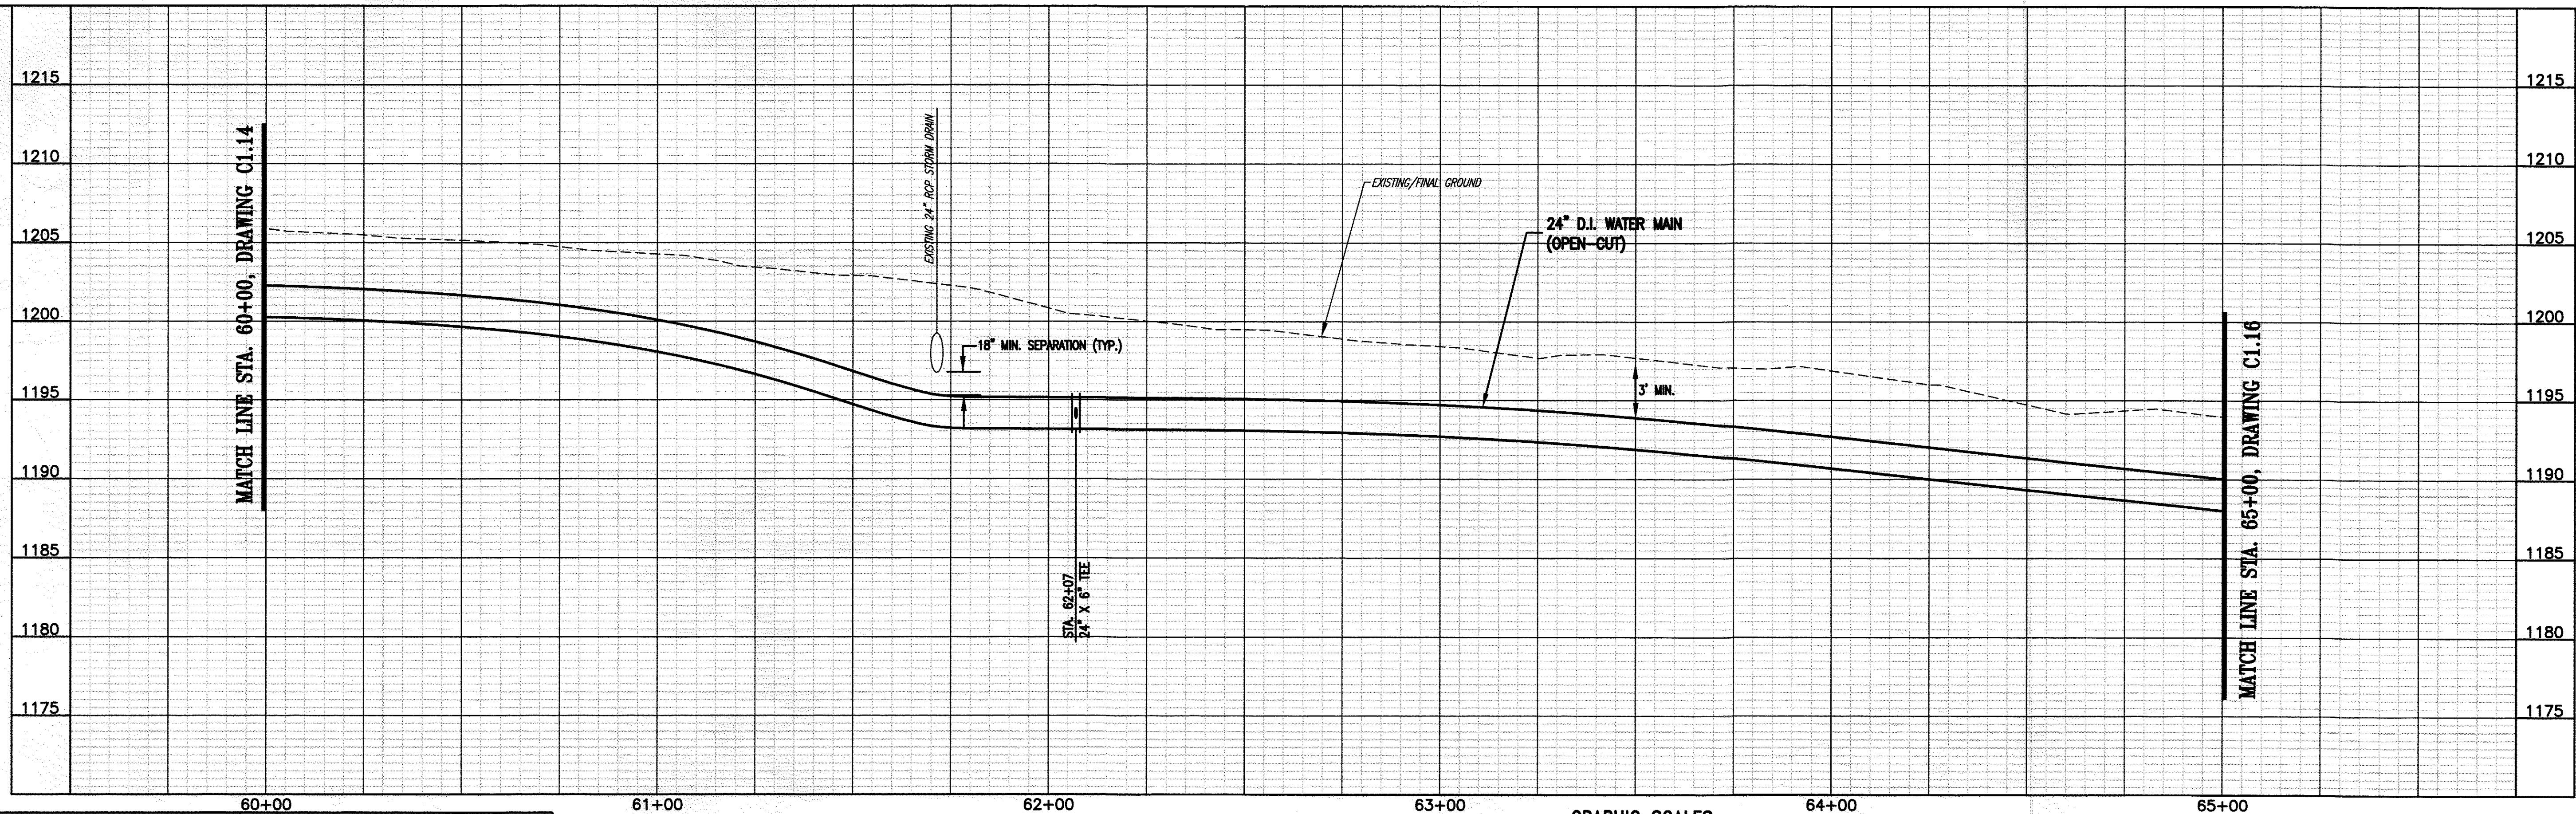


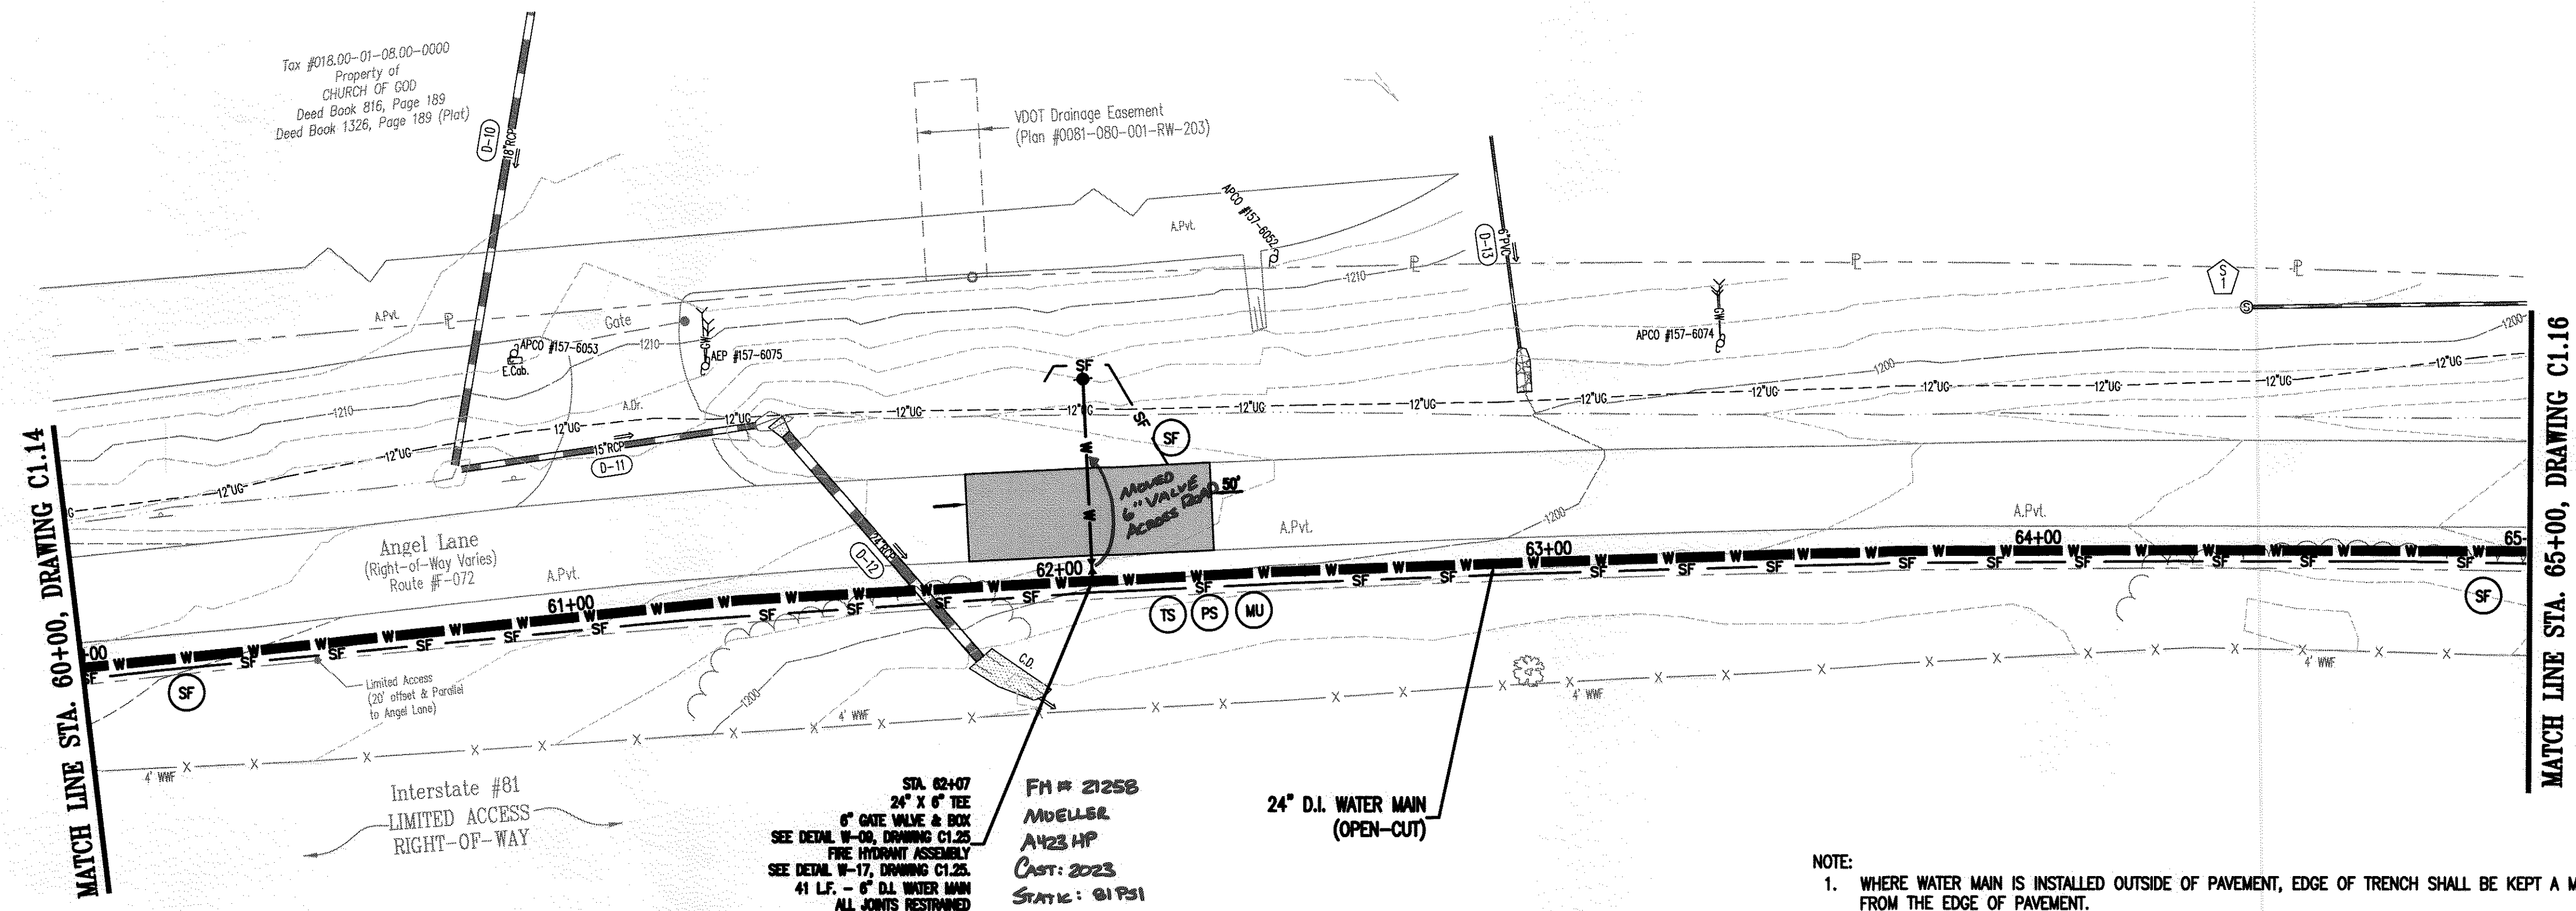

	WESTERN VIRGINIA WATER AUTHORITY 601 South Jefferson Street, Suite 300 Roanoke, Virginia 24011	DES: BP DRAWN: JES CHECK: PJM DATE: 6/20/23	SCALE: AS SHOWN HORIZ: 1" = 20' VERT: 1" = 5'	ANGEL LANE INTERCONNECTION	24" WATER MAIN PLAN - PROFILE STA. 60+00 TO STA. 65+00	DRAWING C1.15	SHEET 15
--	---	--	--	-----------------------------------	---	--------------------------	---------------------