



Tax #018-00-01-08-00-0000
Property of
CHURCH OF GOD
Deed Book 816, Page 189
Deed Book 1326, Page 189 (Plot)

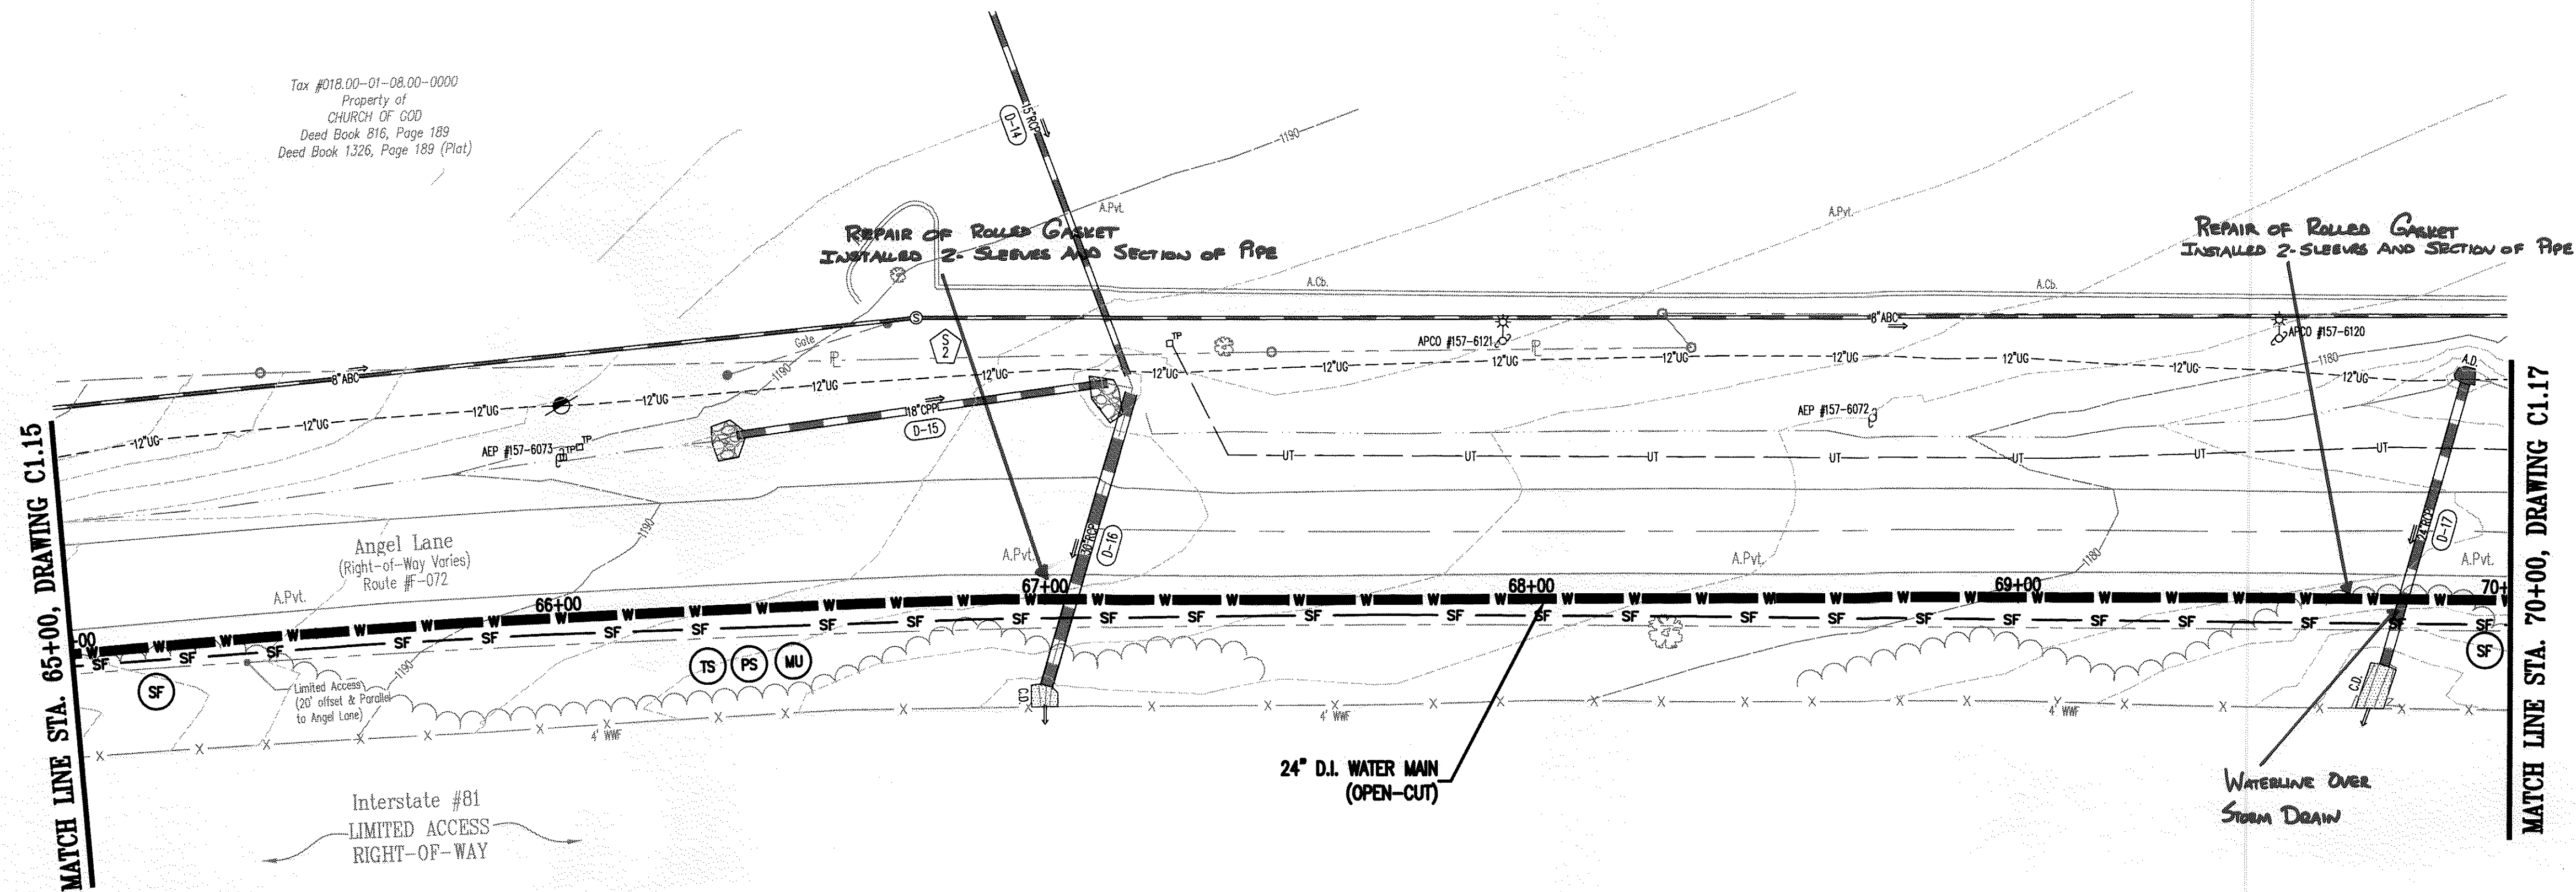

NOTE:
1. WHERE WATER MAIN IS INSTALLED OUTSIDE OF PAVEMENT, EDGE OF TRENCH SHALL BE KEPT A MINIMUM OF 2' FROM THE EDGE OF PAVEMENT.

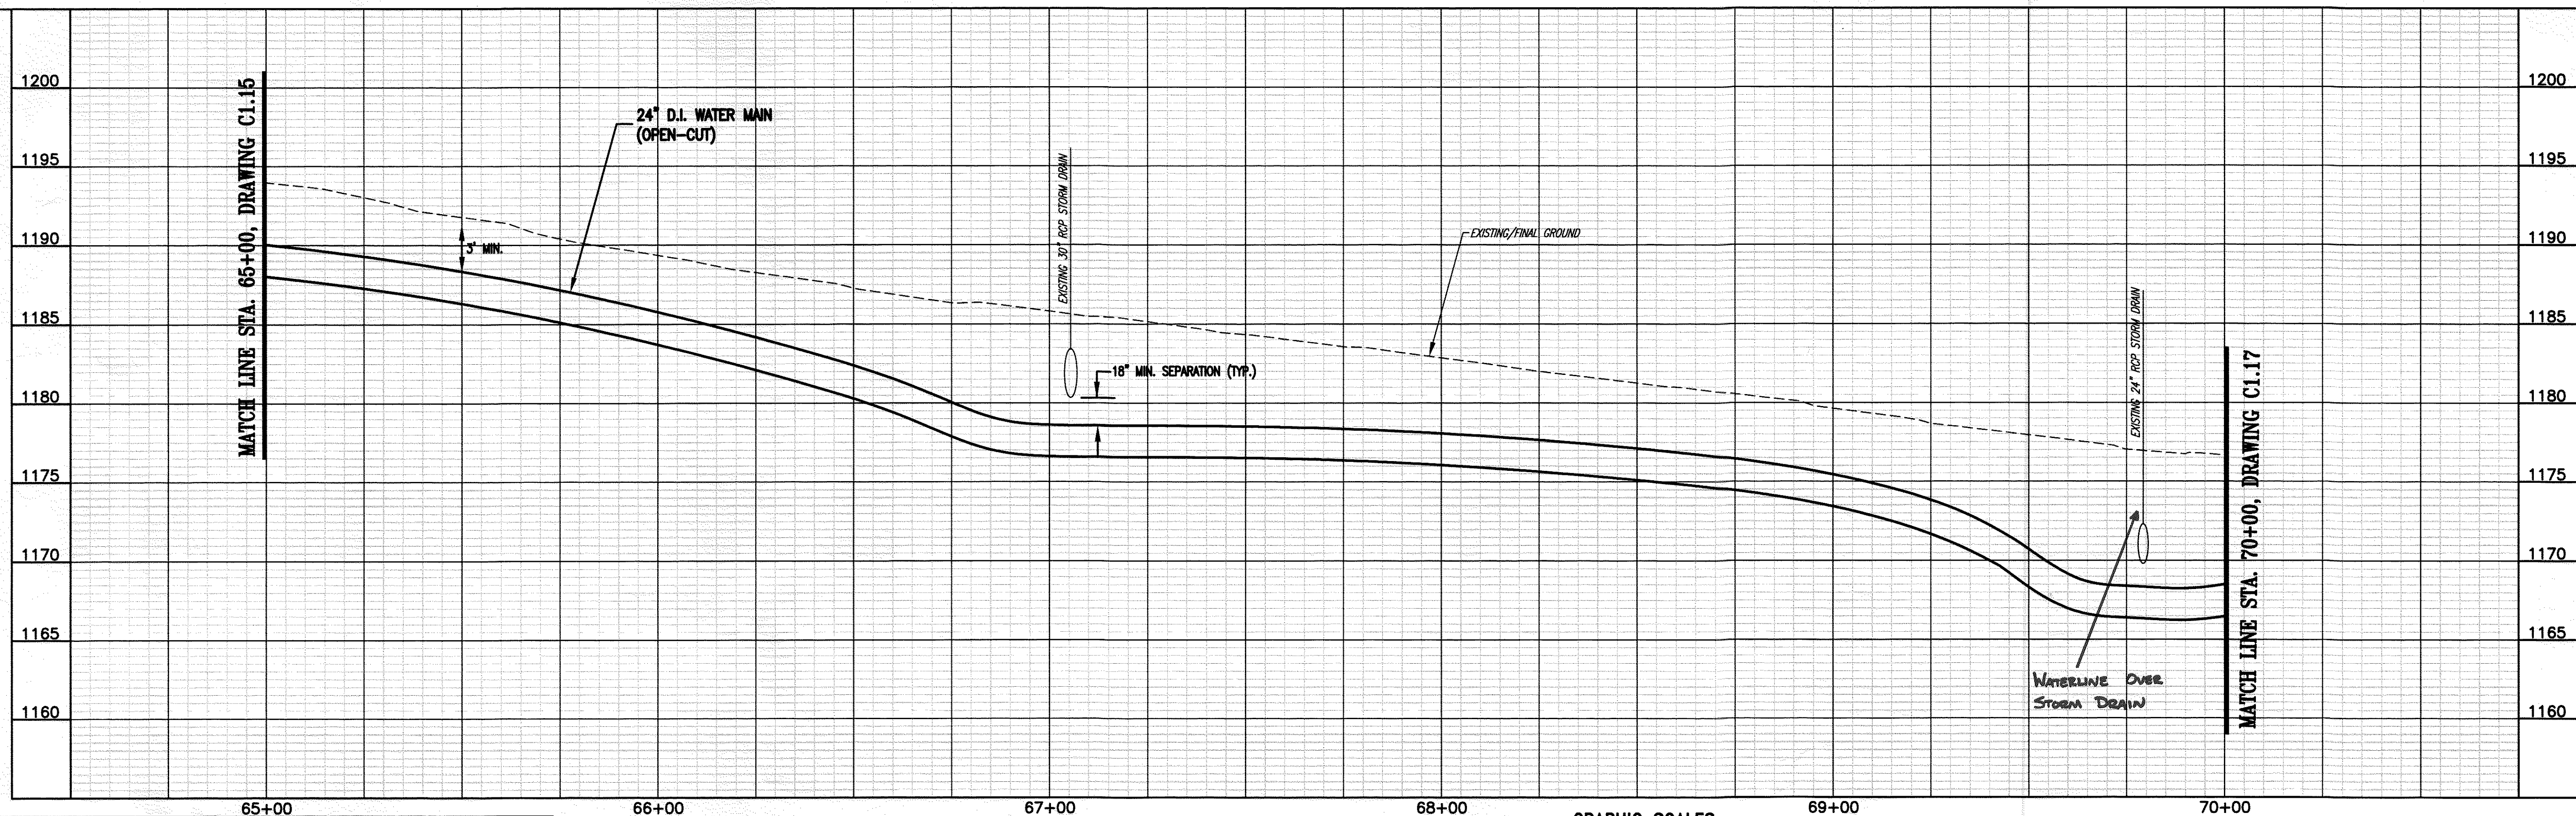

WESTERN VIRGINIA WATER AUTHORITY
601 South Jefferson Street, Suite 300
Roanoke, Virginia 24011

DES: BF
DRAWN: JES
CHECK: PJM
DATE: 6/20/23

SCALE: AS SHOWN
HORIZ: 1" = 20'
VERT: 1" = 5'

ANGEL LANE INTERCONNECTION

24" WATER MAIN PLAN - PROFILE
STA. 65+00 TO STA. 70+00

REV	DATE	DESCRIPTION

DRAWING: C1.16
SHEET: 16