






NOTE:
1. WHERE WATER MAIN IS INSTALLED OUTSIDE OF PAVEMENT, EDGE OF TRENCH SHALL BE KEPT A MINIMUM OF 2' FROM THE EDGE OF PAVEMENT.

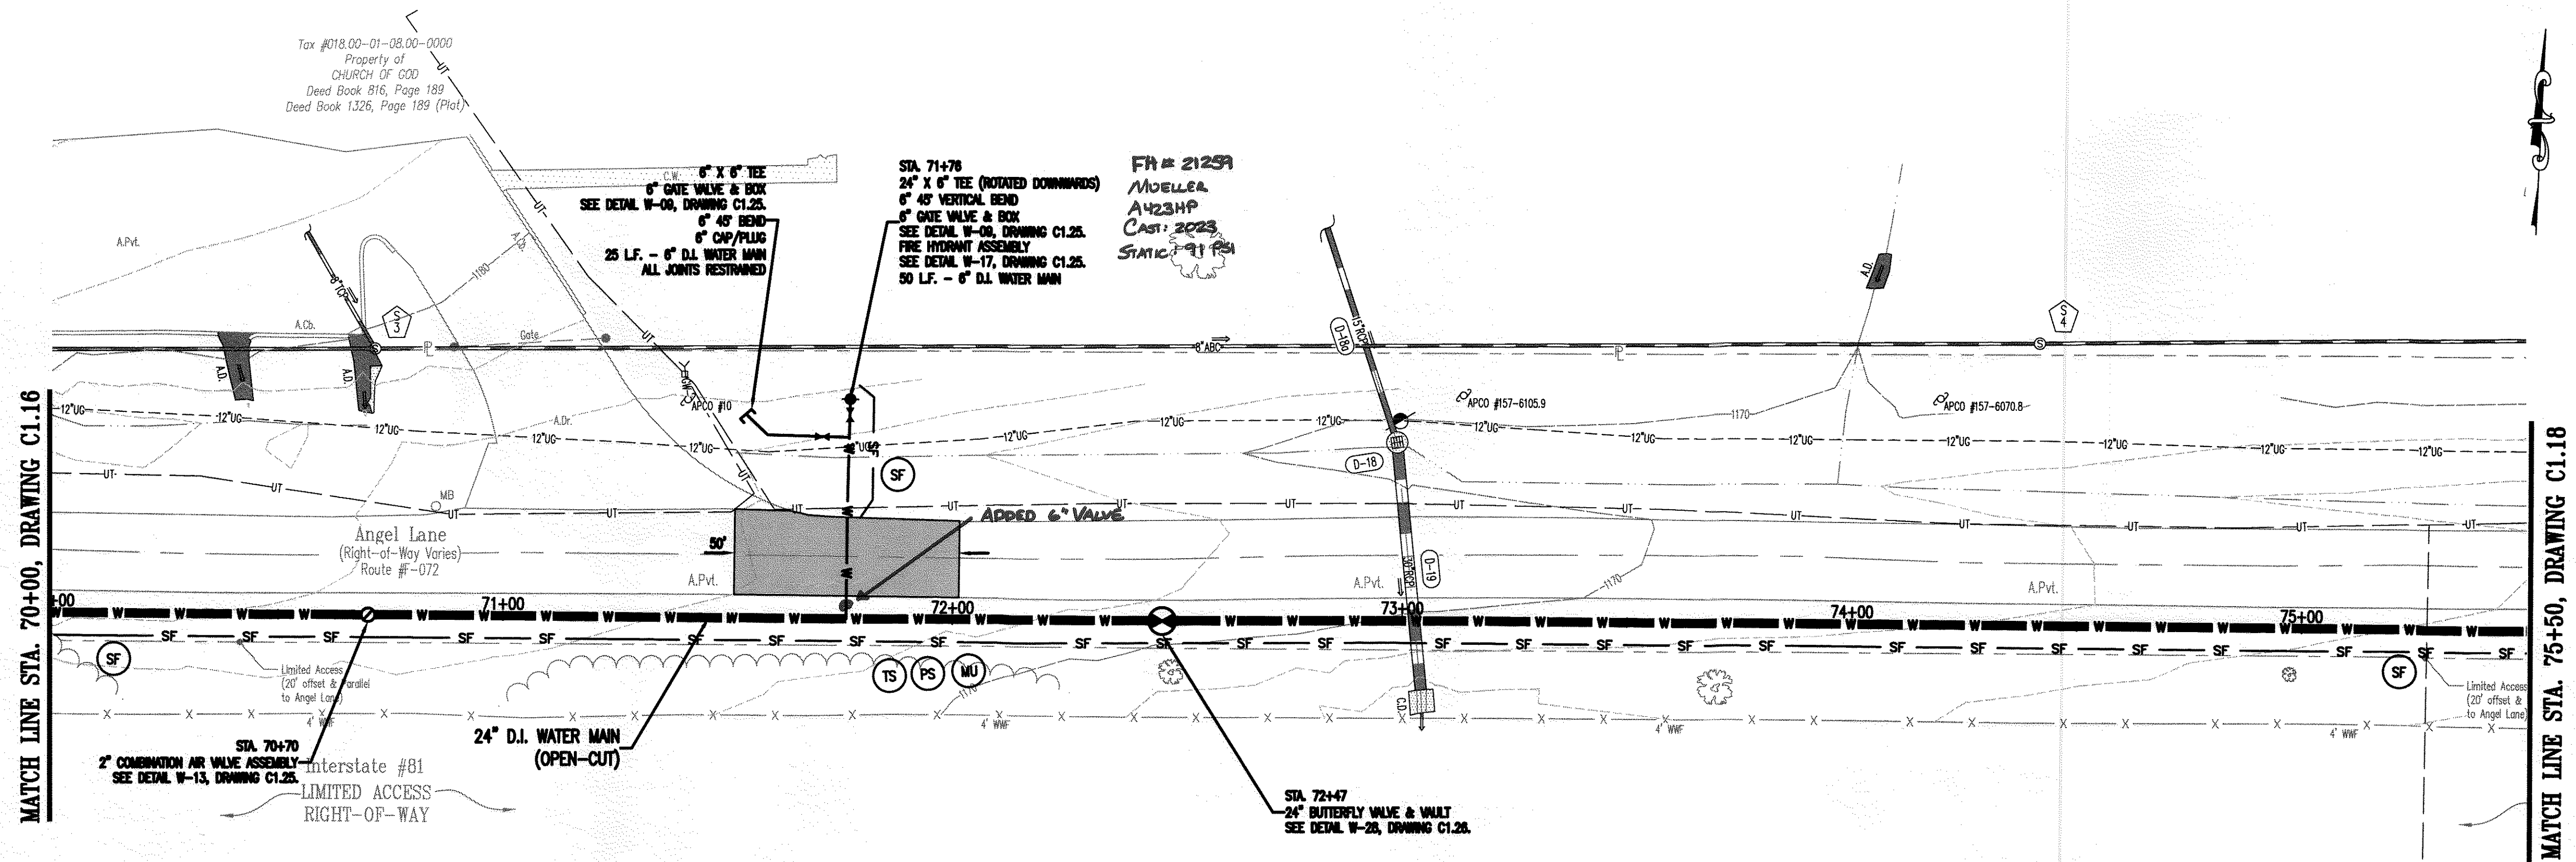

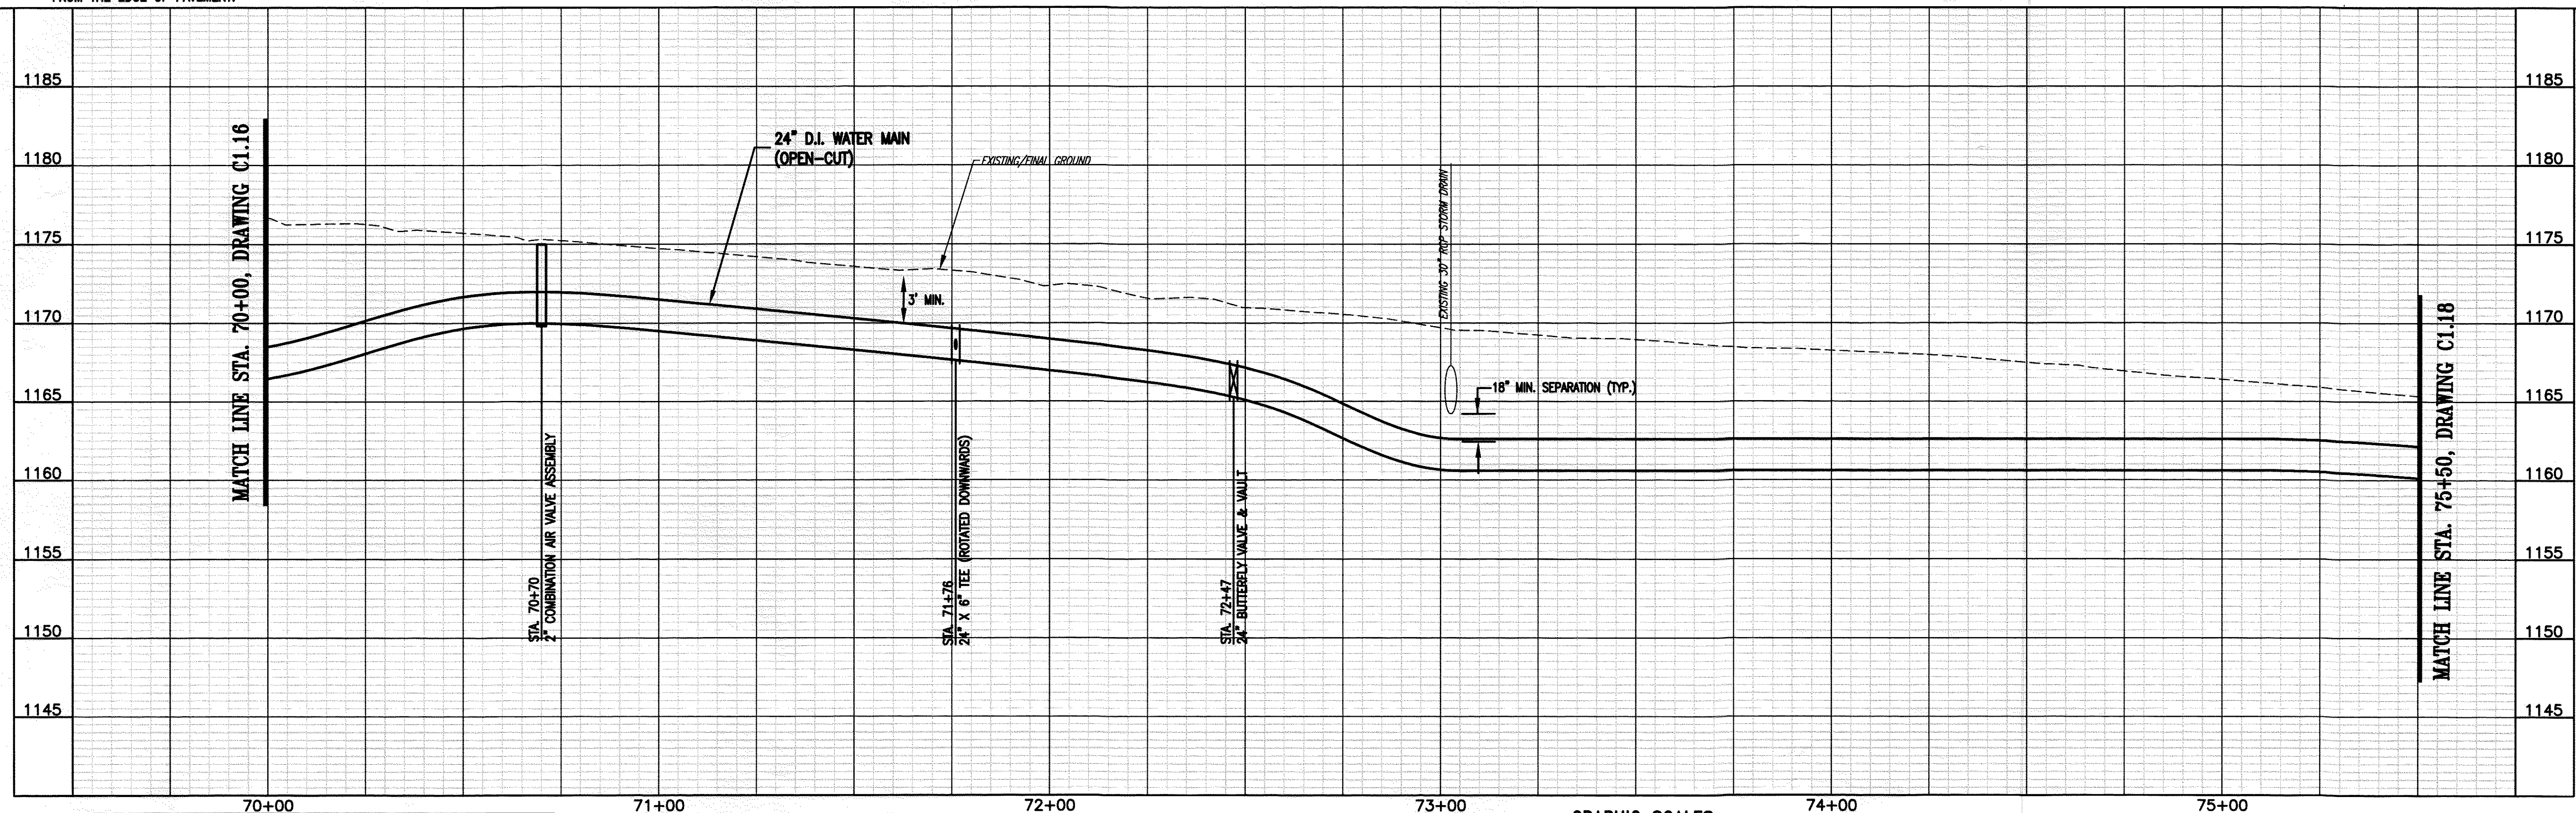

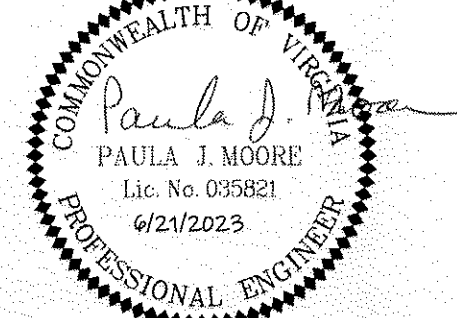

Whitman, Requardt & Associates, LLP
1700 Kraft Dr. Suite 1200, Blacksburg, VA 24060

WESTERN VIRGINIA WATER AUTHORITY
601 South Jefferson Street, Suite 300
Roanoke, Virginia 24011

DES:	BP
DRAWN:	JES
CHECK:	PJM
DATE:	6/20/23

SCALE:	AS SHOWN
HORIZ:	1" = 20'
VERT:	1" = 5'

GRAPHIC SCALES

(IN FEET)
HORIZ. 1 inch = 20 feet

(IN FEET)
VERT. 1 inch = 5 feet

REV	DATE	DESCRIPTION

ANGEL LANE INTERCONNECTION

24" WATER MAIN PLAN - PROFILE
STA. 70+00 TO STA. 75+50

DRAWING
C1.17

SHEET
17