


Tax #018.00-01-08.00-0000
Property of
CHURCH OF GOD
Deed Book 816, Page 189
Deed Book 1326, Page 189 (Plot)

Tax #018.00-01-08.00-0000
Property of
CHURCH OF GOD
(aka RO. CATHEDRAL)
Deed Book 1326, Page 189 (Plot)

MATCH LINE STA. 75+50, DRAWING C1.17


MATCH LINE STA. 81+00, DRAWING C1.19

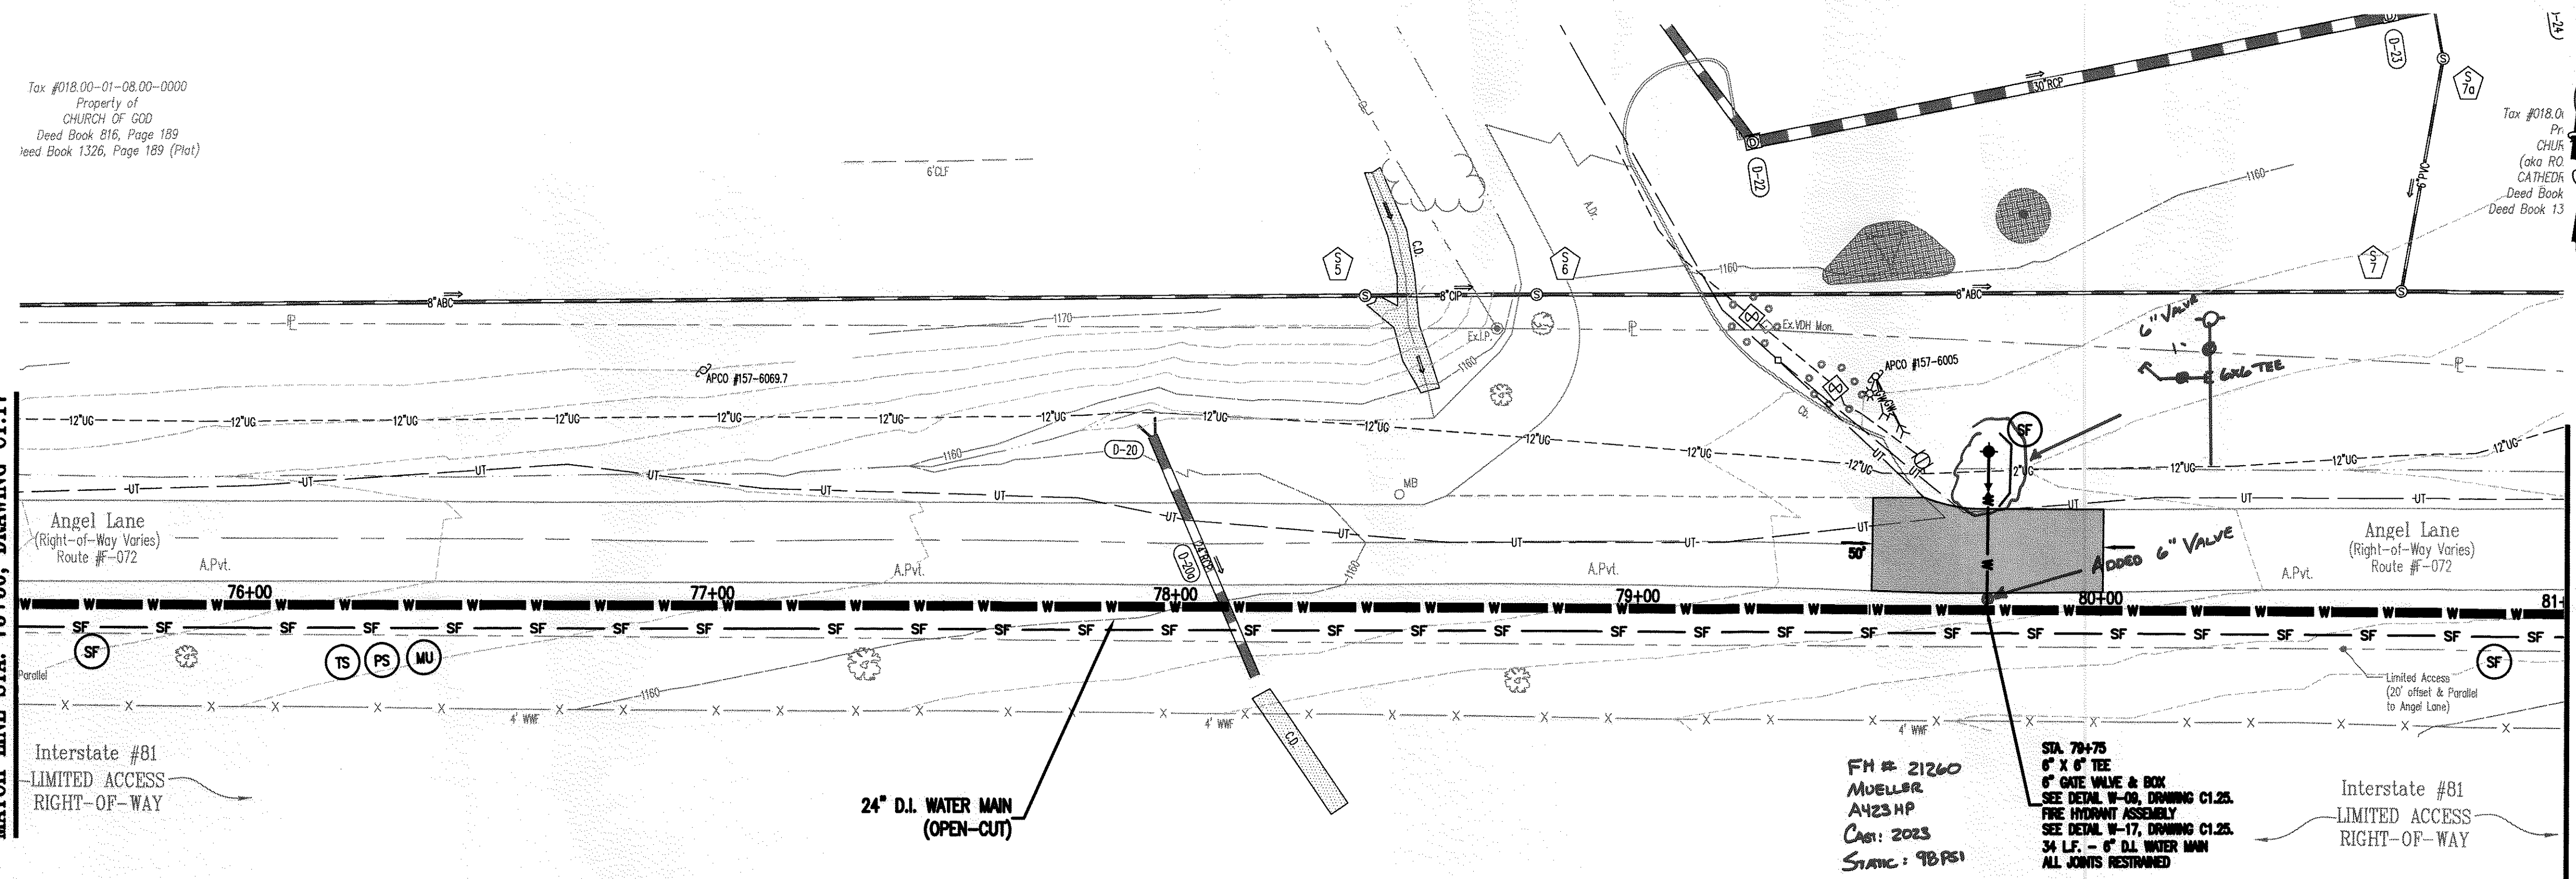

NOTE:
1. WHERE WATER MAIN IS INSTALLED OUTSIDE OF PAVEMENT, EDGE OF TRENCH SHALL BE KEPT A MINIMUM OF 2' FROM THE EDGE OF PAVEMENT.


MATCH LINE STA. 75+50, DRAWING C1.17

MATCH LINE STA. 81+00, DRAWING C1.19

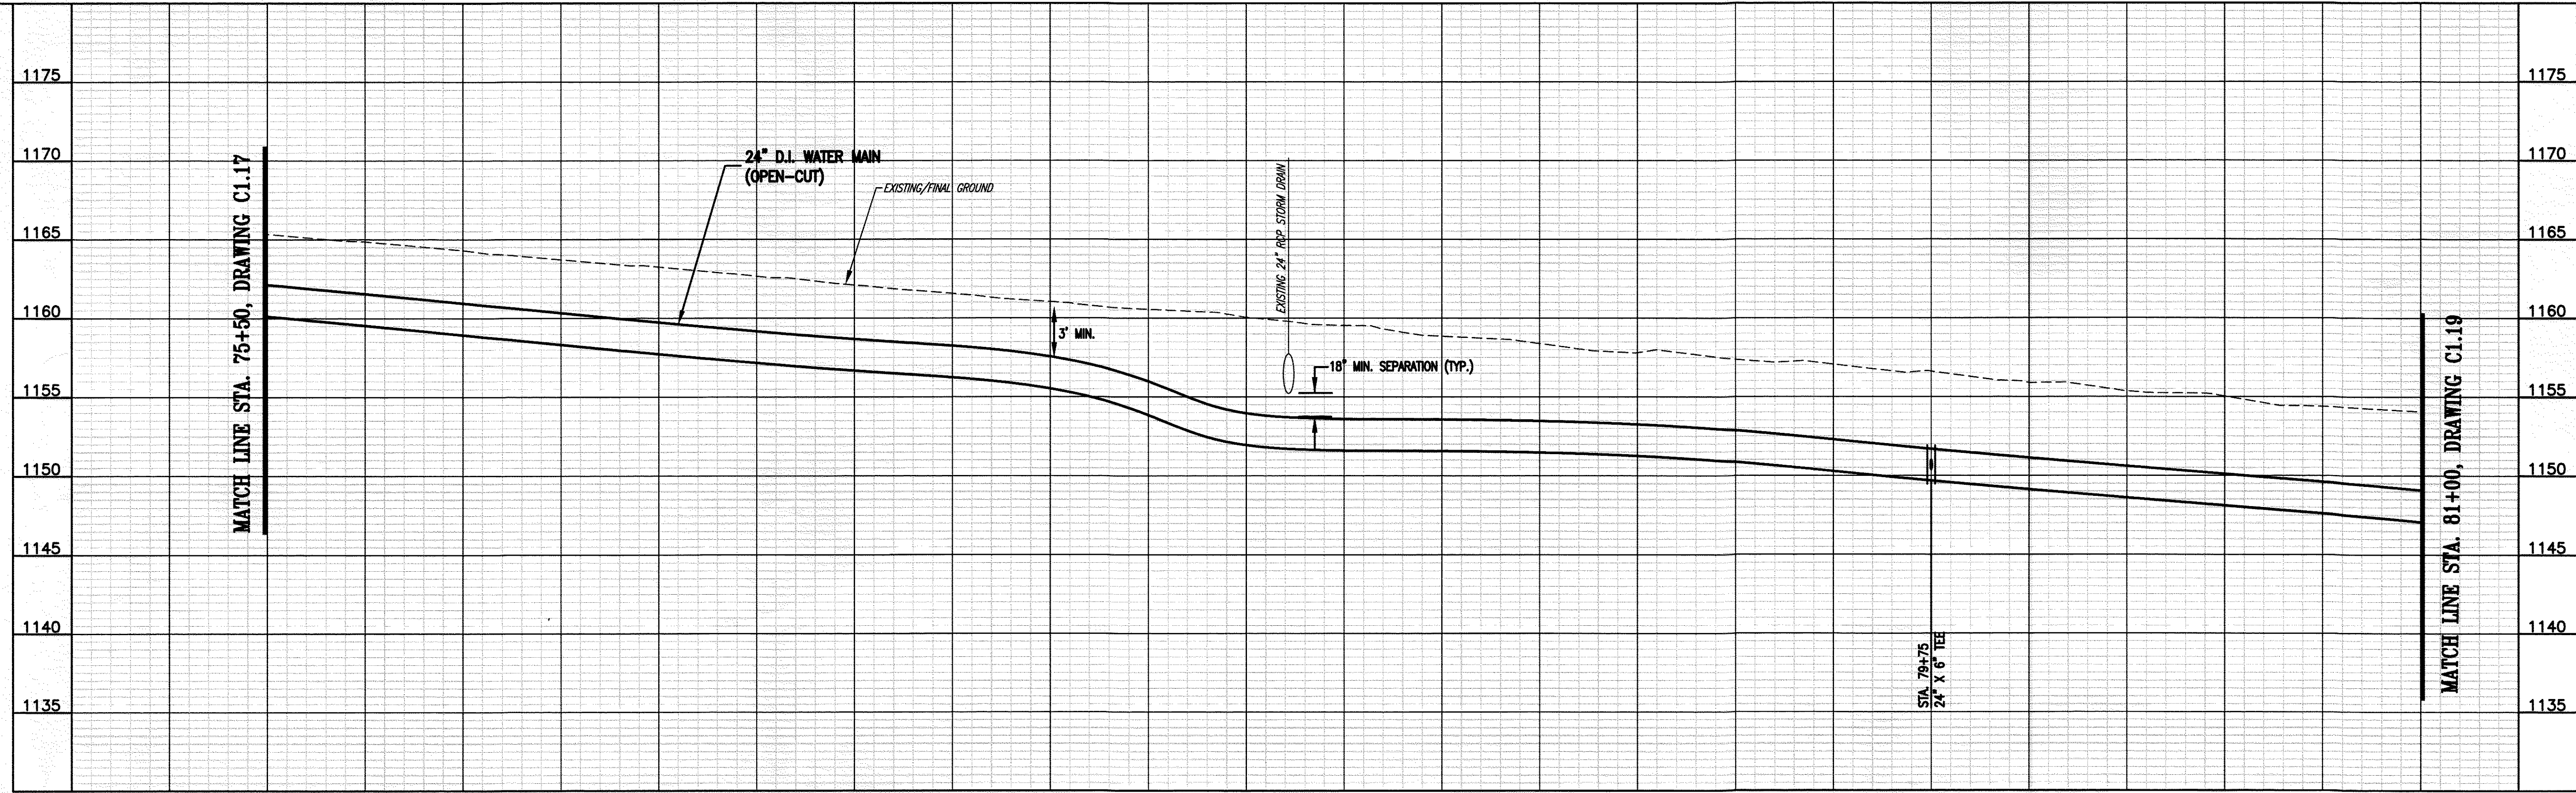


76+00 77+00 78+00 79+00 80+00 81+00

GRAPHIC SCALES

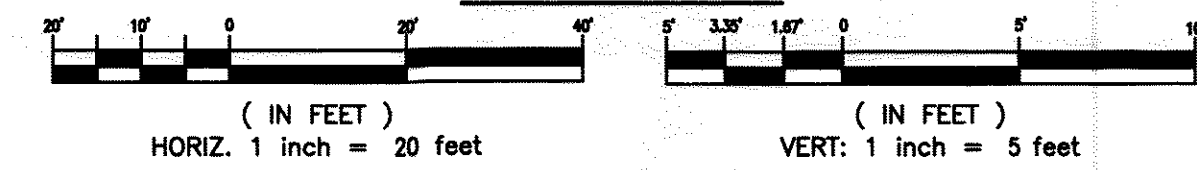

REV	DATE	DESCRIPTION

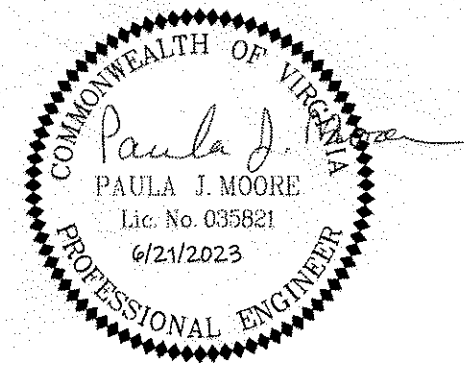

WESTERN VIRGINIA WATER AUTHORITY
601 South Jefferson Street, Suite 300
Roanoke, Virginia 24011

DES: JF
DRAWN: JES
CHECK: PJM
DATE: 6/20/23

SCALE: AS SHOWN
HORIZ: 1" = 20'
VERT: 1" = 5'

ANGEL LANE INTERCONNECTION

24" WATER MAIN PLAN - PROFILE
STA. 75+50 TO STA. 81+00

DRAWING
C1.18

SHEET
18