



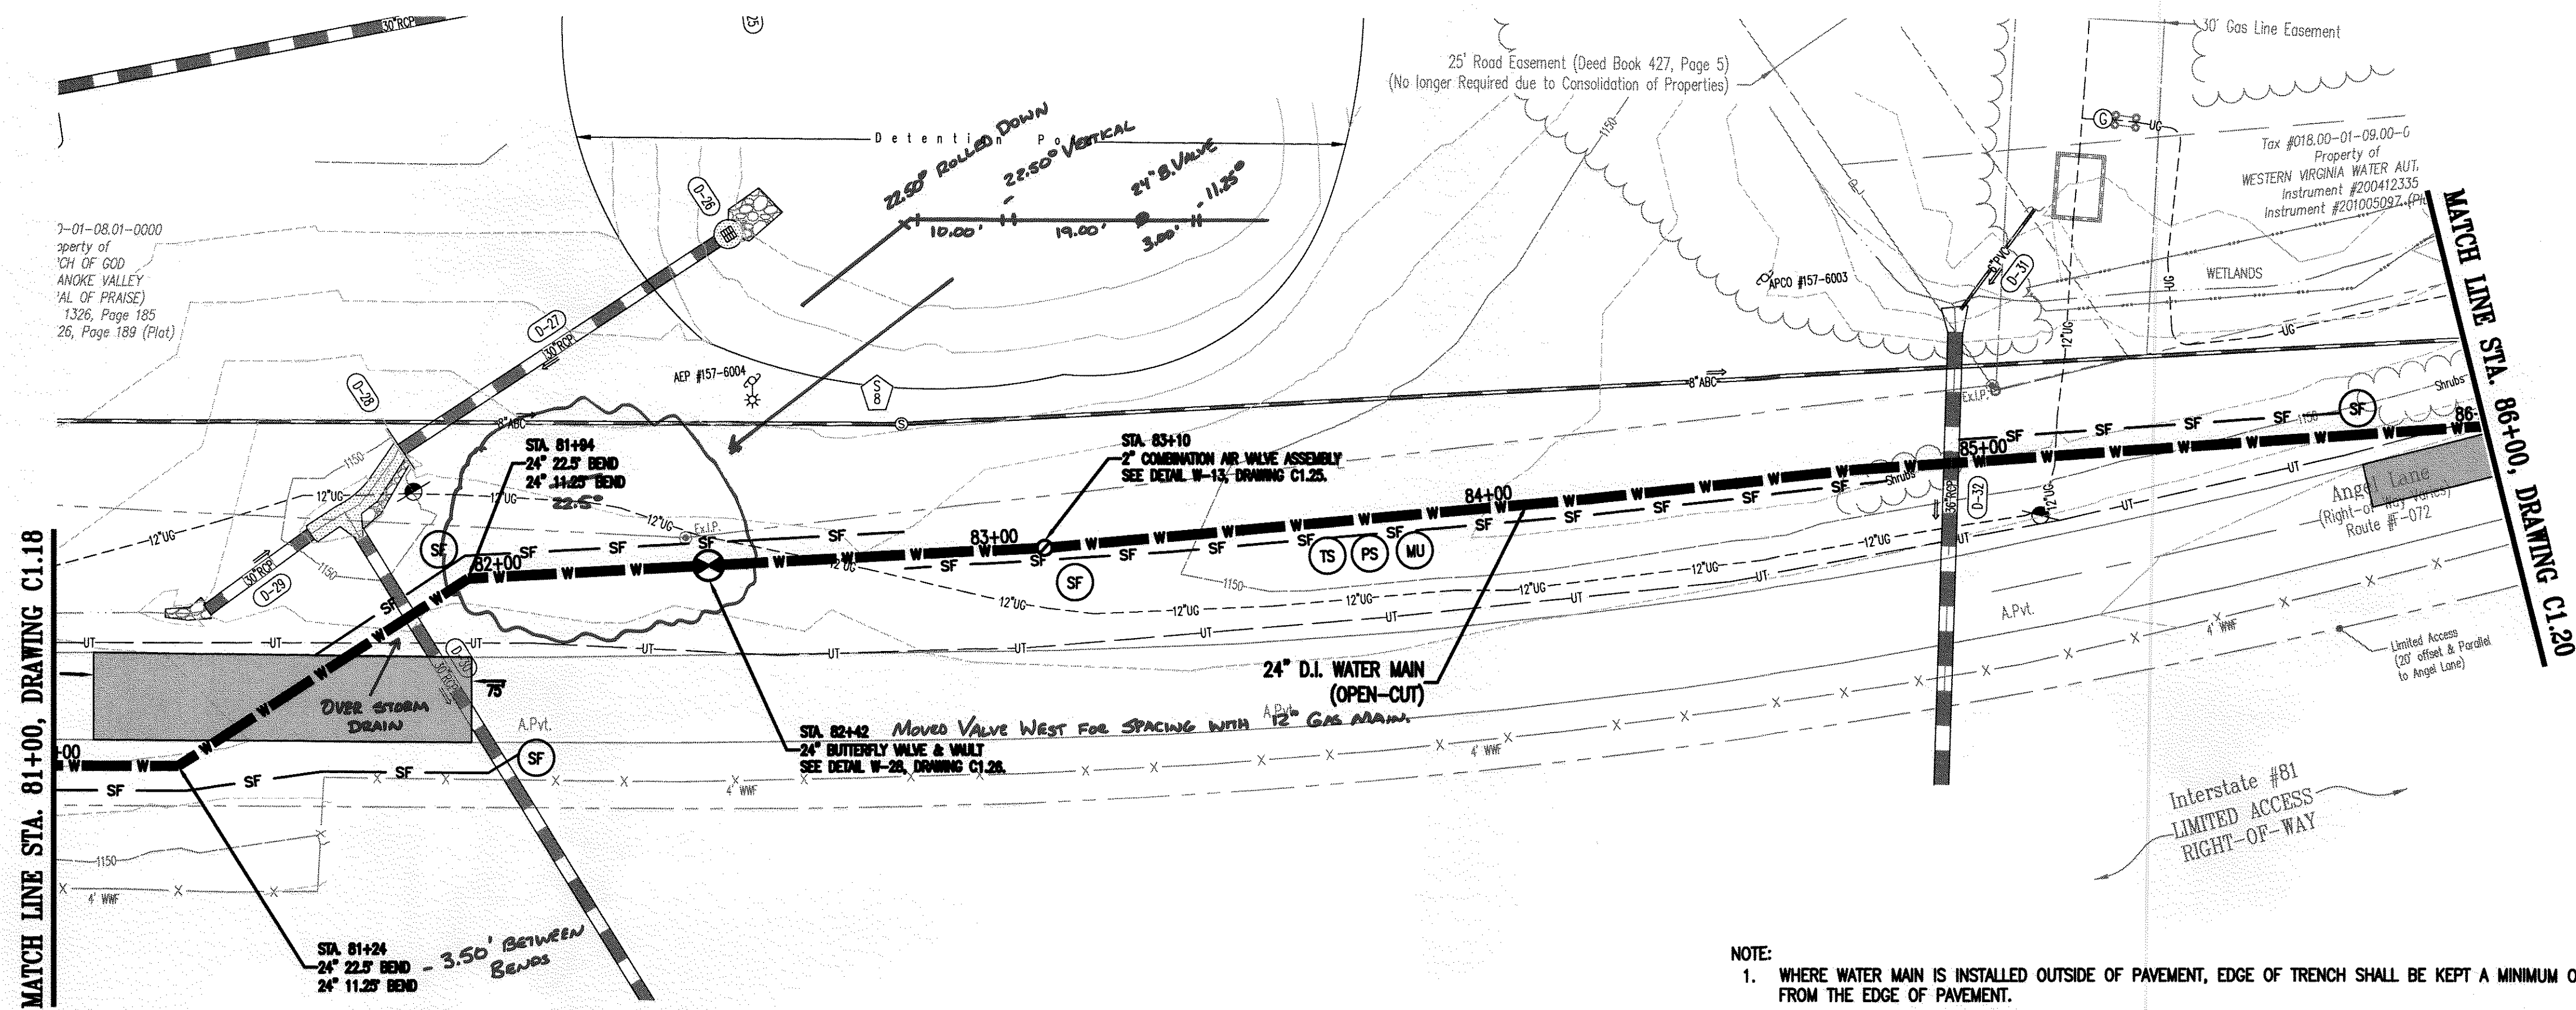

NOTE:
1. WHERE WATER MAIN IS INSTALLED OUTSIDE OF PAVEMENT, EDGE OF TRENCH SHALL BE KEPT A MINIMUM OF 2' FROM THE EDGE OF PAVEMENT.

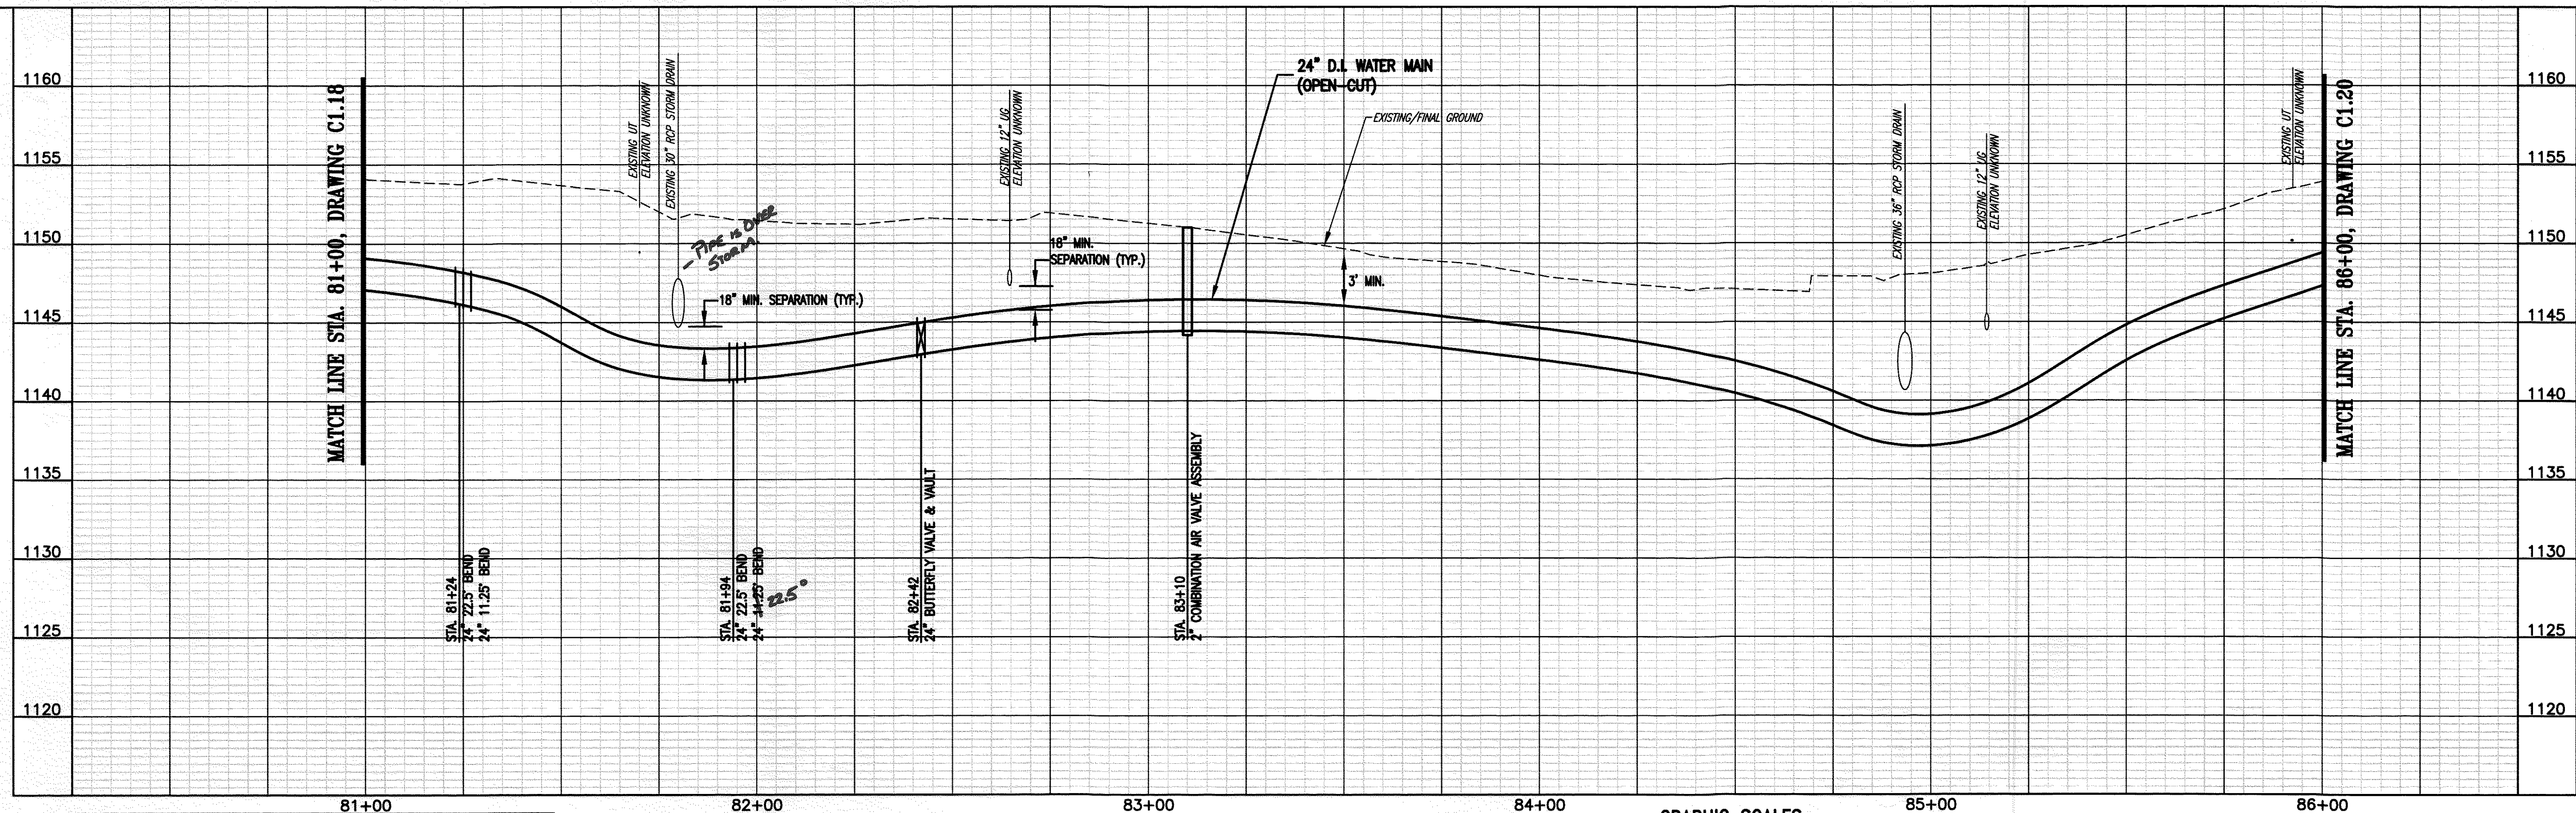

1160 1155 1150 1145 1140 1135 1130 1125 1120

81+00 82+00 83+00 84+00 85+00 86+00



		WESTERN VIRGINIA WATER AUTHORITY 601 South Jefferson Street, Suite 300 Roanoke, Virginia 24011	DES: BP DRAWN: JES CHECK: PJM DATE: 6/20/23	SCALE: AS SHOWN HORIZ: 1" = 20' VERT: 1" = 5'	ANGEL LANE INTERCONNECTION	24" WATER MAIN PLAN - PROFILE STA. 81+00 TO STA. 86+00	DRAWING C1.19	SHEET 19
--	--	---	--	---	----------------------------	--	-------------------------	--------------------