
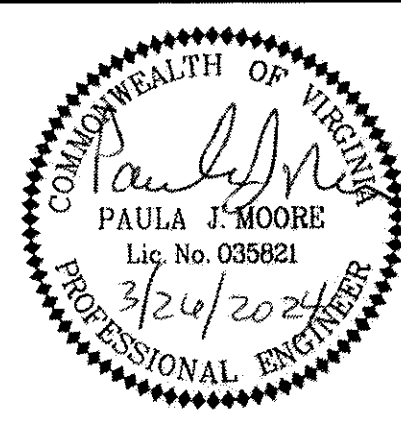
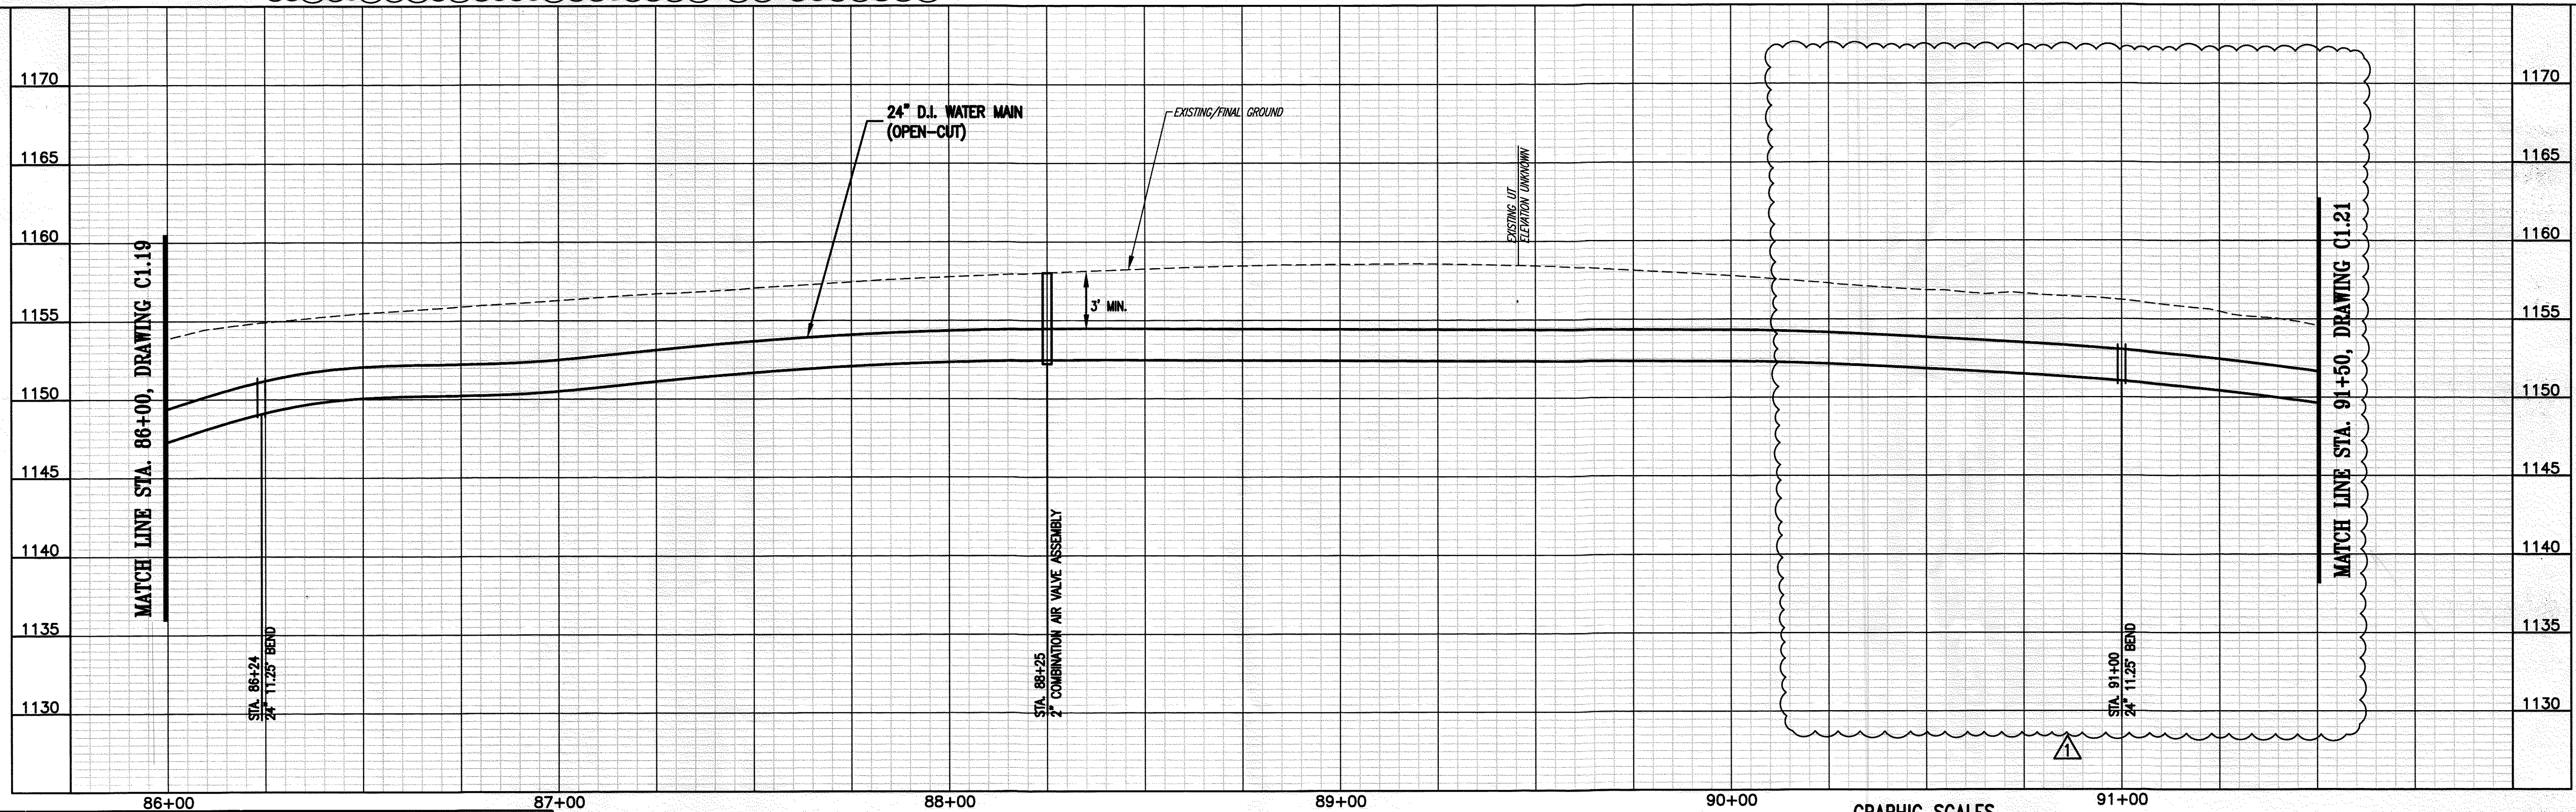


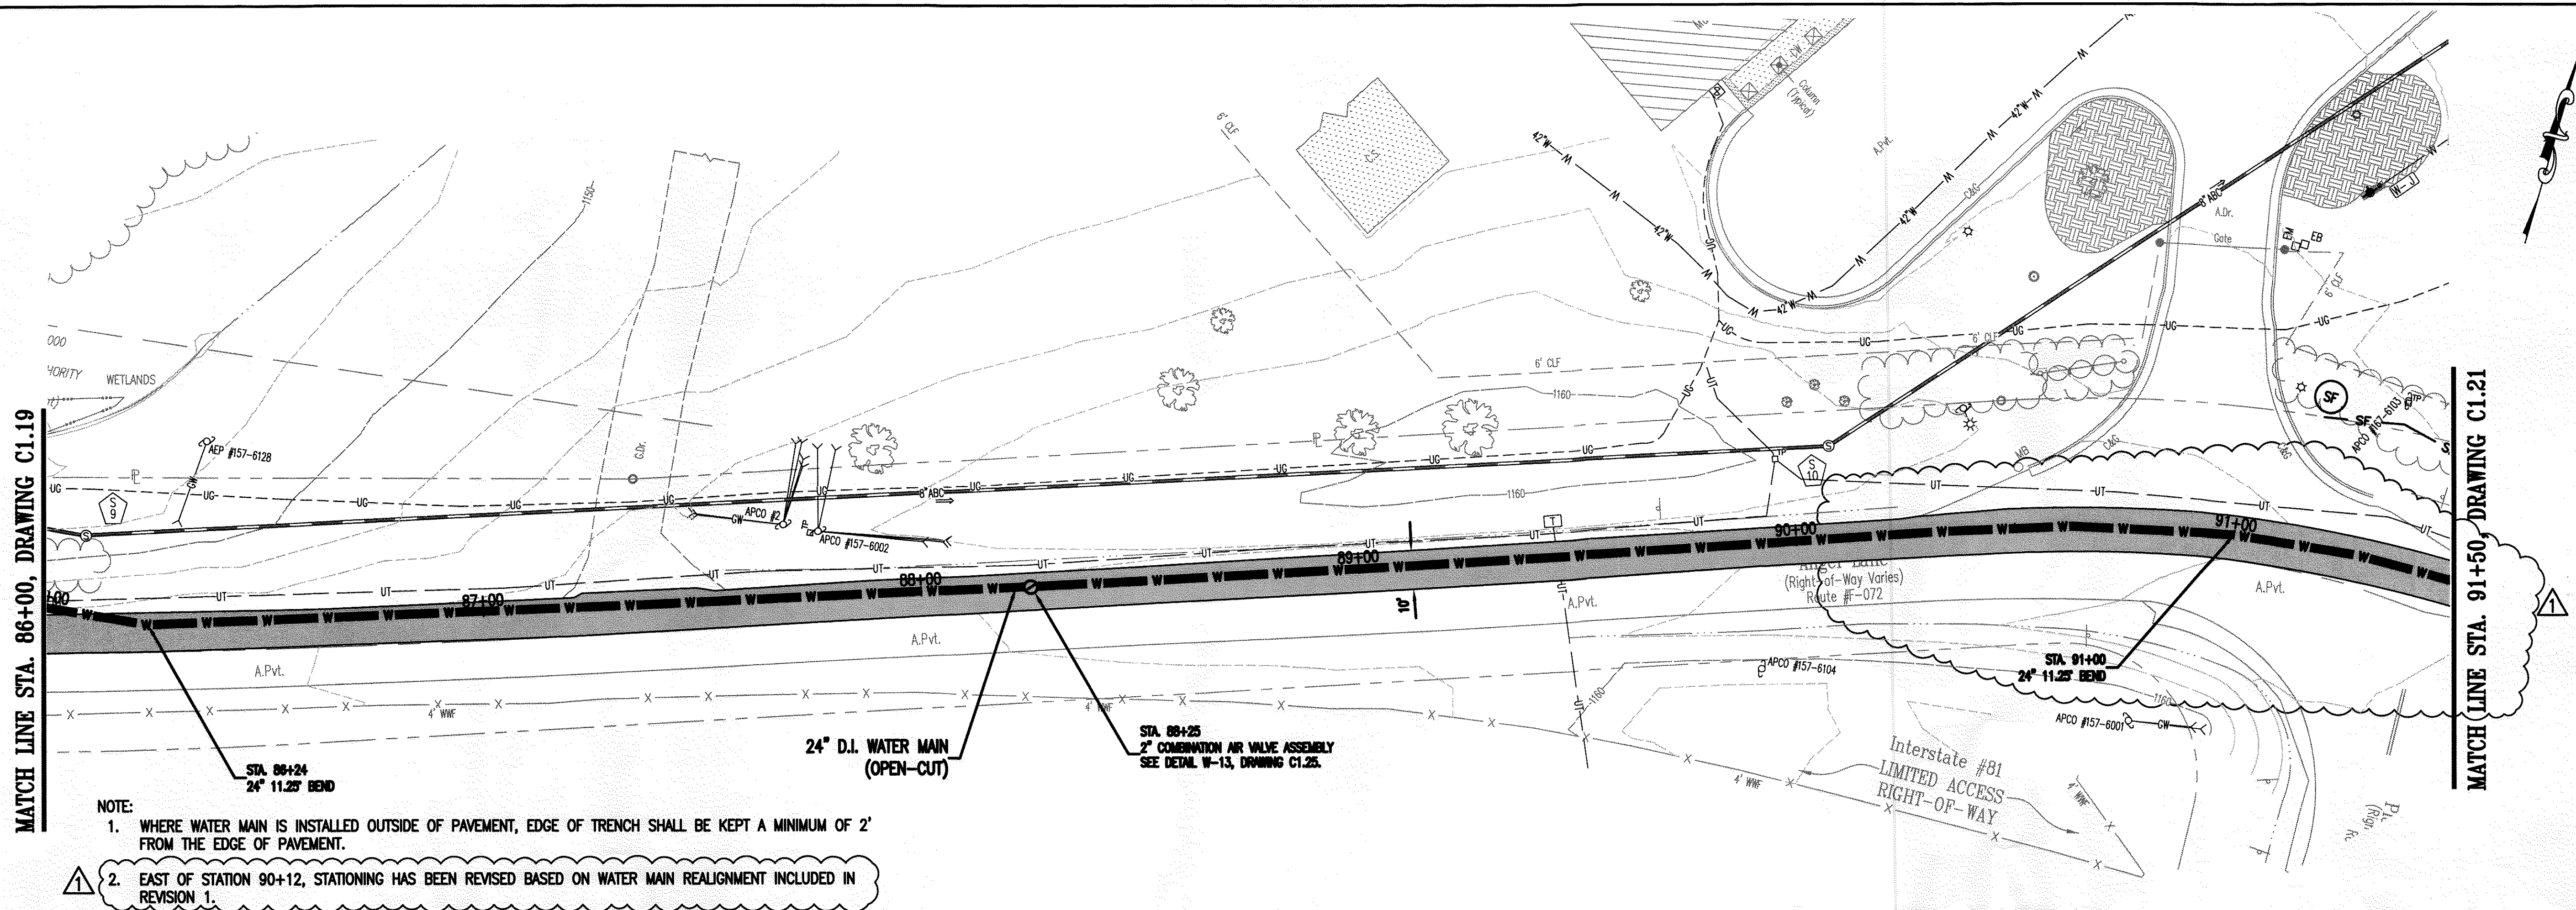


WESTERN VIRGINIA WATER AUTHORITY
601 South Jefferson Street, Suite 300
Roanoke, Virginia 24011

DES: BF
DRAWN: JES
CHECK: PJM
DATE: 6/20/23

SCALE: AS SHOWN
HORIZ: 1" = 20'
VERT: 1" = 5'

ANGEL LANE INTERCONNECTION

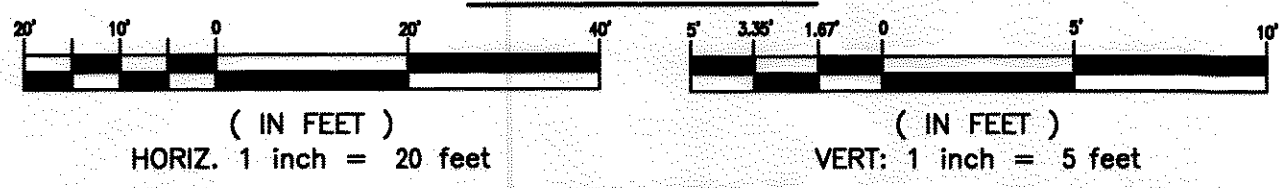

24" WATER MAIN PLAN - PROFILE
STA. 86+00 TO STA. 91+50

REV	DATE	DESCRIPTION	DRAWING	SHEET
1	3/26/24	WATER MAIN REALIGNMENT	C1.20	20