


AS-BUILT
REC. 7.26.2004
FROM CHUCK CLARK

Archbold Ave NE.
1900 Blk in Alleyway


Installed
a New 8"
Sewer Main
6-30-04
G.M. Smith

Archbold Ave NE

T# 3221259

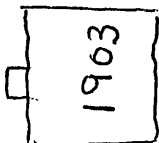

T# 3221259

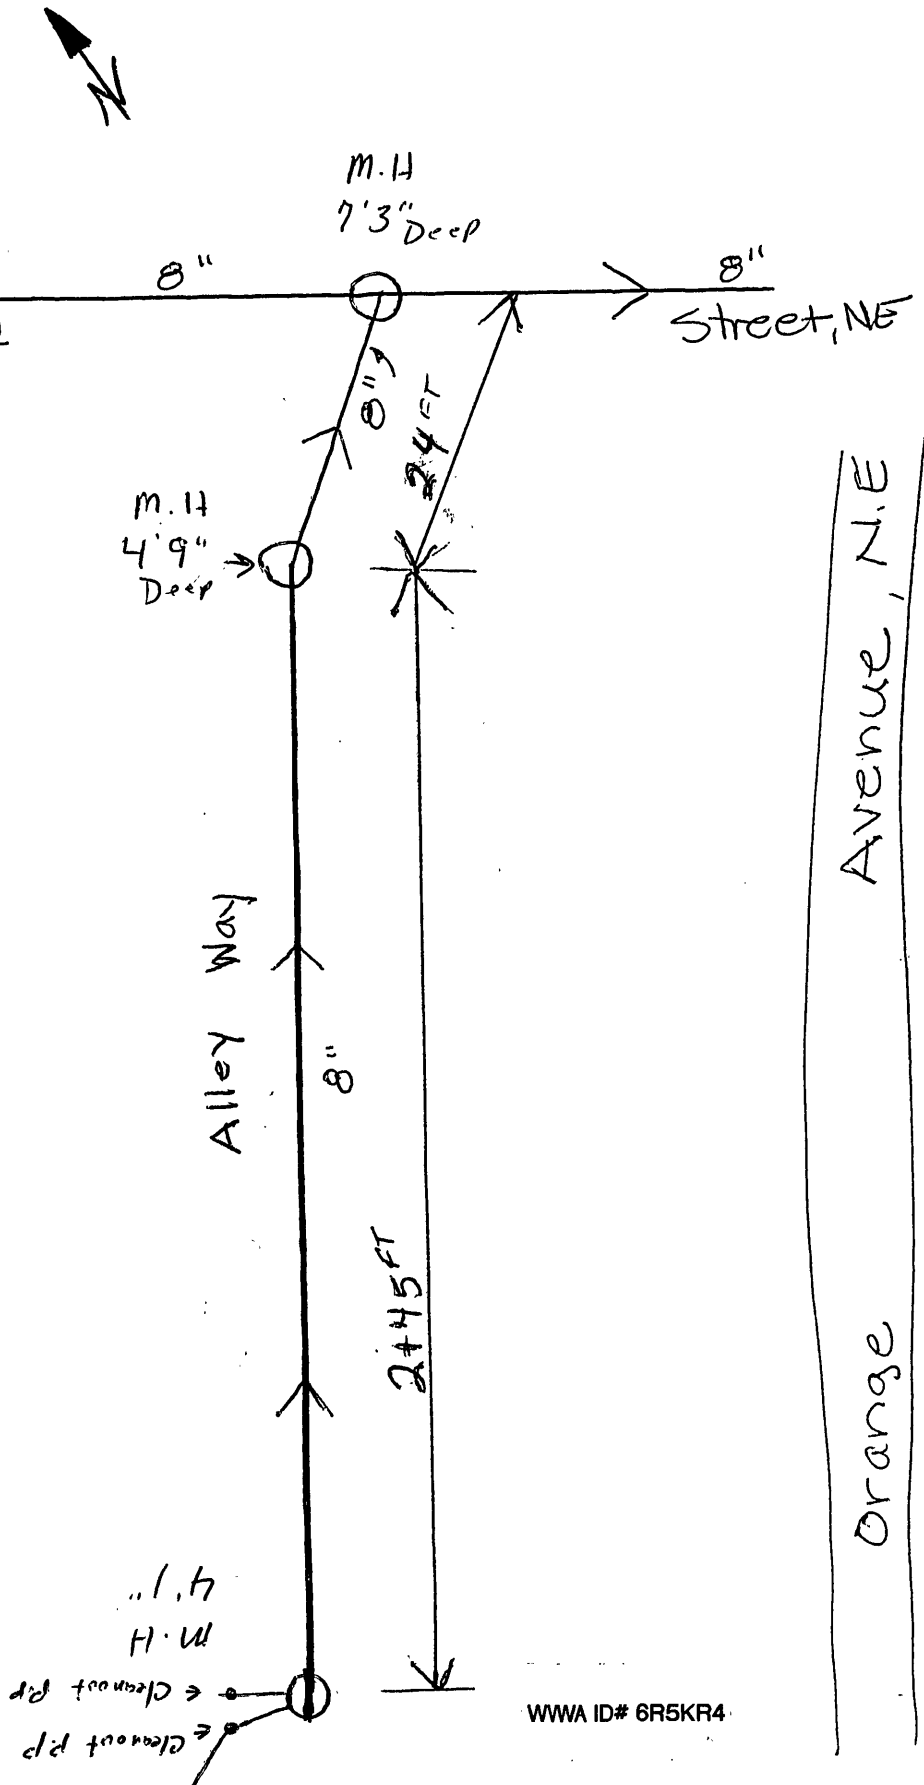

WWA ID# 6R5KR4