


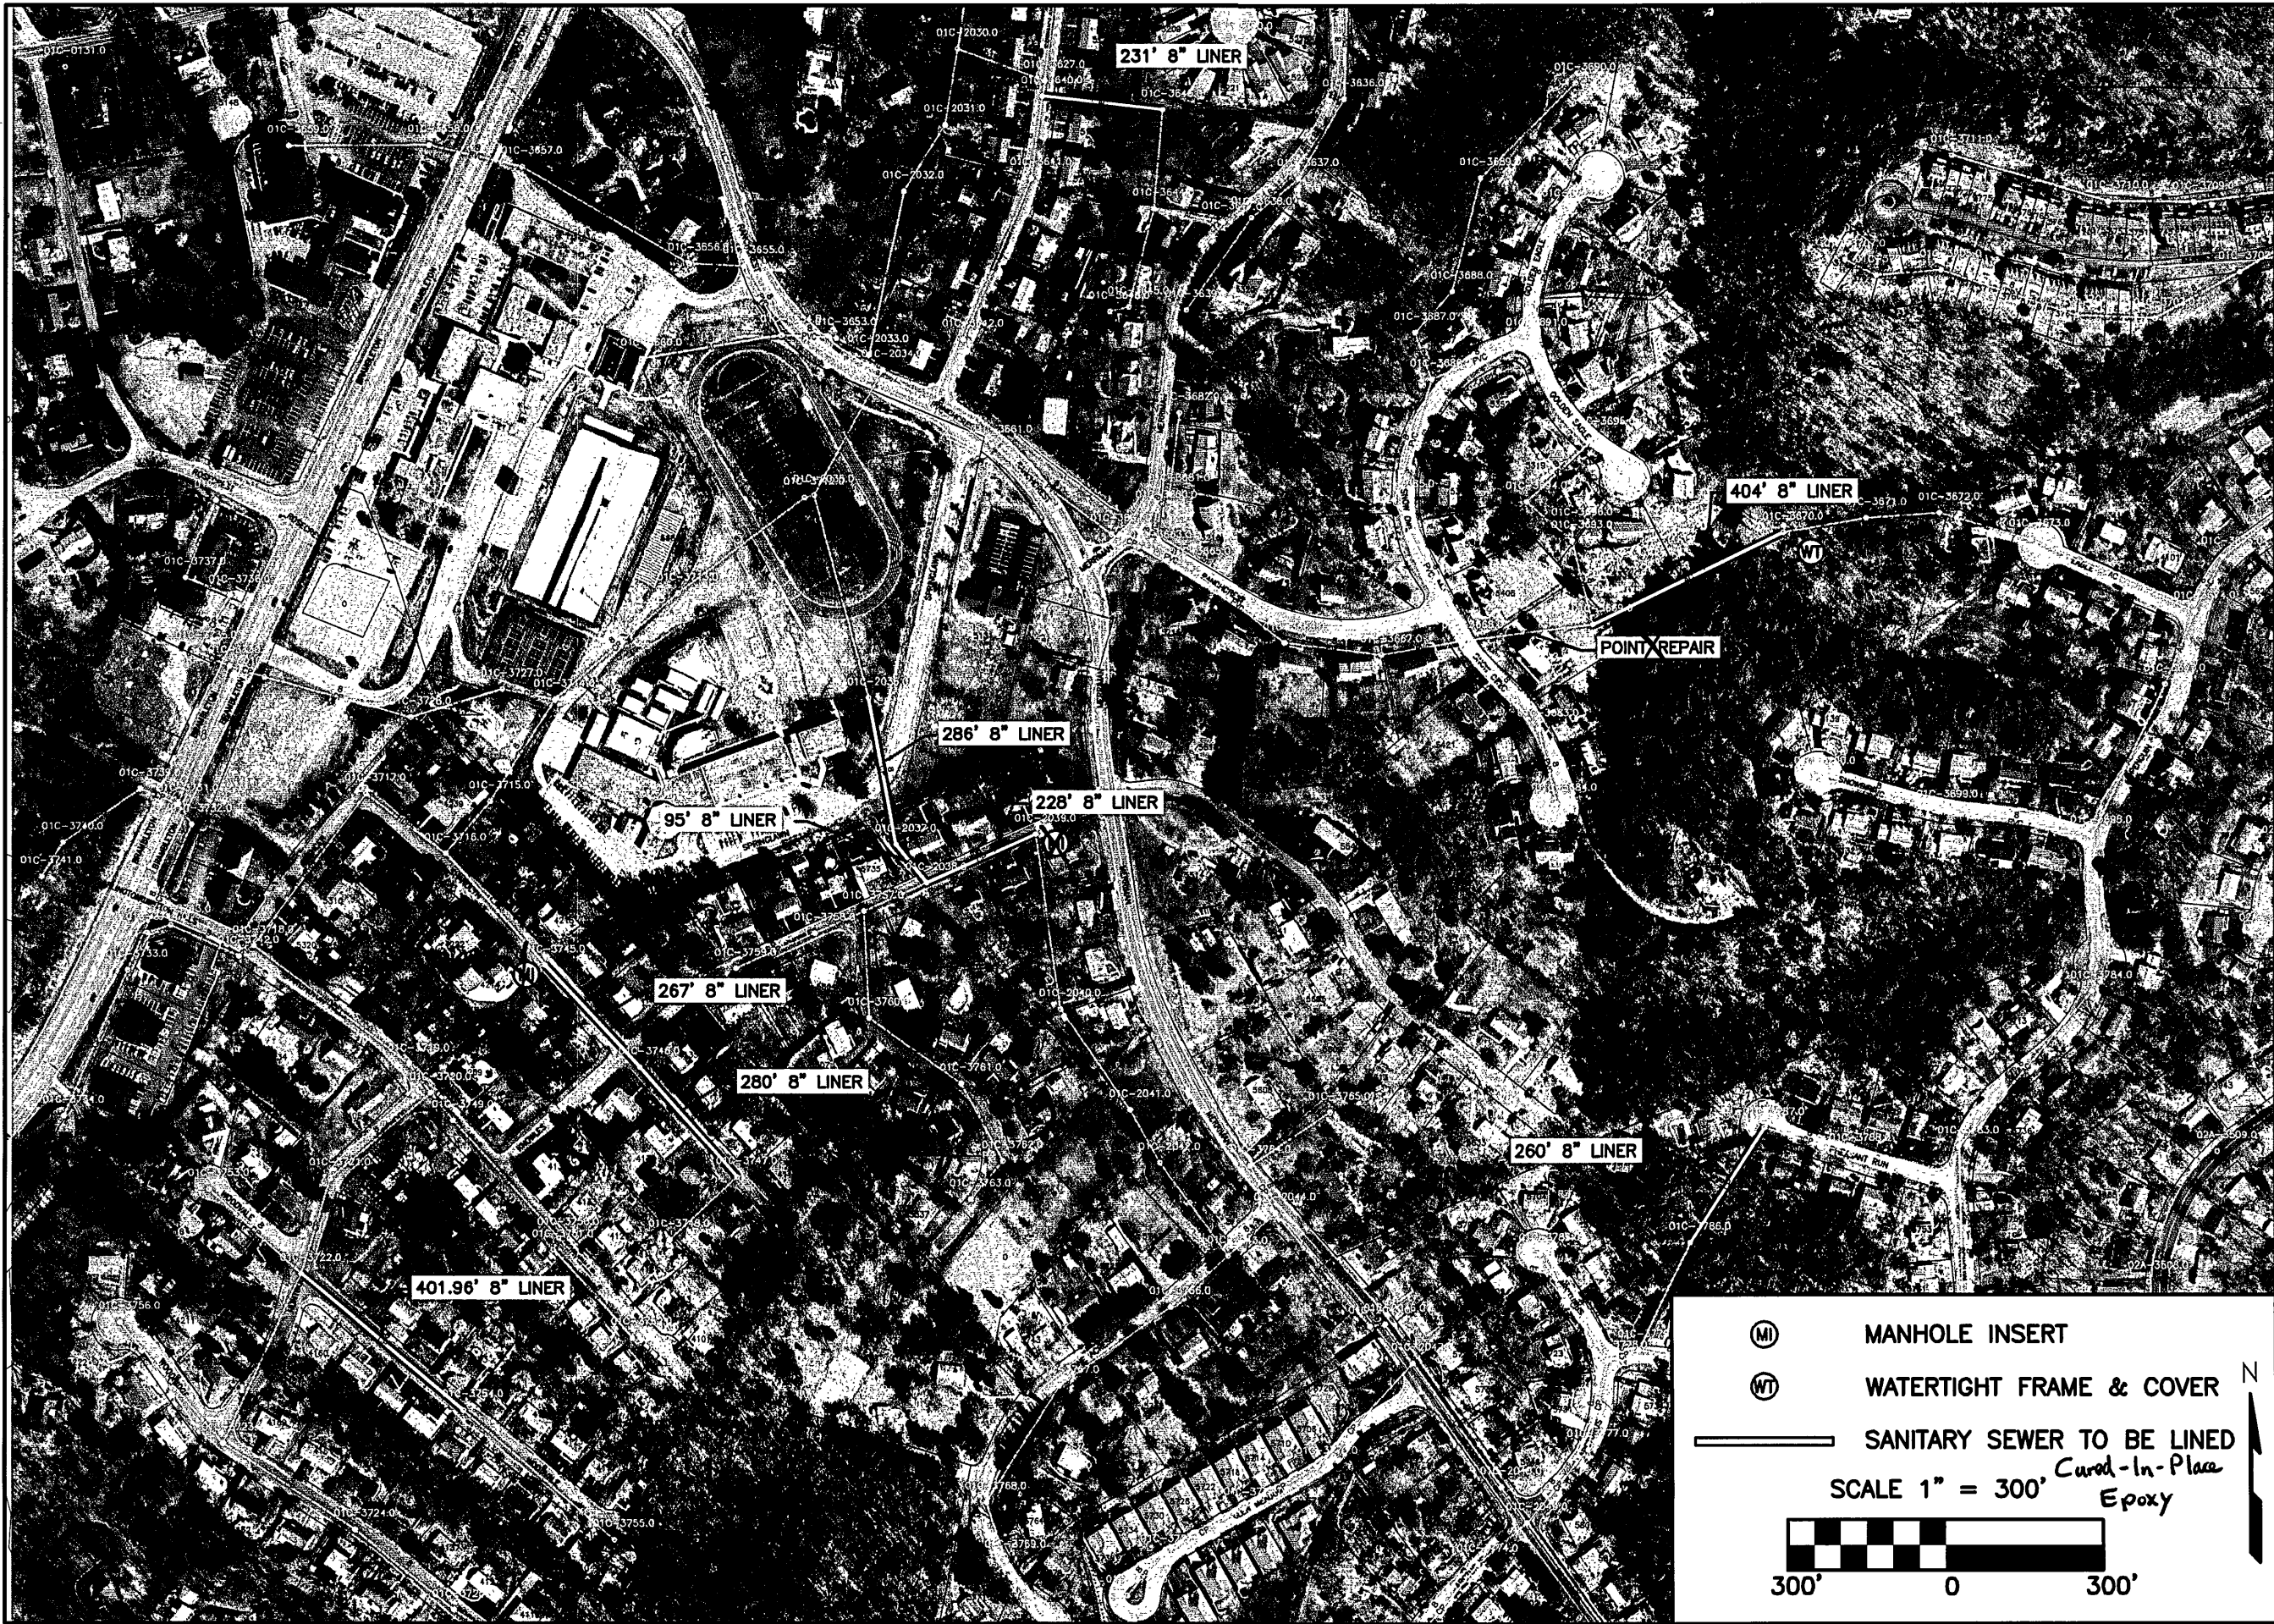

PROJECT		WWWA LINER PROJECTS 2009	
TITLE		AS-BUILT	ARLINGTON HILLS
		SES	10/01/10
COMM. NO.		209050.00	
DRAWN	CHECKED		
BSH	WM		
DWG. REFERENCE NO.		ARLINGTON HEIGHTS.DWG	
SHEET TITLE			
DATE	REV.		
12-09			