

COMM 17485

PROPERTY OF
ARROW WOOD COUNTRY CLUB, INC.

E CURVE DATA
PC 75+90.45
PT 81+80.48
A 47.99
TAN 151.66
KNO 227.22
AV 269.03
CHD 275.26

E CURVE DATA
PC 86+73.93
PT 88+76.32
A 31.00
TAN 104.00
KNO 375.00
AV 202.89
CHD 200.43

E CURVE DATA
PC 64+75.38
PT 67+23.24
A 125.18
TAN 472.80
KNO 200.00
AV 447.85
CHD 359.98


E CURVE DATA
PC 74+21.91
PT 75+55.38
A 36.32
TAN 114.88
KNO 225.00
AV 143.47
CHD 141.03

E CURVE DATA
PC 70+57.26
PT 72+43.06
A 65.10
TAN 114.88
KNO 225.00
AV 135.80
CHD 169.17

E CURVE DATA
PC 62+08.81
PT 63+95.21
A 20.00
TAN 99.15
KNO 525.00
AV 156.31
CHD 155.34

PLAN	SURVEY	DATE
NOTE BOOK	10.1.8	10.1.8
NO.	10.1.8	10.1.8

PROFILE	SURVEY	DATE
NOTE BOOK	10.1.8	10.1.8
NO.	10.1.8	10.1.8

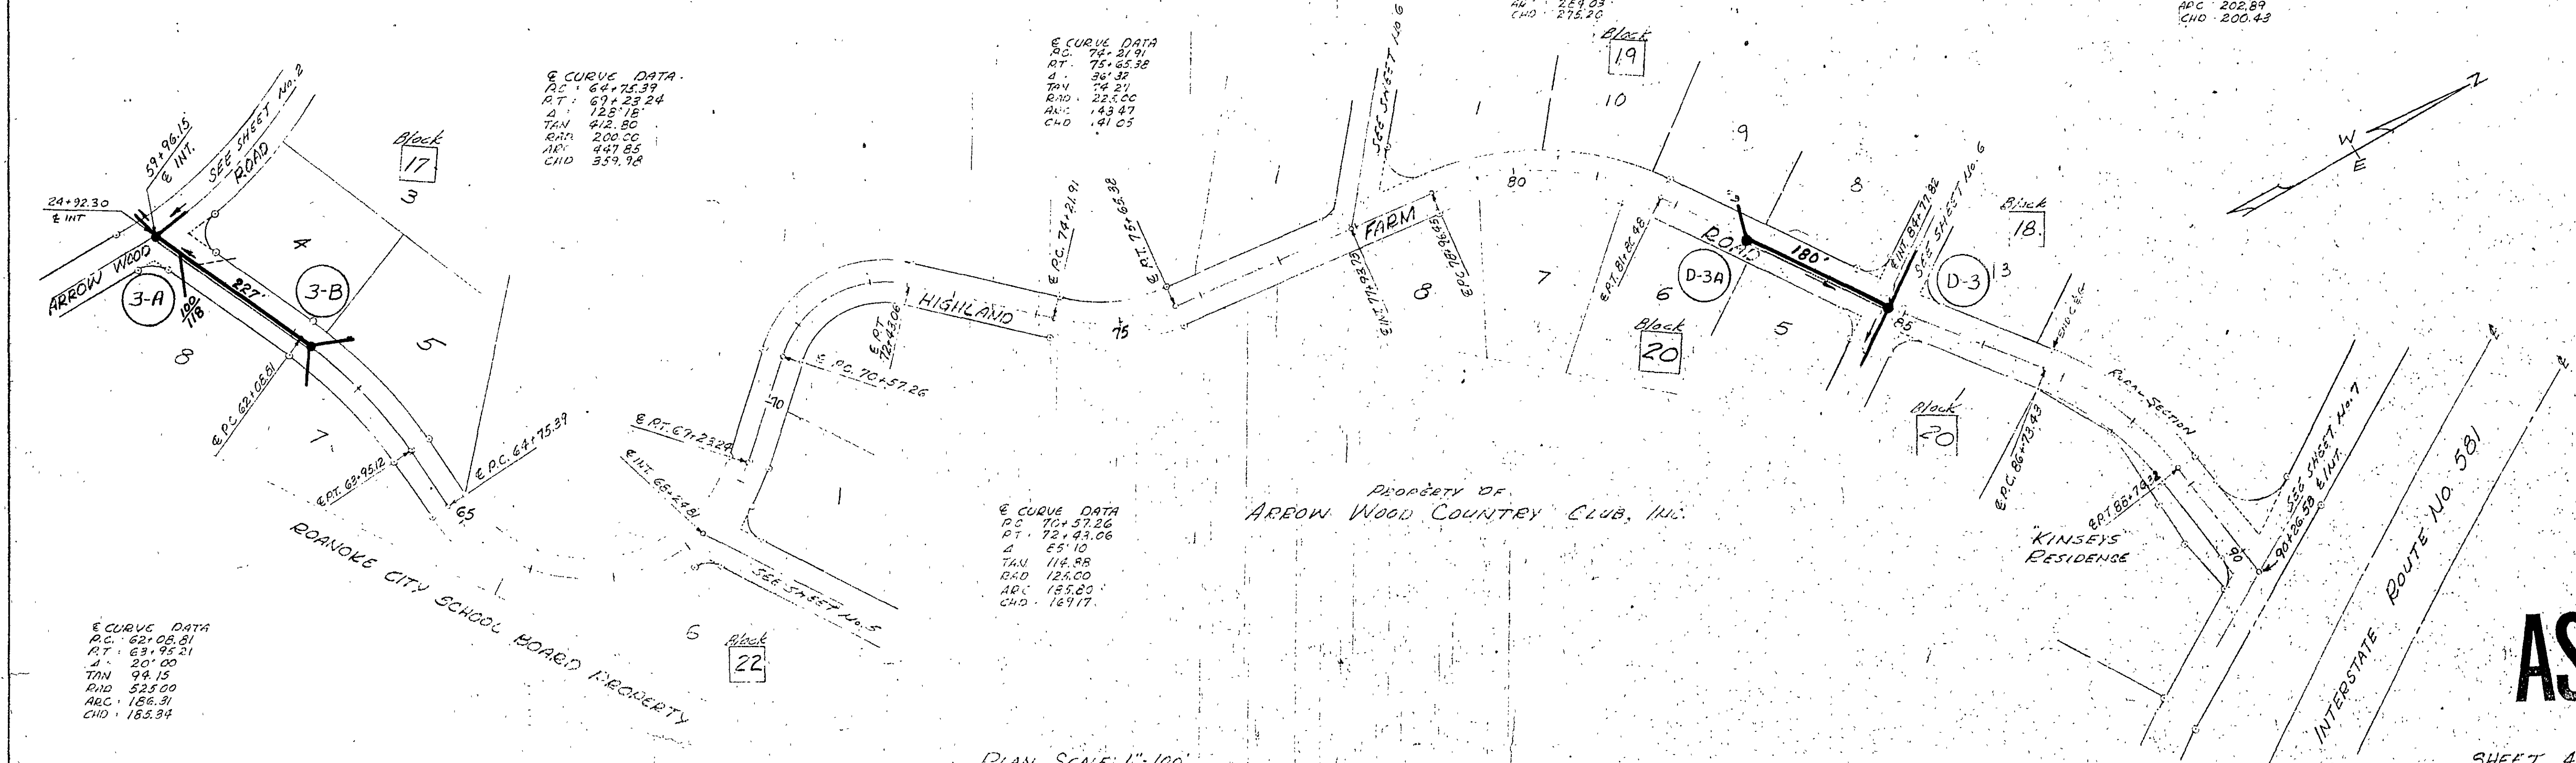


AS BUILT

PLAN SCALE: 1"=100'

SCALE: 1"=10' VERTICAL
1"=100' HORIZONTAL

CENTER LINE PROFILE

SHEET 4 OF SHEETS
PLAN AND PROFILE
PROPOSED ROADS
IN PROPERTY OF
ARROW WOOD COUNTRY CLUB, INC.
BY G. B. MALCOLM & SON
STATE LAND ENGINEERS
ROANOKE COUNTY, VIRGINIA
DATE: JULY 15, 1966
SCALE: AS NOTED

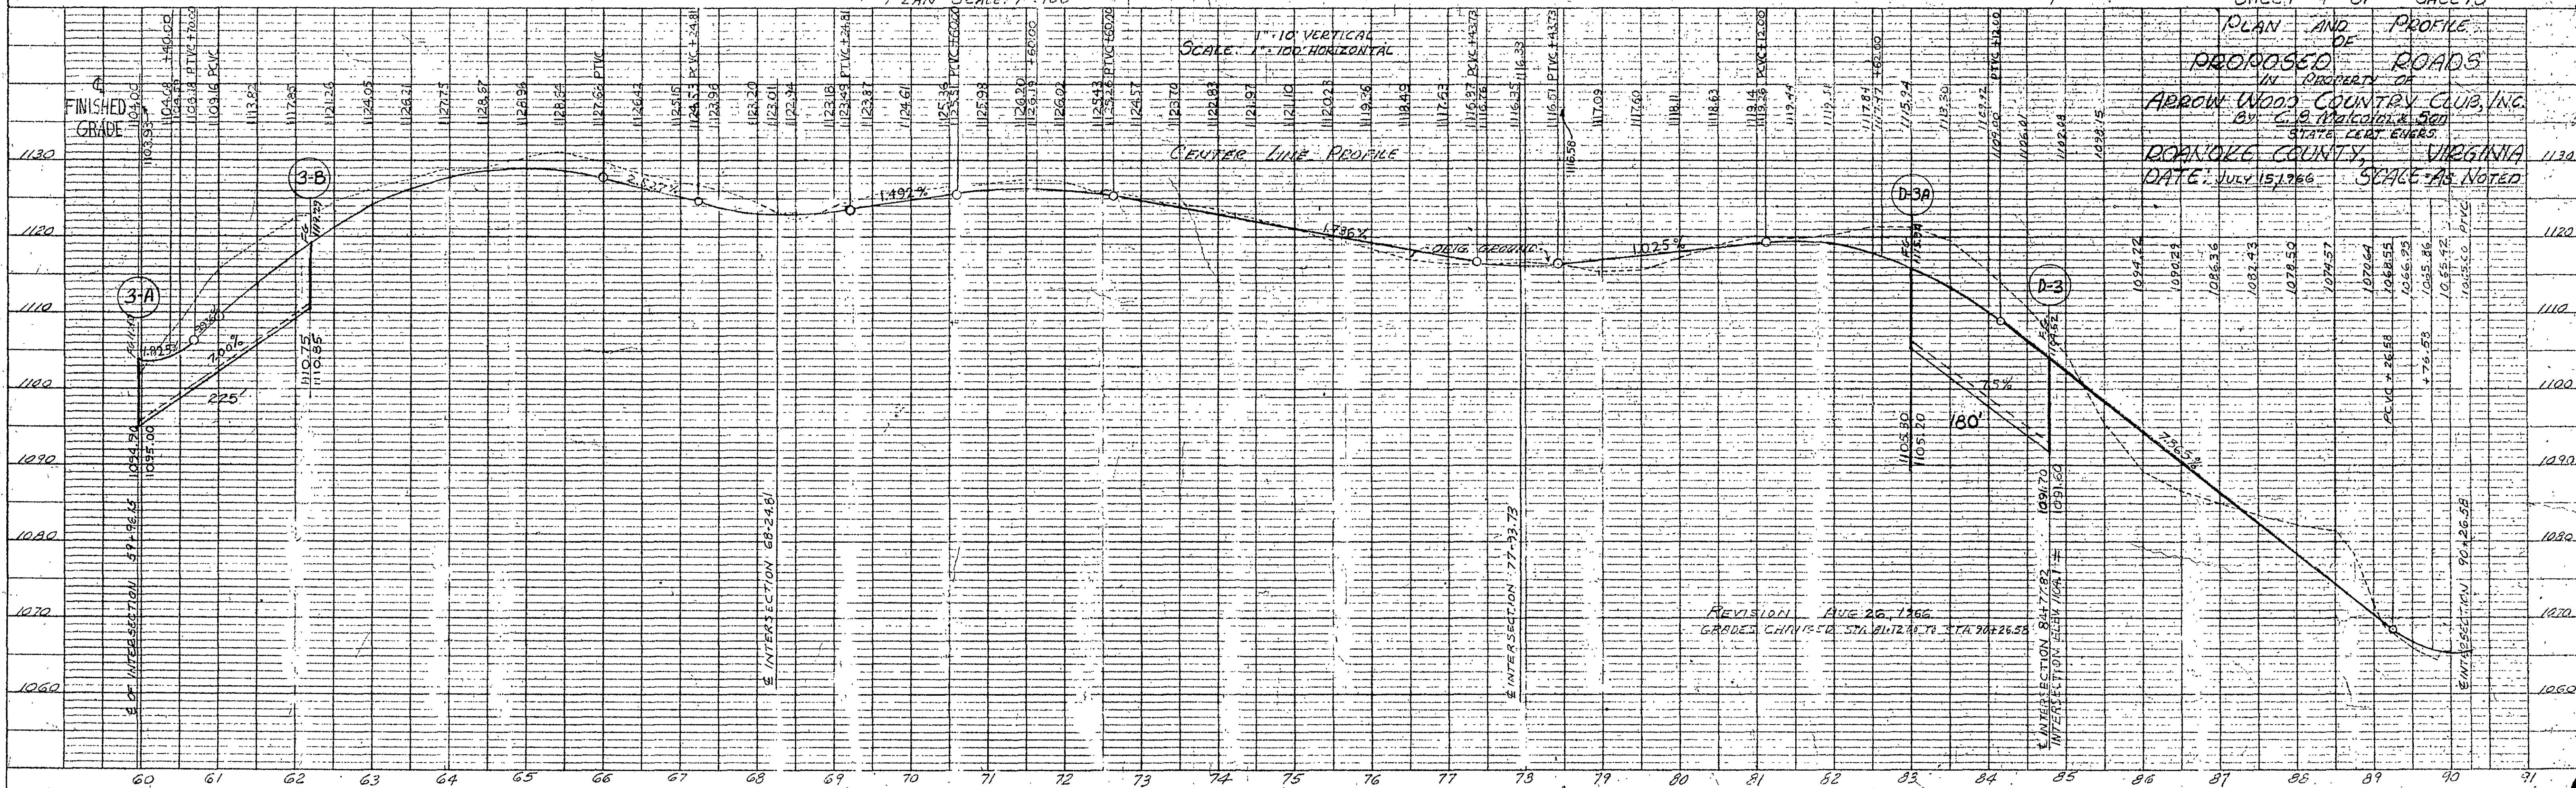

REVISION: AUG 26, 1966
GRADED CHANGES: STA 81+24.78 TO STA 90+26.58