


E CUEVE DATA
 PRC - 109.5194
 DT - 107.67.59.
 A - 53.01.43
 RAD: 75.00
 AP: 64.54
 CHD: 6708

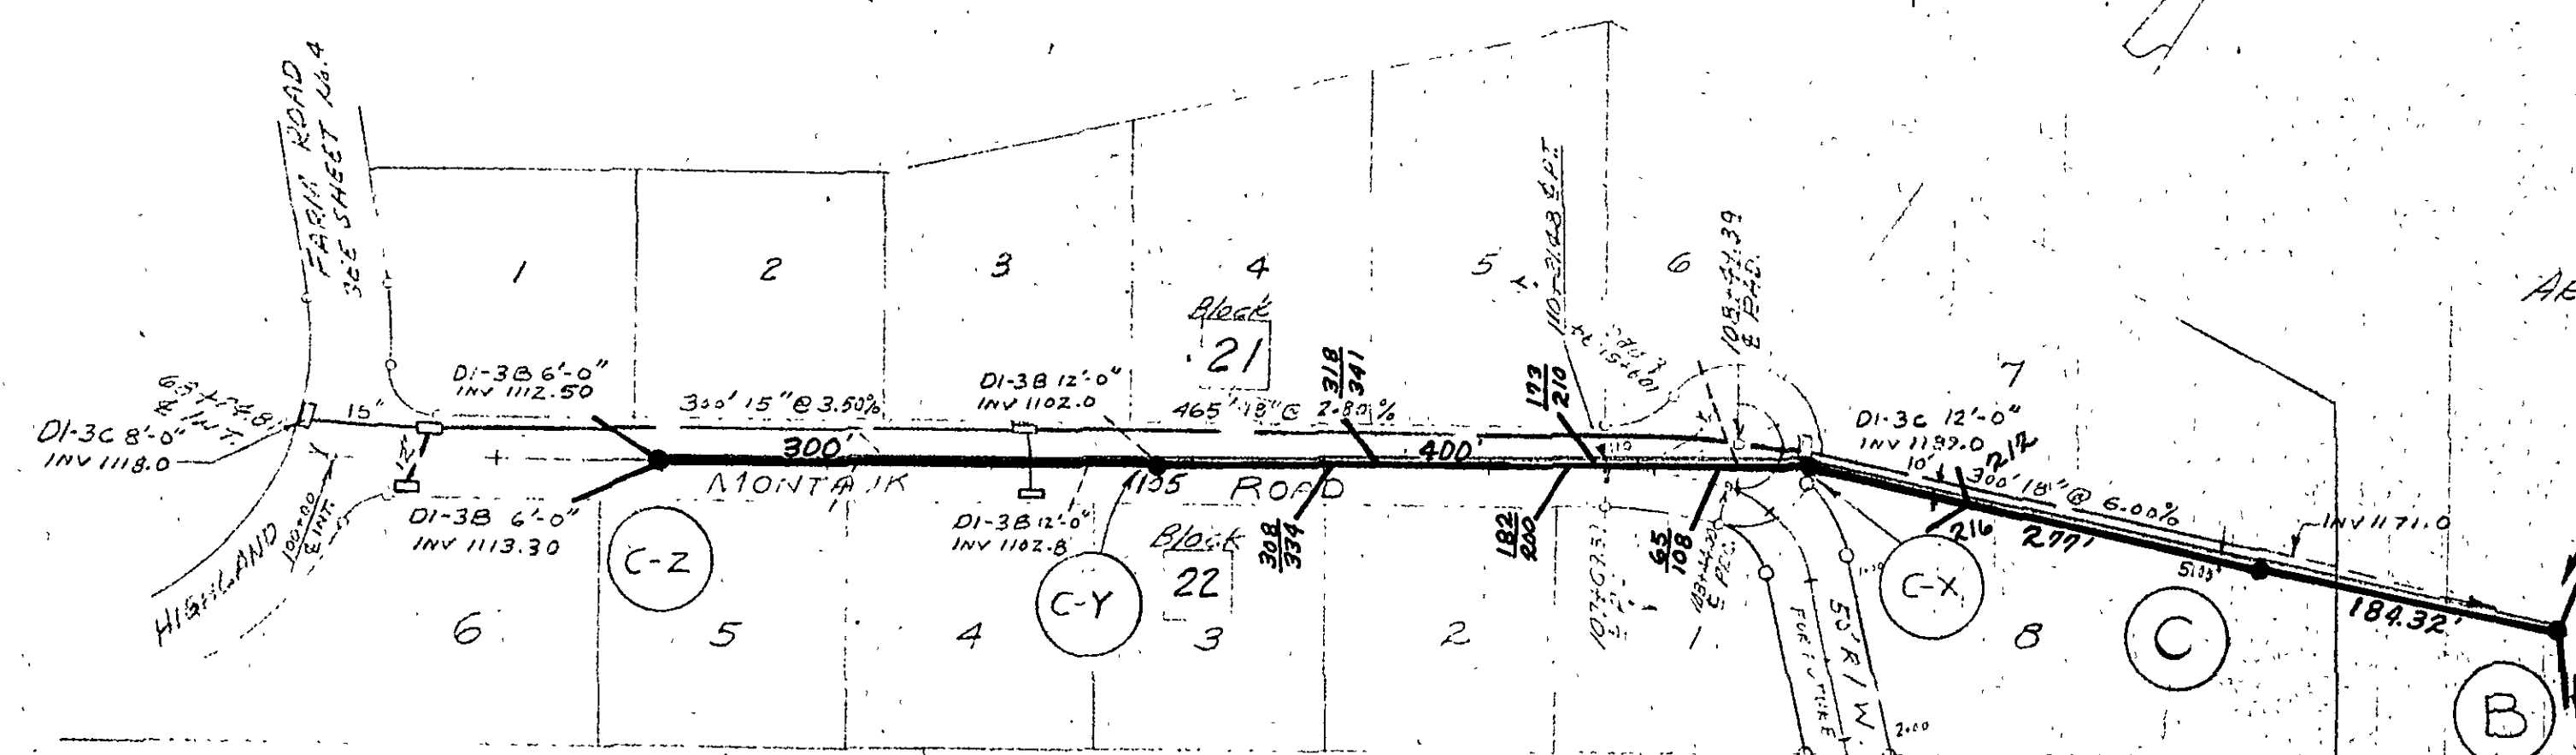

PROPERTY OF
ARROW WOOD COUNTRY CLUB, INC.

C CURVE DATA
 P.R.C. = 103+44.00
 P.R.C. = 109+51.94
 Δ = 247°22'48"
 RAD = 25.00
 ARC = 107.94
 CHD = 41.60

PORNOKE CITY
SCHOOL BOARD PROPERTY


DR. R. T. STEWART
PROPERTY

& CURVE DATA
 PC: 107+67.37
 PTA: 108+44.00
 TAN: 37.50
 R20: 100.00
 PCE: 74.61
 C42: 74.2
 C15: 15.15

AS BUILT

PLAN SCALE 1" = 100'

SCALE 1" = 10' VERTICAL
1" = 100' HORIZONTAL

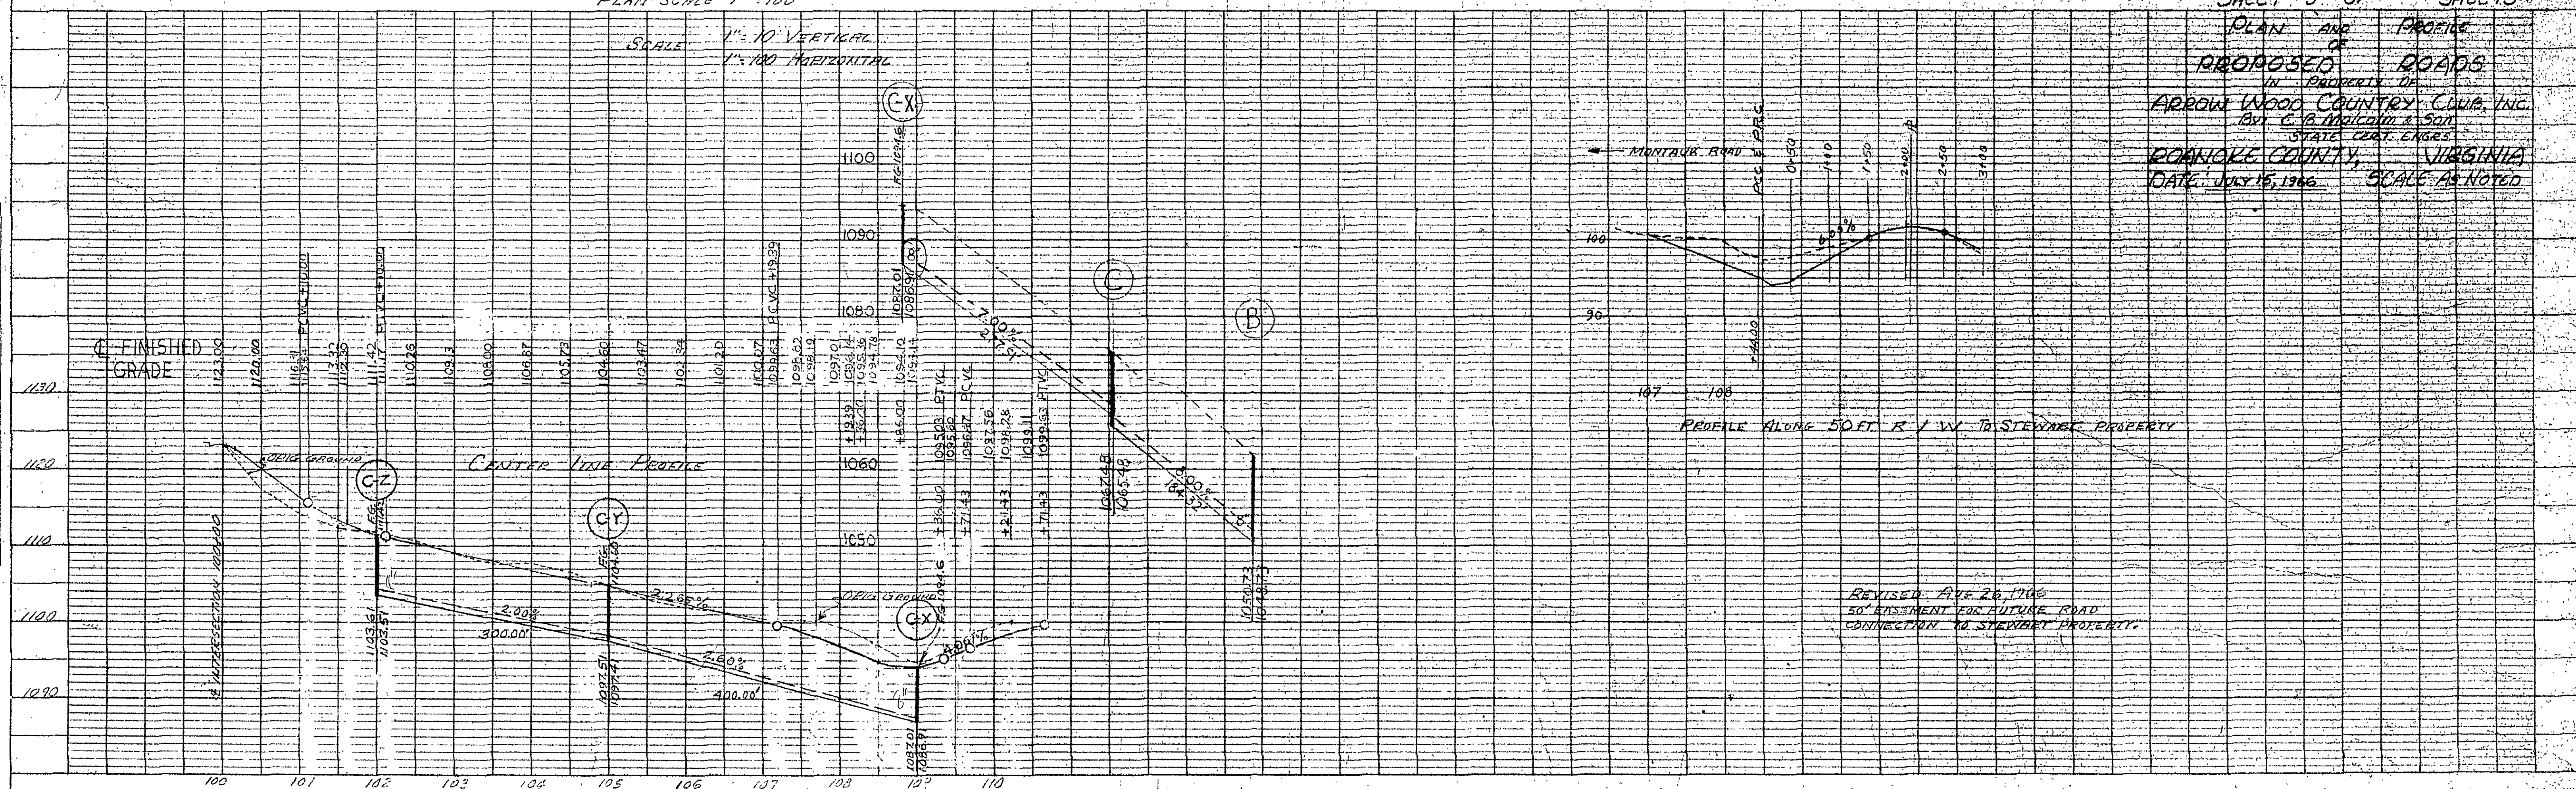

SHEET 5 OF SHEETS

PLAN AND PROFILE
OF
PROPOSED ROADS
IN PROPERTY OF
ARROW WOOD COUNTRY CLUB, INC.
BY C. A. McILICHAIR & SON
STATE CERT. ENGRS.
ROANOKE COUNTY, VIRGINIA
DATE: JULY 15, 1946 SCALE: AS NOTED

REVISED MAY 26, 1966
50' EASEMENT FOR FUTURE ROAD
CONNECTION TO STEWART PROPERTY