
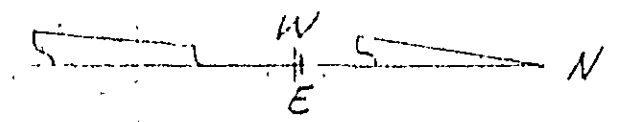


PLAN	DATE
PLAN	2/27/66
NOTE BOOK	UB
SURVEYED	
ALIGNED	
CHECKED	
BY	

PROFILE	DATE
PROFILE	2/27/66
NOTE BOOK	UB
GRADES CHECKED	
BY	
STRUCTURE NO.	

E. CURELL DATA
PC 32+00.0
PVI 32+25.0
C 32+12.5
TAN 5.5534
RAD 79.83
AVC 101.12
CHD 52+29.48 W
N 21°35'40" W

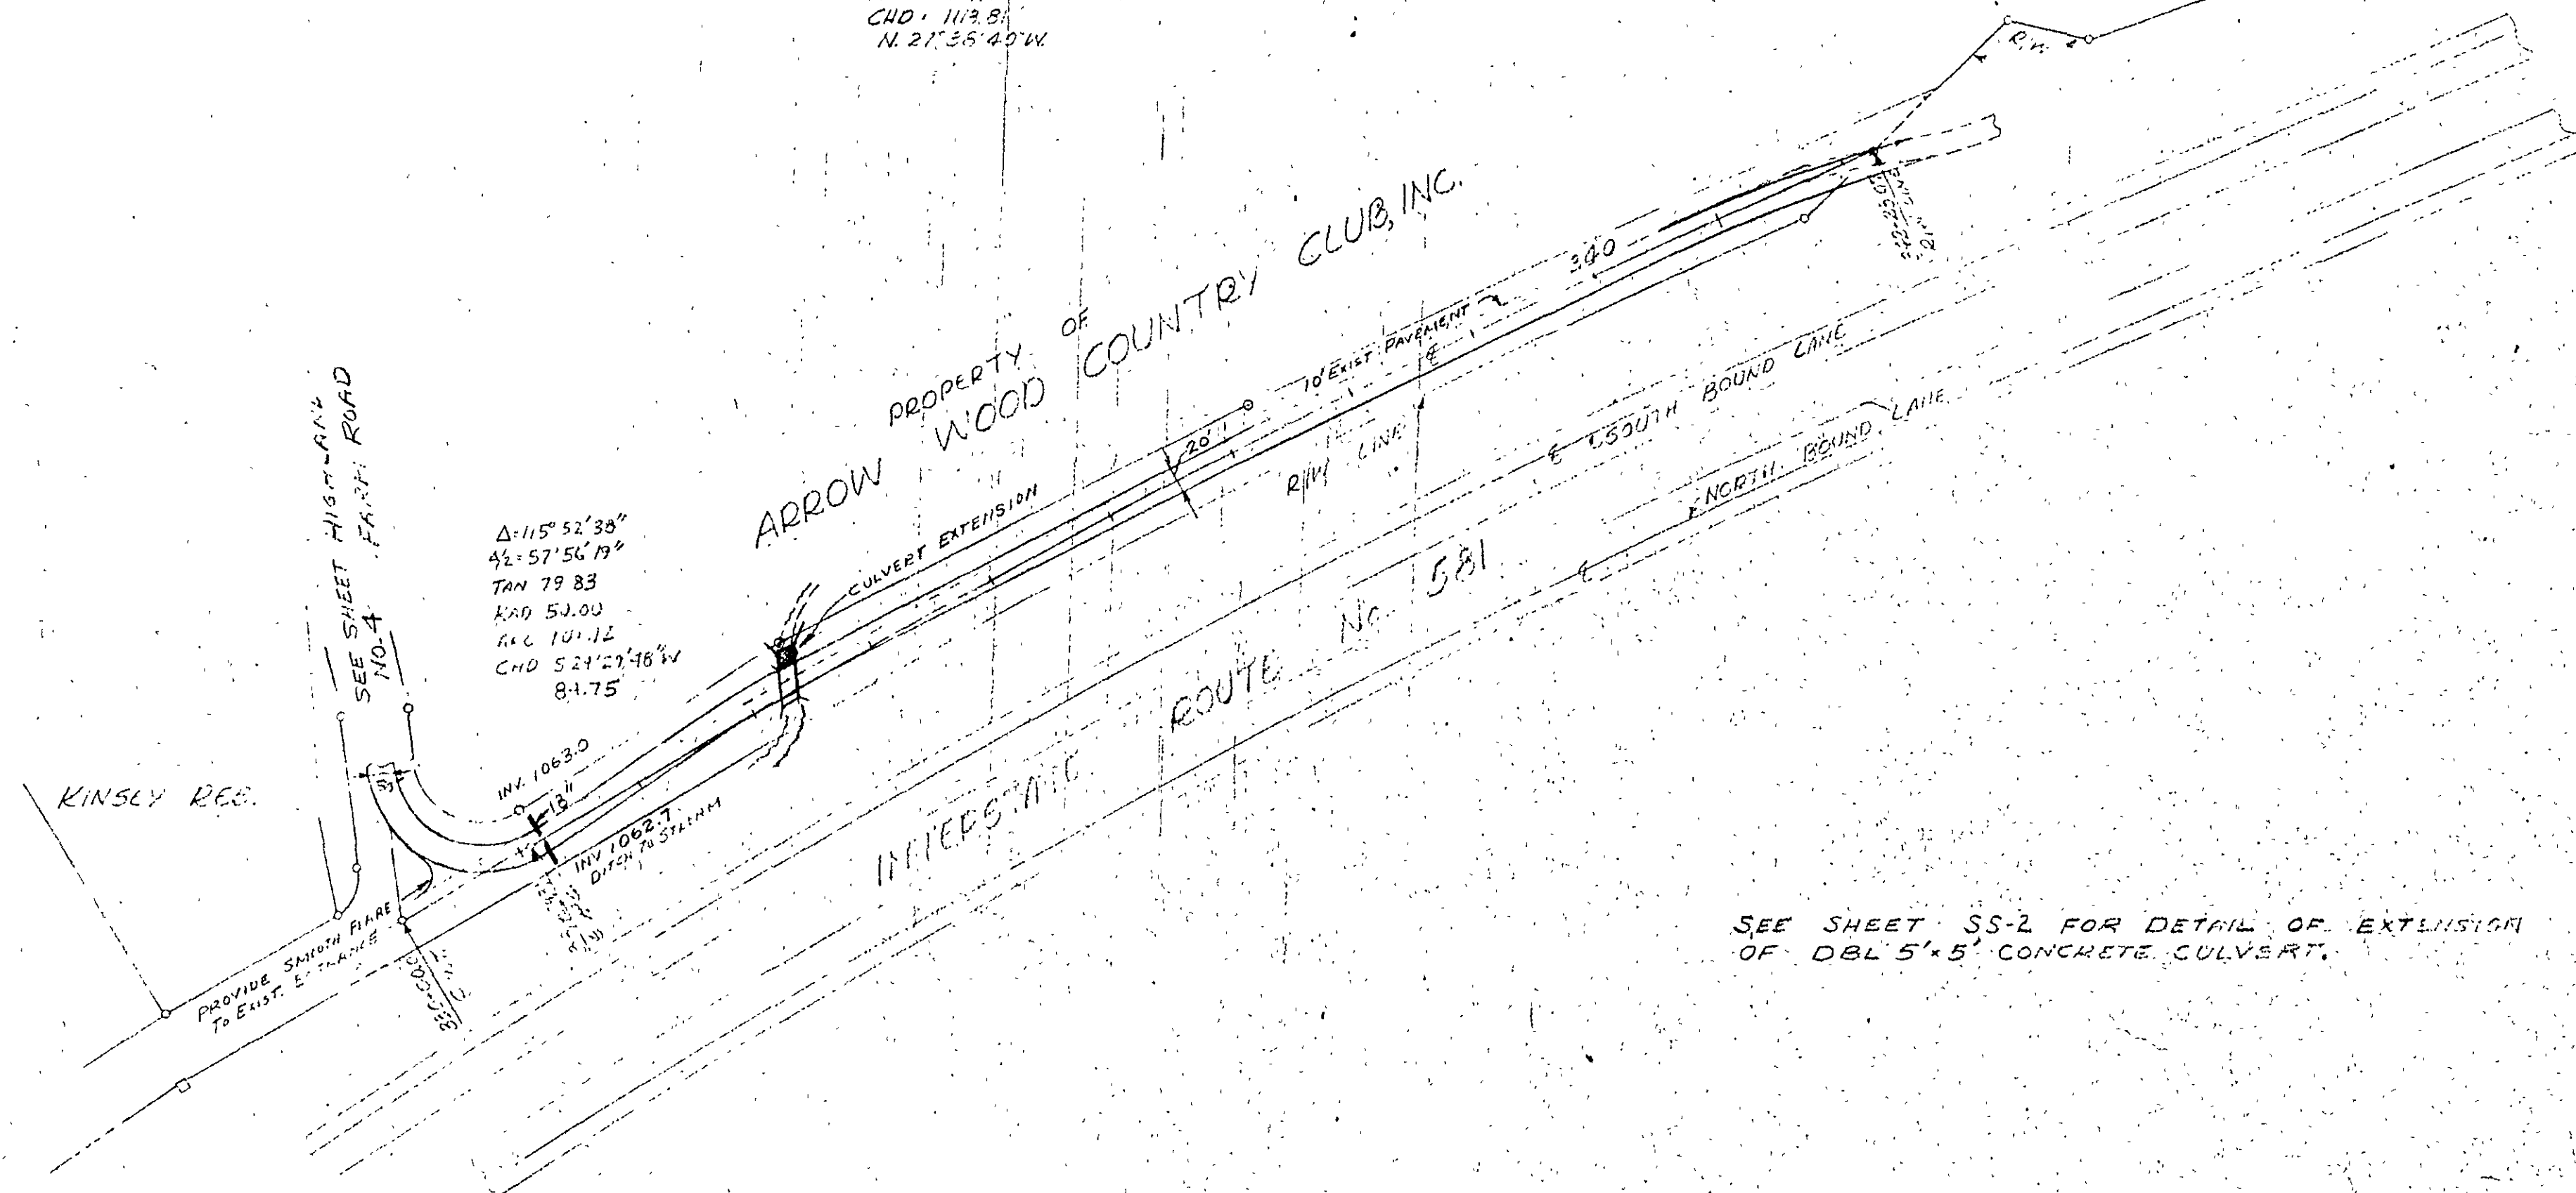


AS BUILT

PLAN SCALE: 1"=100'

SCALE: 1"=10' VERTICAL
1"=100' HORIZONTAL

SHEET 7 OF SHEETS

PLAN AND PROFILE
OF
PROPOSED ROADS
IN PROPERTY OF
ARROW WOOD COUNTRY CLUB, INC.
BY G. B. MASON & SON
STATE CERT. ENGRS.
ROANOKE COUNTY, VIRGINIA
DATE: JULY 15, 1966 SCALE: AS NOTED

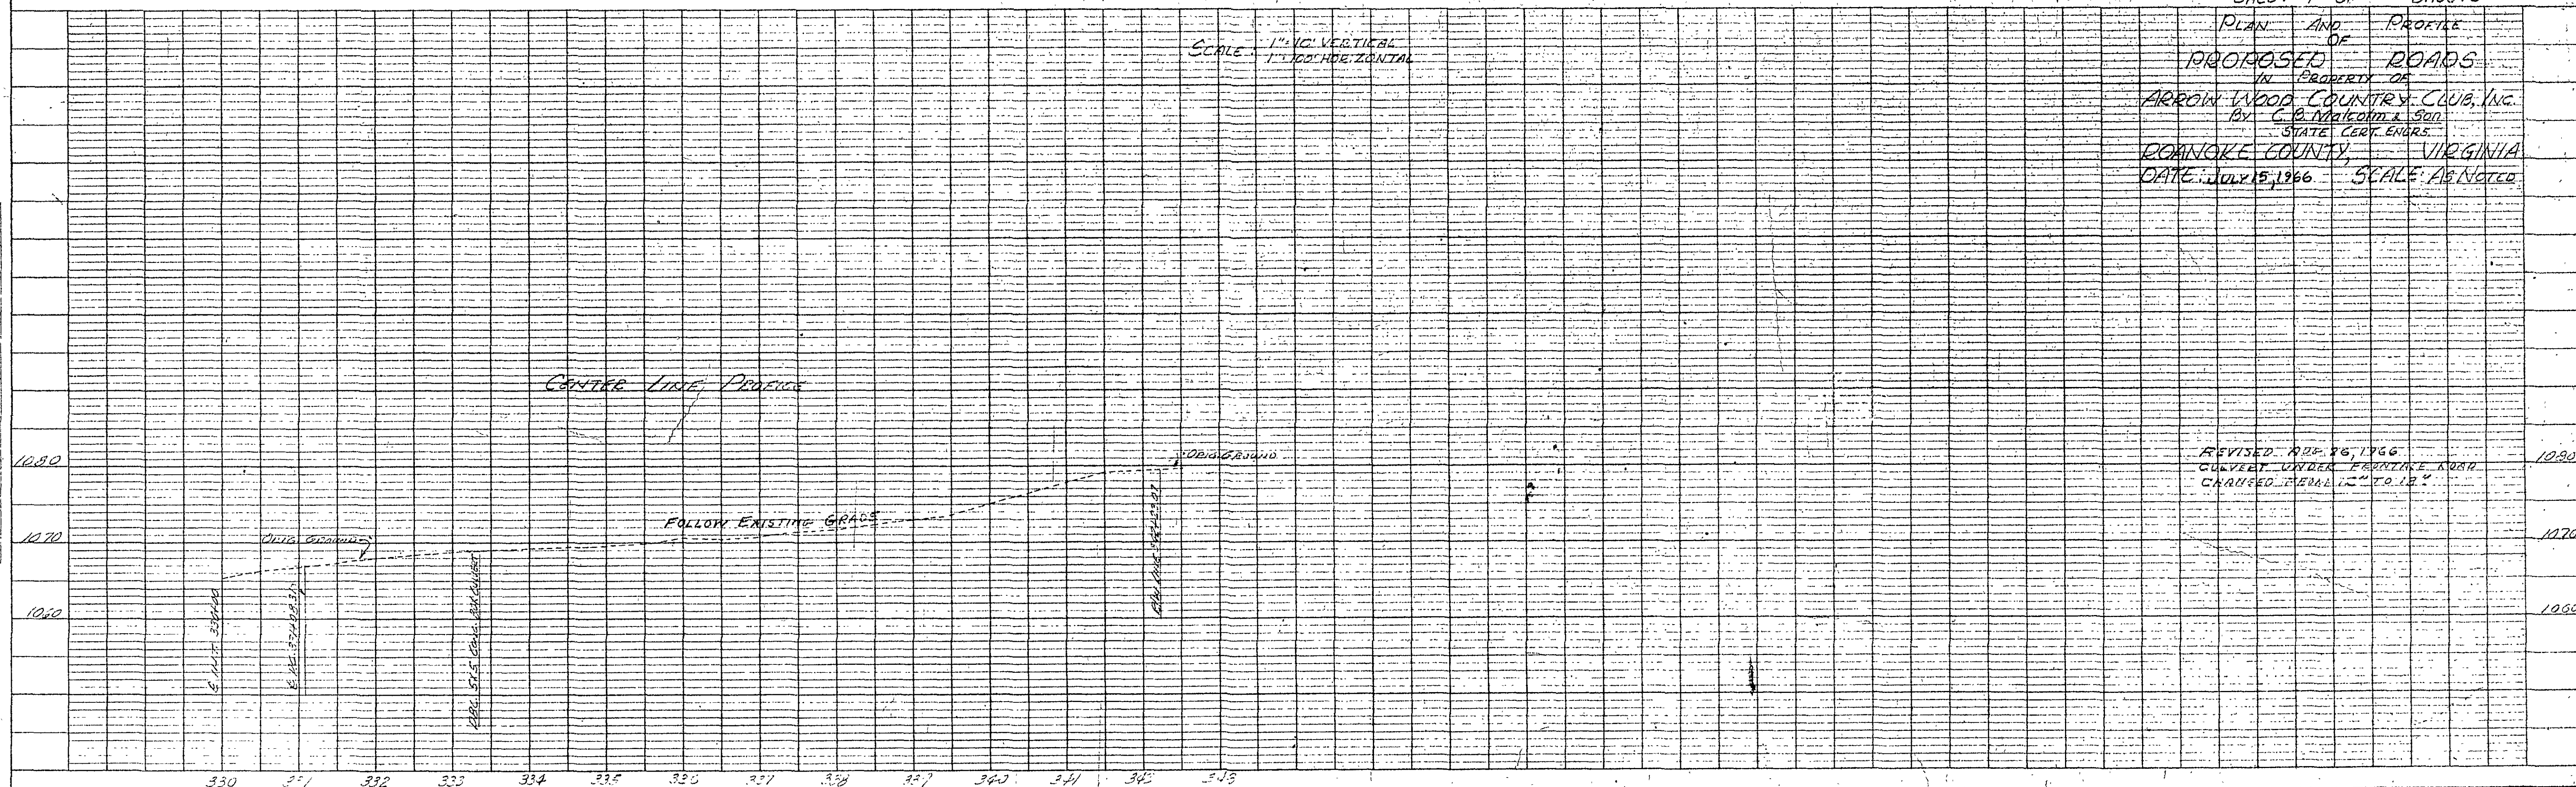

REVISED APR. 26, 1966
CULVERT UNDER FARMLINE ROAD
CHANGED FROM 12" TO 18"