

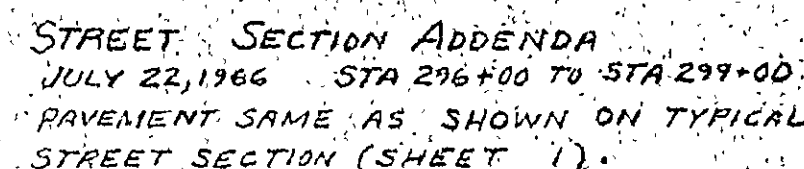
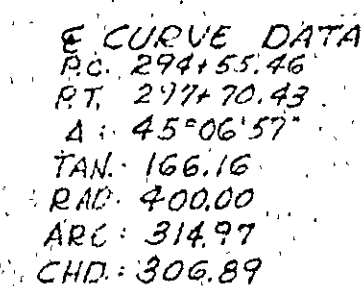
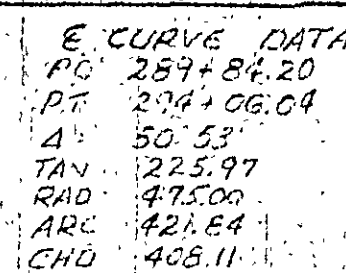


PROFILE	BY	DATE
	2/27/52	
NOTE BOOK	PL	
	SUBMITTED	
	PLOTTED	
	GRAPHS CHECKED	
	B. M. 1 NOTED	
NO	STRUCTURE NOTAL MS CH MO	

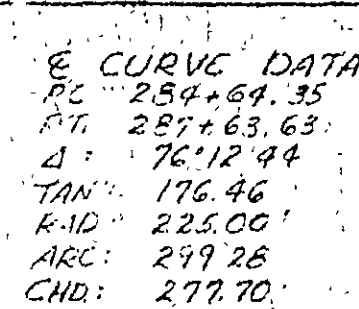

AS BUILT

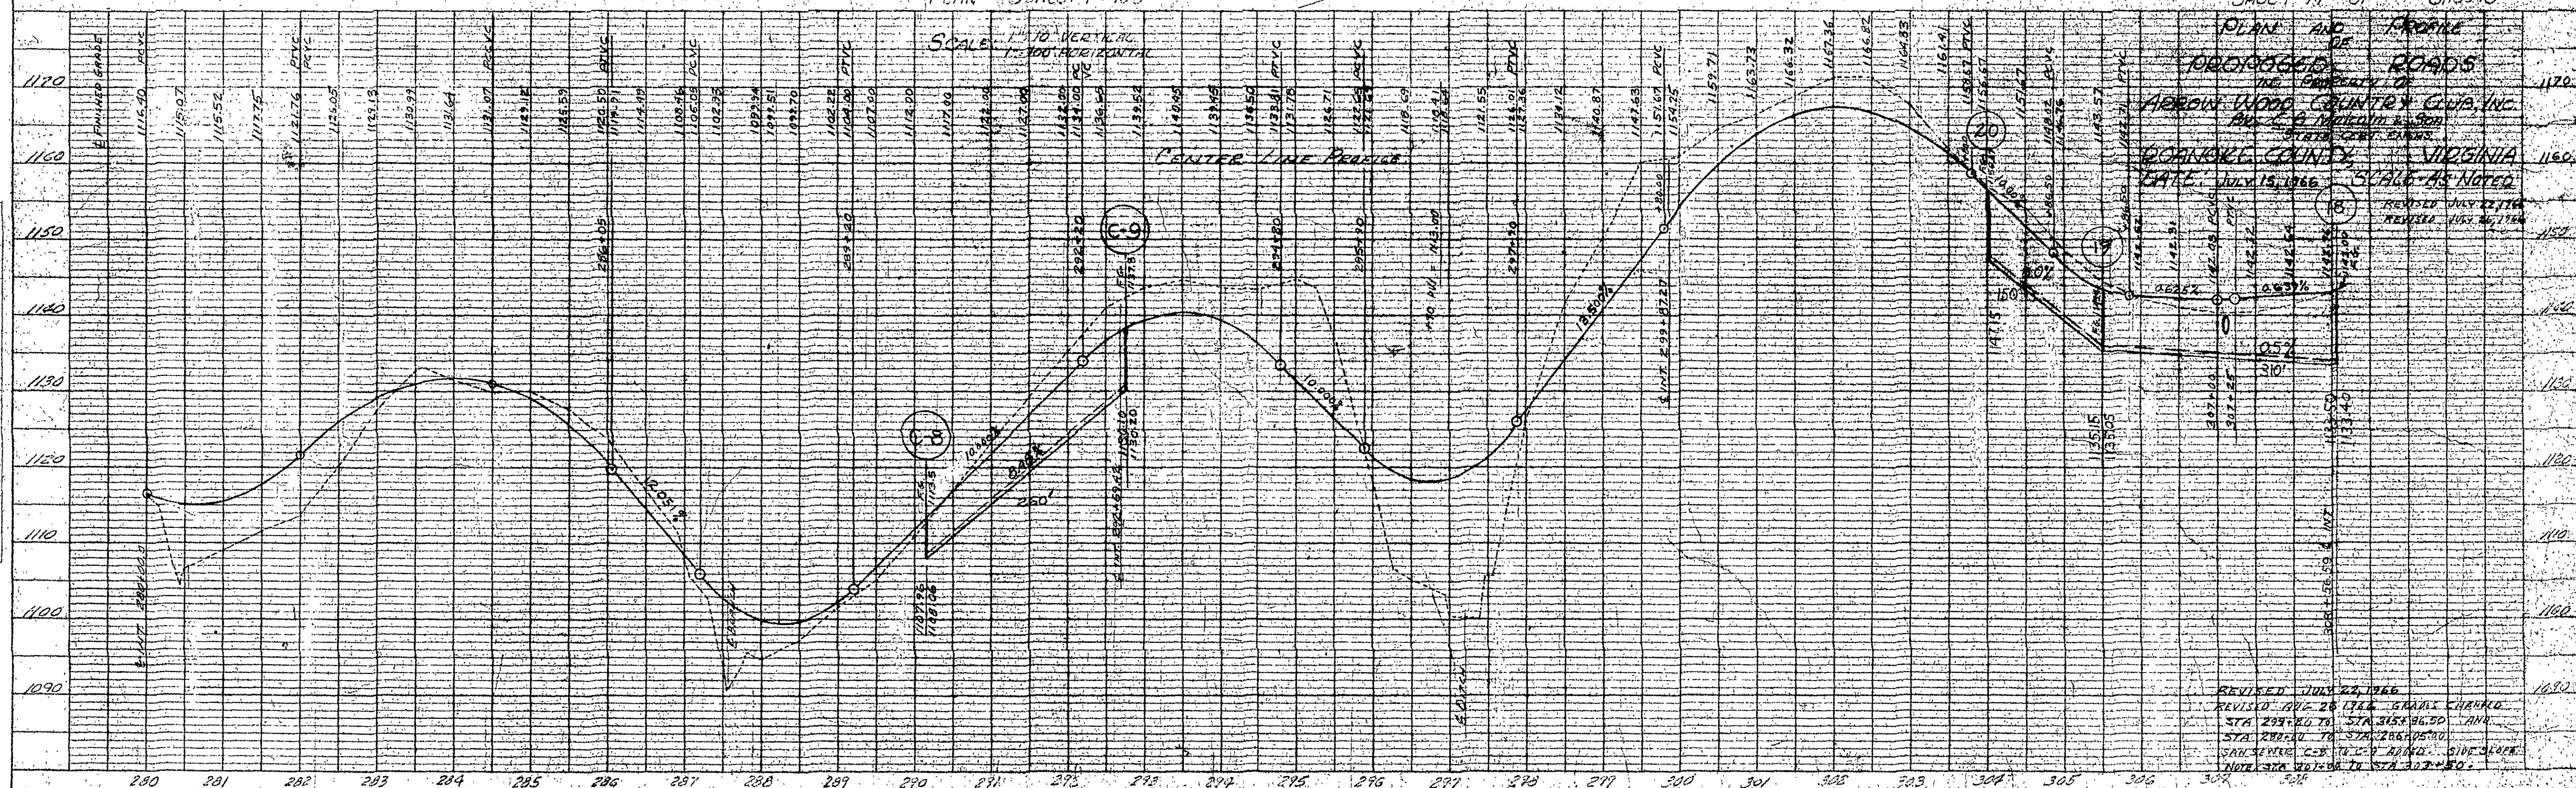

REVISED JULY 22, 1966
REVISED AUG 28 1966 GRADES CHECKED
STA 293+00 TO STA 315+86.50 1"4"
STA 200+00 TO STA 286+05.00
SAN SEWEE C-B TO C-B ADDED. SIVE SLOPE
NOTE STA 201+00 TO STA 303+50.