


E CURVE DATA
 PC 310+44.74
 PT 311+18.49
 Δ 14°15'
 TAN 37.50
 RAD 75.00
 ARC 74.61
 CHD 74.42

E CURVE DATA
 PC 310+16.25
 PT 311+18.49
 Δ 247°22'48"
 RAD 25.00
 ARC 101.74
 CHD 41.60

CURVE DATA
 PC 315+18.49
 PT 315+66.03
 Δ 53°07'45"
 TAN 37.50
 RAD 75.00
 ARC 69.54
 CHD 67.06

E CURVE DATA
 PC 282+96.73
 PT 310+69.94
 Δ 105.32
 TAN 72.37
 RAD 35.00
 ARC 101.30
 CHD 87.58

EXTEND STORM DRAIN 1111 OF 5'
 EAST OF SANITARY SEWER AND
 CHANNEL TO EXIST. DRAINAGE SWALE

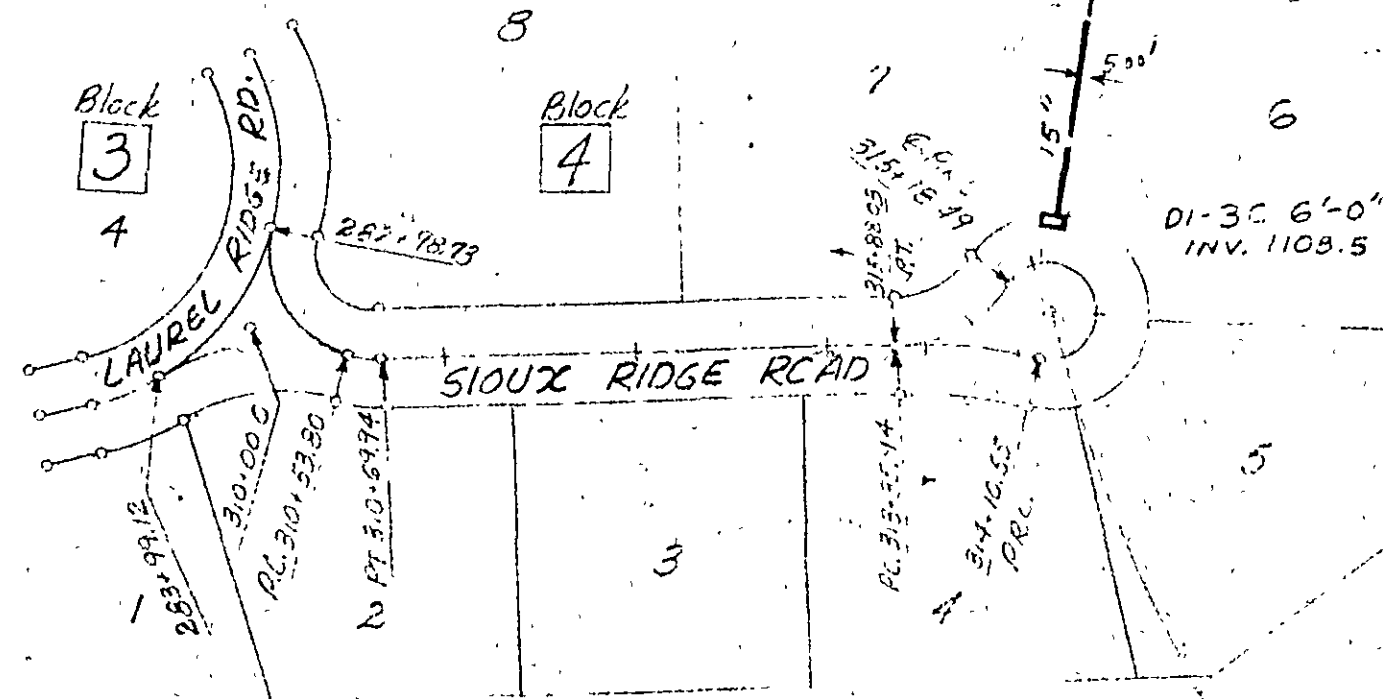

PROPERTY OF
 ARROW WOOD COUNTRY CLUB, INC.

E CURVE DATA
 PC 283+97.12
 PT 310+53.08
 Δ 17°34'03"
 TAN 37.50
 RAD 35.00
 ARC 100.34
 CHD 97.72

E CURVE DATA
 PC 310+53.08
 PT 310+69.94
 Δ 17°34'03"
 TAN 37.50
 RAD 35.00
 ARC 100.34
 CHD 97.72

CURVE DATA
 PC 322+06.03
 PT 322+50.63
 Δ 14°15'
 TAN 37.50
 RAD 75.00
 ARC 74.61
 CHD 74.42


CURVE DATA
 PC 322+50.63
 PT 322+74.54
 Δ 24°22'48"
 TAN 37.50
 RAD 75.00
 ARC 101.74
 CHD 41.60

CURVE DATA
 PC 323+82.57
 PT 324+58.11
 Δ 53°07'45"
 TAN 37.50
 RAD 75.00
 ARC 69.54
 CHD 67.06

AS BUILT

PLAN SCALE 1"=100'

SCALE 1"=10' VERTICAL
 1"=100' HORIZONTAL

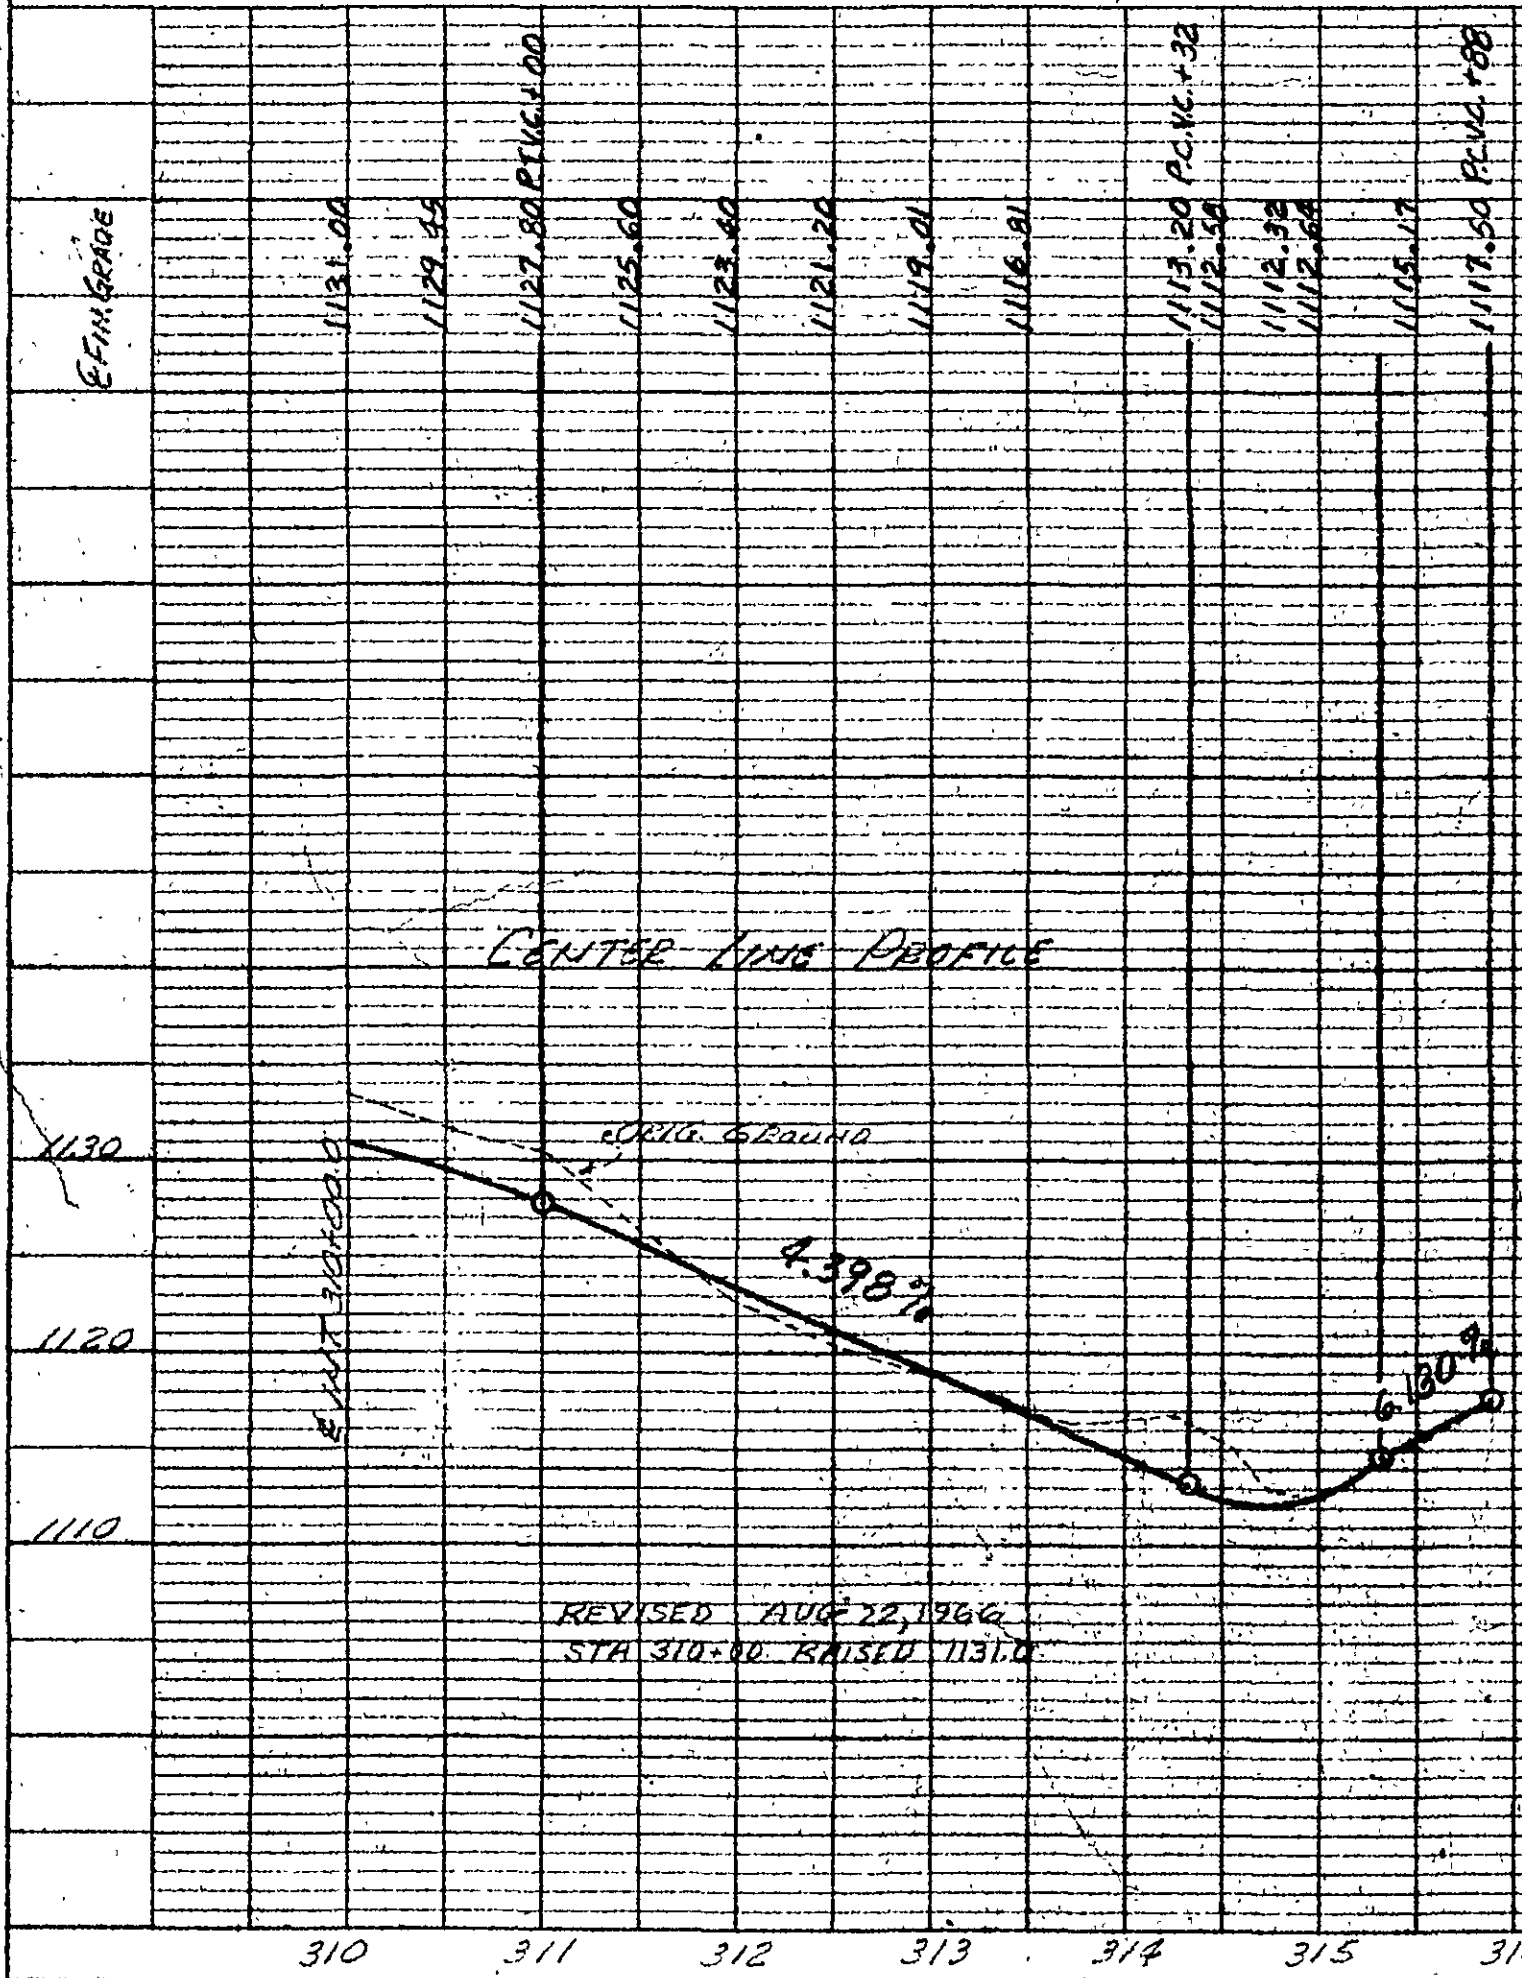

REVISED AUG 22, 1966
 STA 310+00 RAISED 13.10'

SHEET 12 OF SHEETS

PLAN AND PROFILE

PROPOSED ROADS

IN PROPERTY OF

ARROW WOOD COUNTRY CLUB, INC.


By E. G. Malcolm & Son

STATE CORP. ENGINEERS

DORRICK COUNTY, VIRGINIA

DATE: JULY 15, 1966

SCALE: AS NOTED

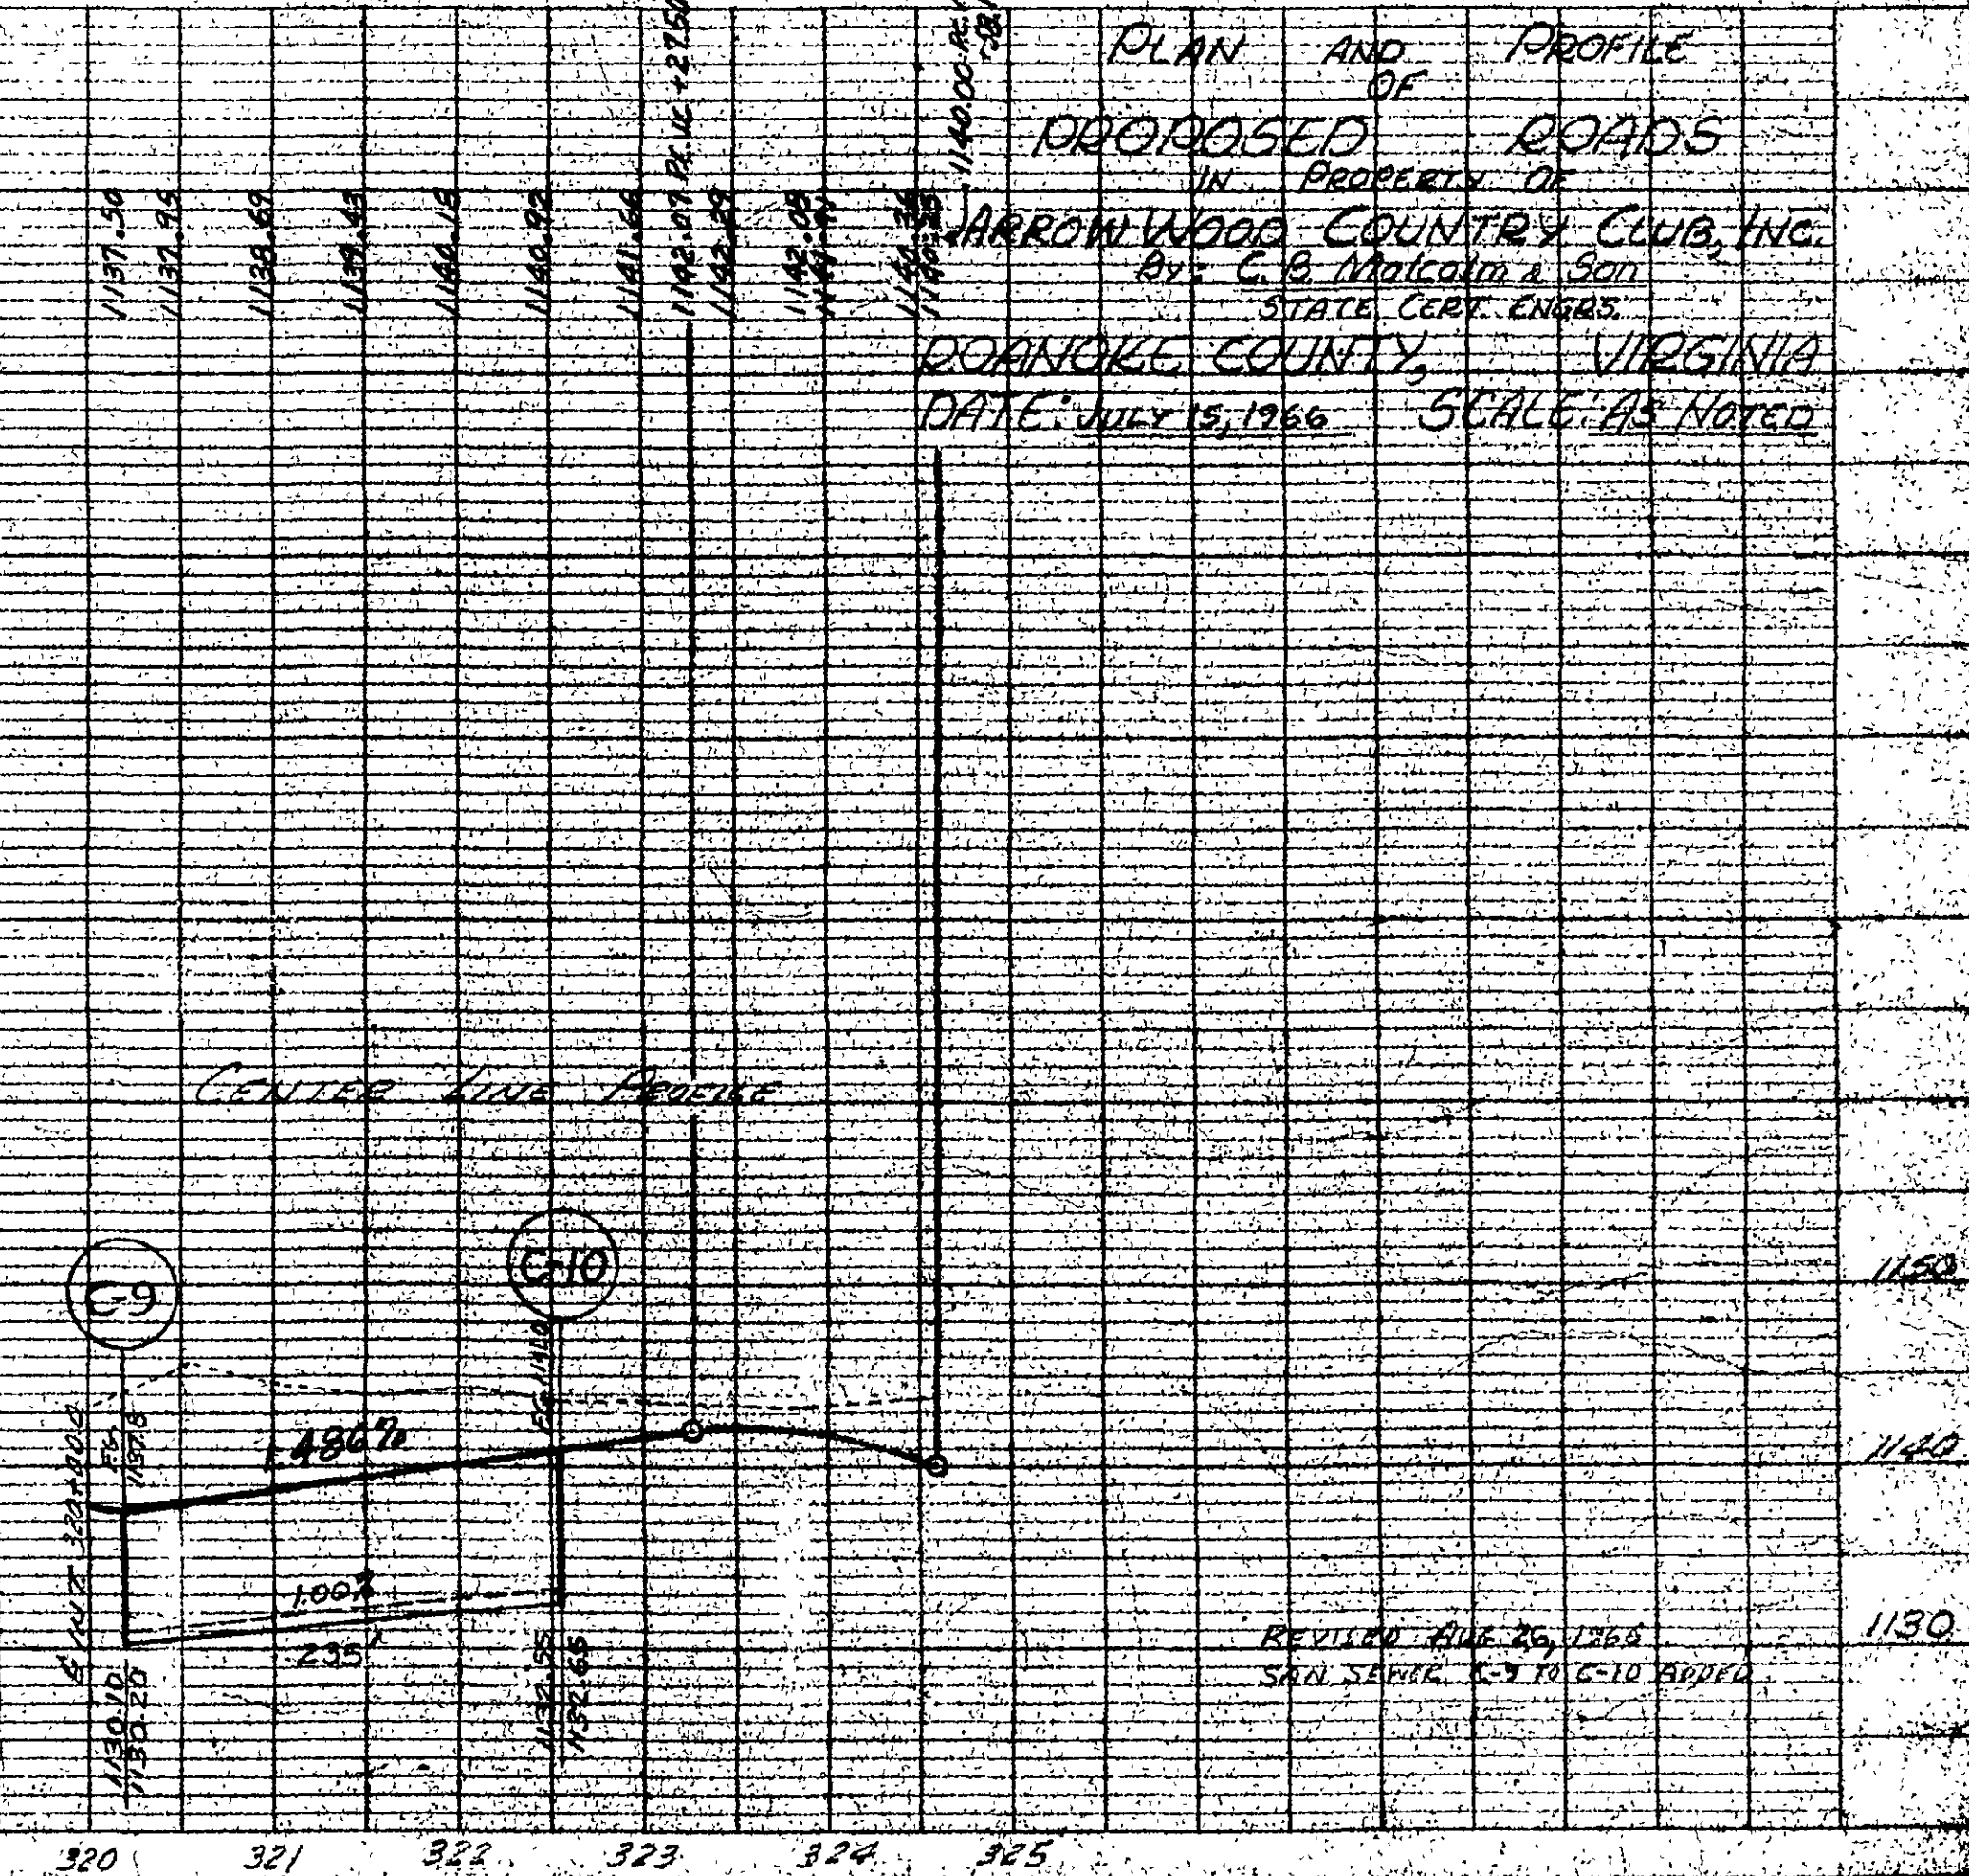

REVISED AUG 22, 1966
 SAN JUAN, C. 10' 5.10' BUILT