


COMM. 17485

PLAN	SUBMIT
NOTE BOOK	DATE
NO.	BY

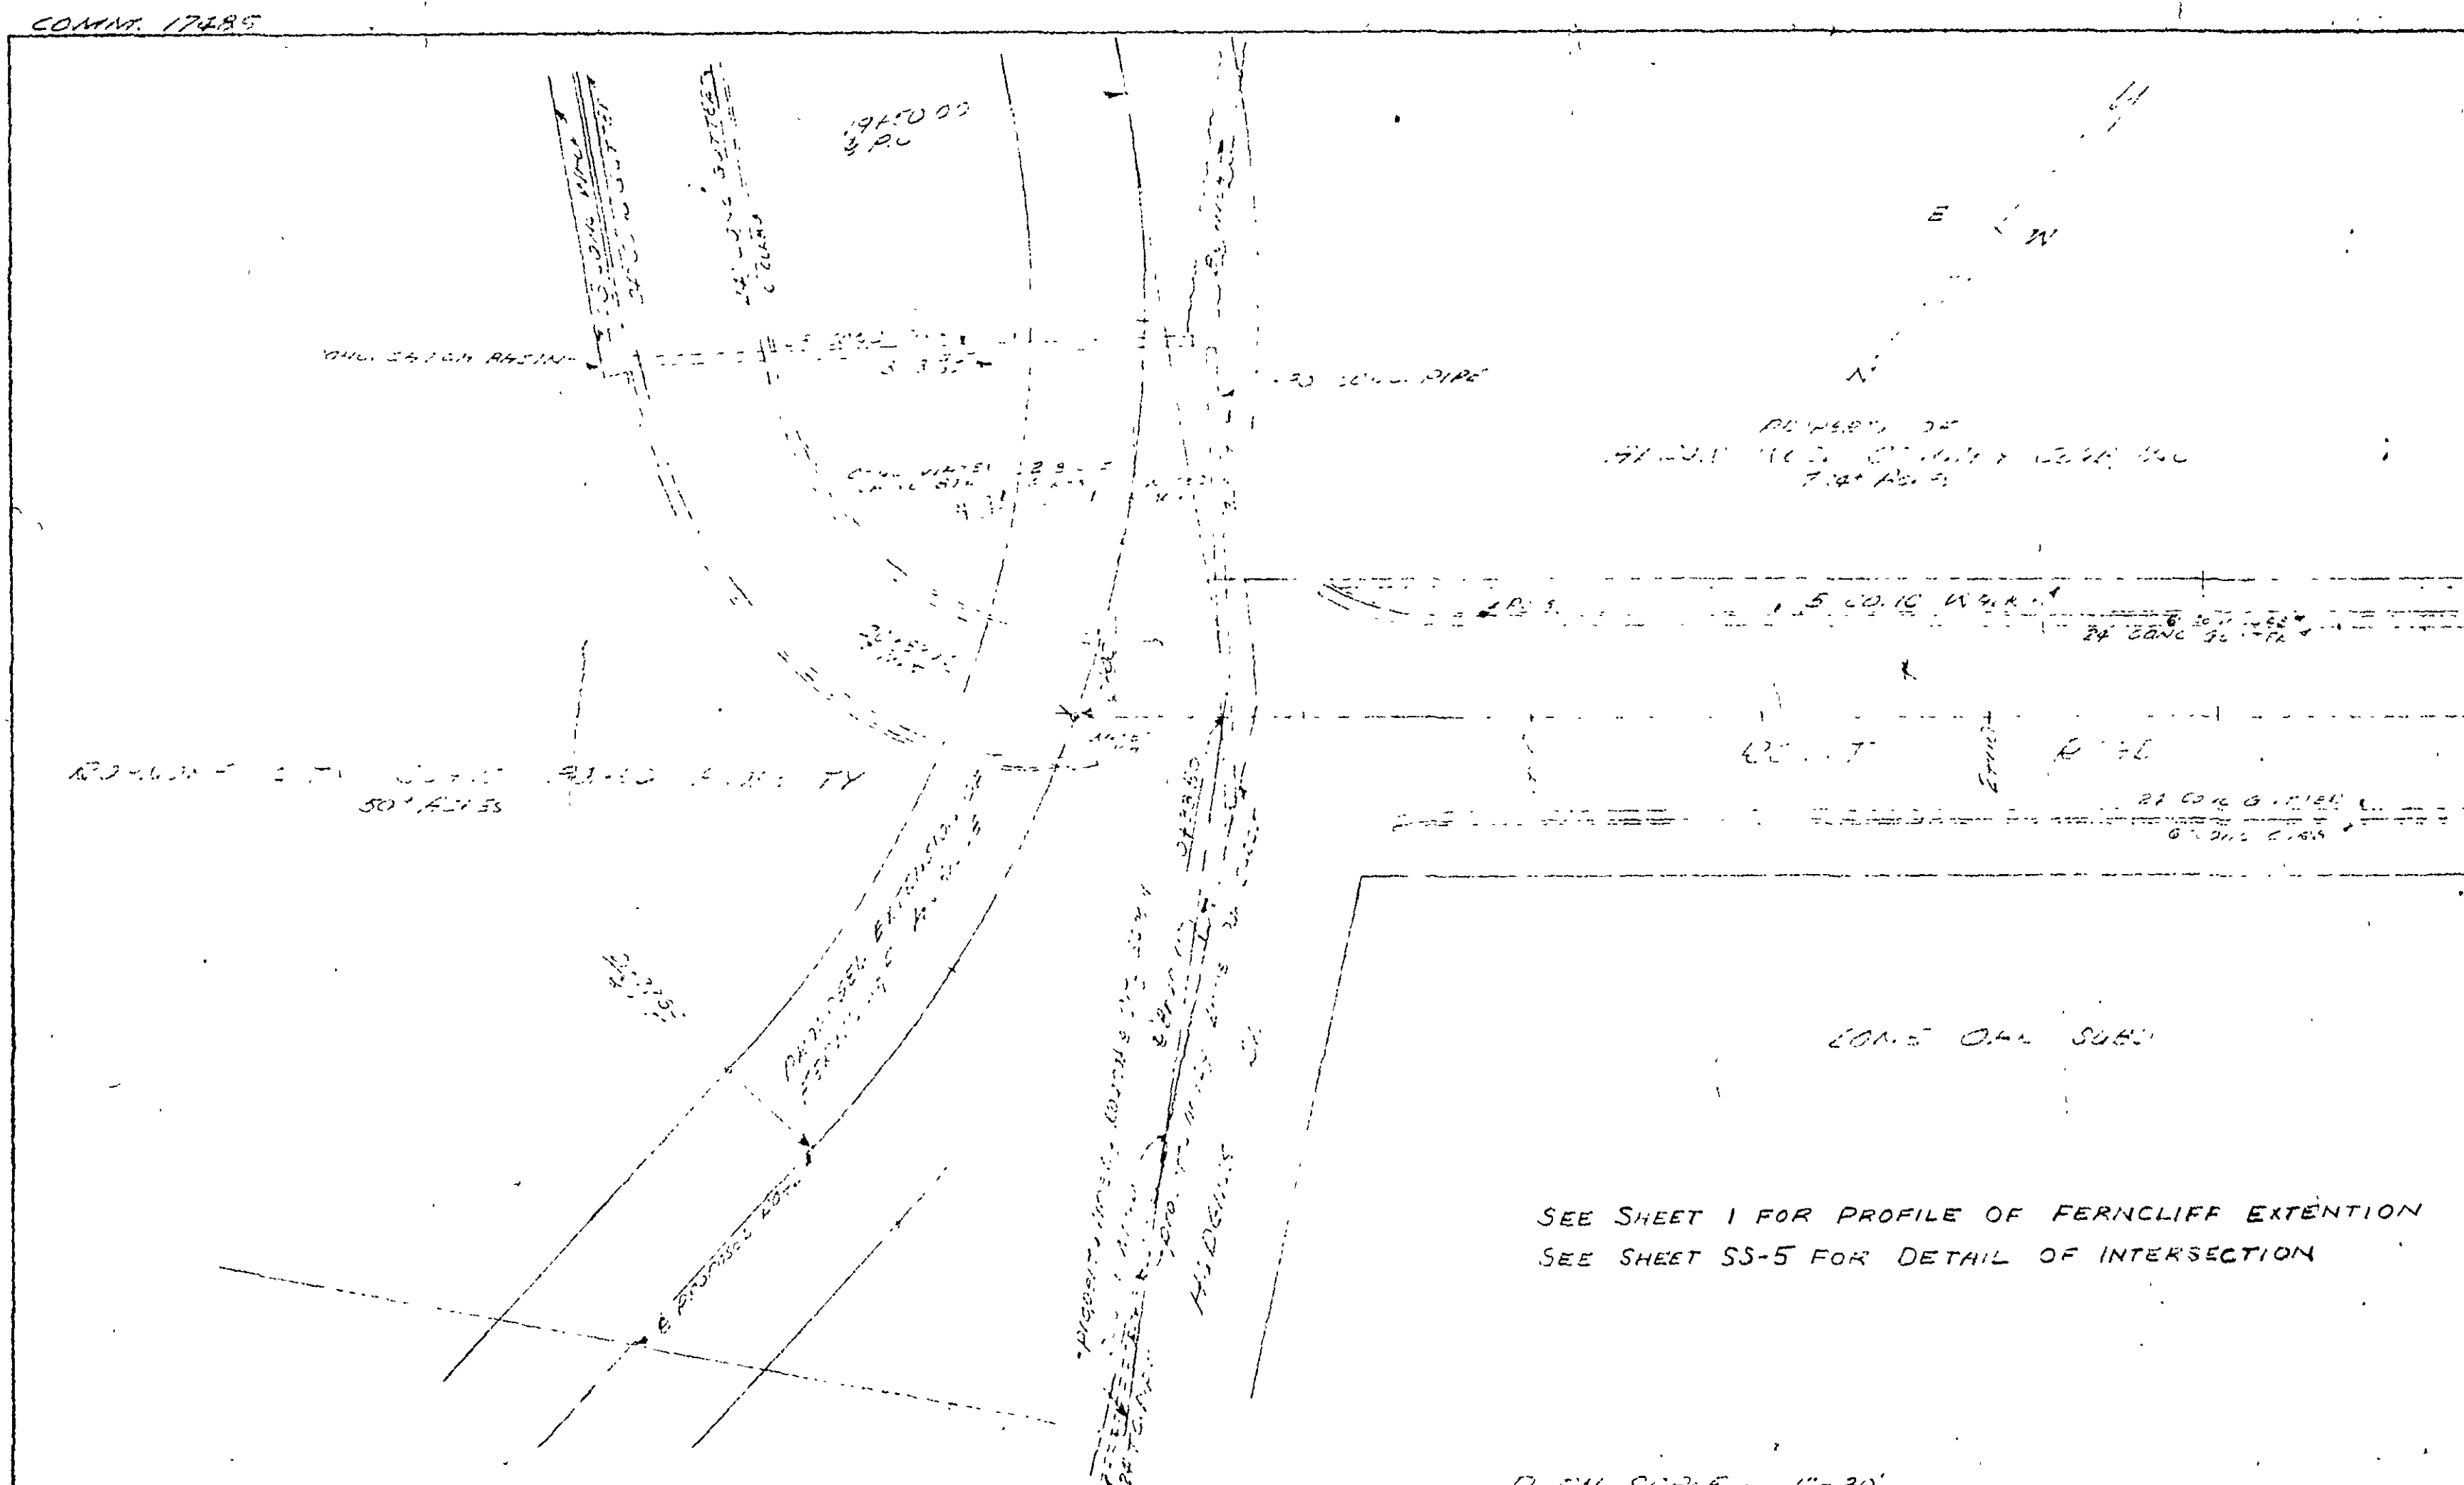


SEE SHEET 1 FOR PROFILE OF FERNCLIFF EXTENTION
SEE SHEET SS-5 FOR DETAIL OF INTERSECTION

PLAN SCALE: 1"=30'

SCALE: 1"=10' VERTICAL
1"=30' HORIZONTAL

PROFILE	SUBMIT
NOTE BOOK	DATE
NO.	BY

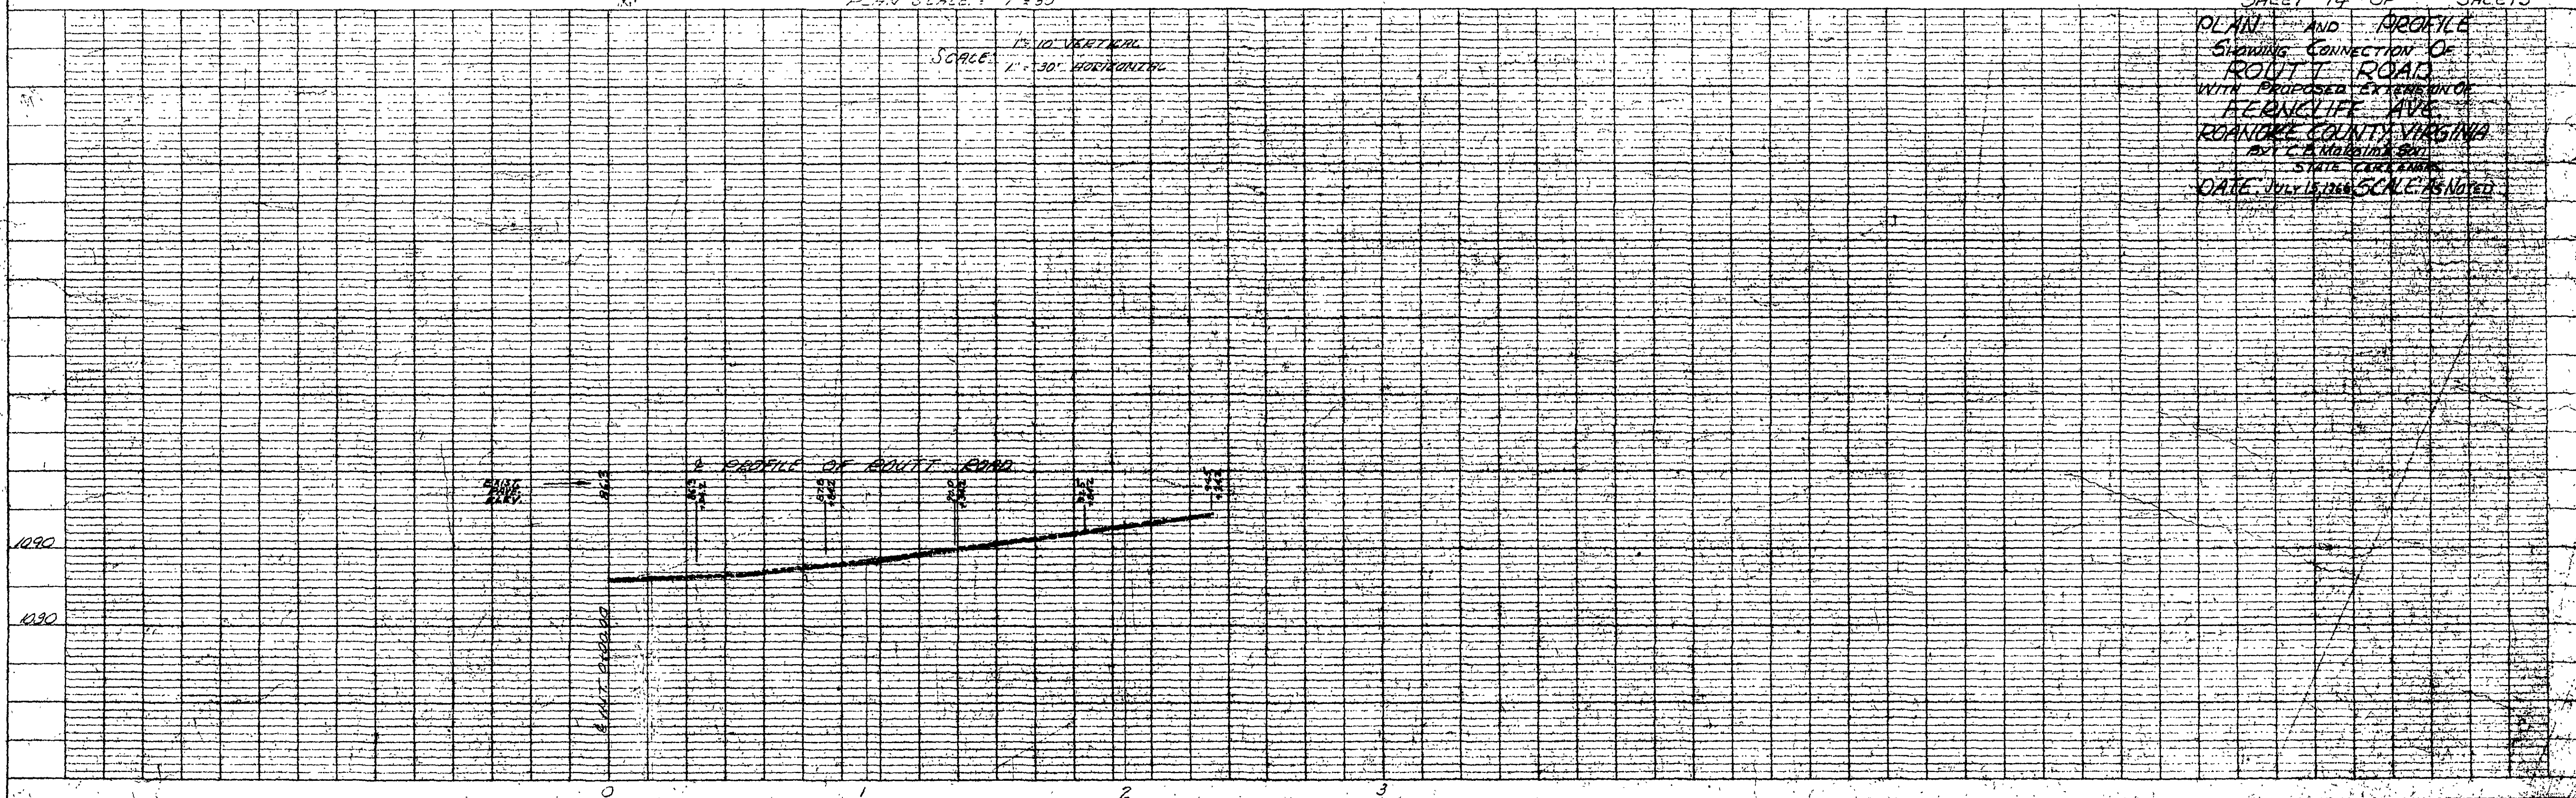

AS BUILT

SHEET 14 OF SHEETS
PLAN AND PROFILE
SHOWING CONNECTION OF
ROUTE 1
WITH PROPOSED EXTENSION
OF FERNCLIFF AVE
ROANOKE COUNTY VIRGINIA
BY C. E. MORGAN, JR.
STATE ENGINEER
DATE: JULY 15, 1966 SCALE AS NOTED