
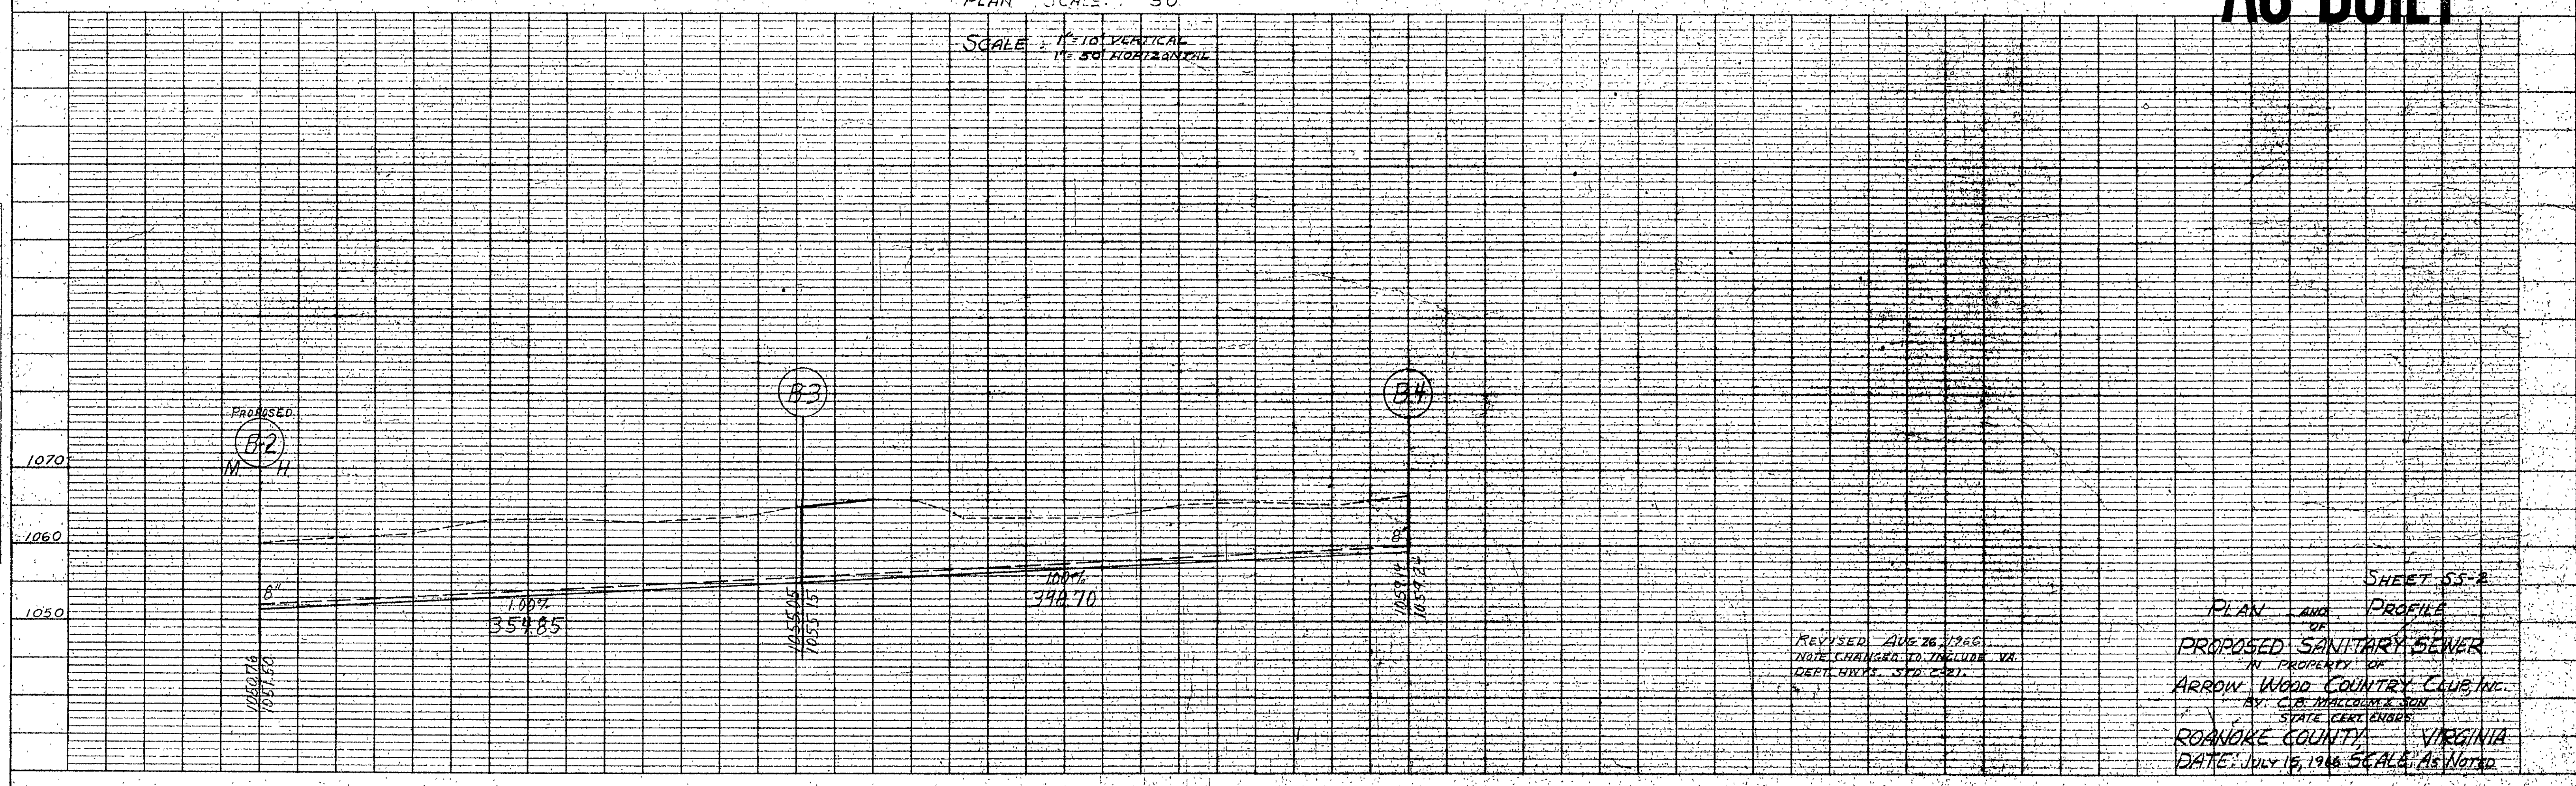


PLAN	DATE
SURVEYED	BY
NOTED	BY
PLANNED	BY
ALIGNED	BY
CHECKED	BY
RT OF WAY	BY

PROFILE	DATE
SURVEYED	BY
NOTED	BY
PLANNED	BY
ALIGNED	BY
CHECKED	BY
STRUCTURE	BY

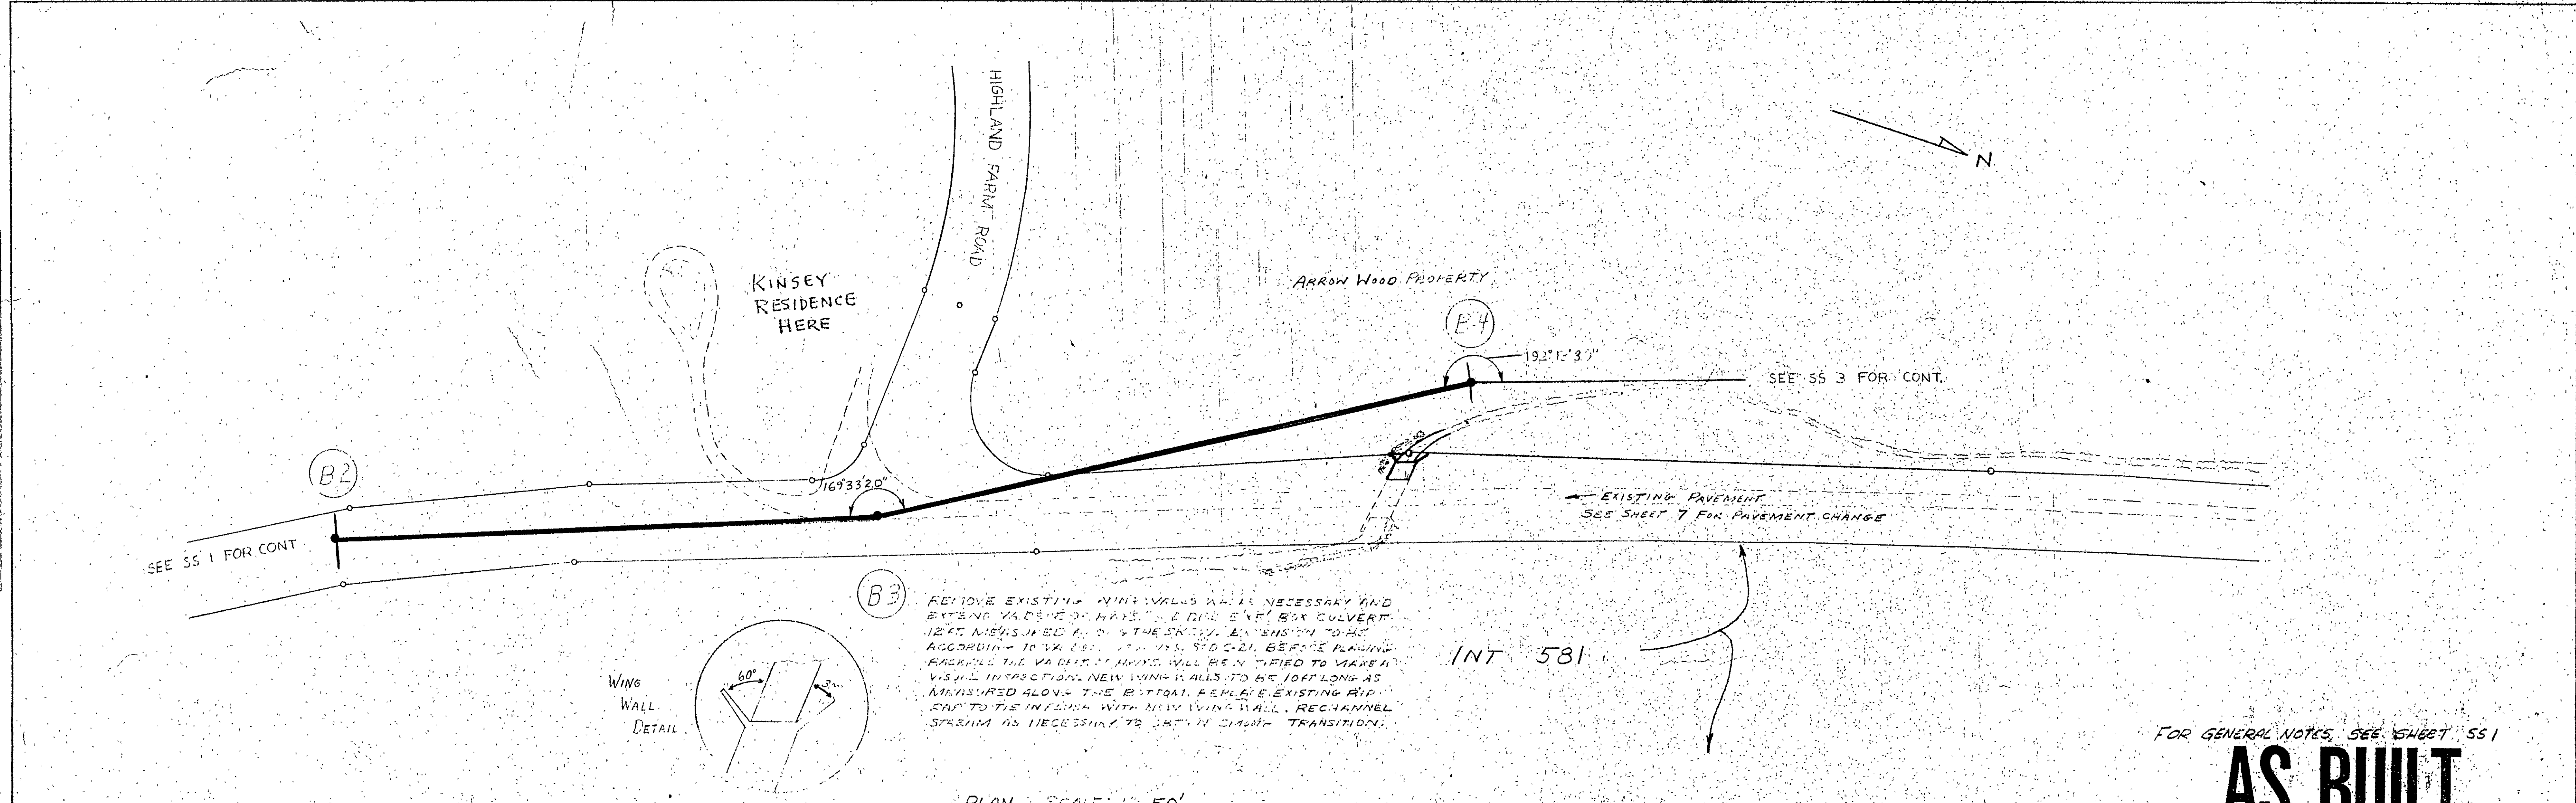

FOR GENERAL NOTES, SEE SHEET SS-1

AS BUILT

REVISED AUG 26, 1966
NOTE CHANGED TO INCLUDE VERTICAL CURVE SFD 2321.

SHEET SS-2
PLAN AND PROFILE
PROPOSED SANITARY SEWER
IN PROPERTY OF
ARROW WOOD COUNTRY CLUB, INC.
BY C.B. MALCOLM & SON
STATE CERT. ENGRS.
ROANOKE COUNTY, VIRGINIA
DATE: JULY 16, 1966 SCALE: AS NOTED

PLATE 1 - PLAN PROFILE
E. K. ELLIOTT COMPANY
100 400 BLOOMING TRACING PAPER

Arrow Wood