

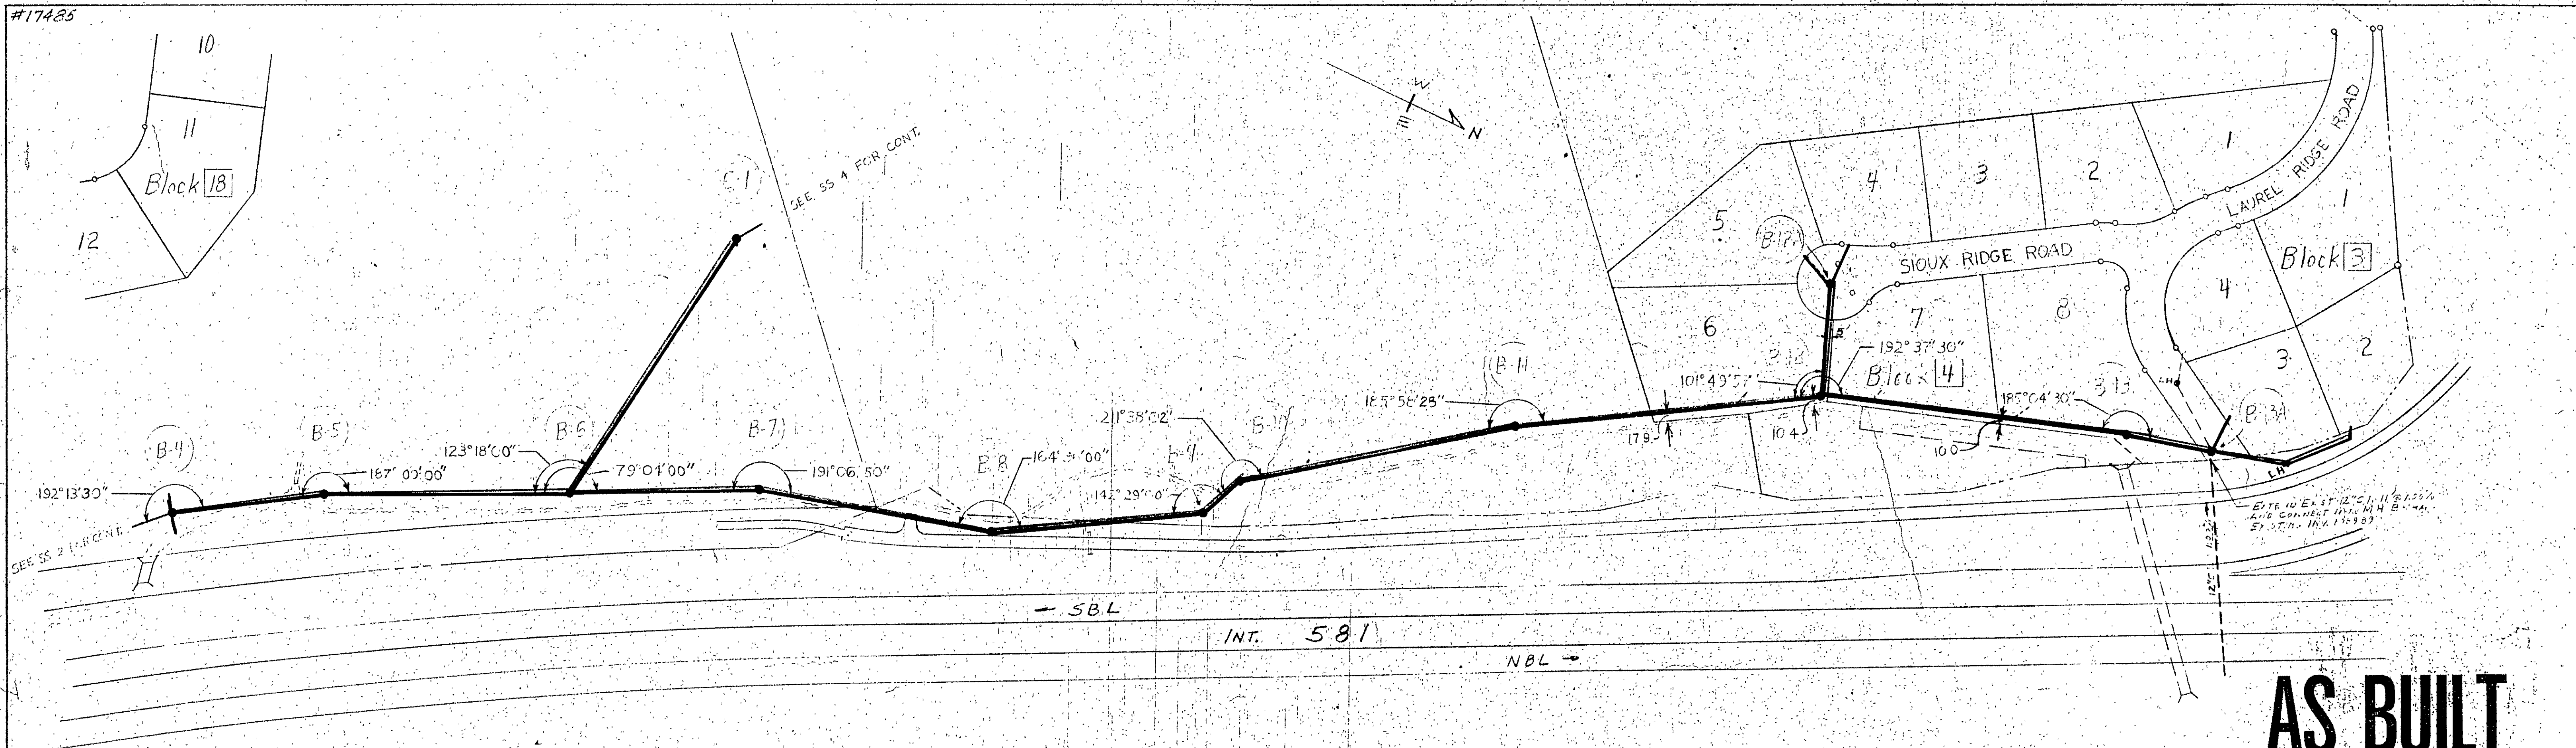
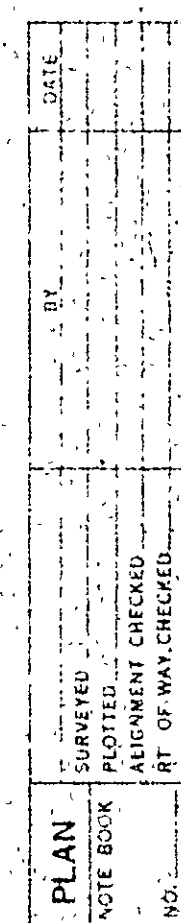


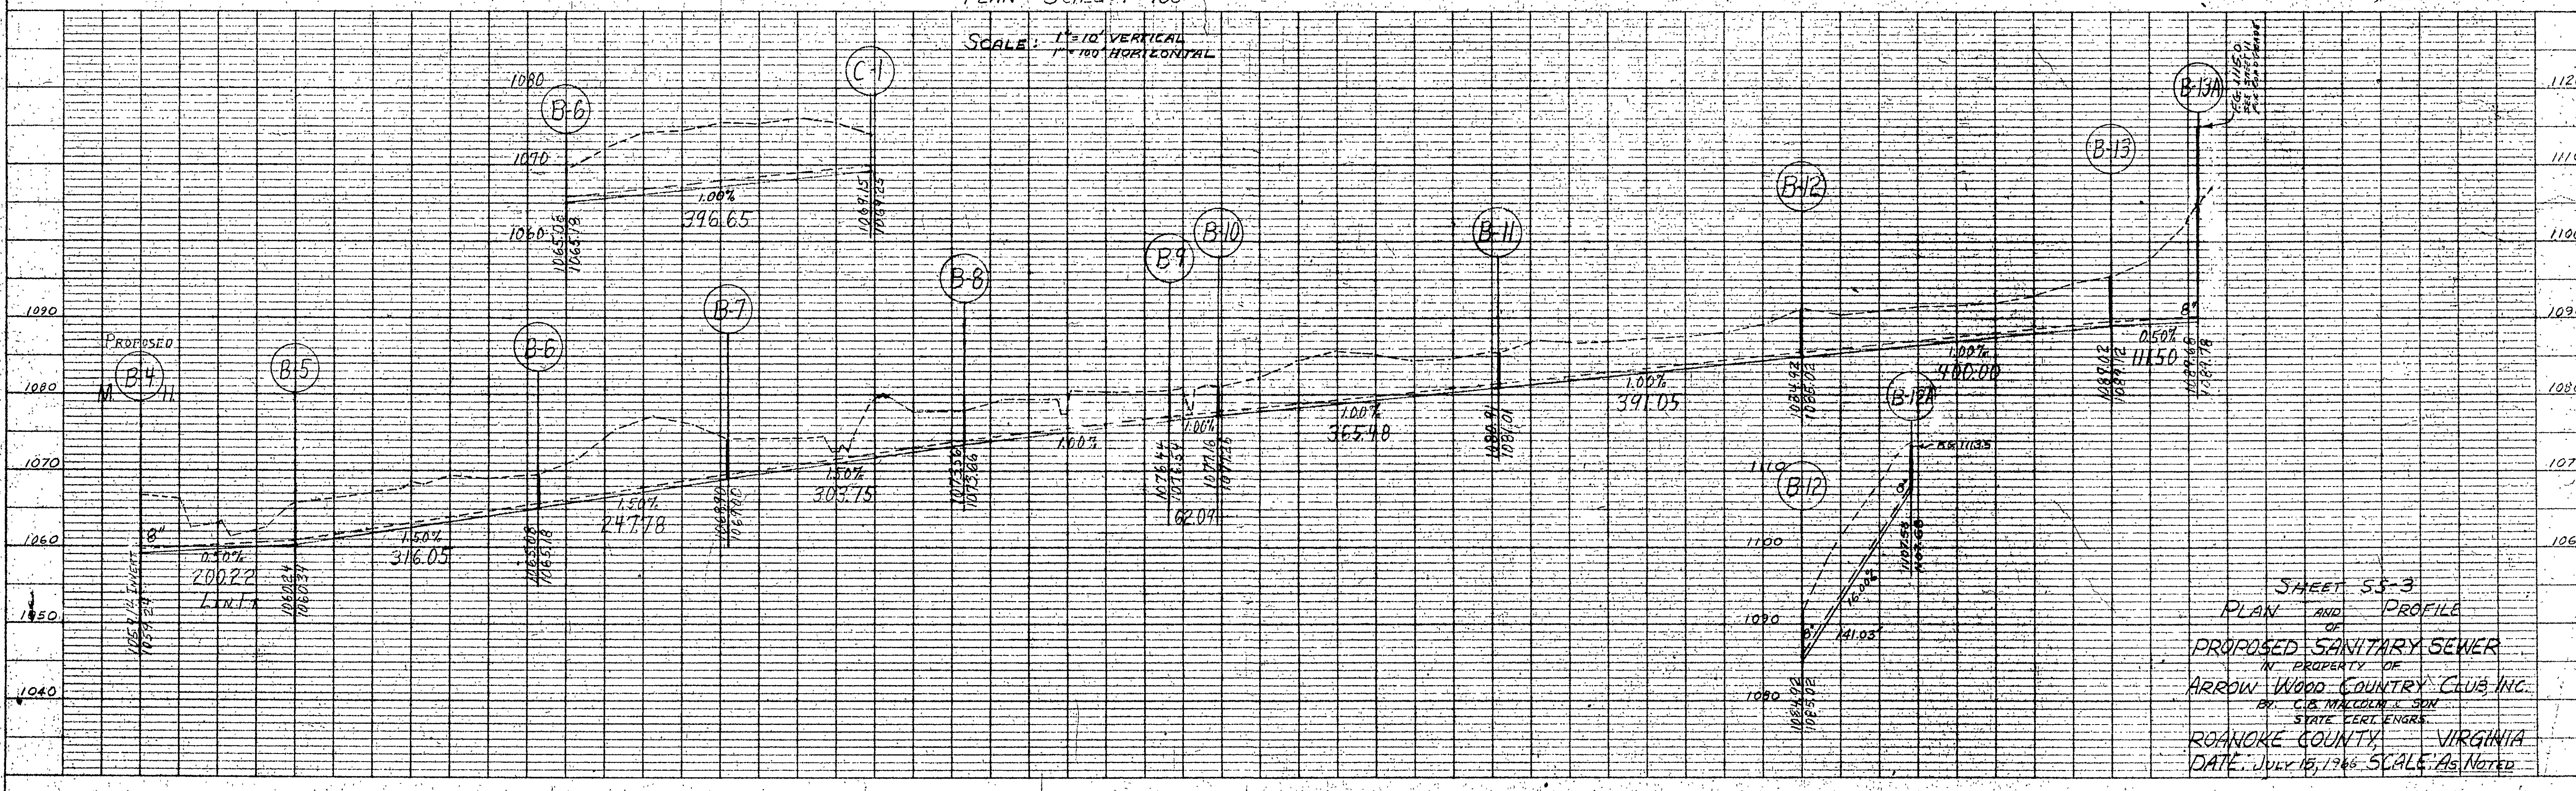

AS BUILT

PLAN SCALE: 1"=100'

FOR GENERAL NOTES SEE SHEET 551

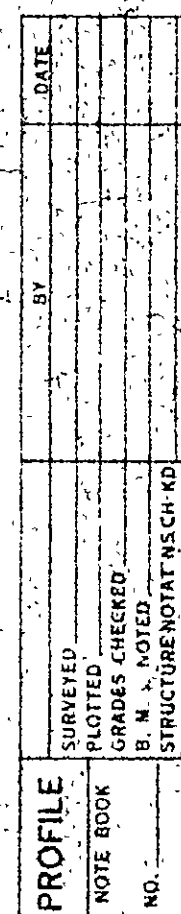

SHEET 53-3
PLAN AND PROFILE
OF
PROPOSED SANITARY SEWER
IN PROPERTY OF
ARROW WOOD COUNTRY CLUB INC.
BY: C.B. MALCOLM & SON
STATE CERT. ENGRS.
ROANOKE COUNTY, VIRGINIA
DATE: JULY 15, 1986 SCALE: AS NOTED