
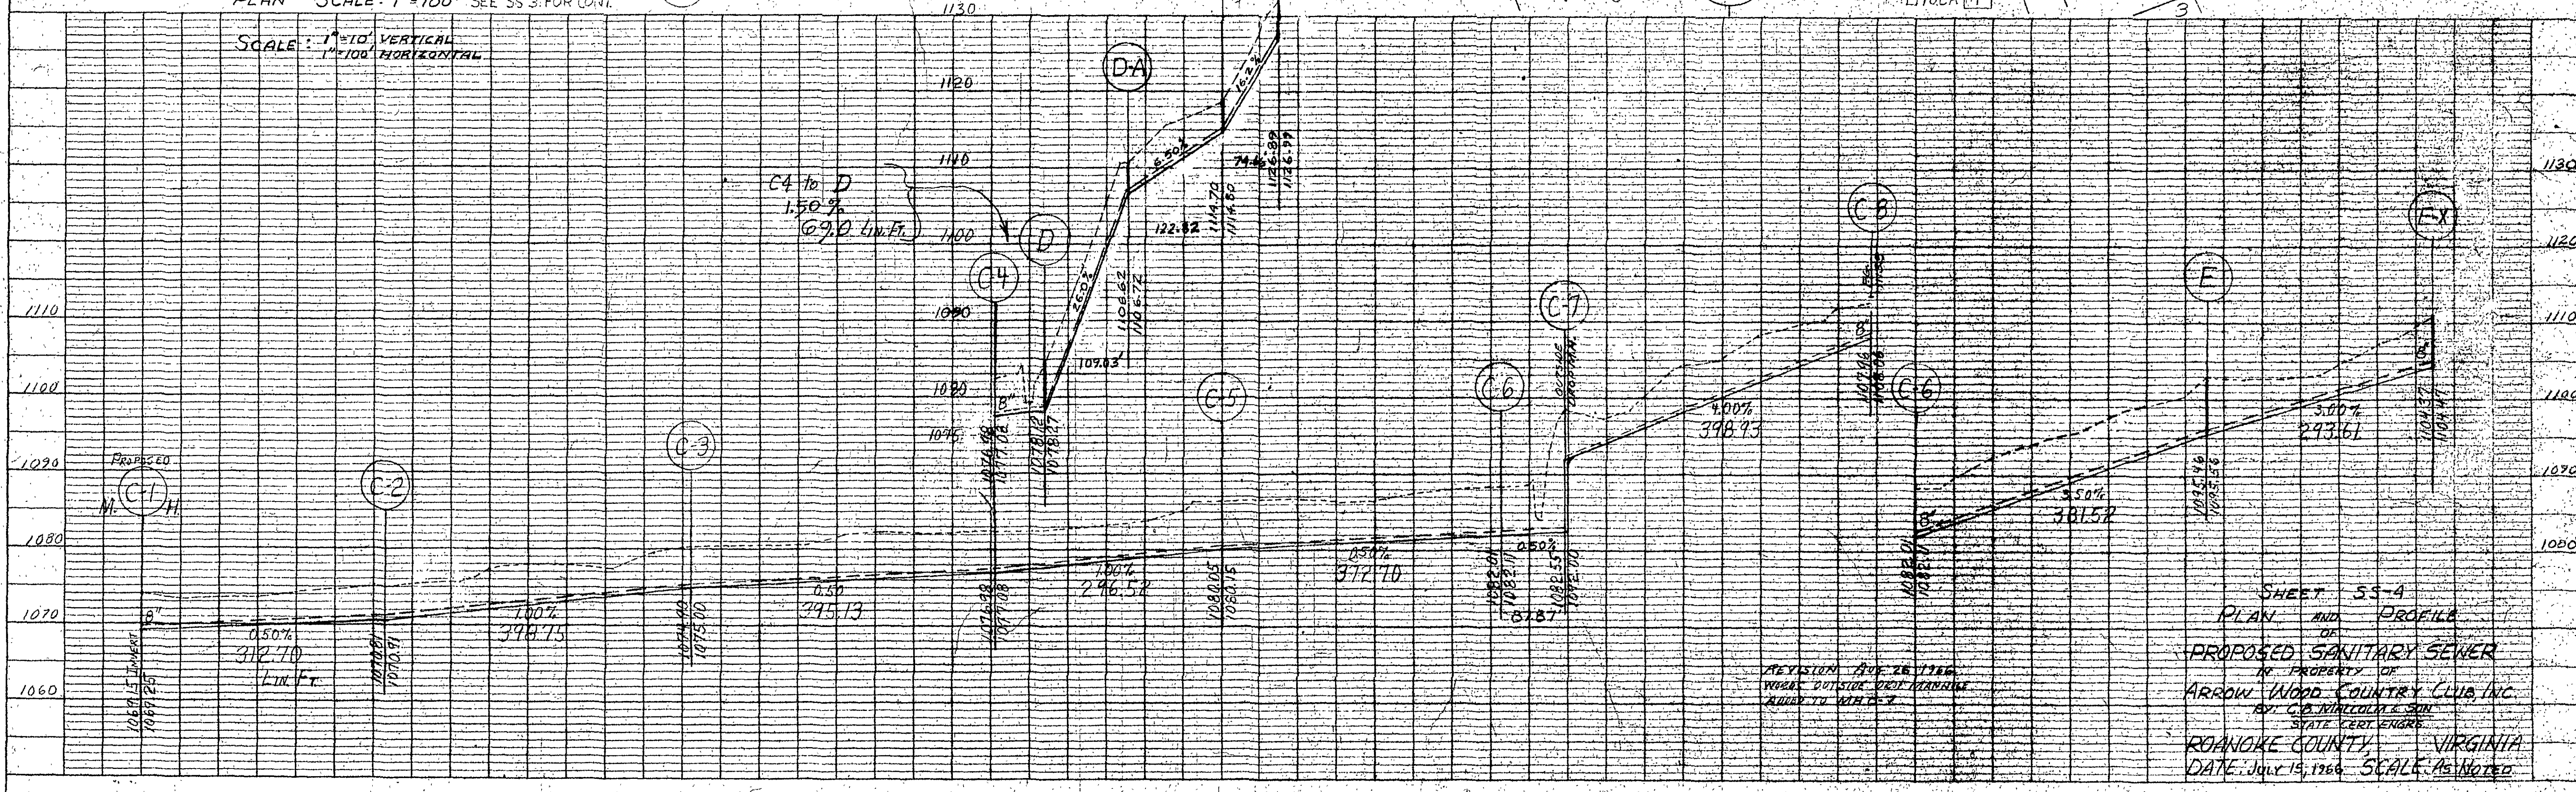


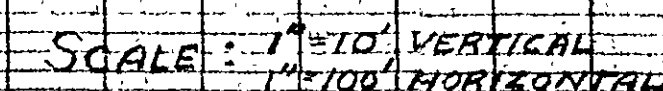

AS BUILT

FOR GENERAL NOTES SEE SHEET 5

SHEET 55-4
PLAN AND PROFILE
OF
PROPOSED SANITARY SEWER
IN PROPERTY OF
ARROW WOOD COUNTRY CLUB INC.
BY C.B. MATHCOLE & SON
STATE CERT. ENGRS.
ROANOKE COUNTY, VIRGINIA
DATE JULY 15, 1960 SCALE AS NOTED