



PLAN	SURVEYED	DATE
NOTE BOOK	PLOTTED	BY
	ALIGNMENT CHECKED	
	BY OF MAY CHECKED	
NO.		

PROFILE	SURVEYED	DATE
NOTE BOOK	GRADES CHECKED	BY
	B.M. NOTED	
	STRUCTURE NOTED	
NO.		

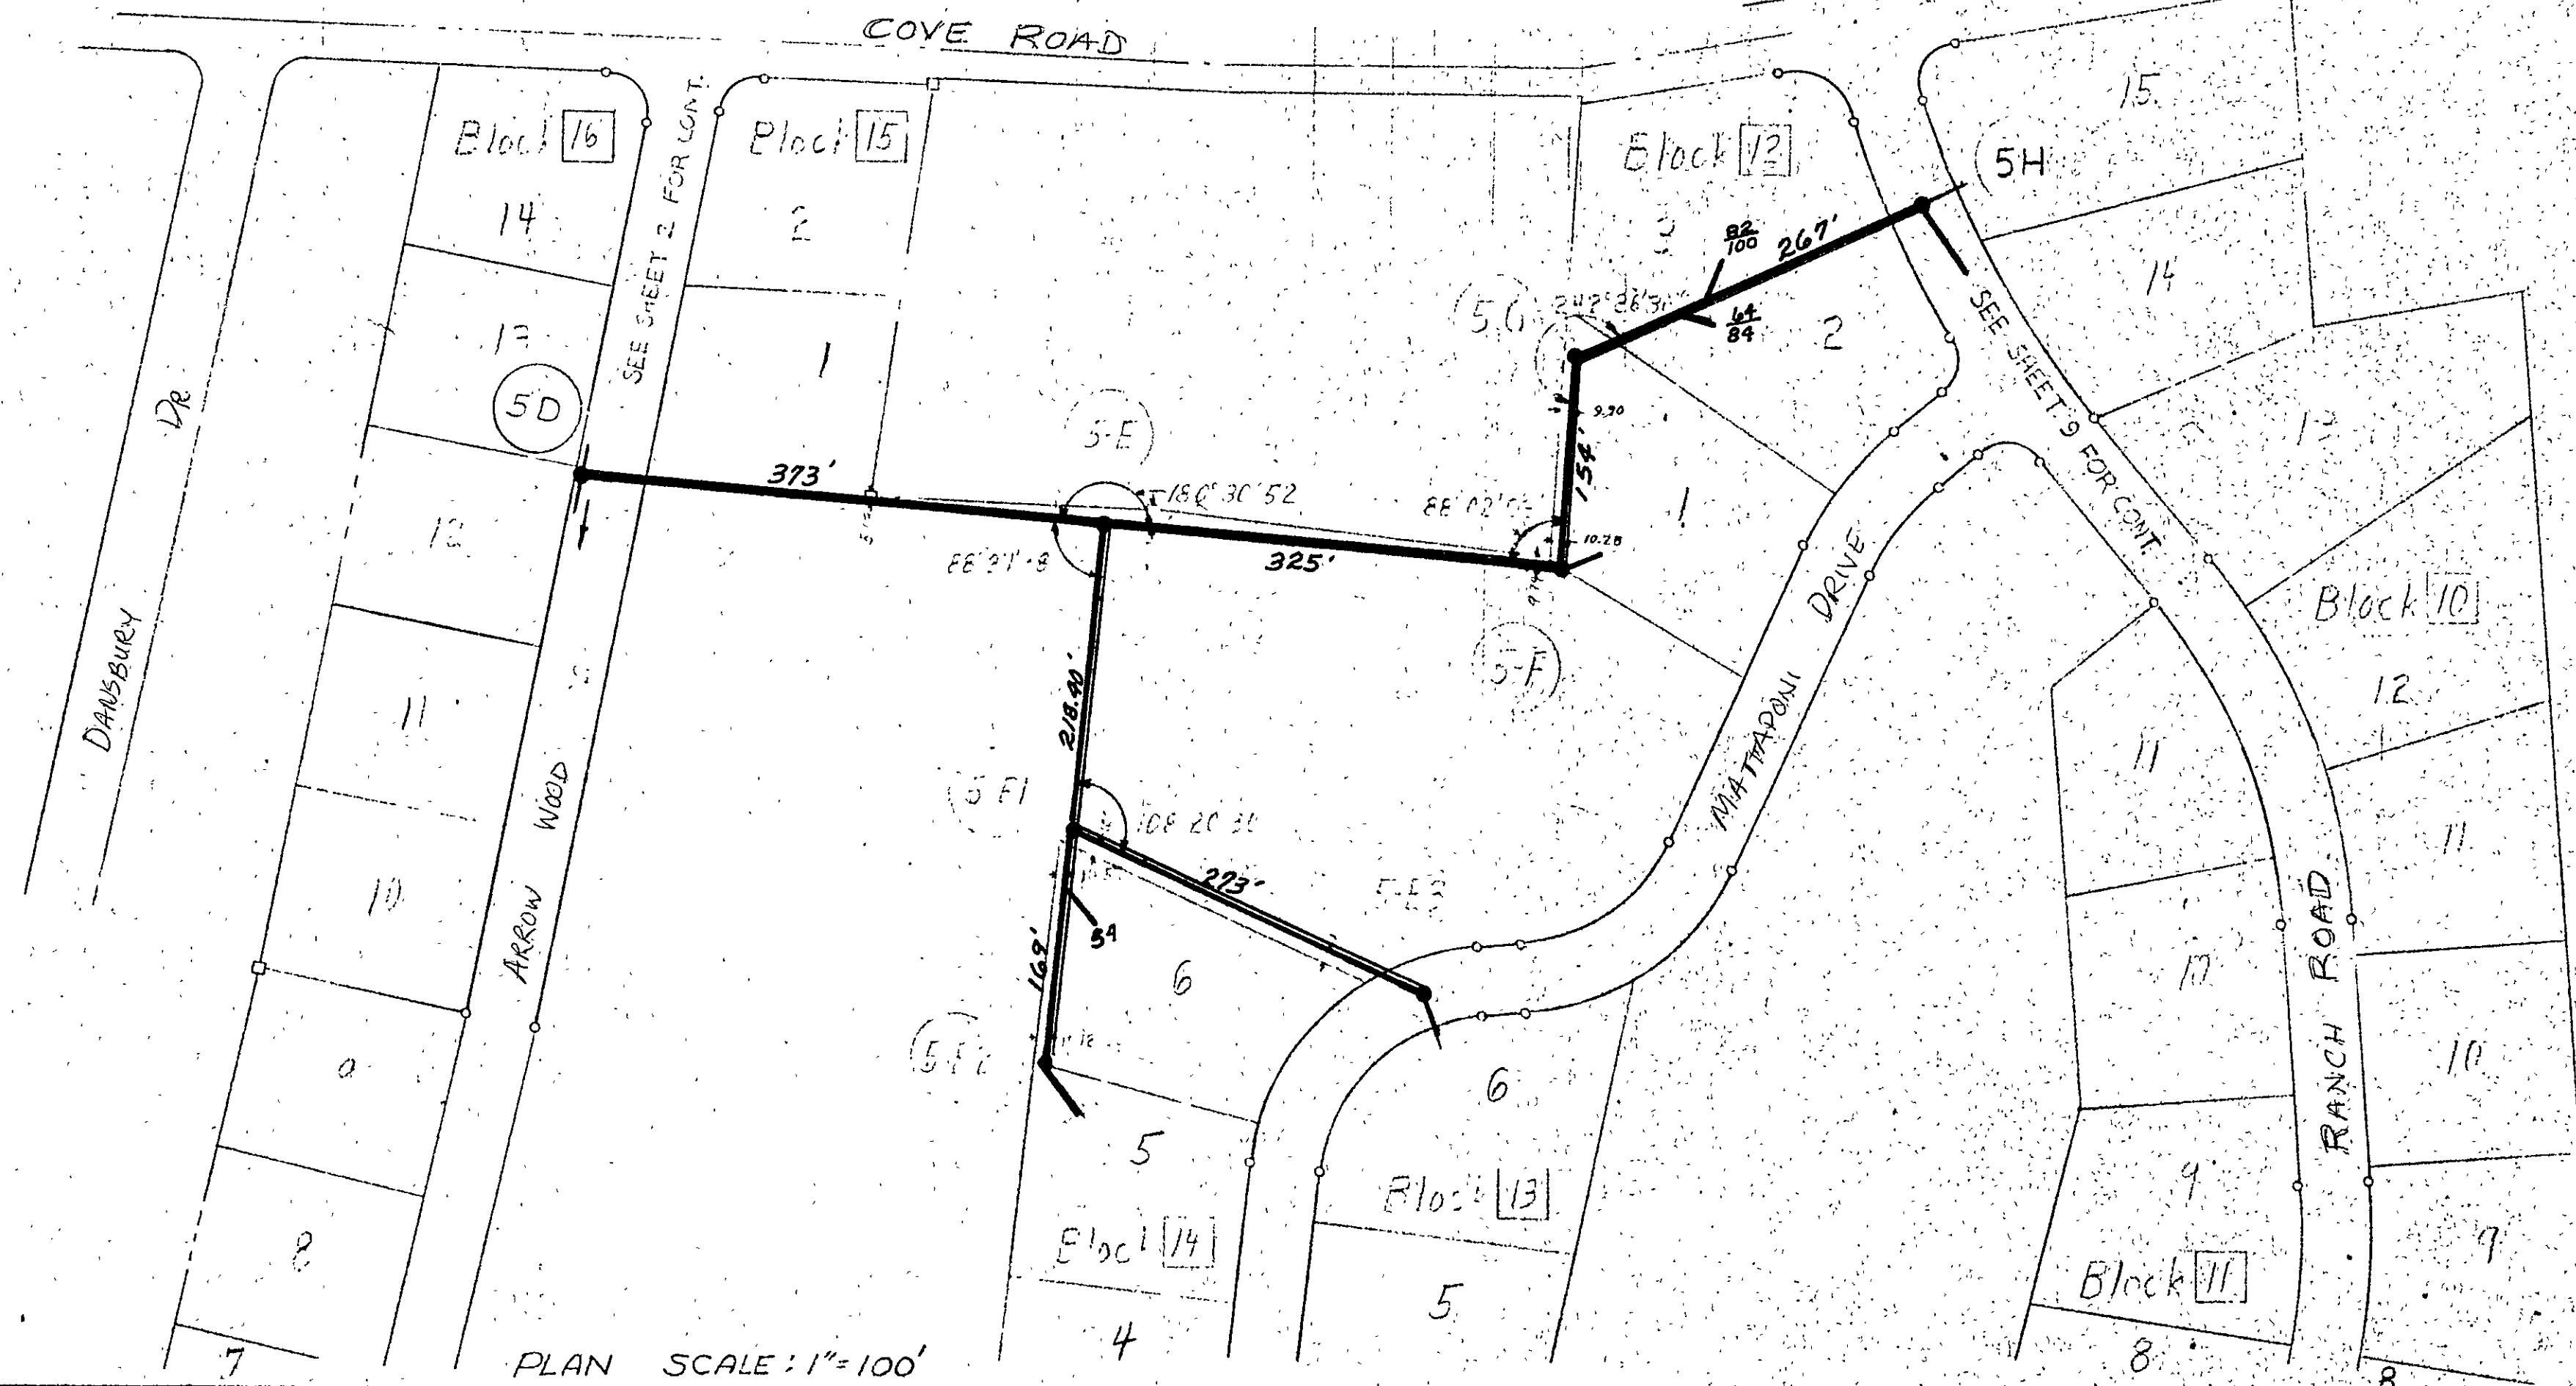

FOR GENERAL NOTES, SEE SHEET

AS BUILT

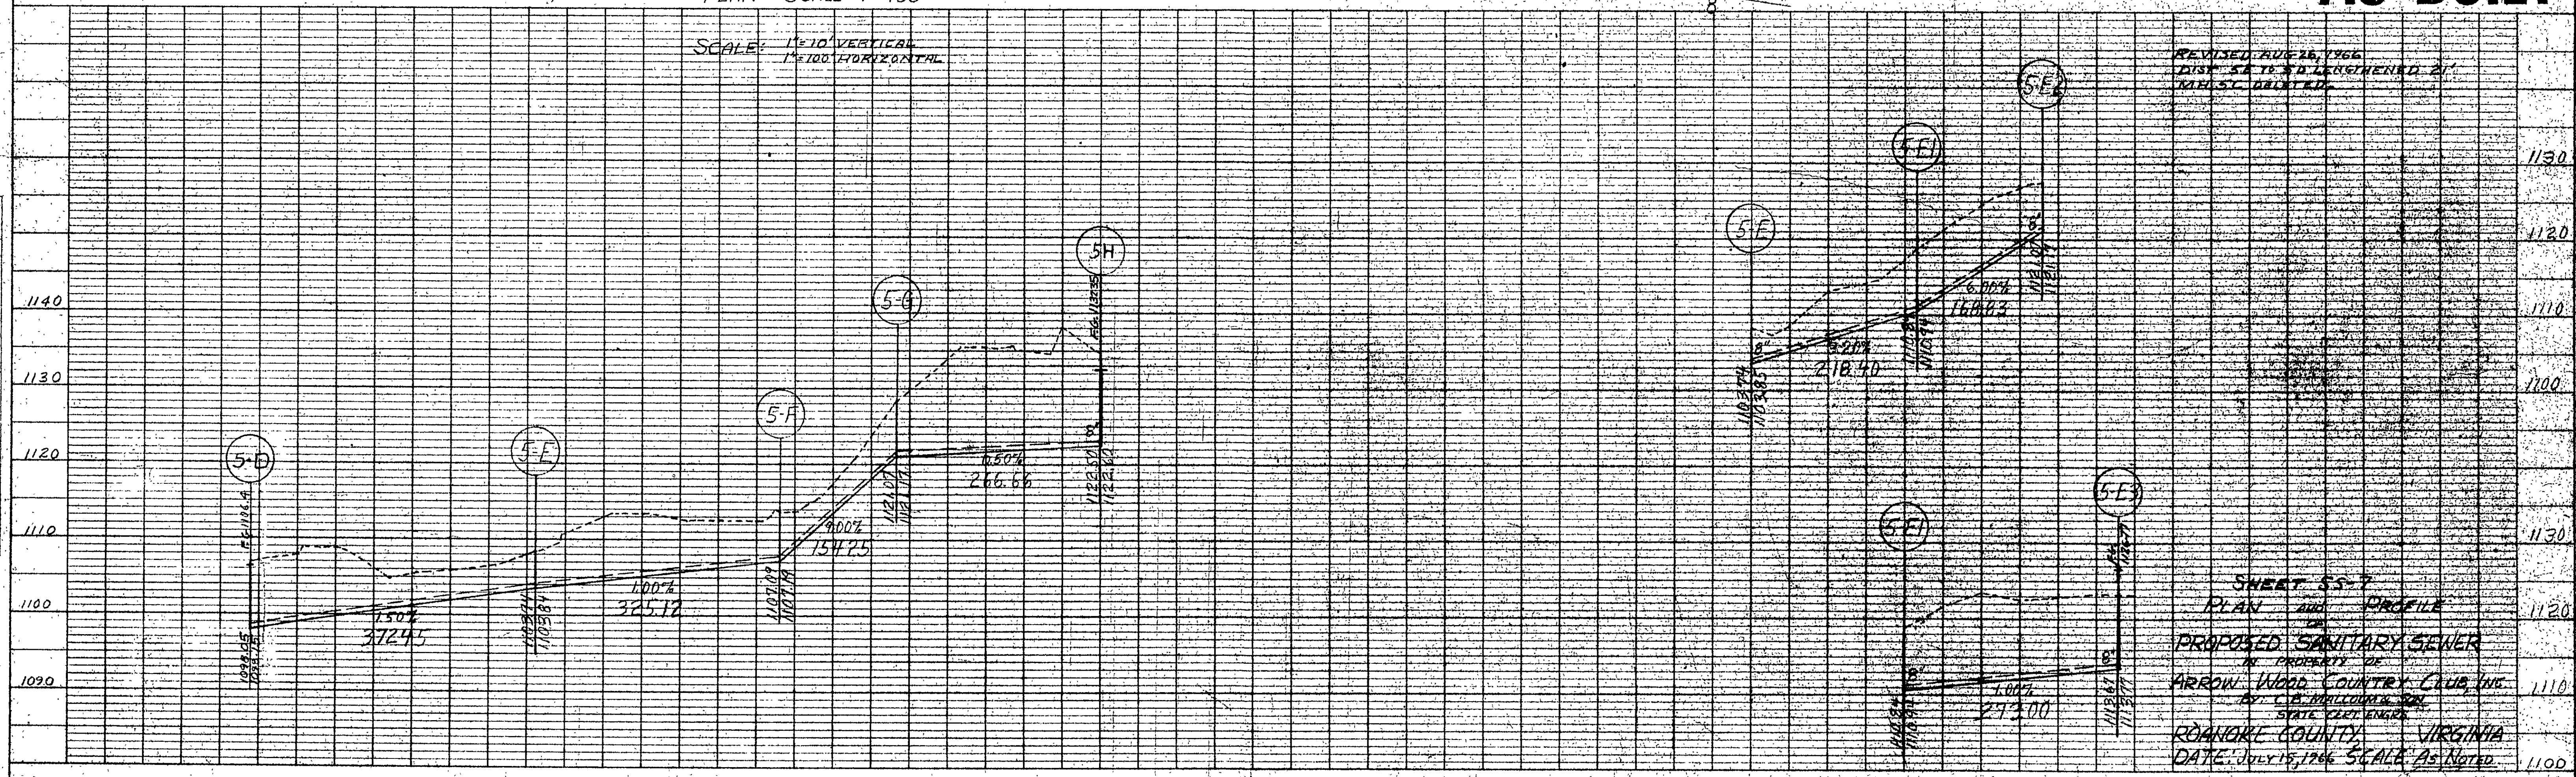

REVISED AUG 26, 1966
DIST. 58 TO 59 LENGTHENED 21'
REPL. PLANTED

SHEET SS-7
PLAN and PROFILE
PROPOSED SANITARY SEWER
IN PROPERTY OF
ARROW WOOD COUNTRY CLUB, INC.
BY C.A. MALLORY & SON
STATE PLANNING ENGINEERS
ROANOKE COUNTY, VIRGINIA
DATE: JULY 15, 1966 SCALE: As Noted