
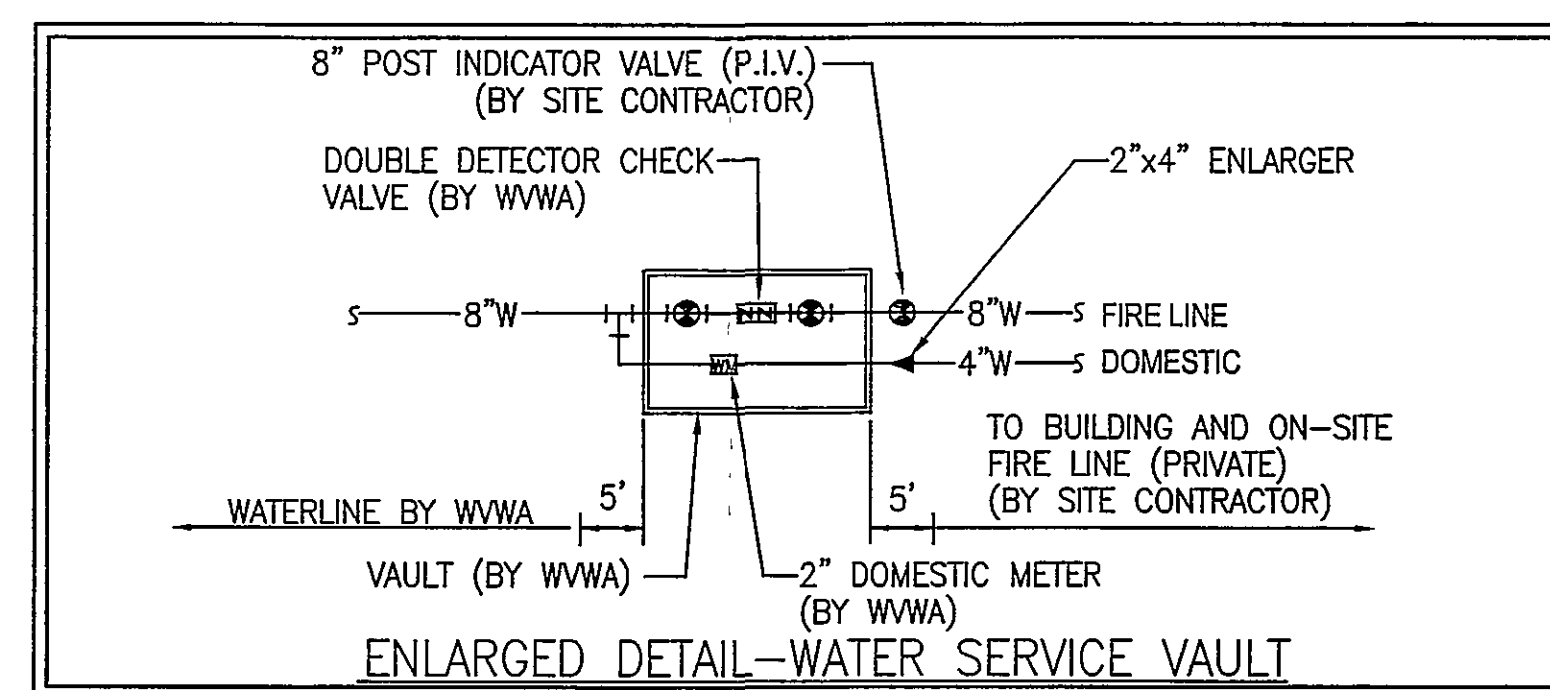


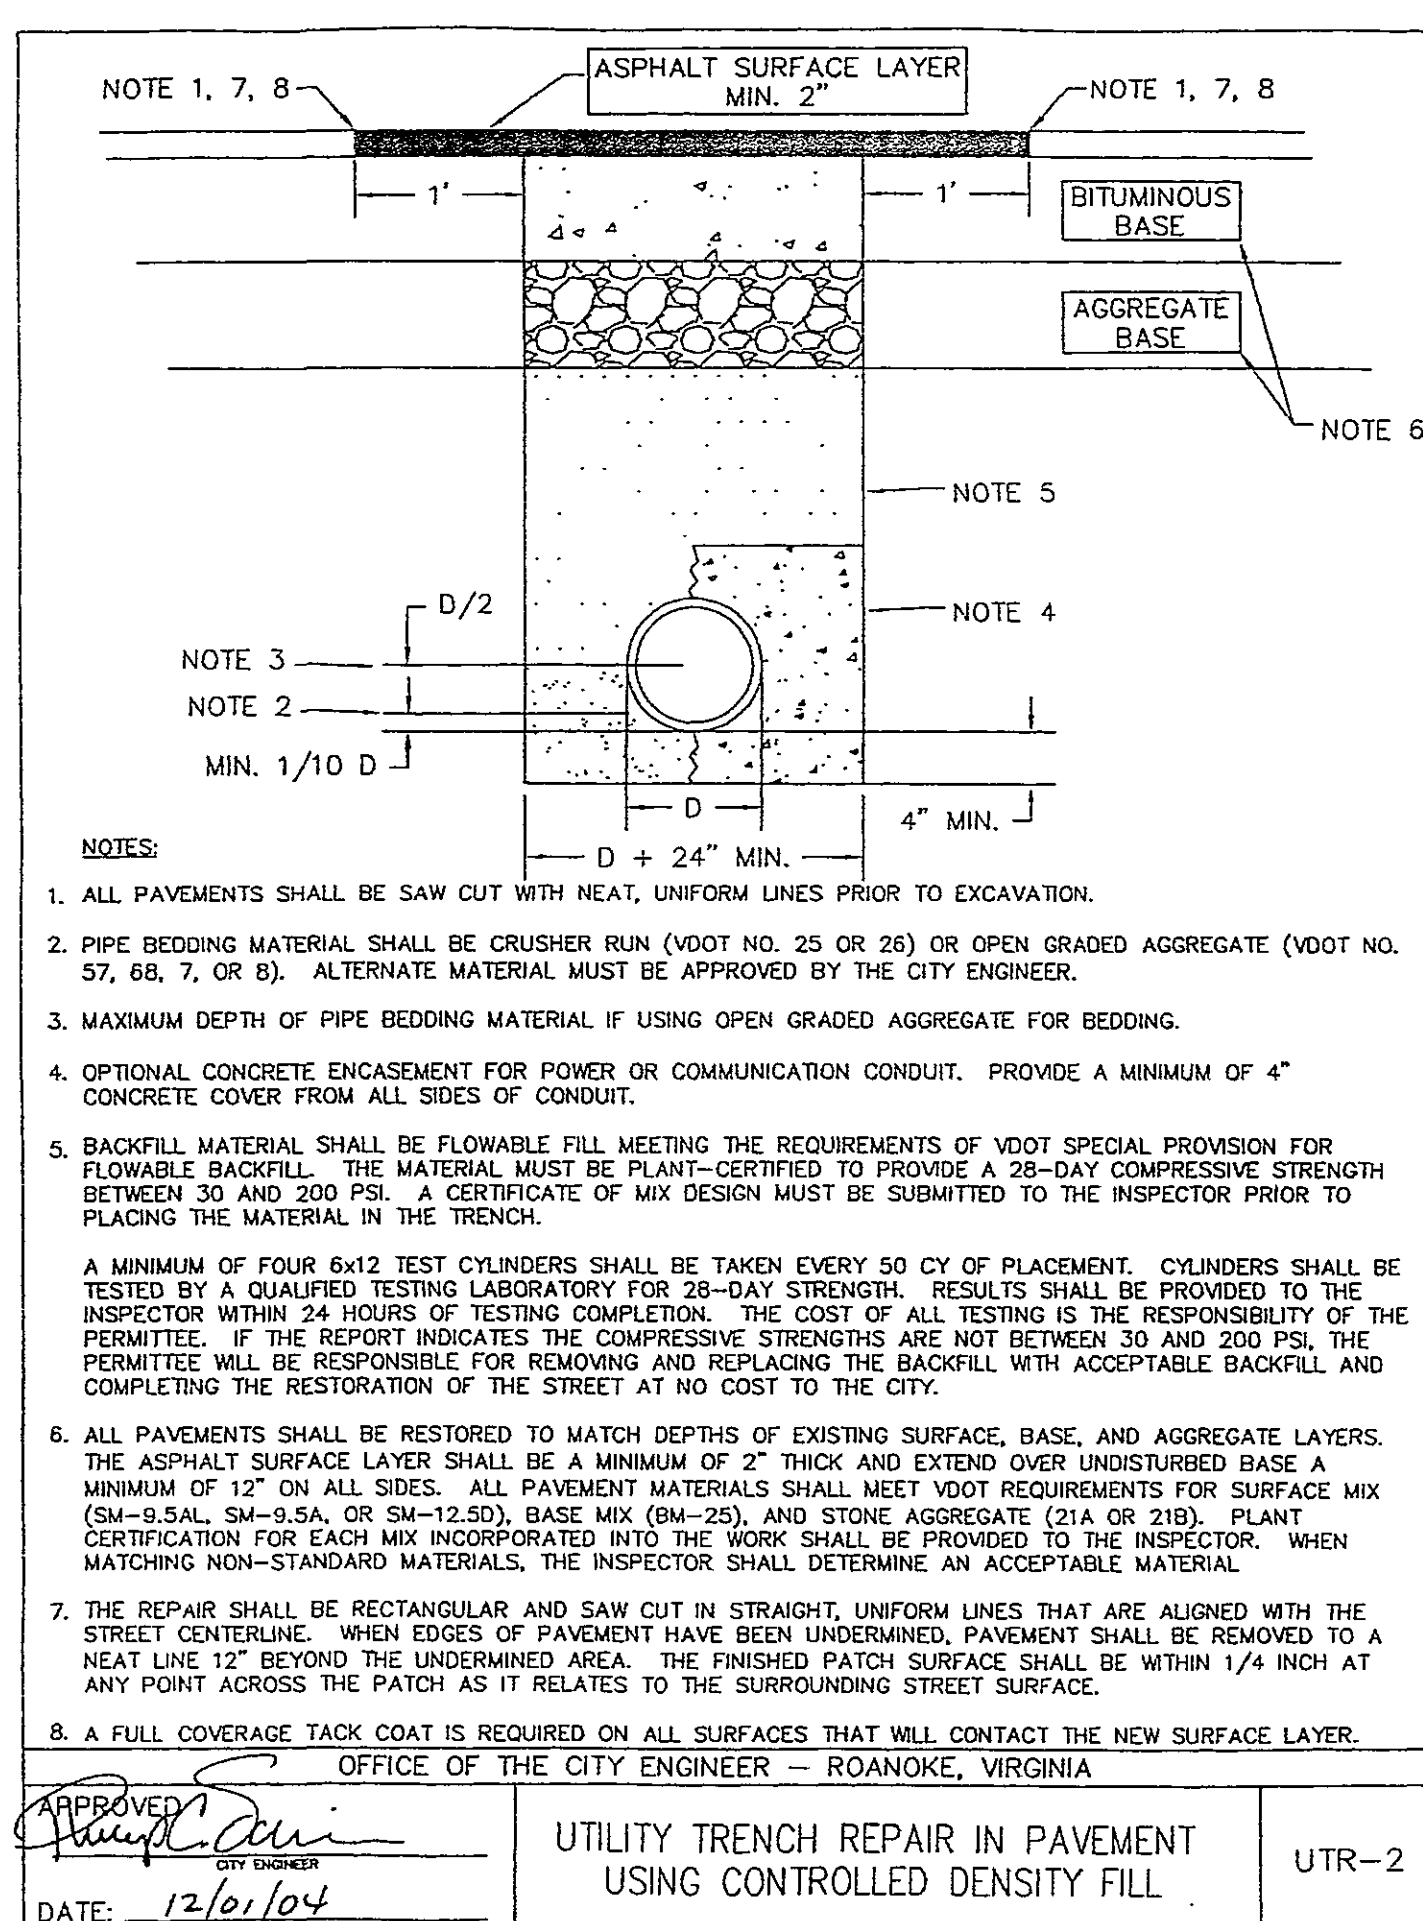


* BEND ARE MEGA LUGGED
PIPE INSTALLED WITH FIELD LOC GASKETS

as BUILT
8-30-07

Black

UTILITY NOTES:

1. CONTRACTOR TO CONTRACT LOCATION & INVERT PRIOR TO INSTALLATION OF NEW SERVICE LINES.
2. CONTRACTOR TO CONTACT JAMIE MORRIS WITH THE WESTERN VIRGINIA WATER AUTHORITY (853-1588) FOR AN AVAILABILITY LETTER AND/OR TAP LETTER.
3. CLEAN-OUTS IN PAVEMENT OR SIDEWALK SHALL BE SET IN 6" DIAMETER CAST IRON VALVE BOX WITH TOP SET FLUSH WITH FINISHED PAVED GRADE.
4. GAS SERVICE LINE IS SHOWN FOR GENERAL INFORMATION ONLY. EXACT LOCATION TO BE DETERMINED AND INSTALLED BY GAS SERVICE COMPANY.
5. SANITARY SEWER LATERALS SHALL BE INSTALLED AT 2.08% SLOPE (MIN.) FROM POINT OF CONNECTION TO BUILDING. CONTRACTOR TO CONFORM INVERT OF EXISTING MAIN OR LATERAL PRIOR TO INSTALLATION OF LATERAL.
6. REFER TO BUILDING PLANS FOR EXACT LOCATION OF UTILITY SERVICE CONNECTIONS.
7. A STREET OPENING PERMIT, ISSUED BY THE CITY OF ROANOKE, WILL BE REQUIRED.
8. ALL WATER AND SEWER WORK IS TO CONFORM TO WESTERN VIRGINIA WATER AUTHORITY STANDARDS.
9. UPON COMPLETION OF NEW WATERLINE (INCLUDING PRESSURE TESTING, DISINFECTION, AND FLUSHING) CONNECT NEW 8" WATERLINE TO EXISTING WATERLINE. COORDINATE SHUTDOWN OF EXISTING WATERLINE WITH THE WESTERN VIRGINIA WATER AUTHORITY. OPEN CUT AND REPAIR ASPHALT PAVEMENT.
10. WESTERN VIRGINIA WATER AUTHORITY IS TO MAKE ALL WATER AND SEWER TAPS.

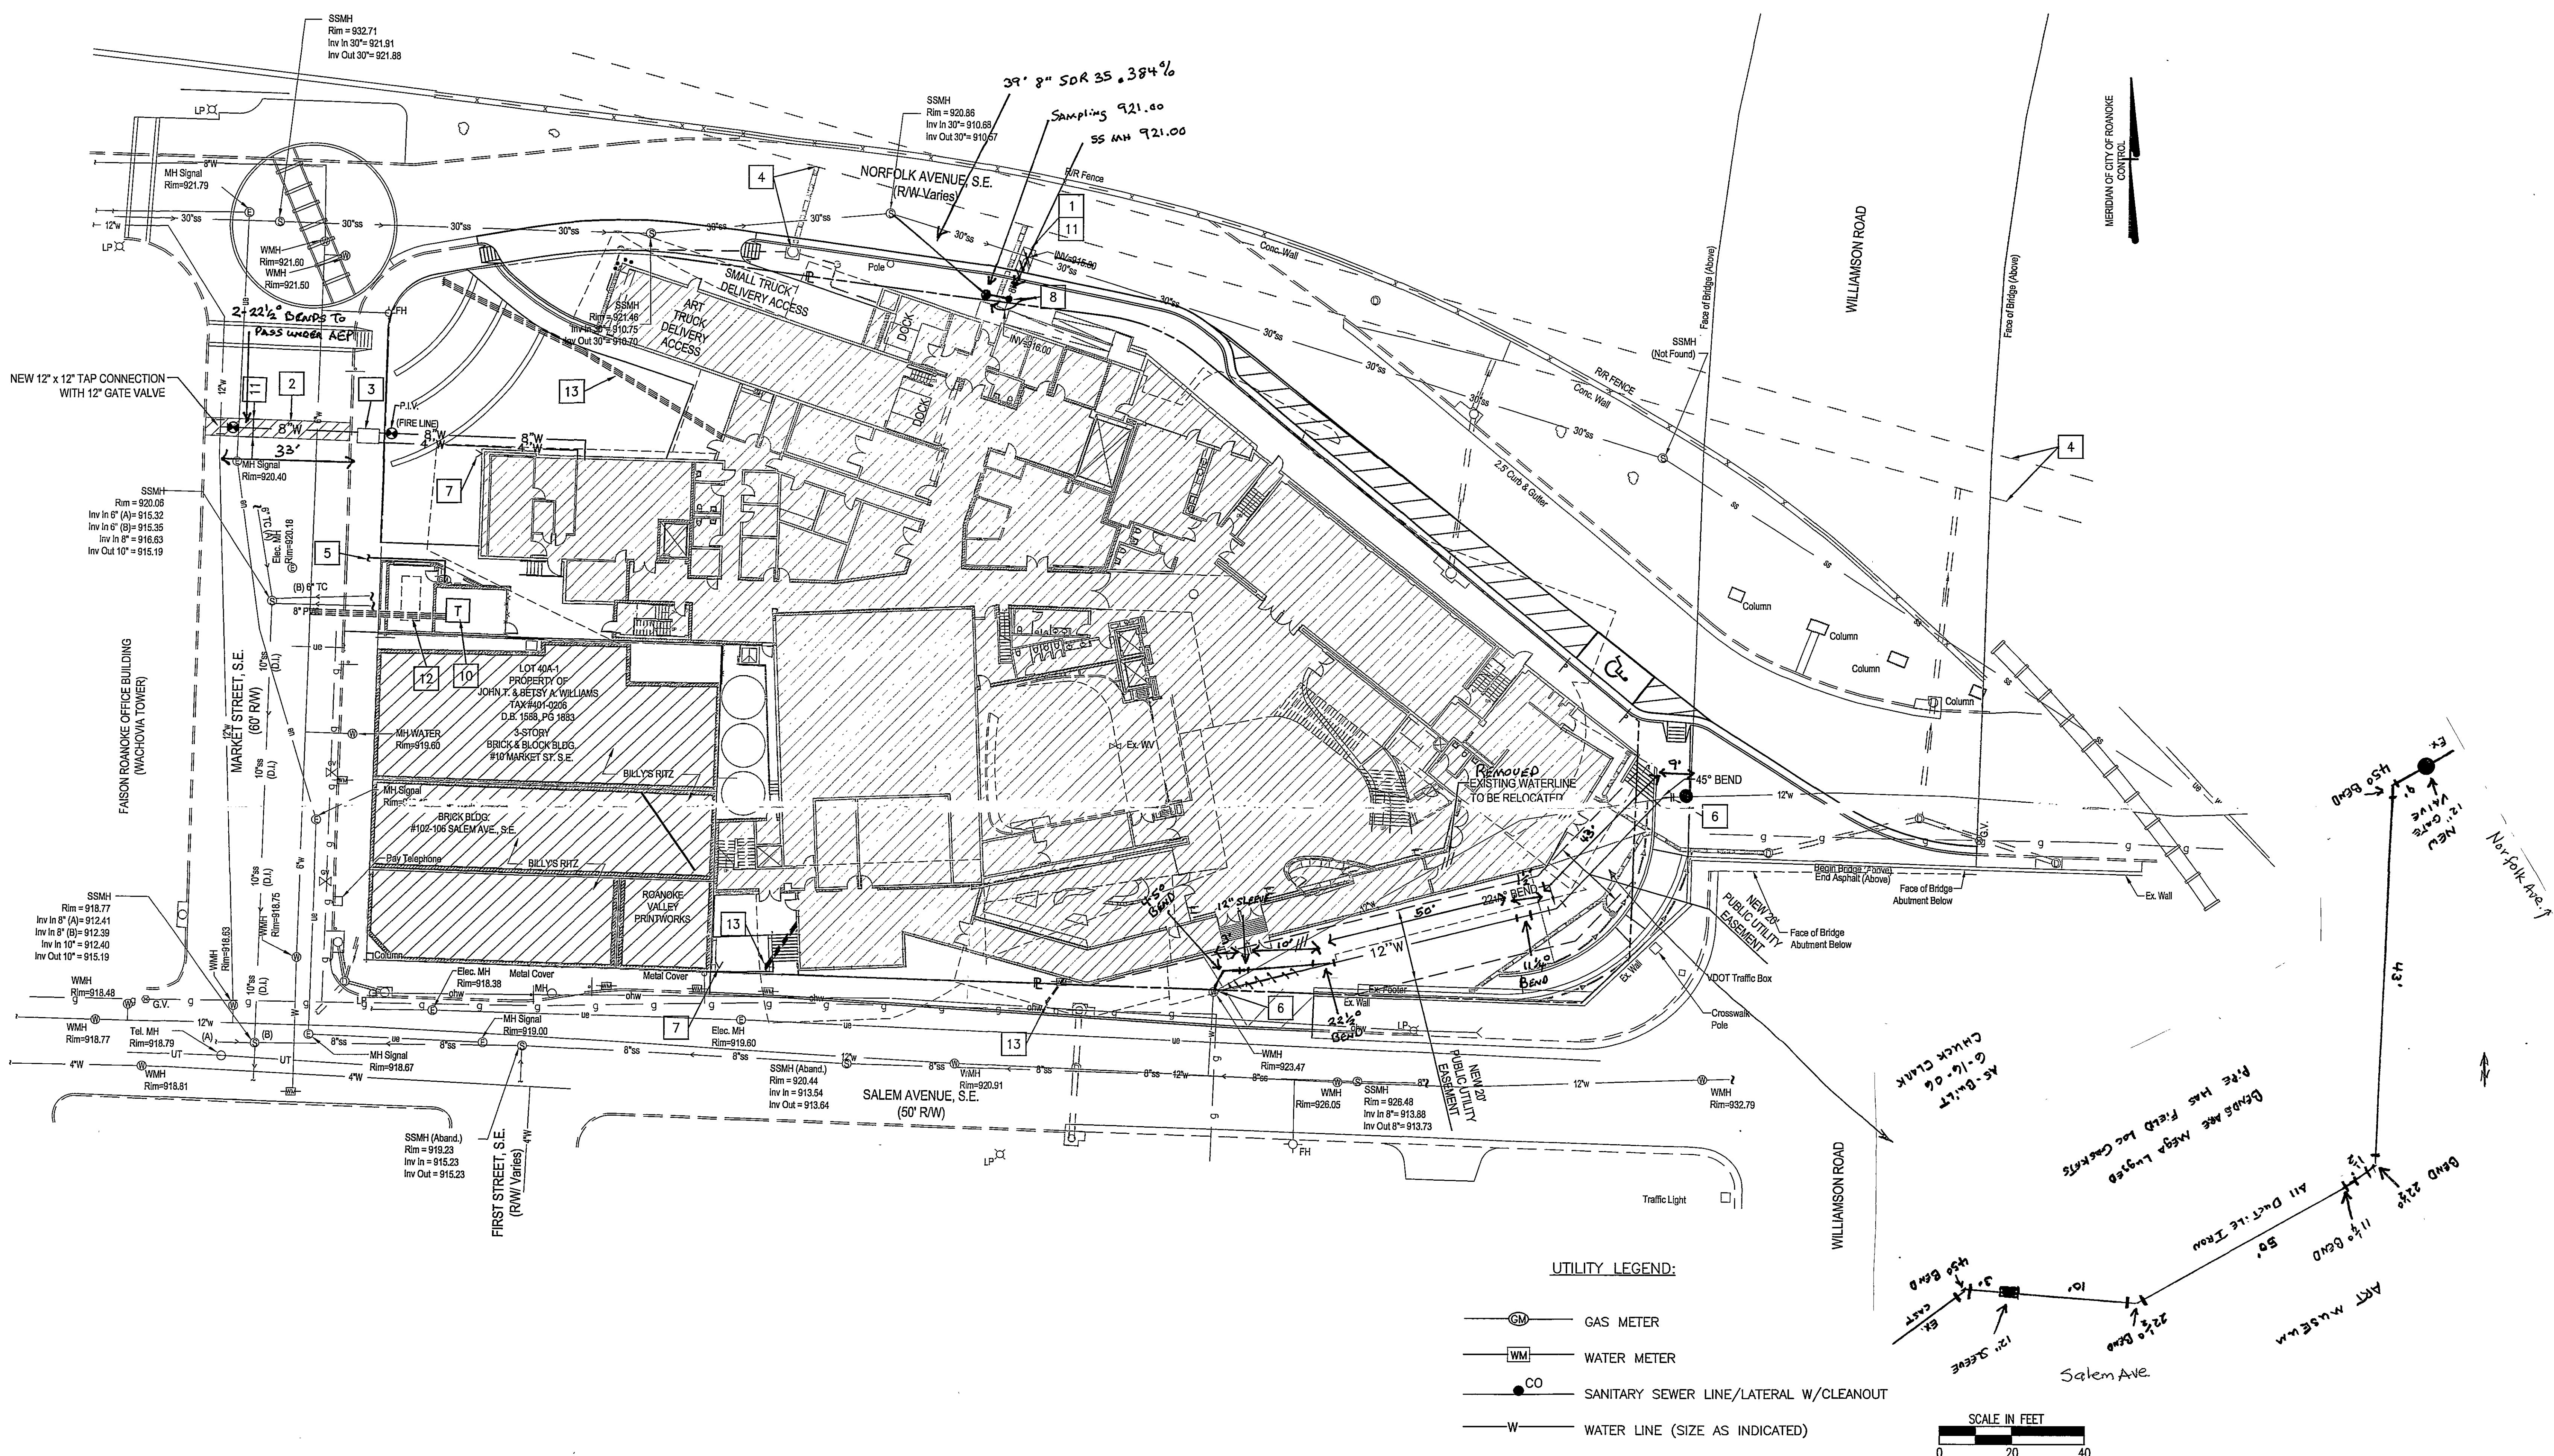

UTILITY LEGEND:

 GAS METER
 WATER METER
 CO SANITARY SEWER LINE/LATERAL W/CLEANOUT
 W WATER LINE (SIZE AS INDICATED)

SCALE IN FEET

0 20 40

UTILITY PLAN

C1-1.22

R:\dwgs\2055\dwg\Master.dwg, C1-122, 2/27/2006 11:41:37