

DATE:	01-30-07
REVISIONS	
△	
△	
△	
△	

PIERSON
ENGINEERING
&
SURVEYING

P.O. BOX 311
1324 ROANOKE ROAD
DALEVILLE, VA 24083


(540) 966-3027 TEL
(540) 966-5906 FAX
e-mail: rpierson@rbnet.com

SITE PLAN FOR
ASHLEY PLANTATION—SECTION 5
PHASE I & II
TOWN OF CHRISTIANSBURG, VIRGINIA

PLAN SHEET



COMMISSION
R200471
SHEET
1

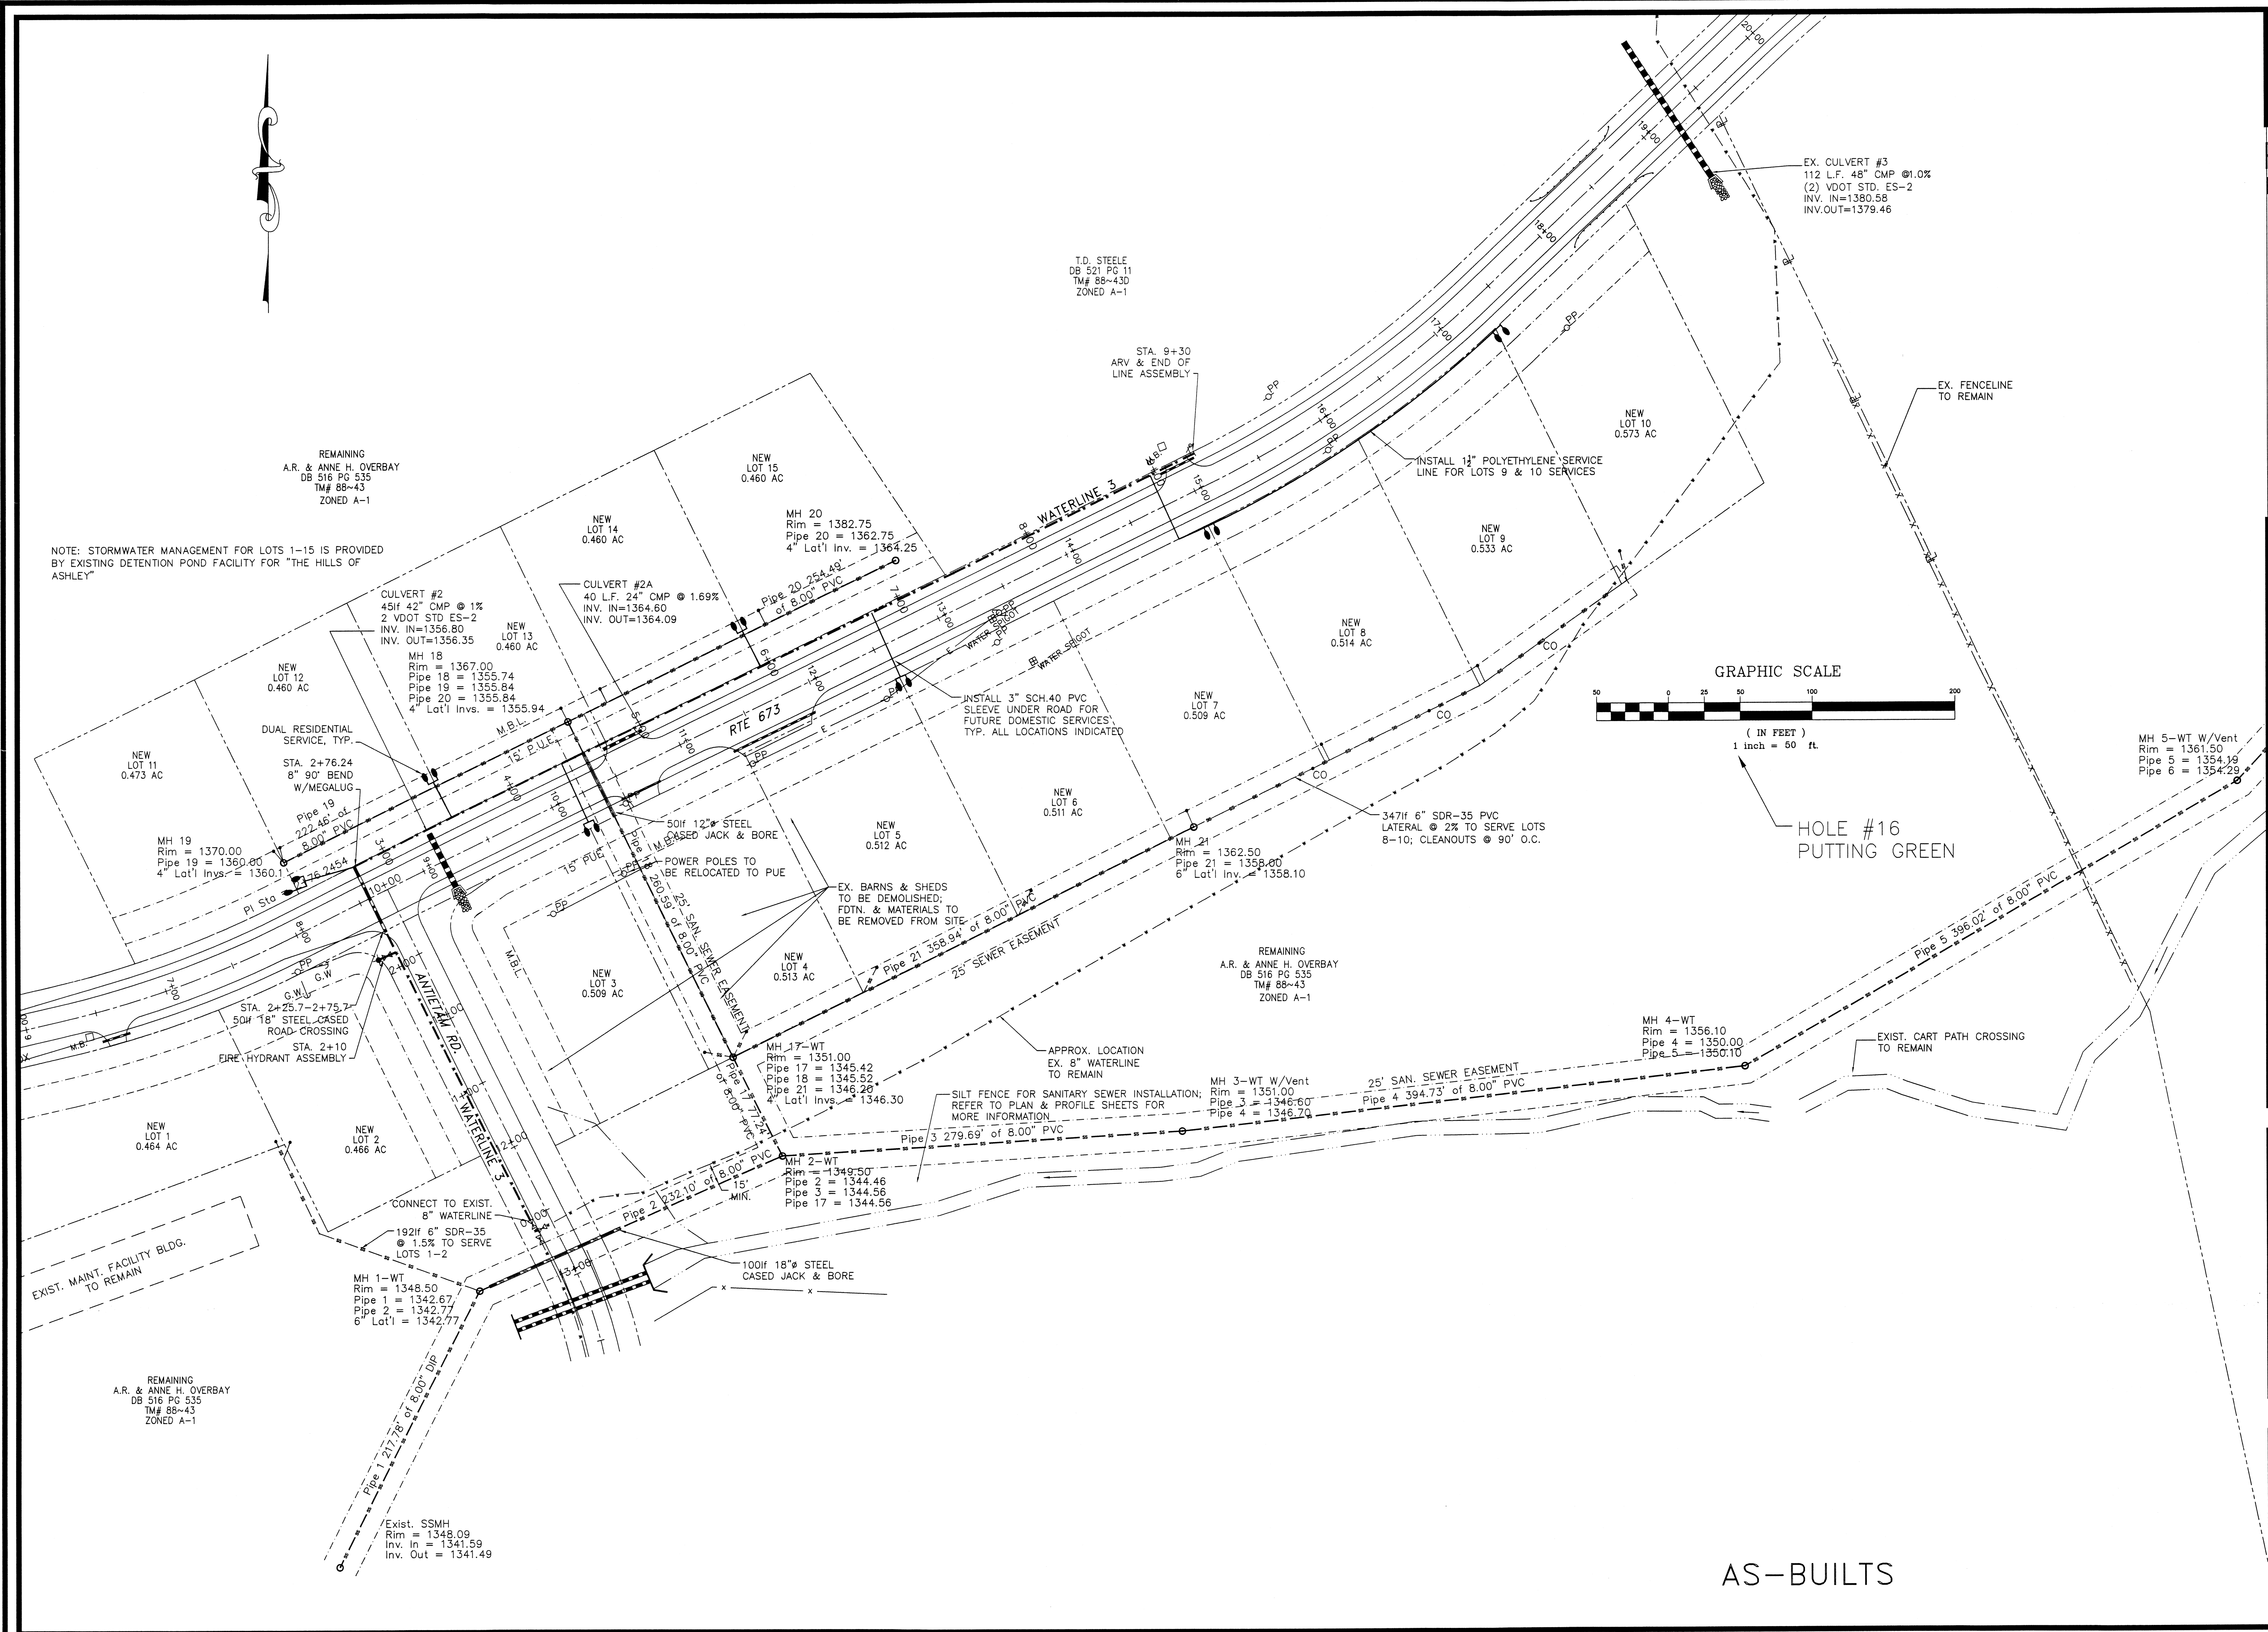

AS-BUILTS

DATE: 01-30-07

REVISIONS
△
△
△
△


PIERSON
ENGINEERING
&
SURVEYING

P.O. BOX 311
1324 ROANOKE ROAD
DALEVILLE, VA 24083

(540) 966-3027 TEL
(540) 966-5906 FAX
e-mail: rpierson@rbnet.com


SITE PLAN FOR
ASHLEY PLANTATION—SECTION 5
PHASE I & II
TOWN OF CHRISTANSBURG, VIRGINIA

WATER PROFILE

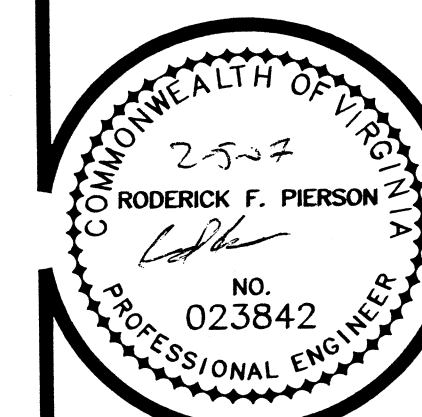

COMMISSION
R200471

SHEET
2

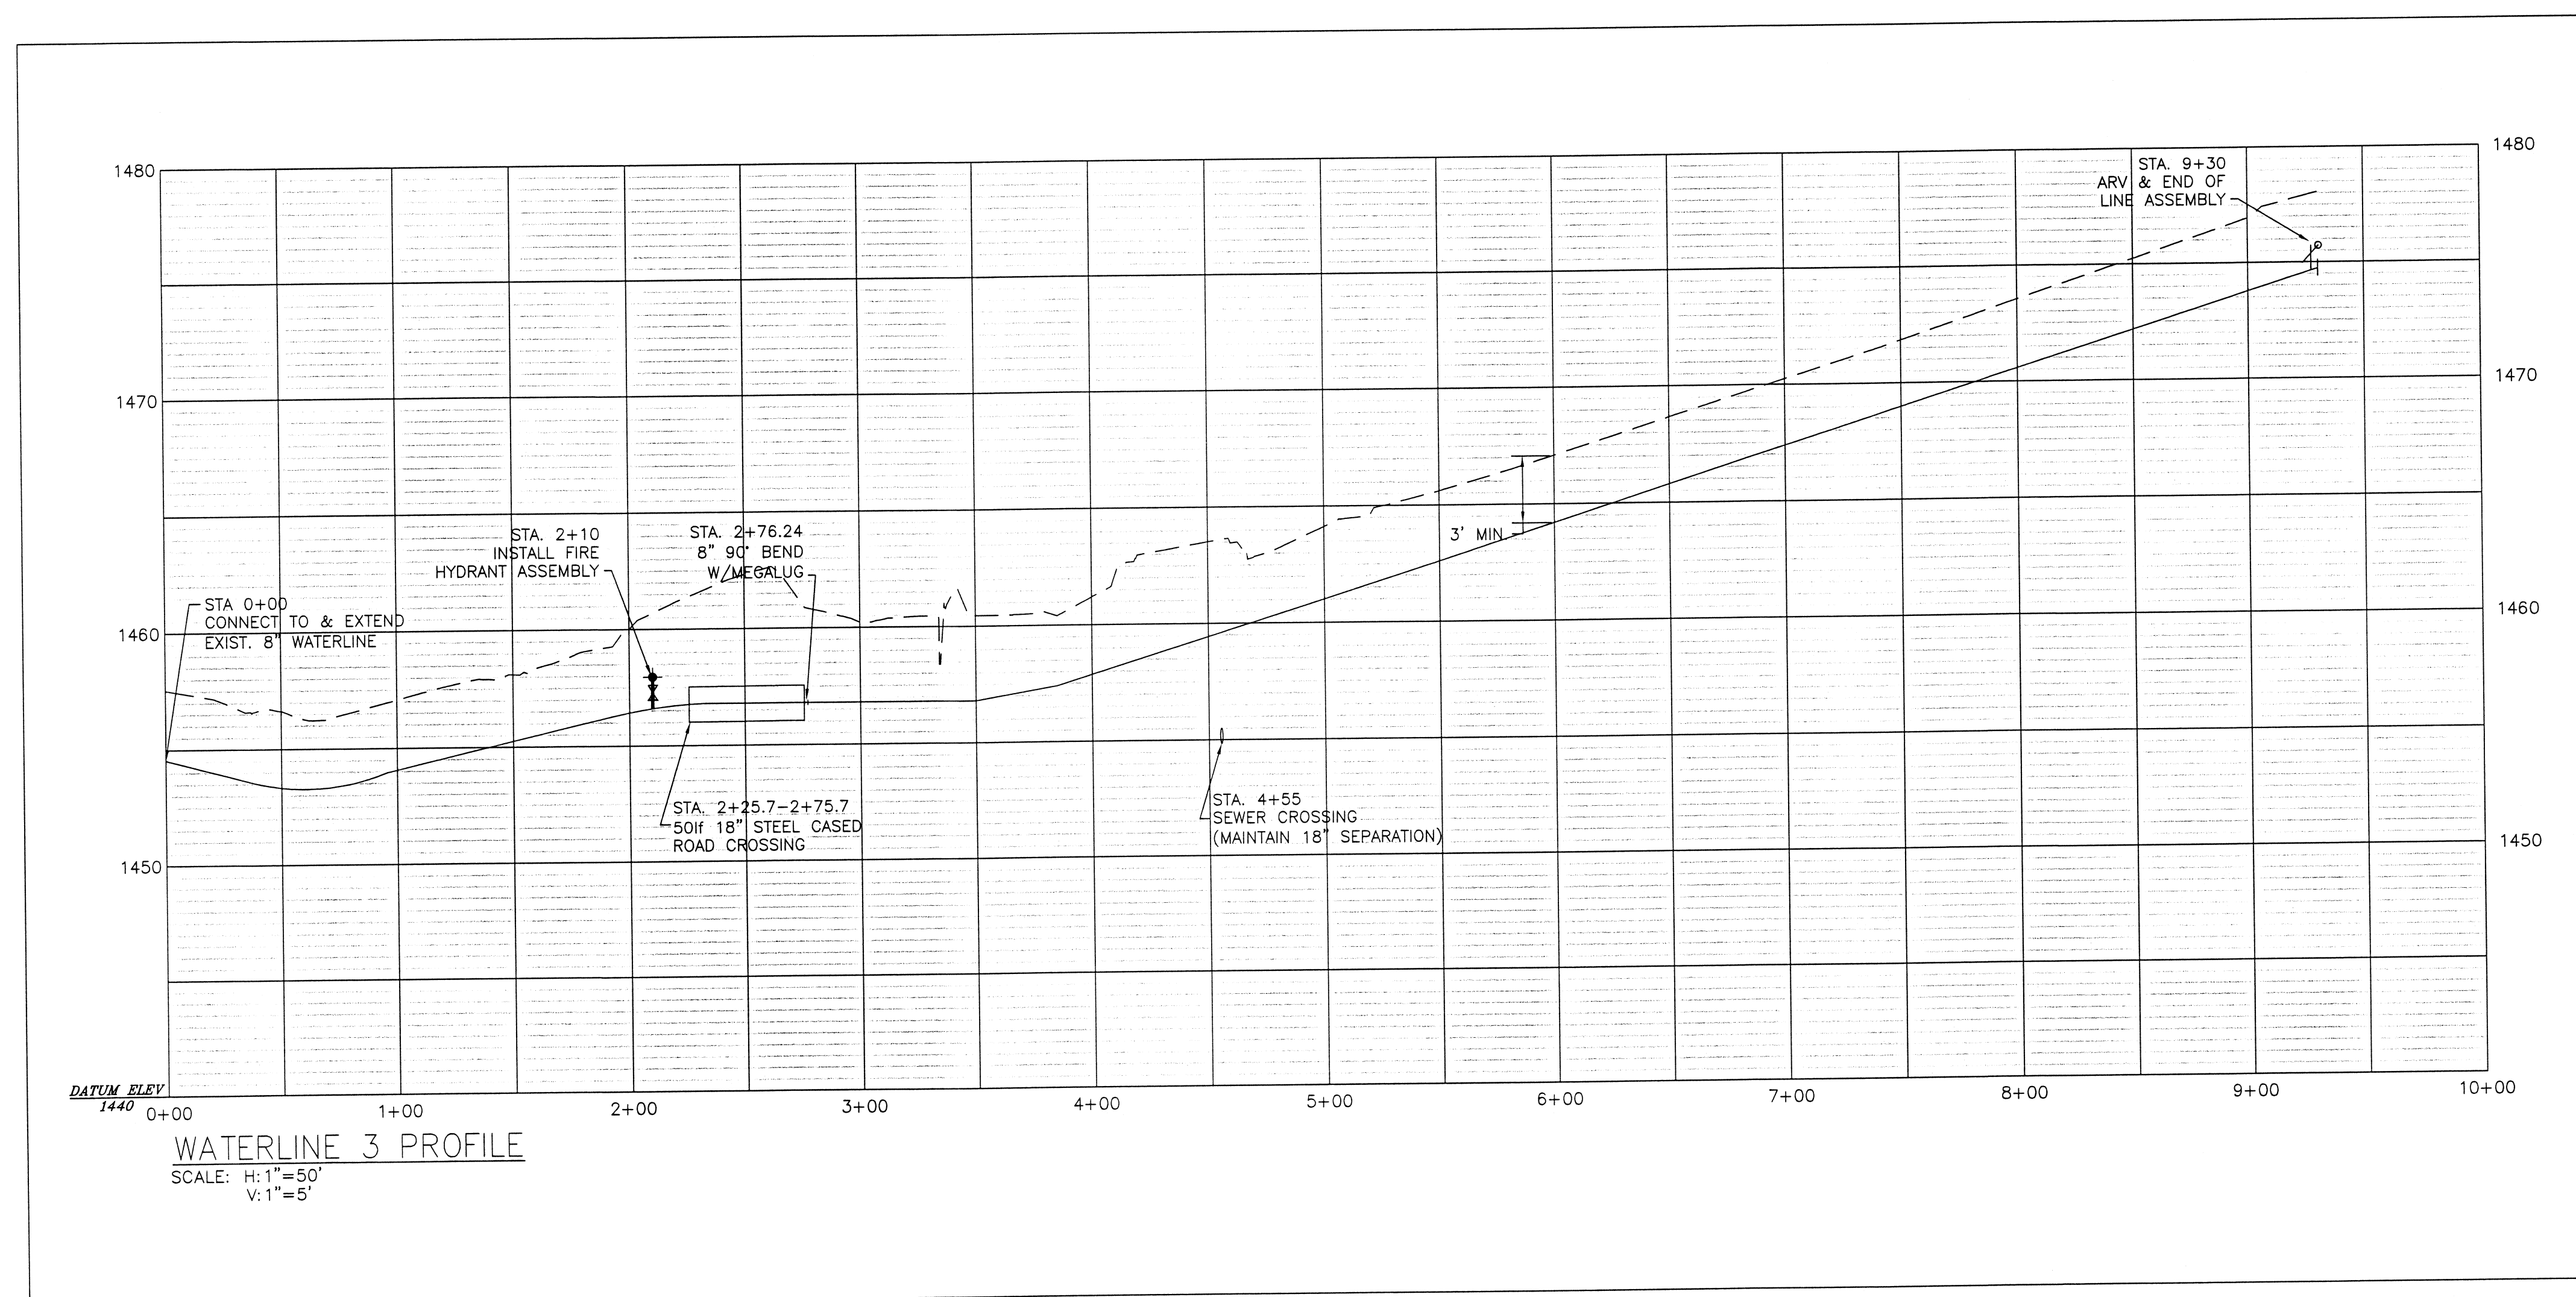

AS-BUILTS

DATE: 01-30-07

REVISIONS
△
△
△
△


PIERSON
ENGINEERING
&
SURVEYING

P.O. BOX 311
1324 ROANOKE ROAD
DALEVILLE, VA 24083

(540) 966-3027 TEL
(540) 966-5906 FAX
e-mail: rpierson@rbnet.com

SITE PLAN FOR
ASHLEY PLANTATION—SECTION 5
PHASE I & II
TOWN OF CHRISTANSBURG, VIRGINIA



SEWER PROFILE

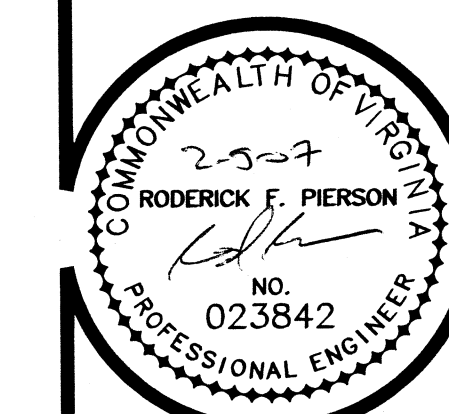


COMMISSION
R200471

SHEET
3

AS-BUILTS

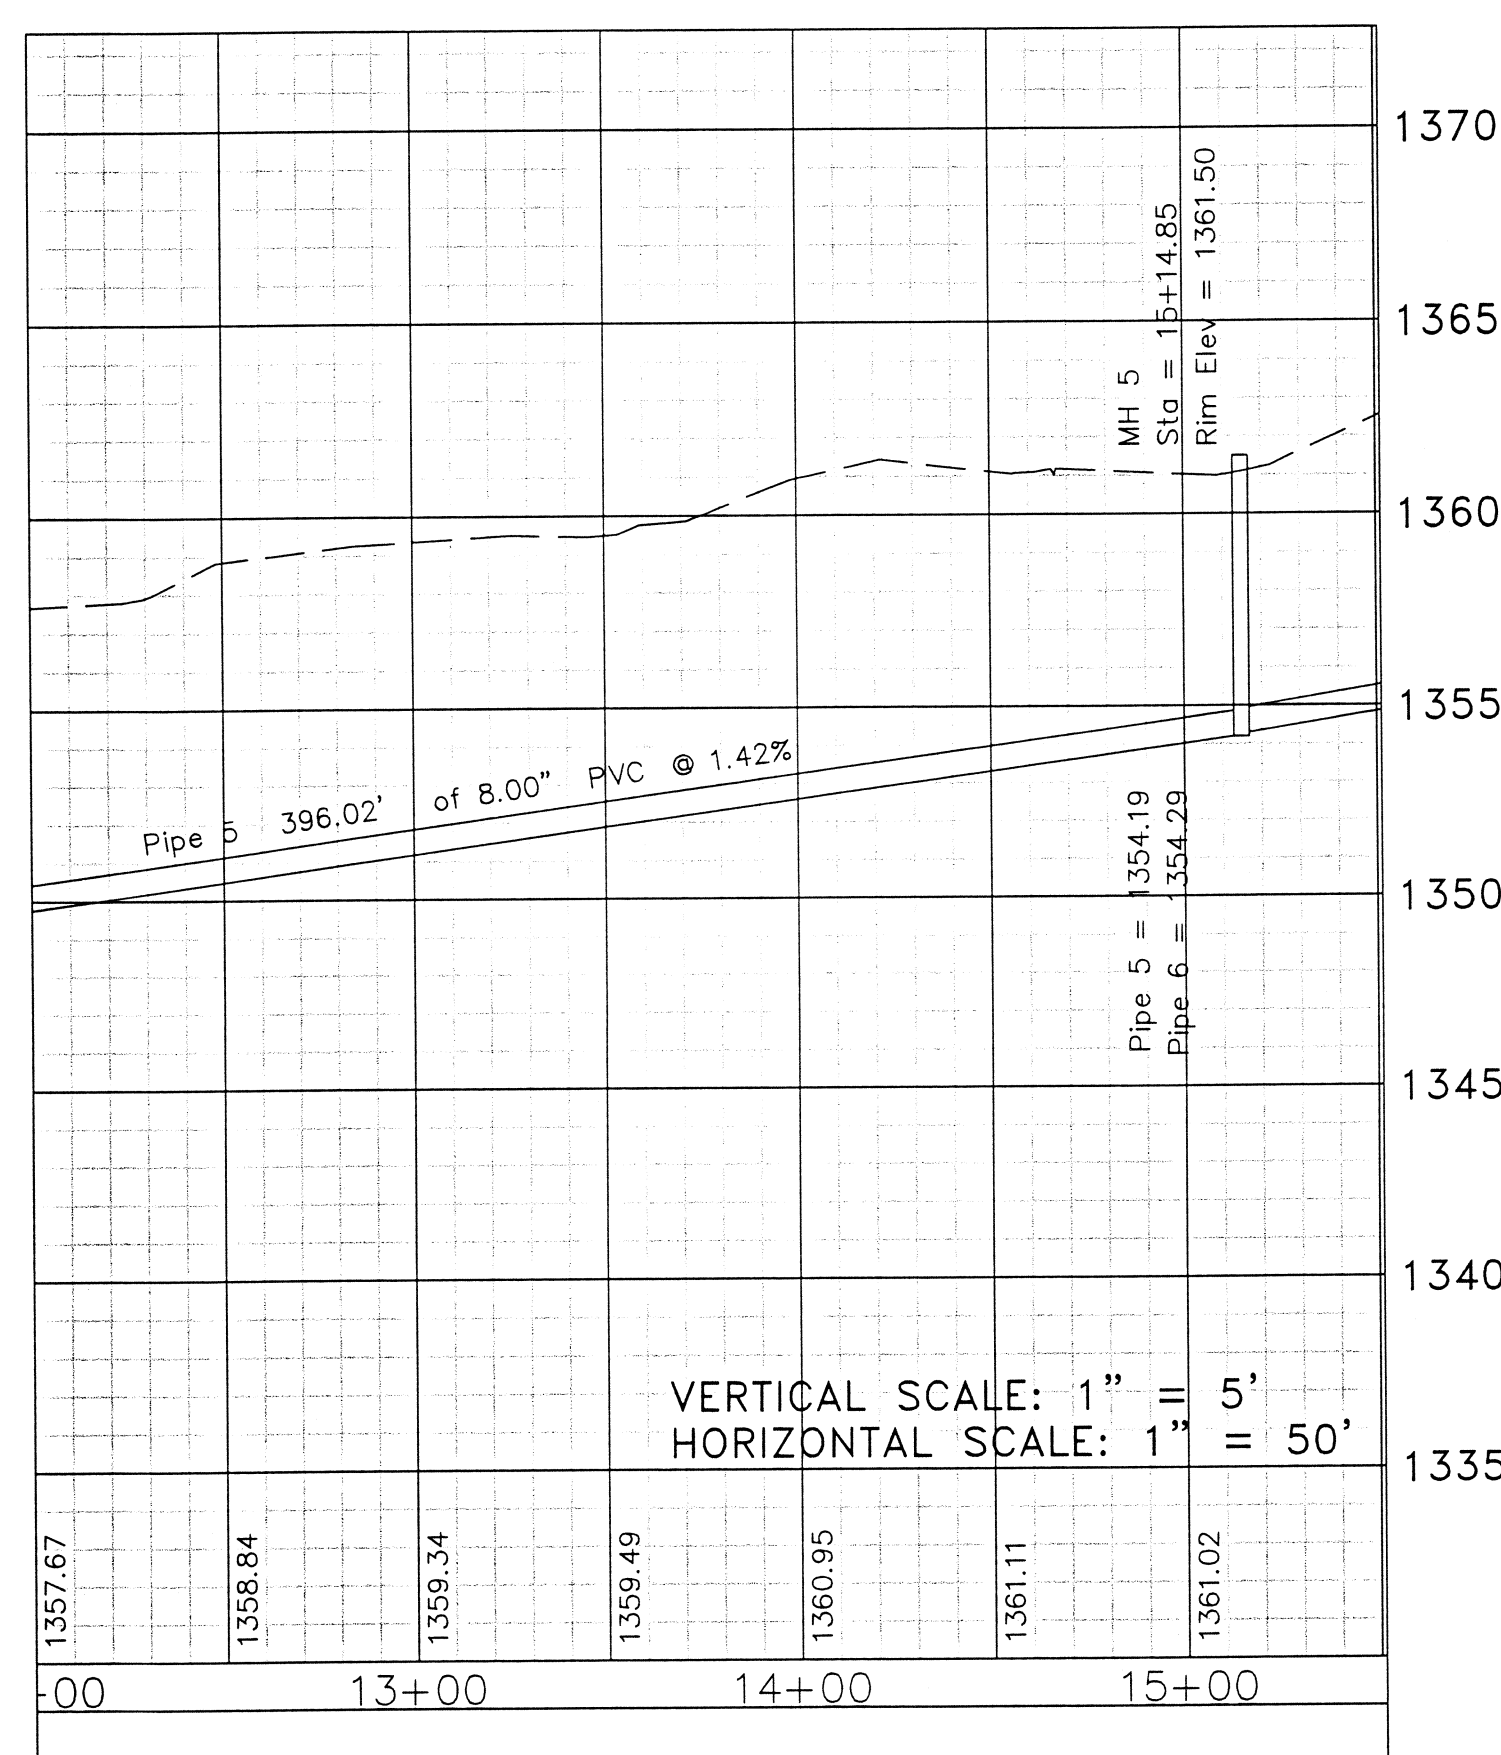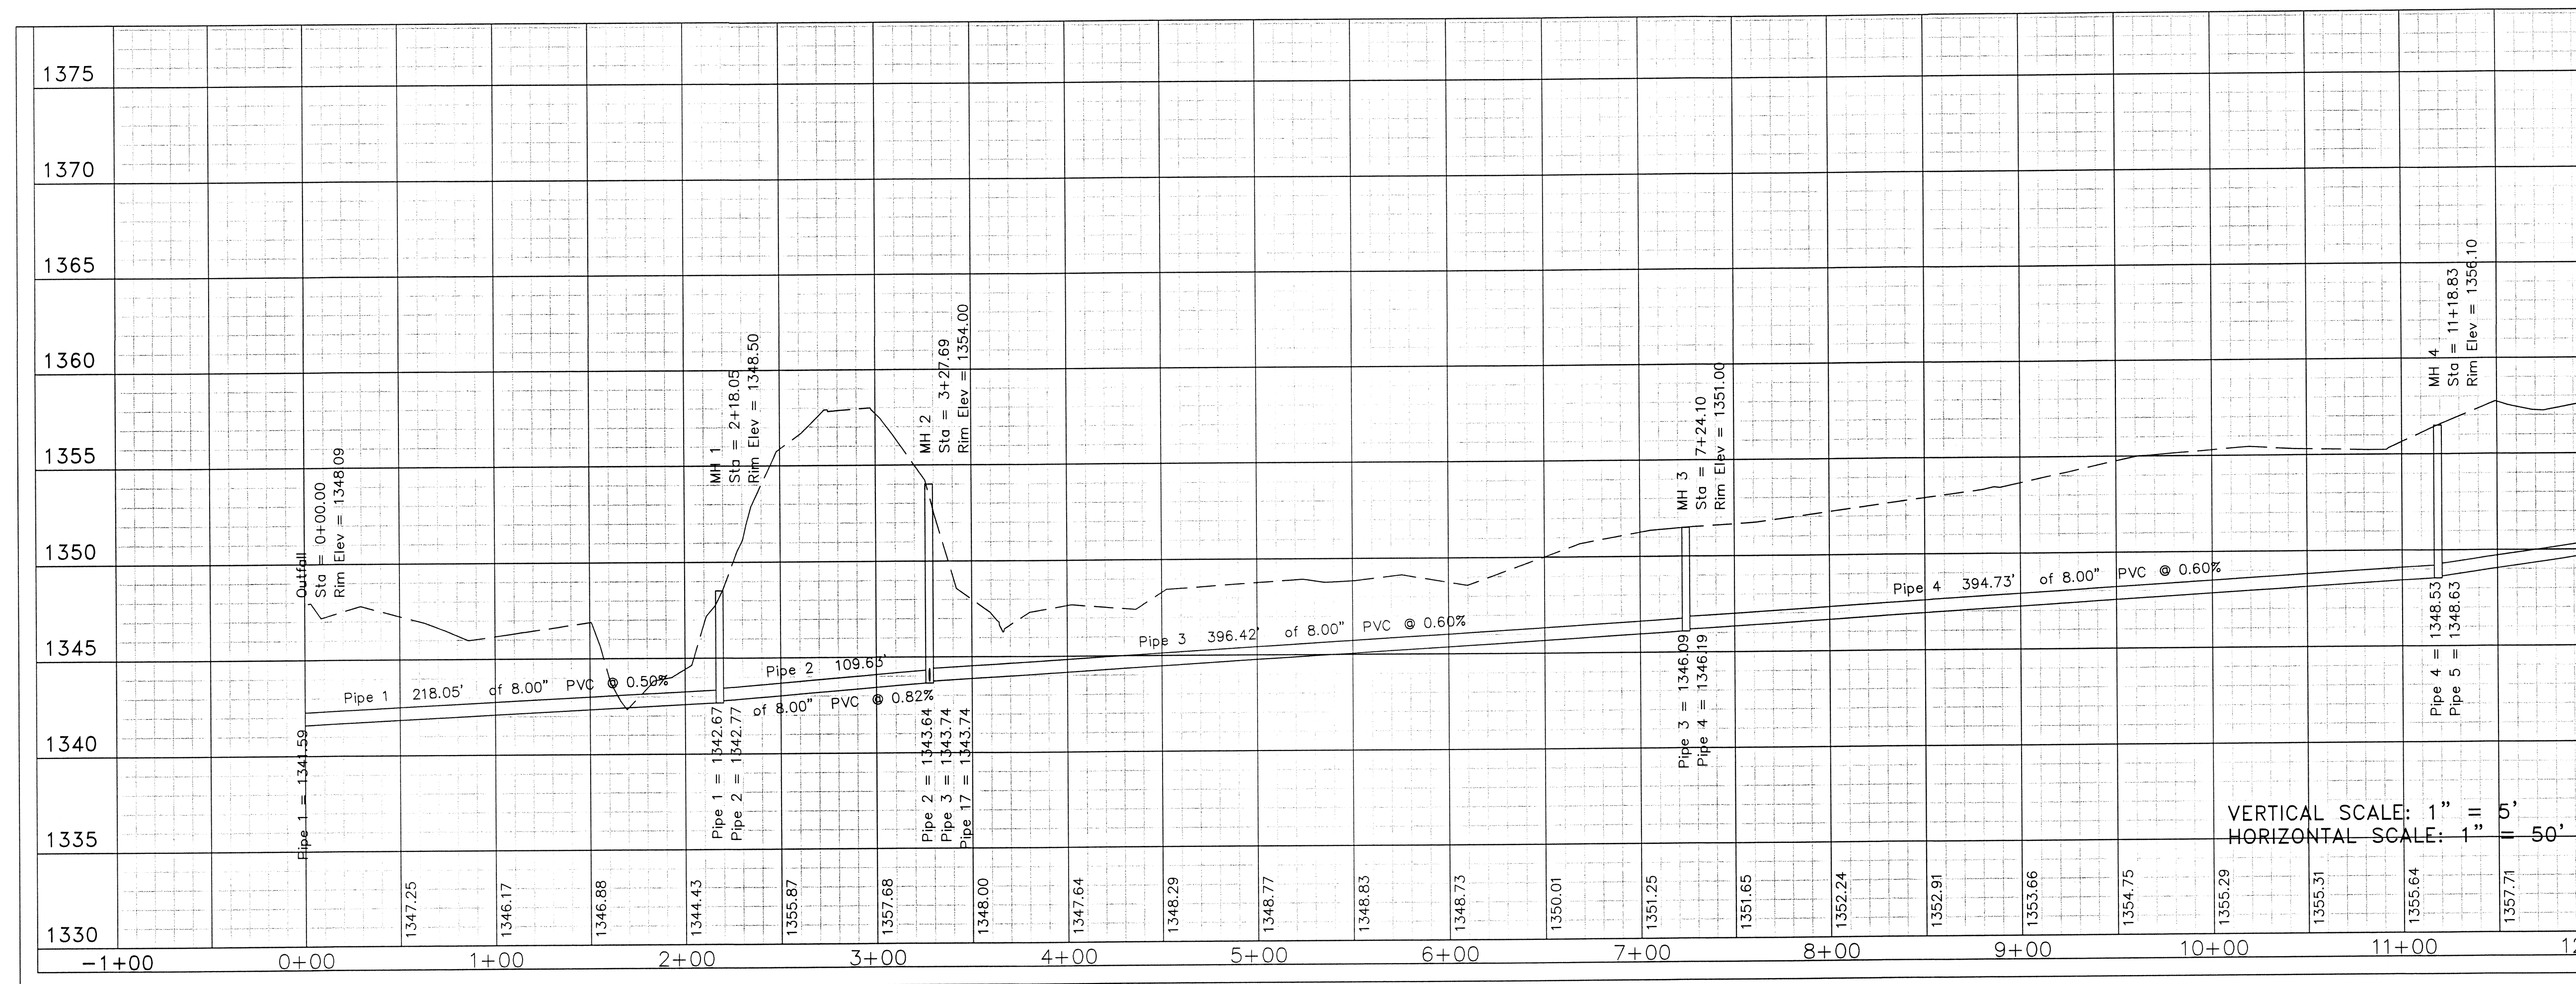

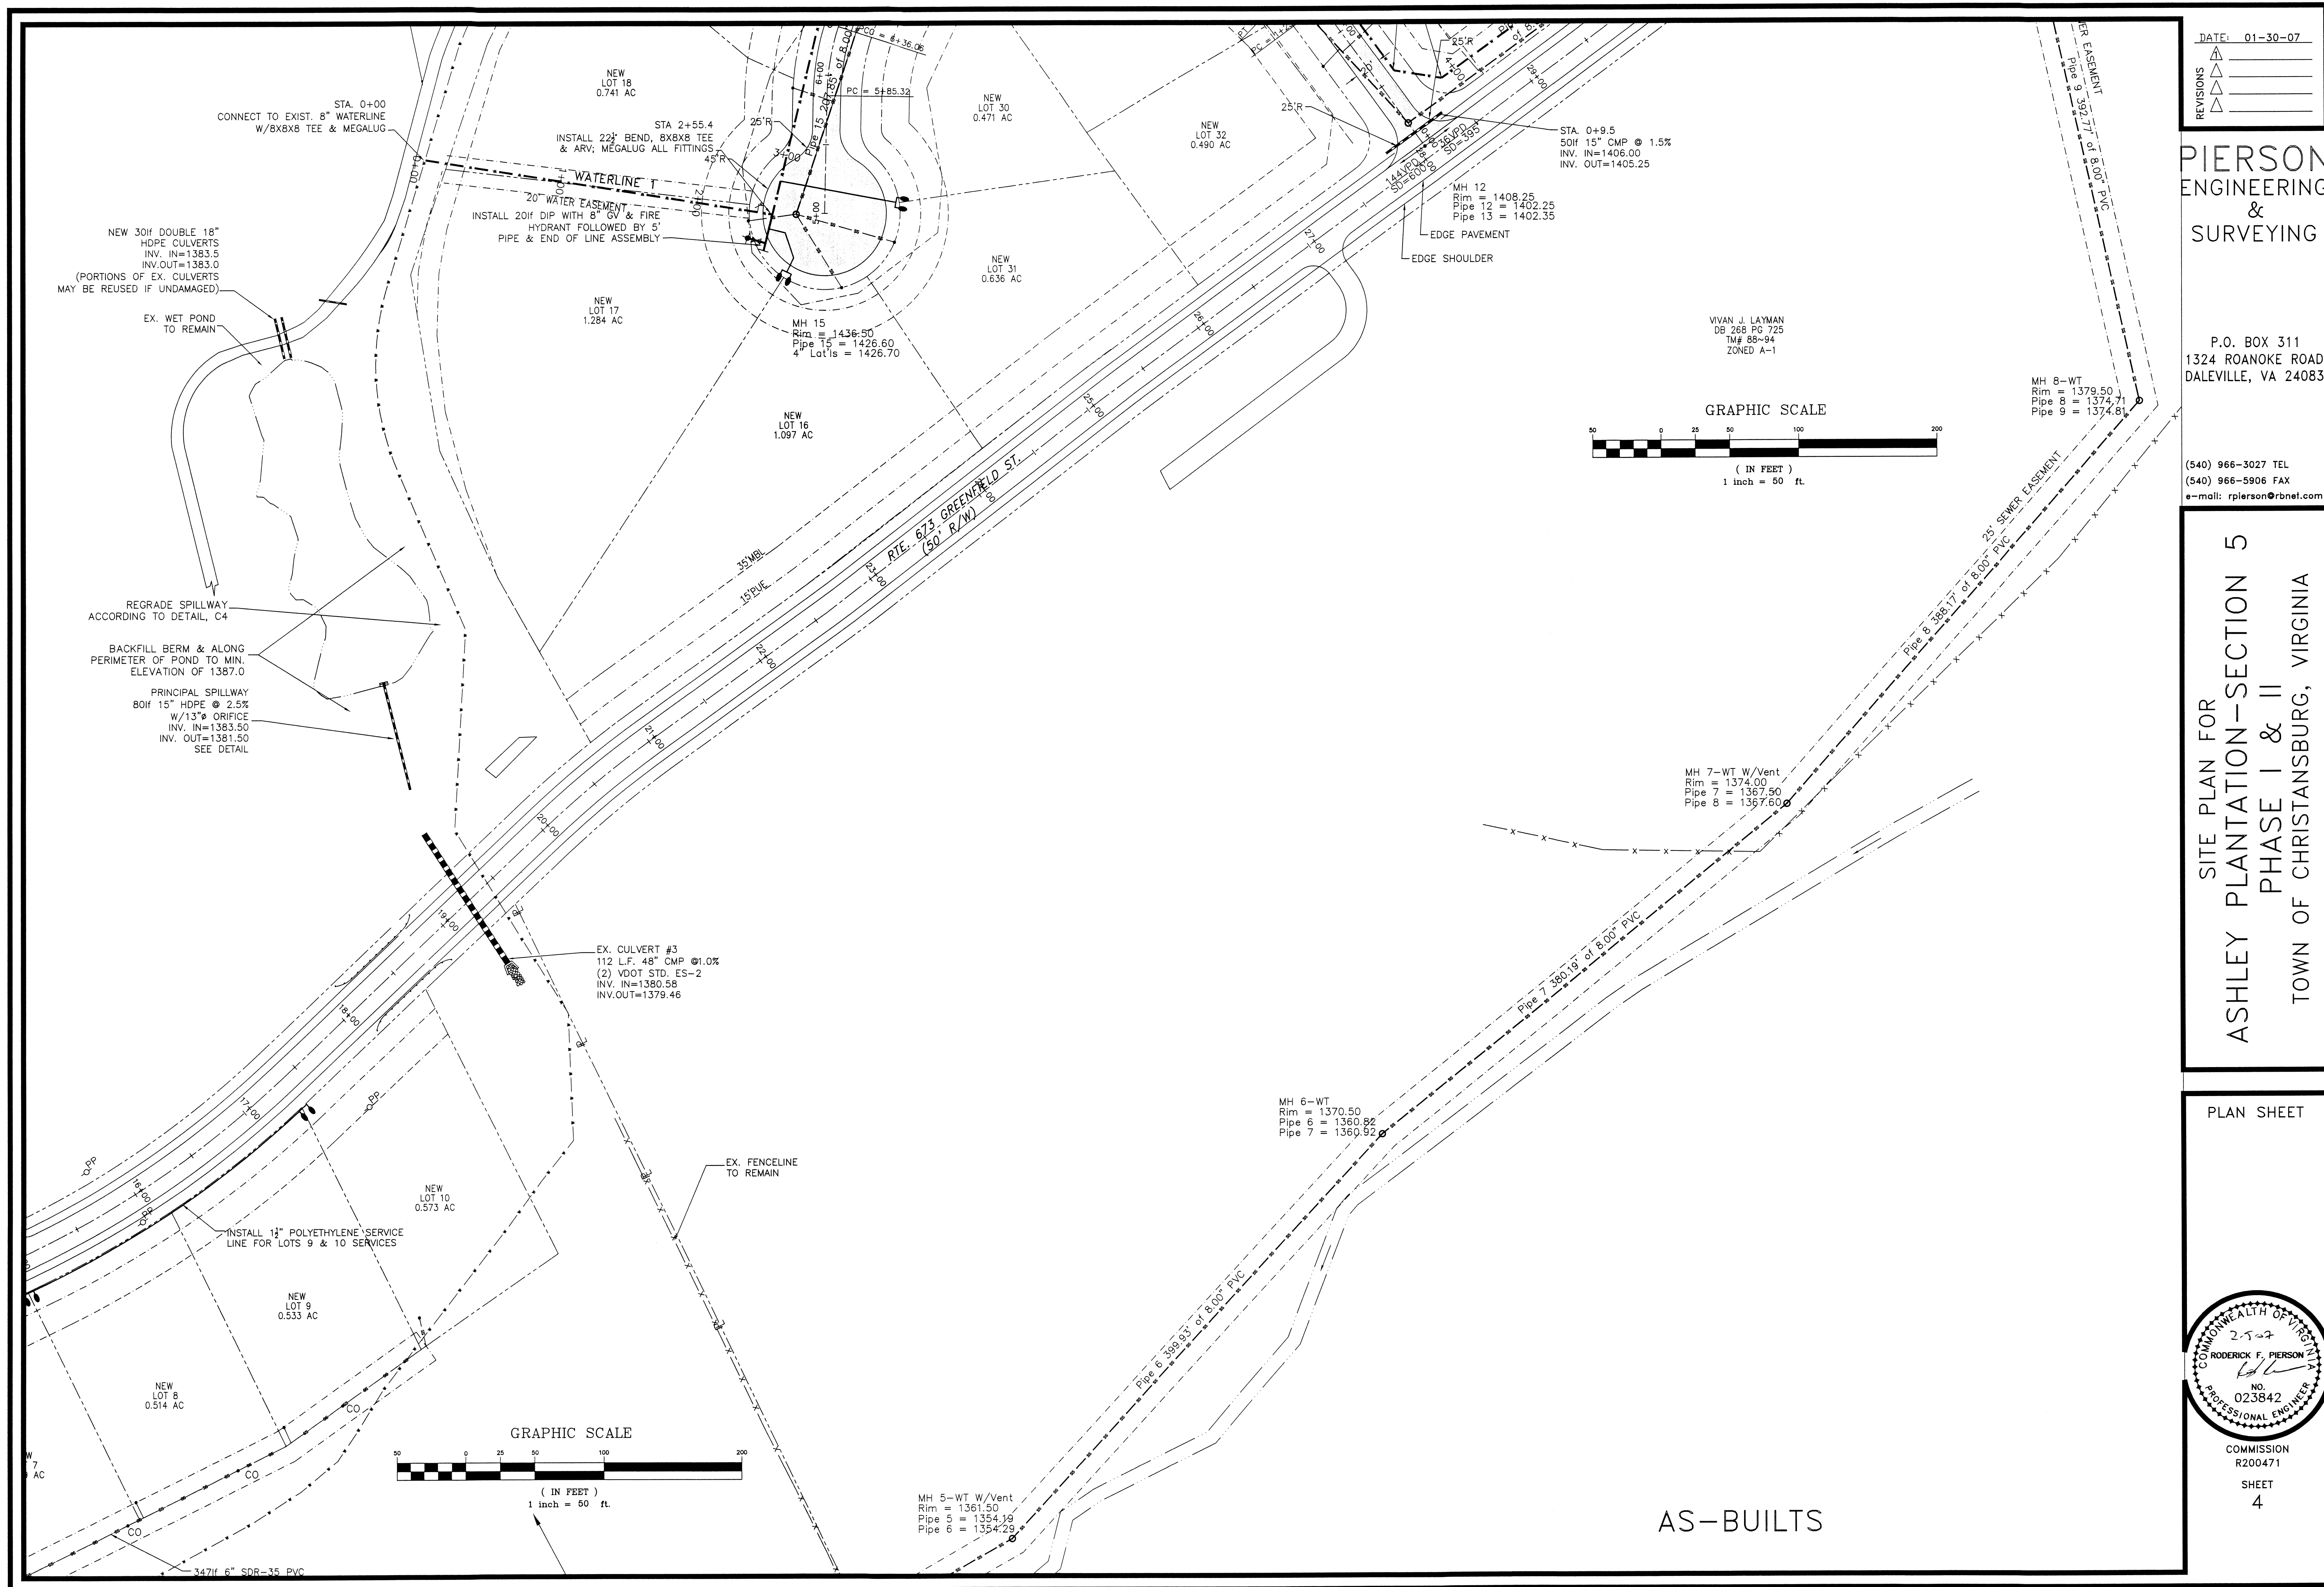

DATE:	01-30-07
REVISIONS	
△	
△	
△	

PIERSON
ENGINEERING
&
SURVEYING

P.O. BOX 311
1324 ROANOKE ROAD
DALEVILLE, VA 24083

(540) 966-3027 TEL
(540) 966-5906 FAX
e-mail: rpierson@rnel.com

SITE PLAN FOR
ASHLEY PLANTATION - SECTION 5
PHASE I & II
TOWN OF CHRISTANSBURG, VIRGINIA

PLAN SHEET

COMMONWEALTH OF VIRGINIA
2527
RODERICK F. PIERSON
No. 023842
PROFESSIONAL ENGINEER
COMMISSION R200471
SHEET 4

AS-BUILTS

DATE: 01-30-07

REVISIONS
△
△
△
△


PIERSON
ENGINEERING
&
SURVEYING

P.O. BOX 311
1324 ROANOKE ROAD
DALEVILLE, VA 24083



(540) 966-3027 TEL
(540) 966-5906 FAX
e-mail: rpierson@rbnet.com

SITE PLAN FOR
ASHLEY PLANTATION - SECTION 5
PHASE I & II
TOWN OF CHRISTANSBURG, VIRGINIA



PLAN SHEET

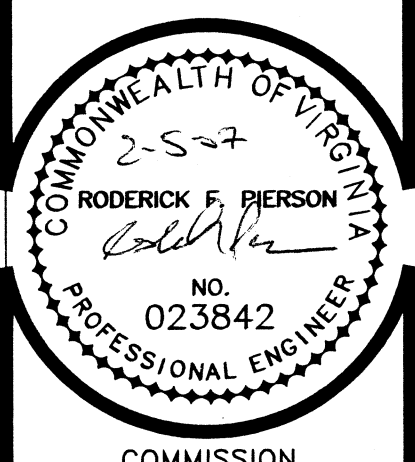

COMMISSION
R200471
SHEET
5

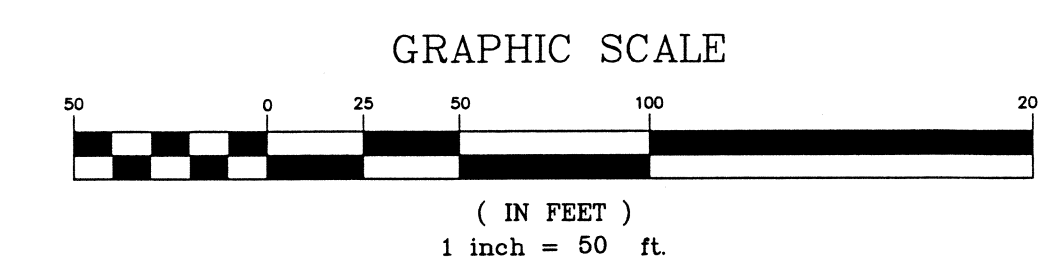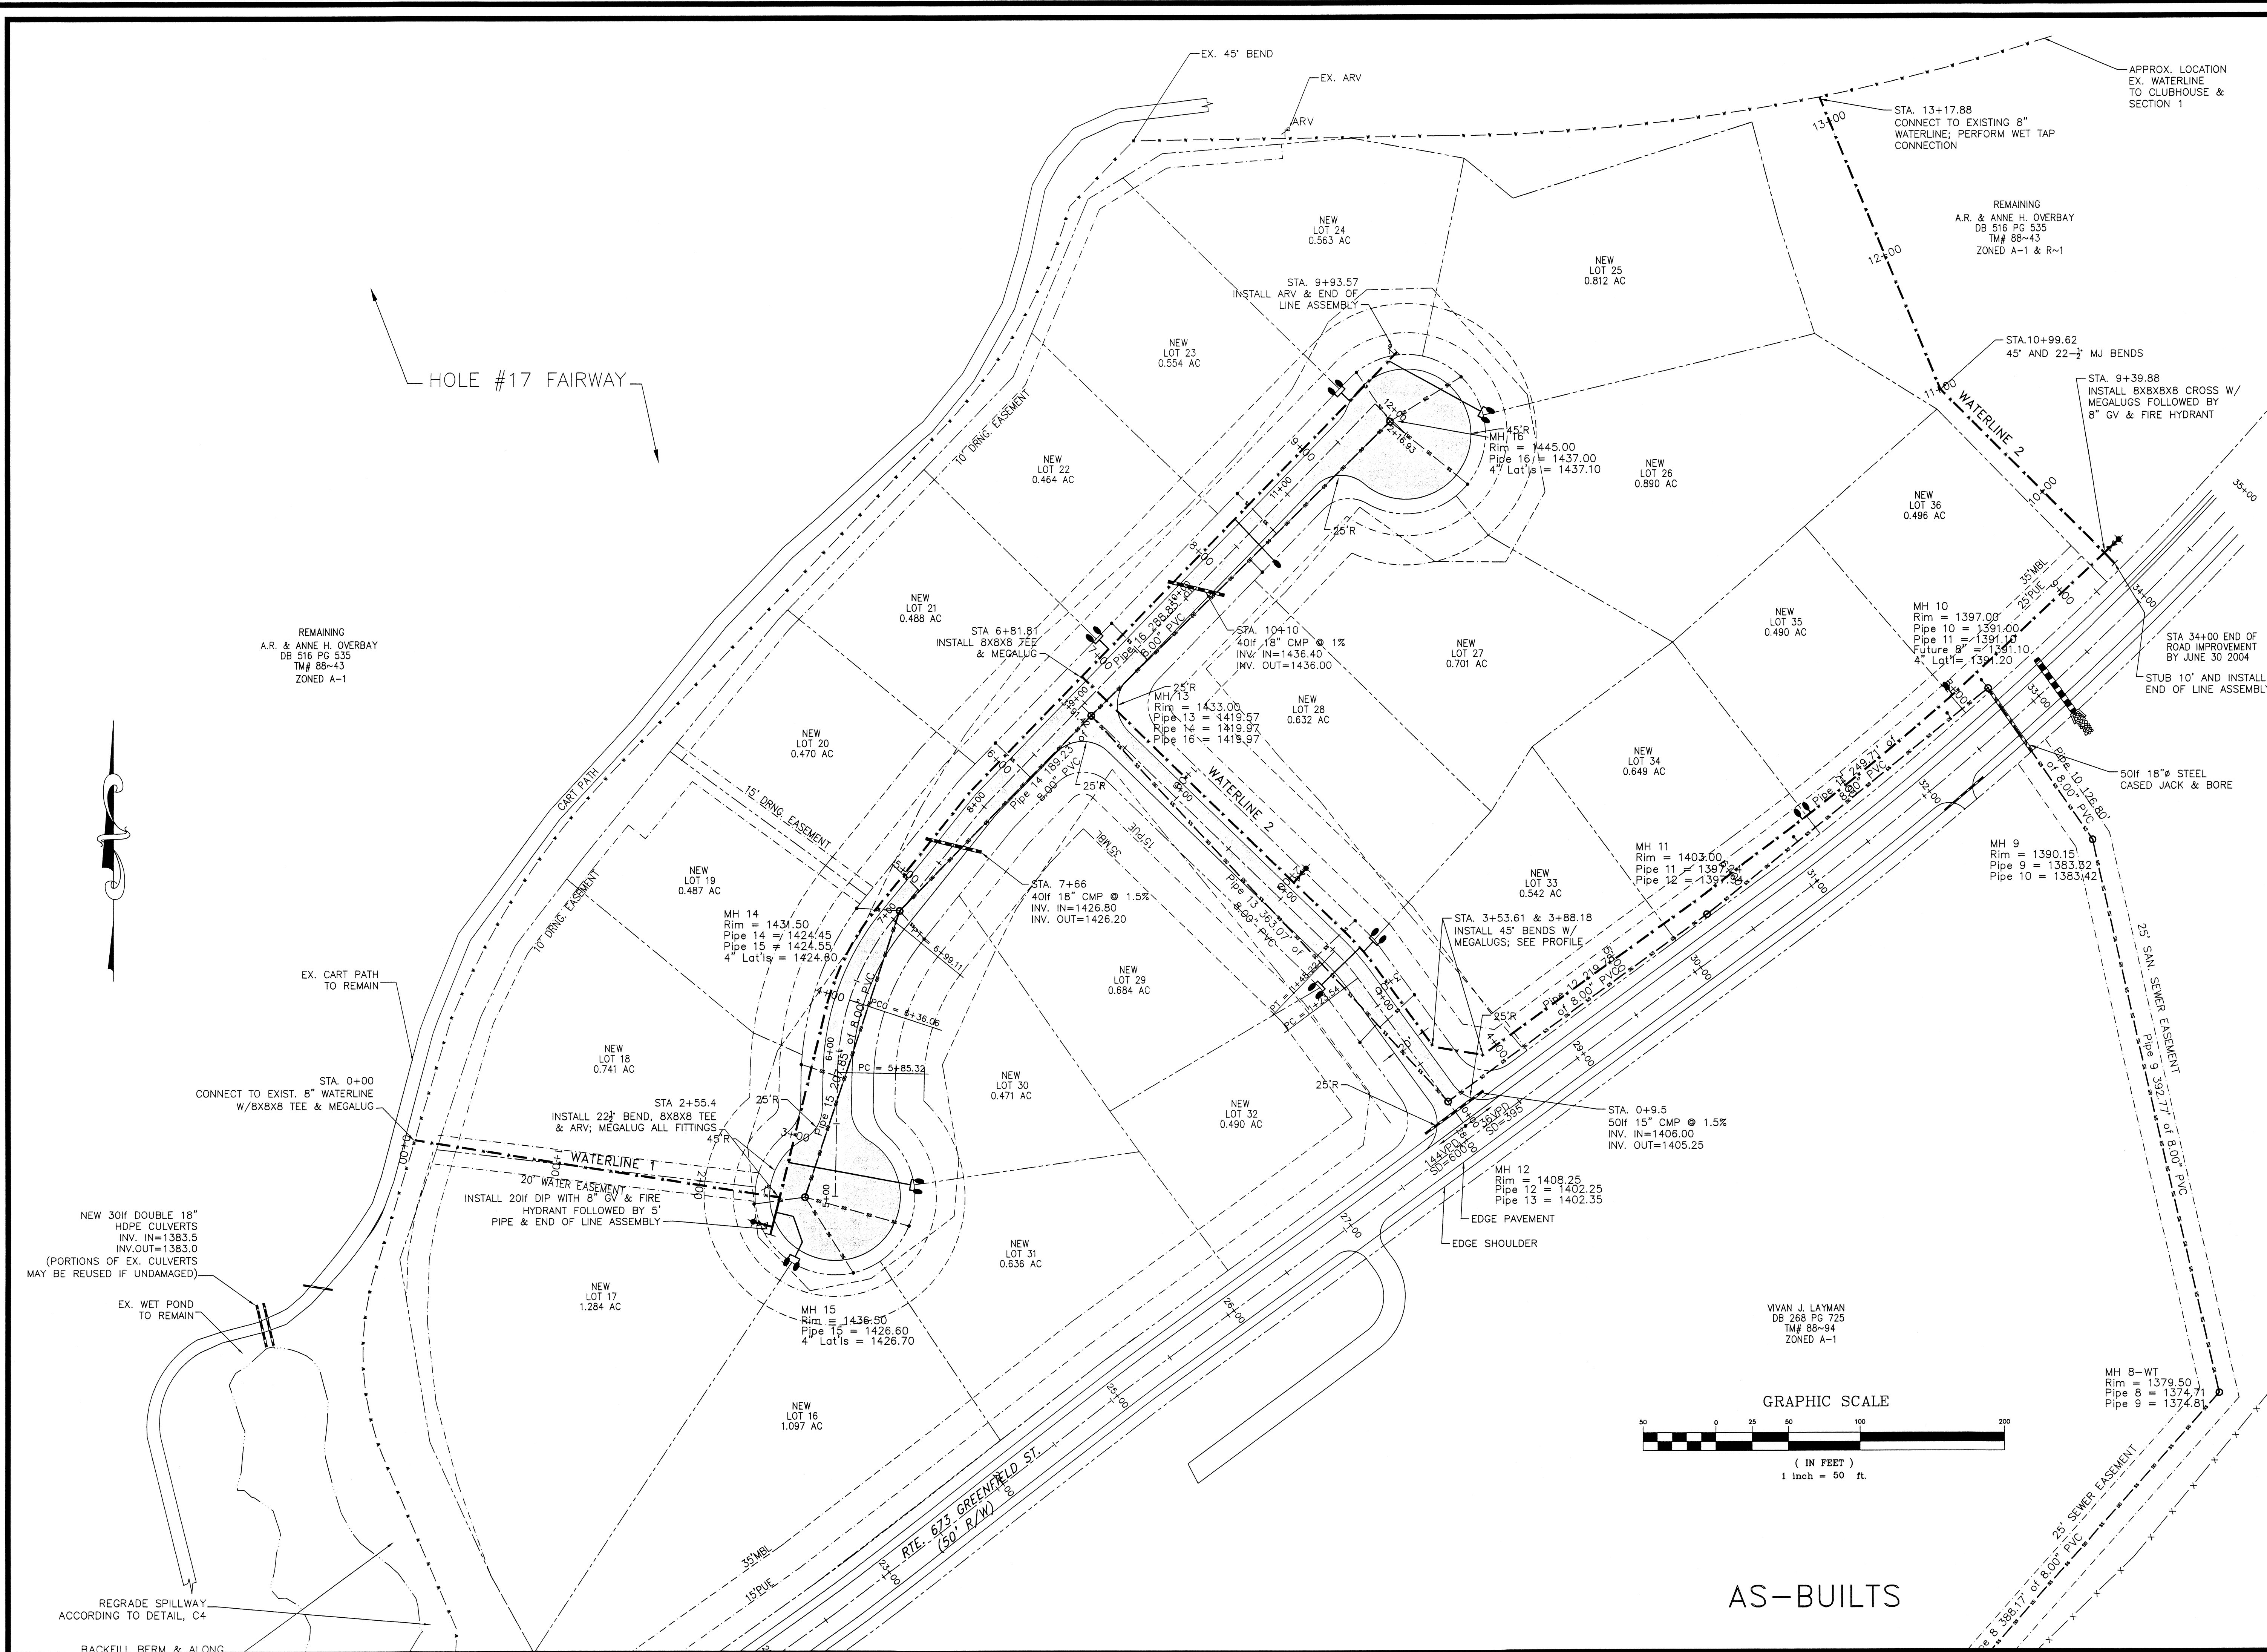

AS-BUILTS

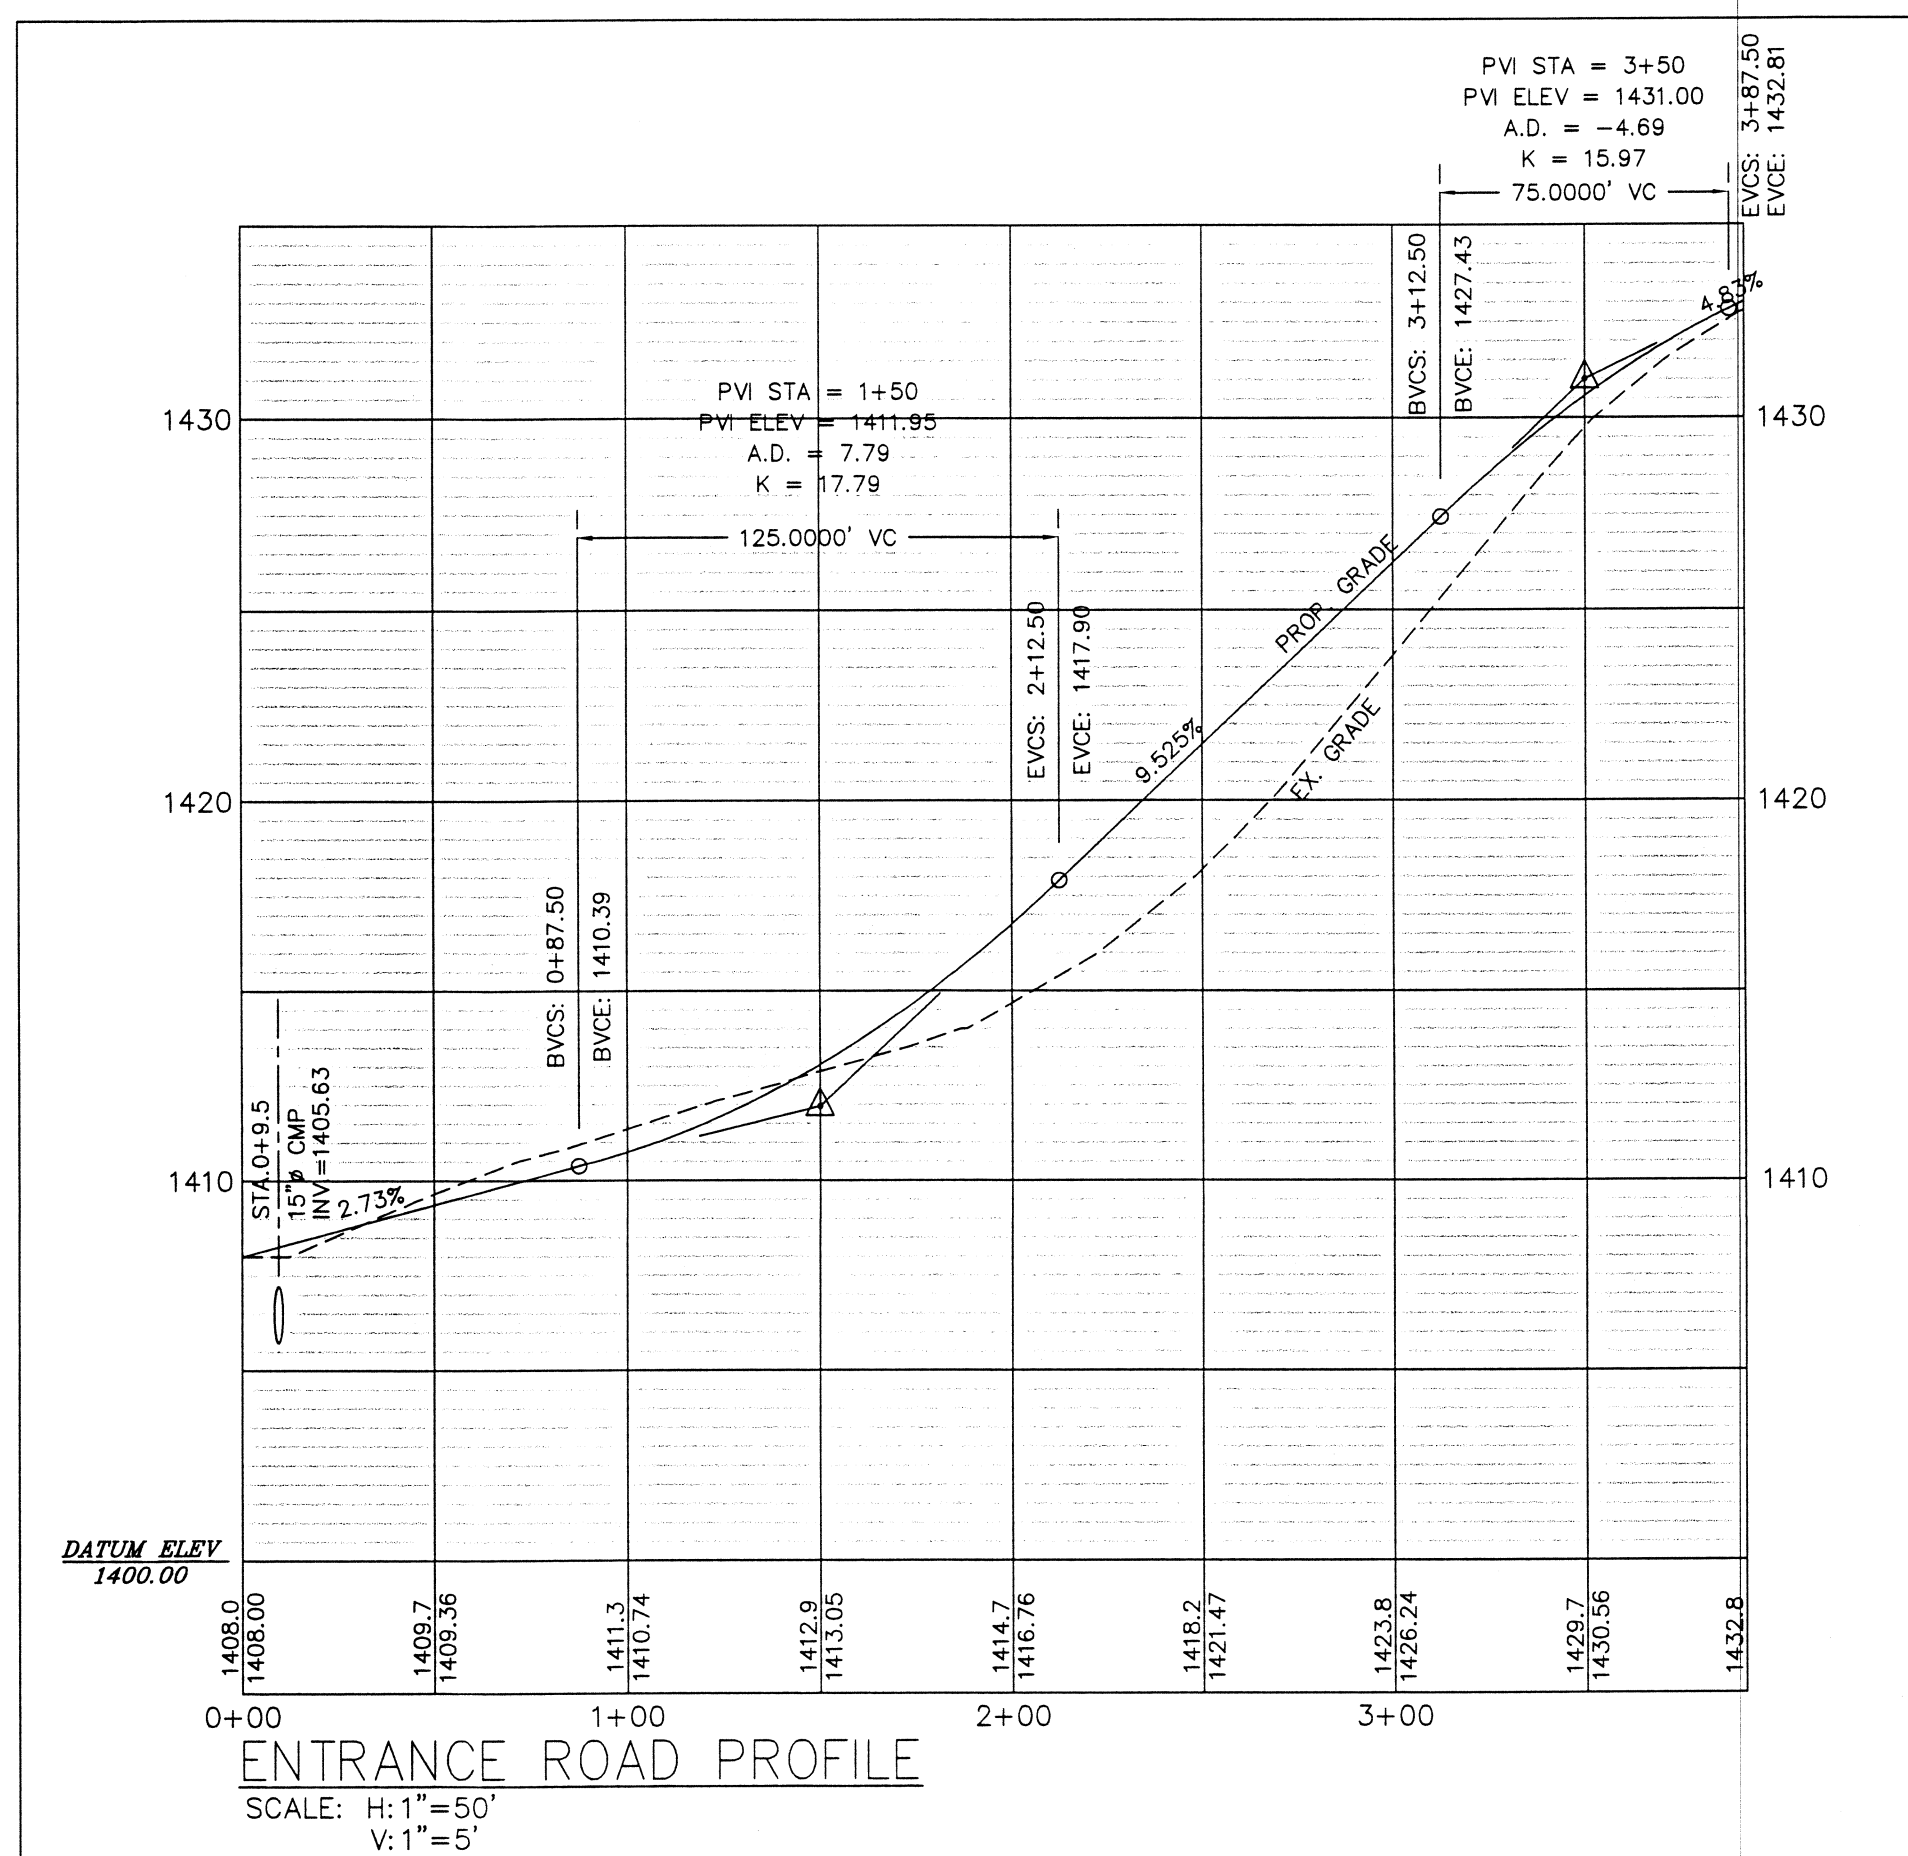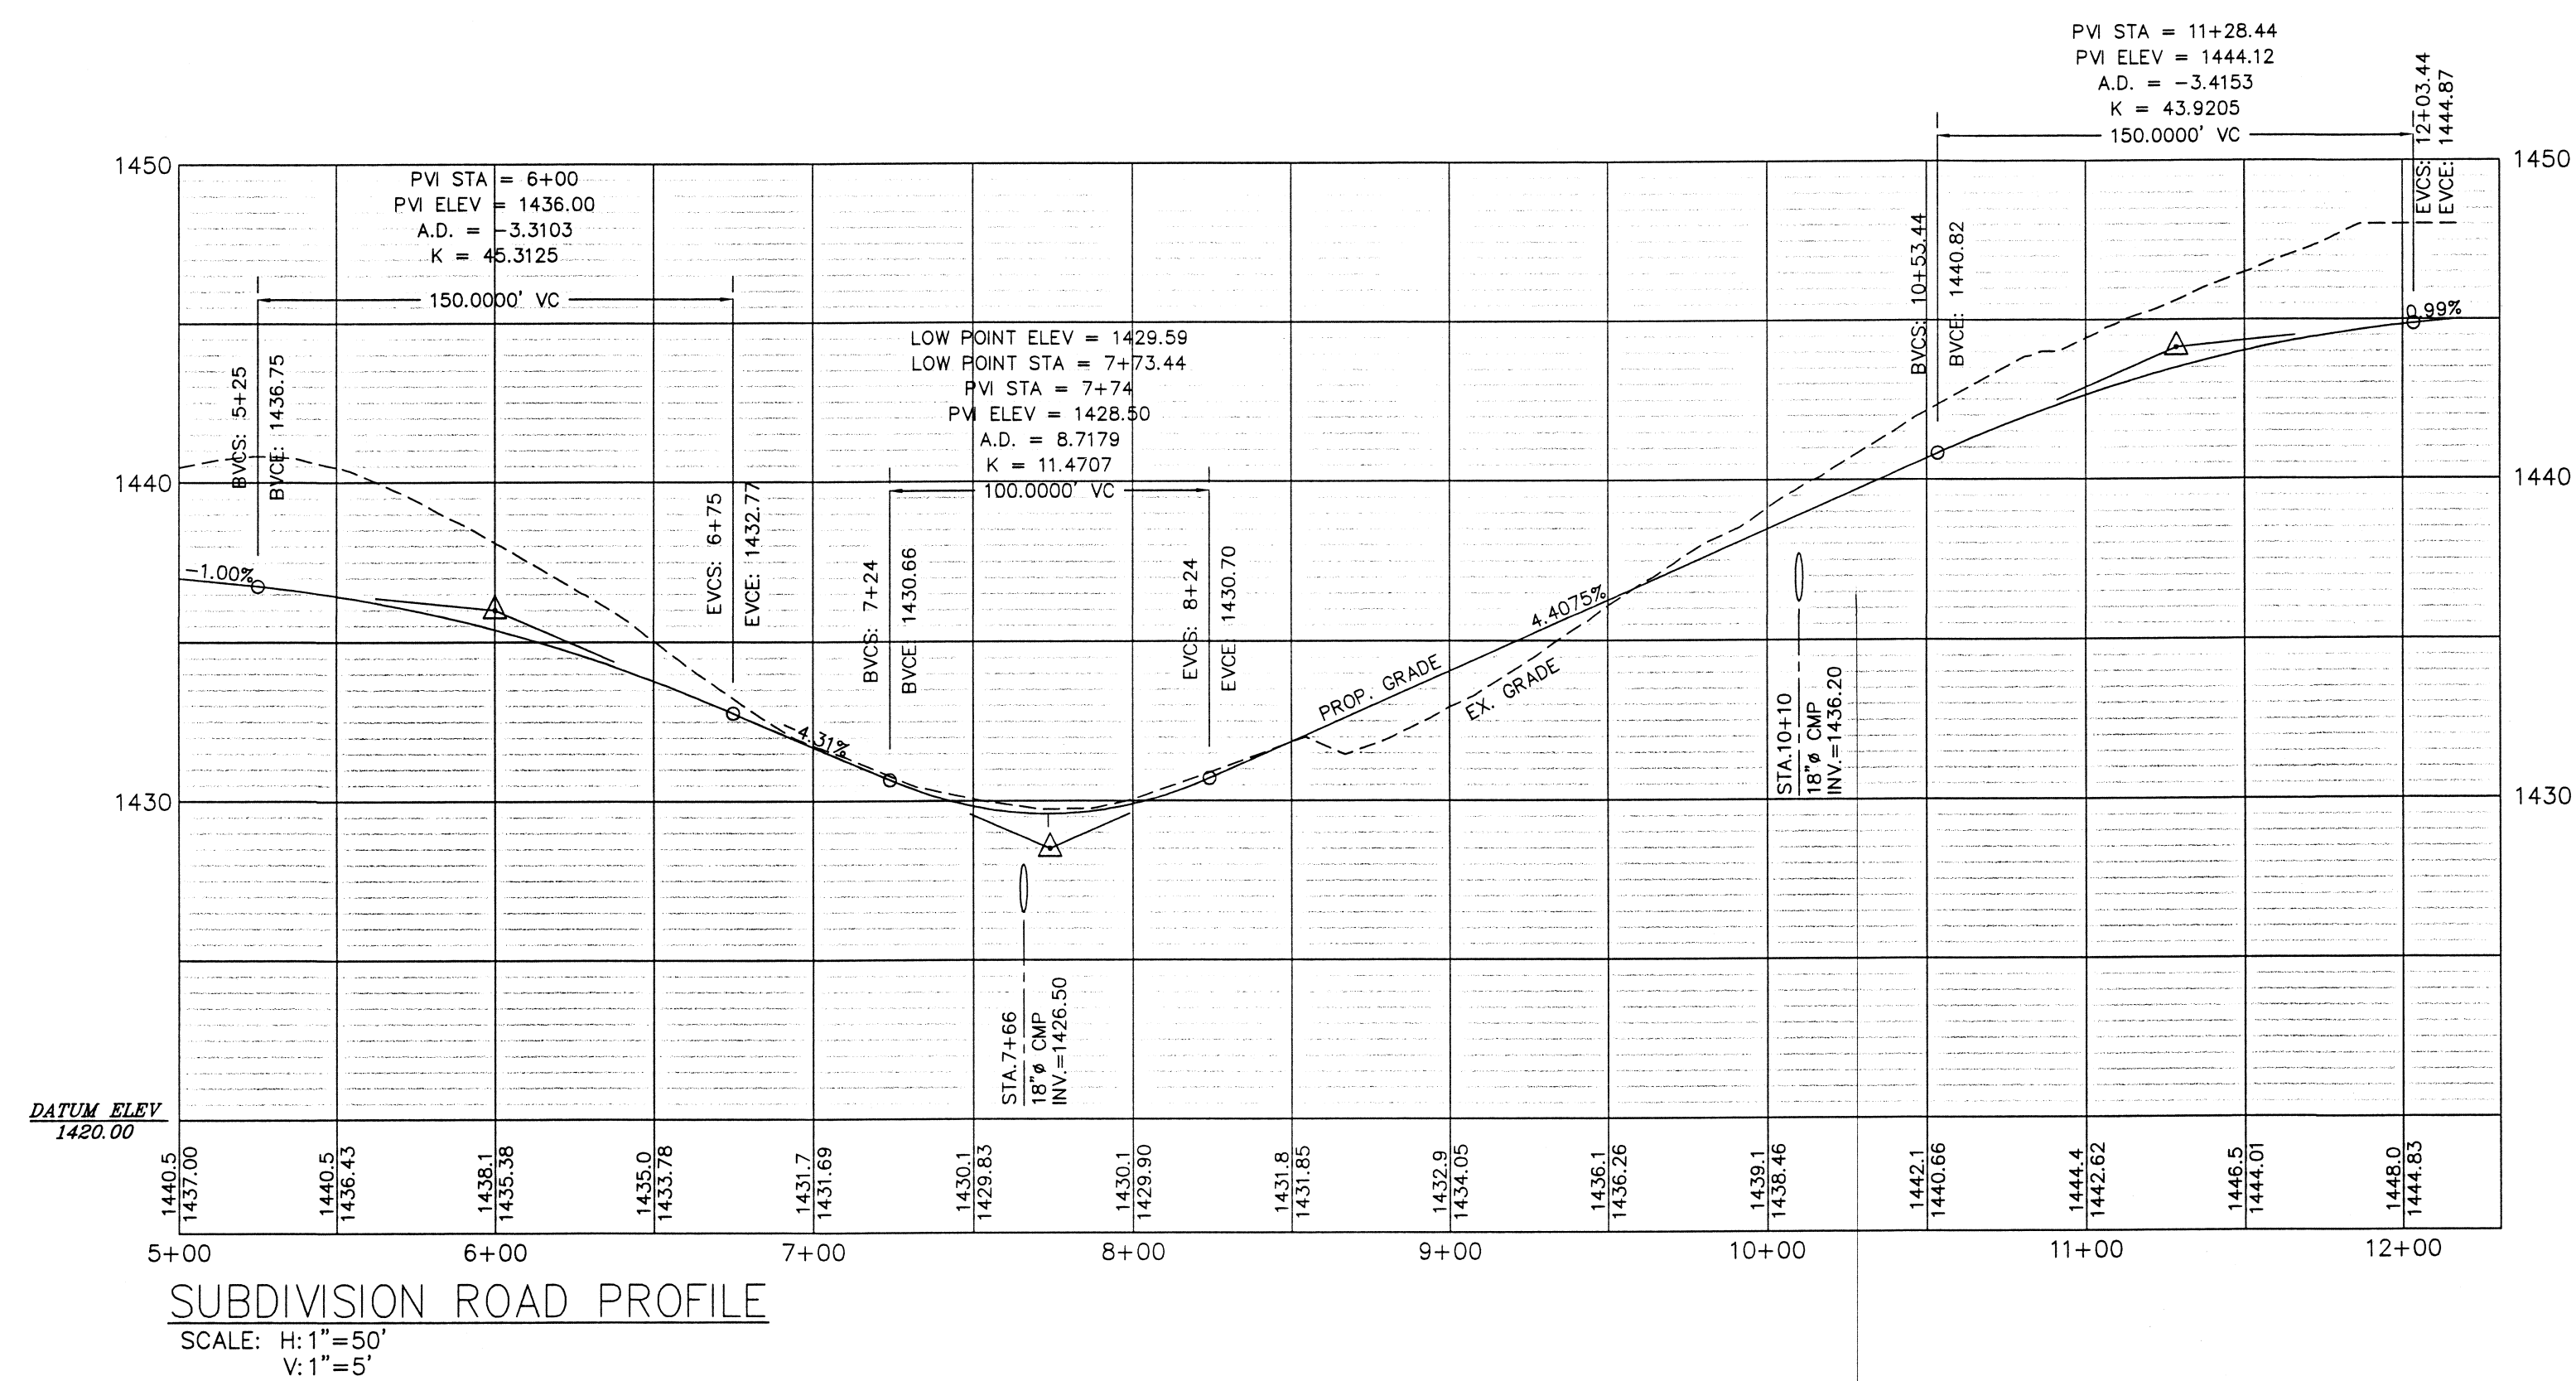

DATE:	01-30-07
REVISIONS	


PIERSON
ENGINEERING
&
SURVEYING

P.O. BOX 311
1324 ROANOKE ROAD
DALEVILLE, VA 24083

(540) 966-3027 TEL
(540) 966-5906 FAX
e-mail: rpierson@rbnet.com

SITE PLAN FOR
ASHLEY PLANTATION—SECTION 5
PHASE I & II
TOWN OF CHRISTANSBURG, VIRGINIA

ROAD PROFILES

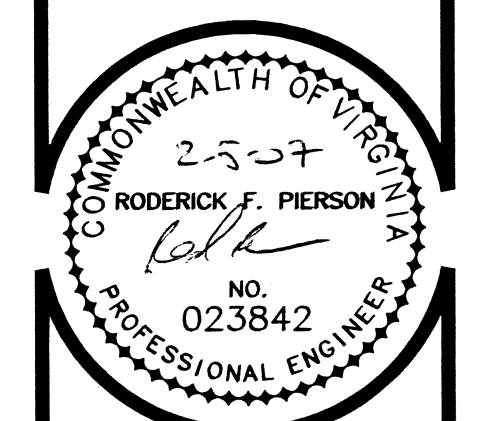

COMMISSION
R200471
SHEET
6

AS-BUILTS

DATE:	01-30-07
REVISIONS	
△	
△	
△	
△	

PIERSON
ENGINEERING
&
SURVEYING

P.O. BOX 311
1324 ROANOKE ROAD
DALEVILLE, VA 24083

(540) 966-3027 TEL
(540) 966-5906 FAX
e-mail: rpierson@rbnet.com

SITE PLAN FOR
ASHLEY PLANTATION—SECTION 5
PHASE I & II
TOWN OF CHRISTANSBURG, VIRGINIA

WATER PROFILE

COMMONWEALTH OF VIRGINIA

2-1-07


RODERICK E. PIERSON

NO. 023842

PROFESSIONAL ENGINEER

COMMISSION R200471

SHEET 7

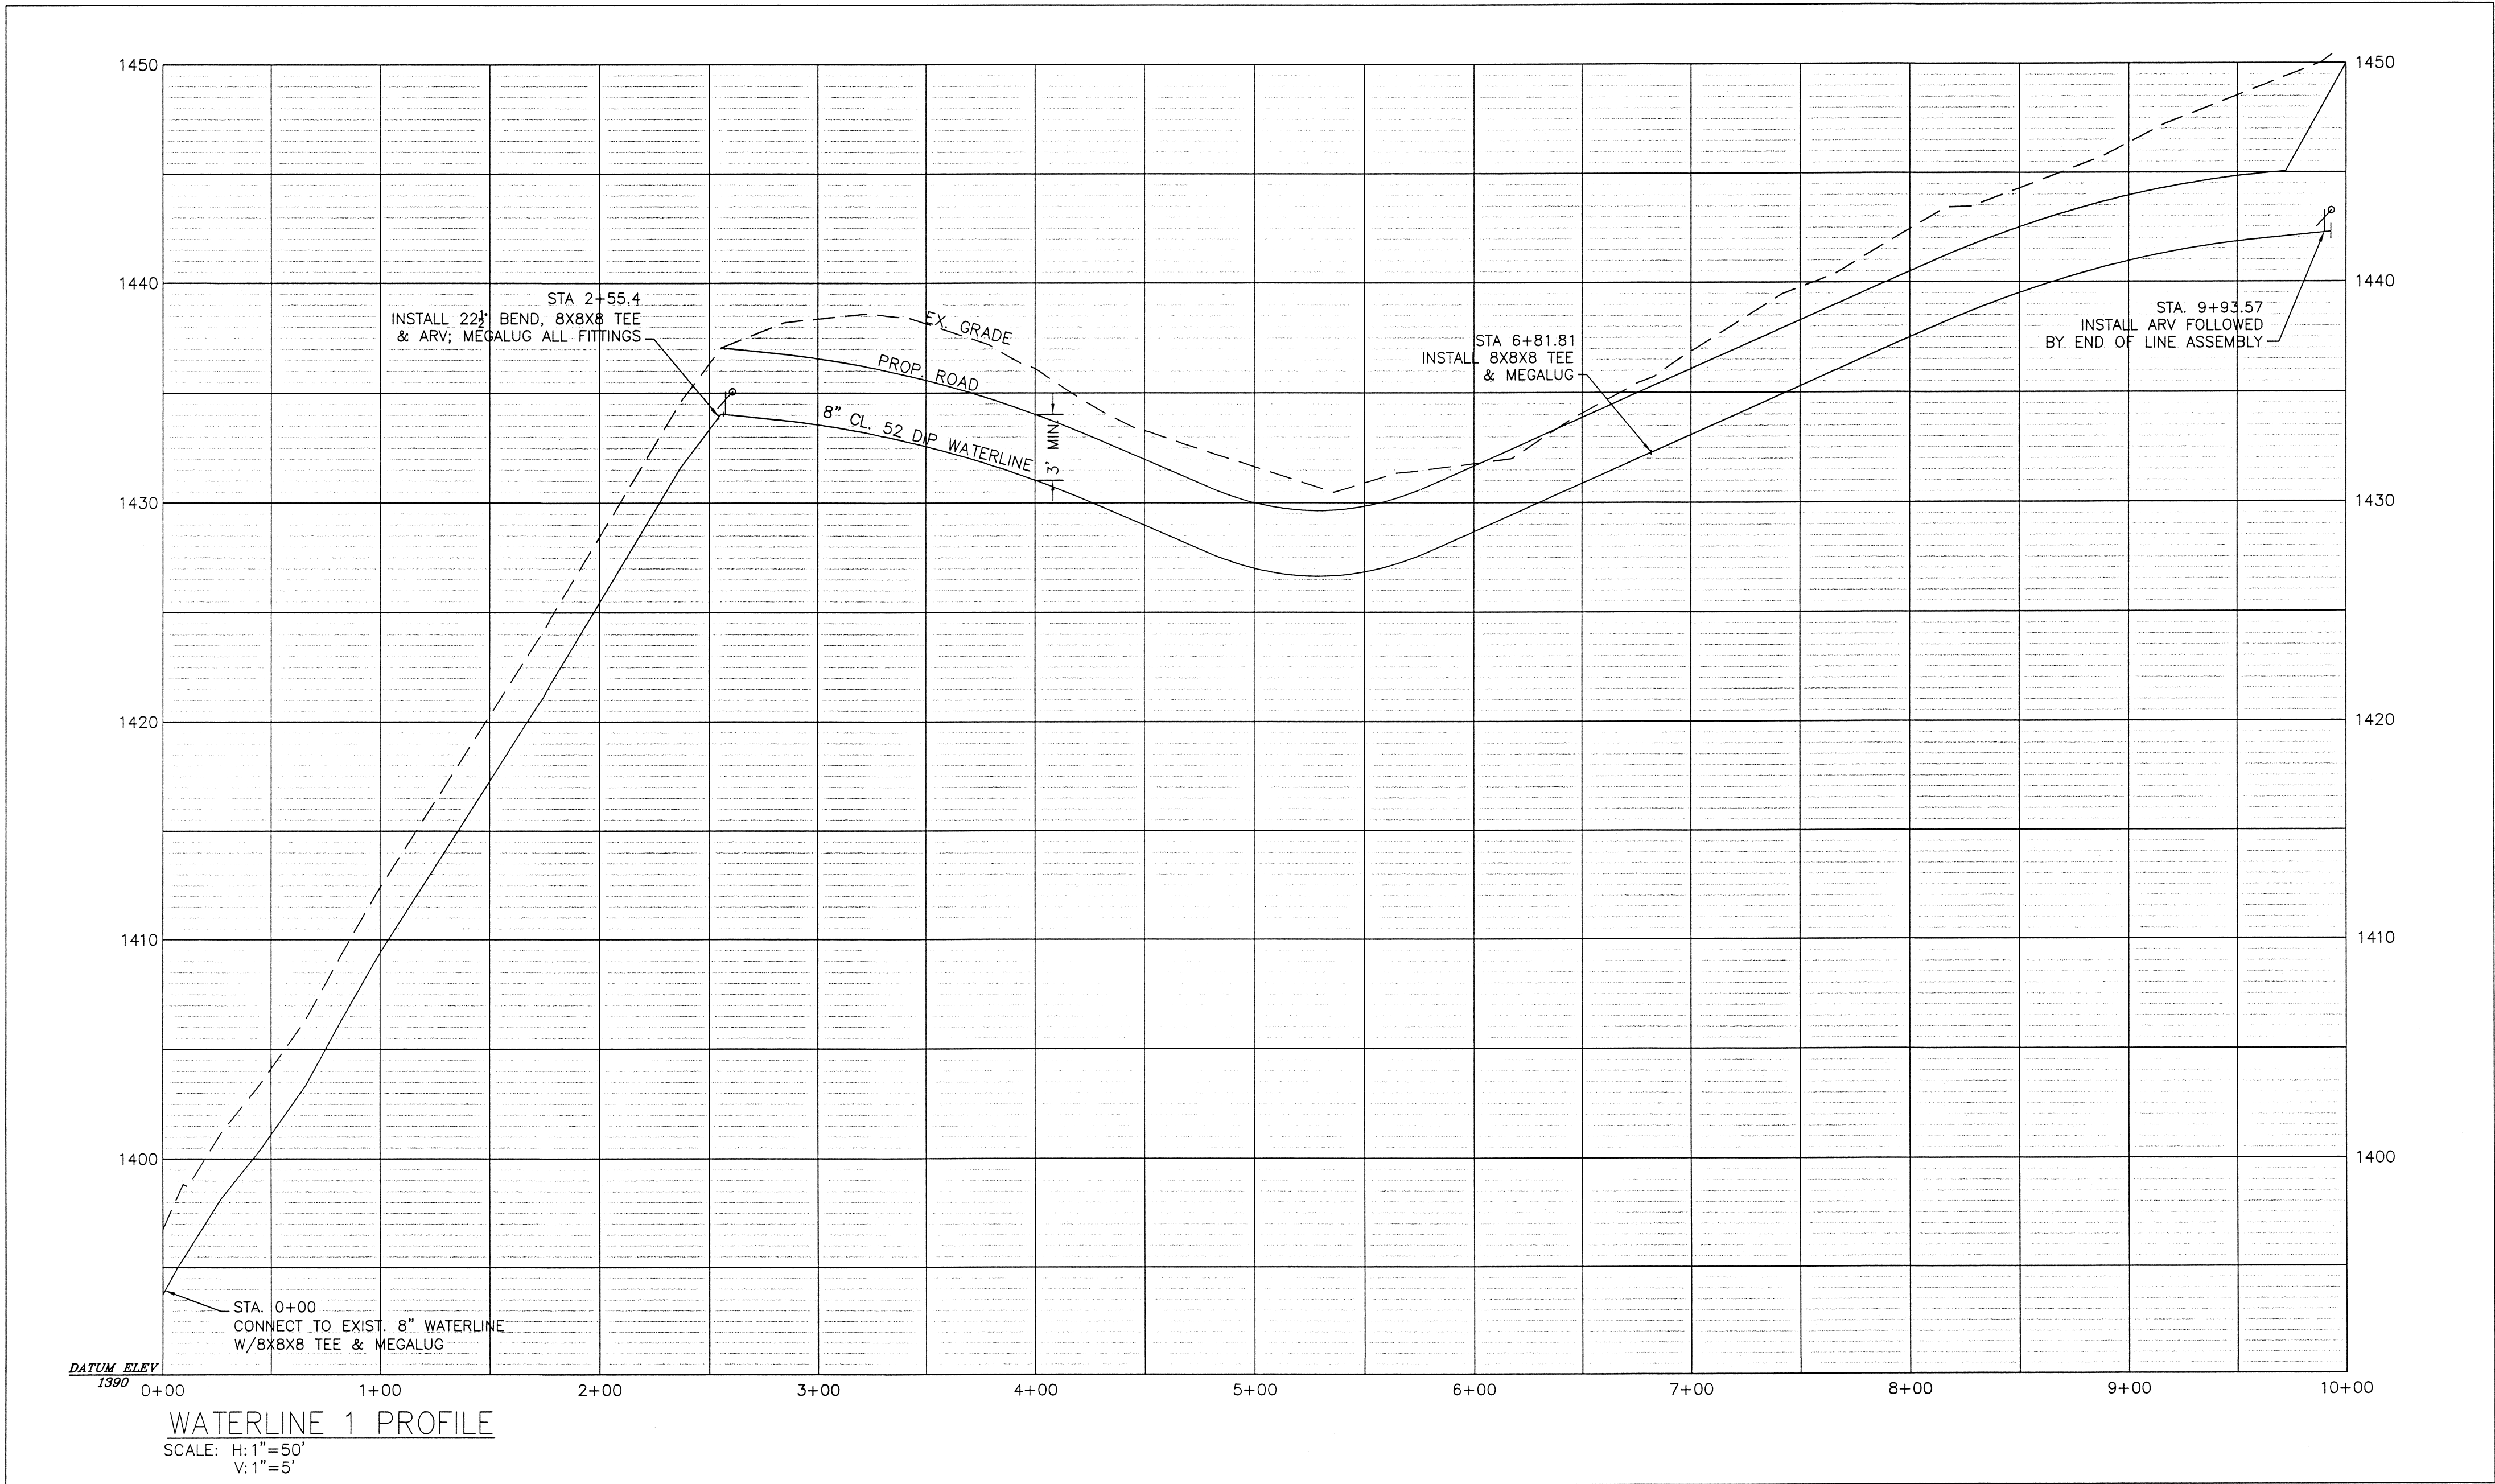

AS-BUILTS

DATE: 01-30-07

REVISIONS
△
△
△
△


PIERSON
ENGINEERING
&
SURVEYING

P.O. BOX 311
1324 ROANOKE ROAD
DALEVILLE, VA 24083


(540) 966-3027 TEL
(540) 966-5906 FAX
e-mail: rpierson@rbnet.com

SITE PLAN FOR
ASHLEY PLANTATION-SECTION 5
PHASE I & II
TOWN OF CHRISTANSBURG, VIRGINIA

WATER PROFILE

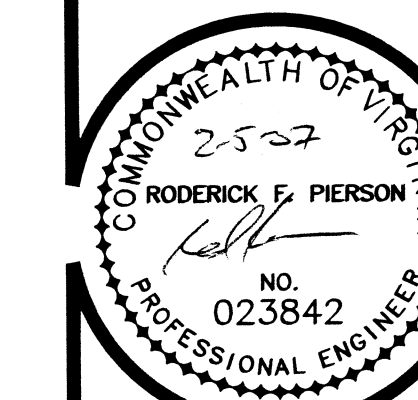

COMMISSION
R200471
SHEET
8

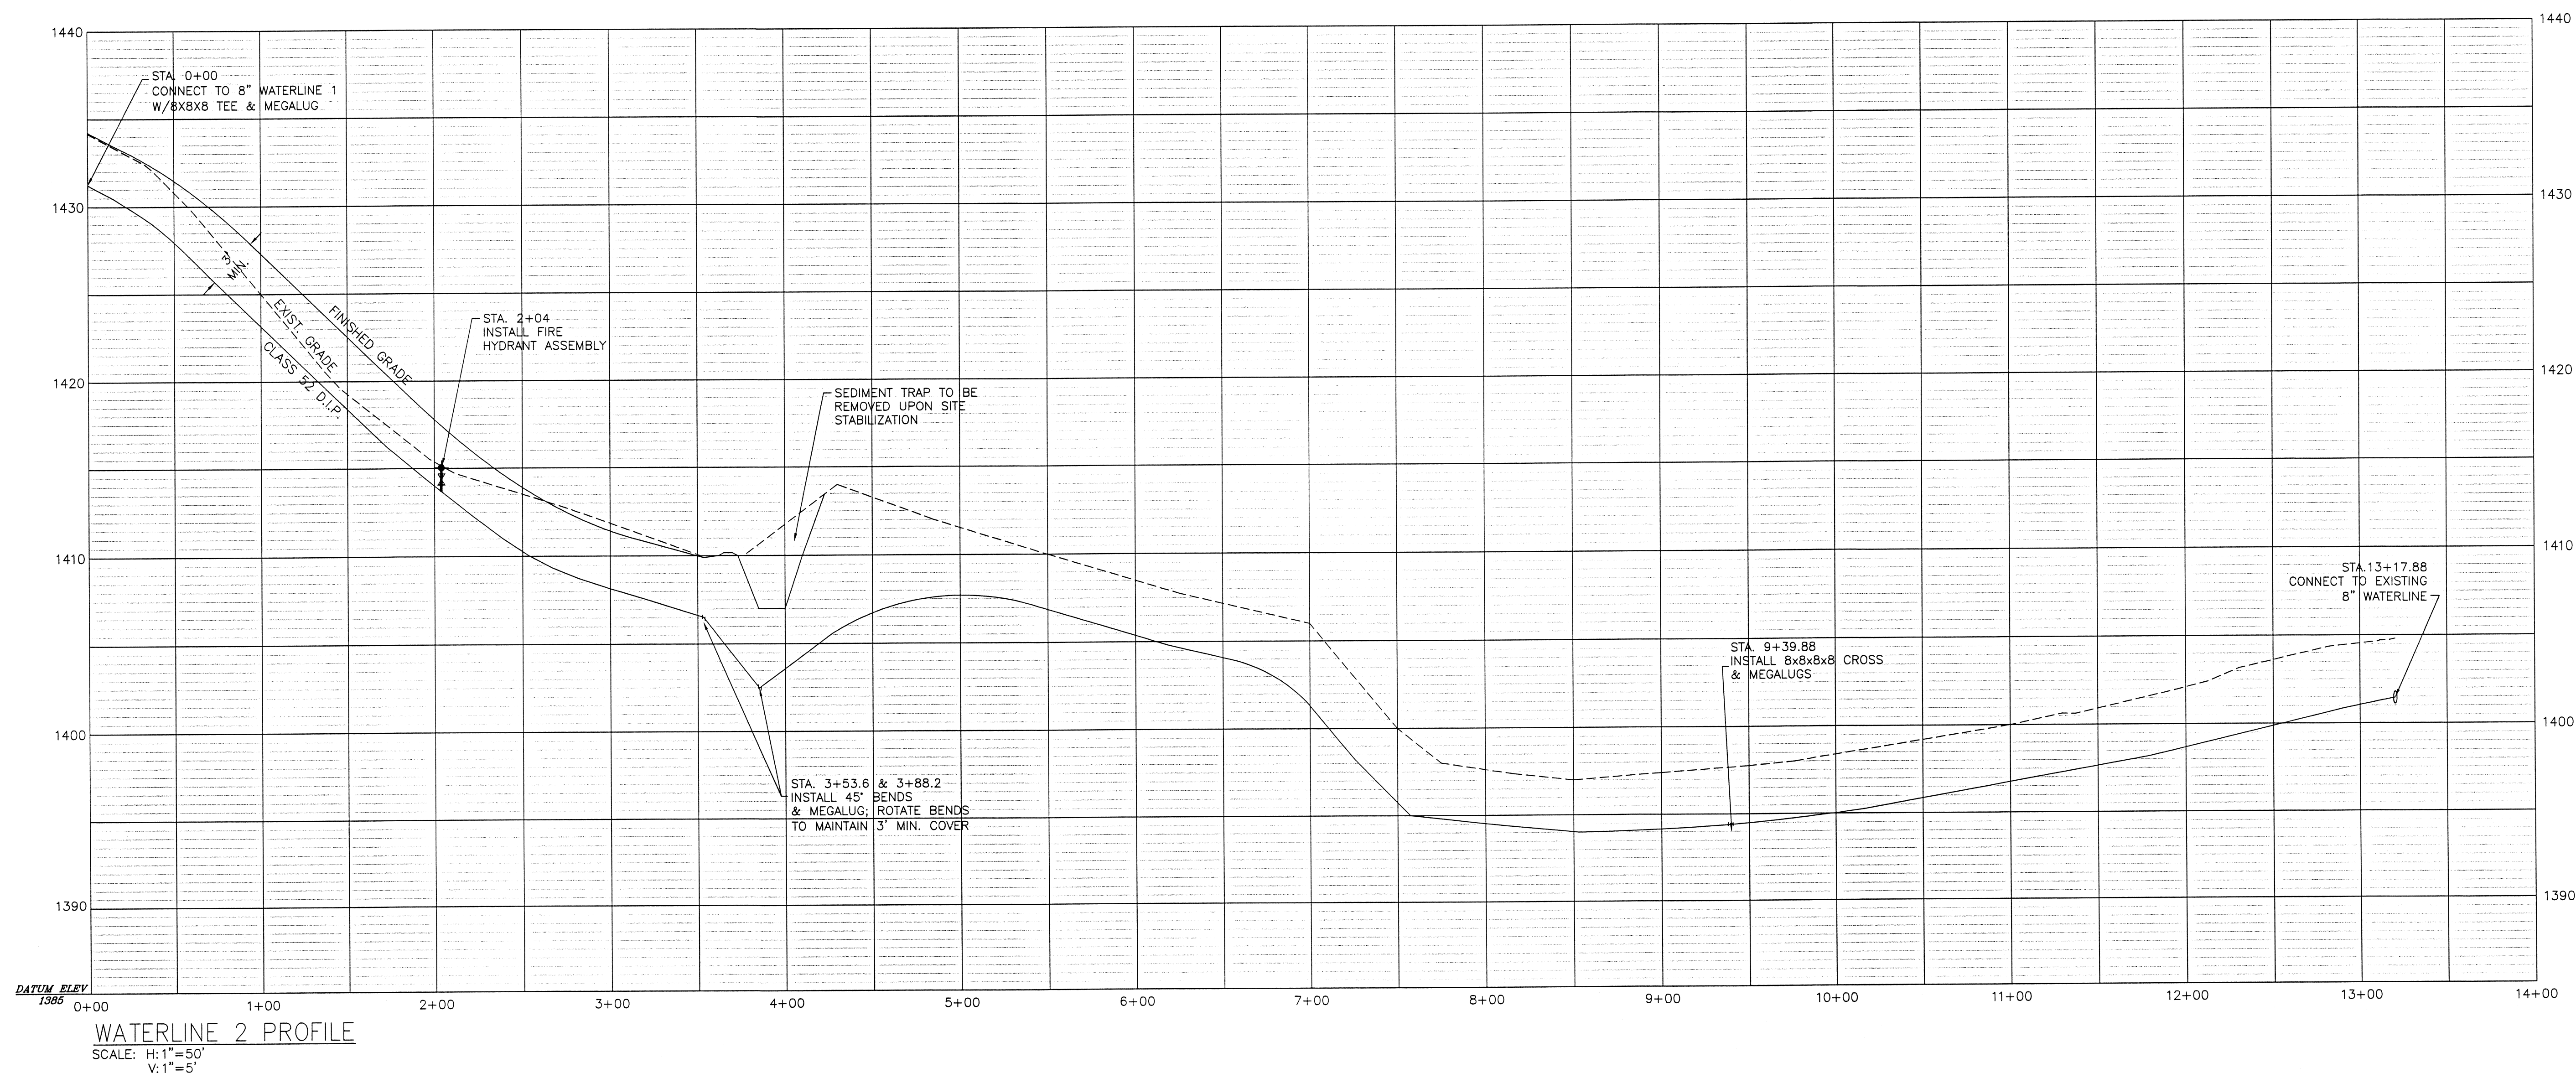

AS-BUILTS

DATE: 01-30-07

REVISIONS
△
△
△
△


PIERSON
ENGINEERING
&
SURVEYING

P.O. BOX 311
1324 ROANOKE ROAD
DALEVILLE, VA 24083


(540) 966-3027 TEL
(540) 966-5906 FAX
e-mail: rpierson@rbnet.com

SITE PLAN FOR
ASHLEY PLANTATION—SECTION 5
PHASE I & II
TOWN OF CHRISTANSBURG, VIRGINIA


SEWER PROFILE

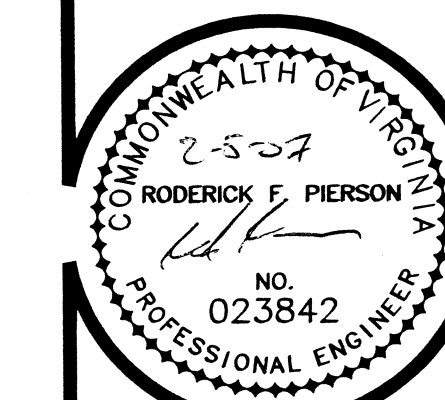

COMMISSION
R200471
SHEET
9

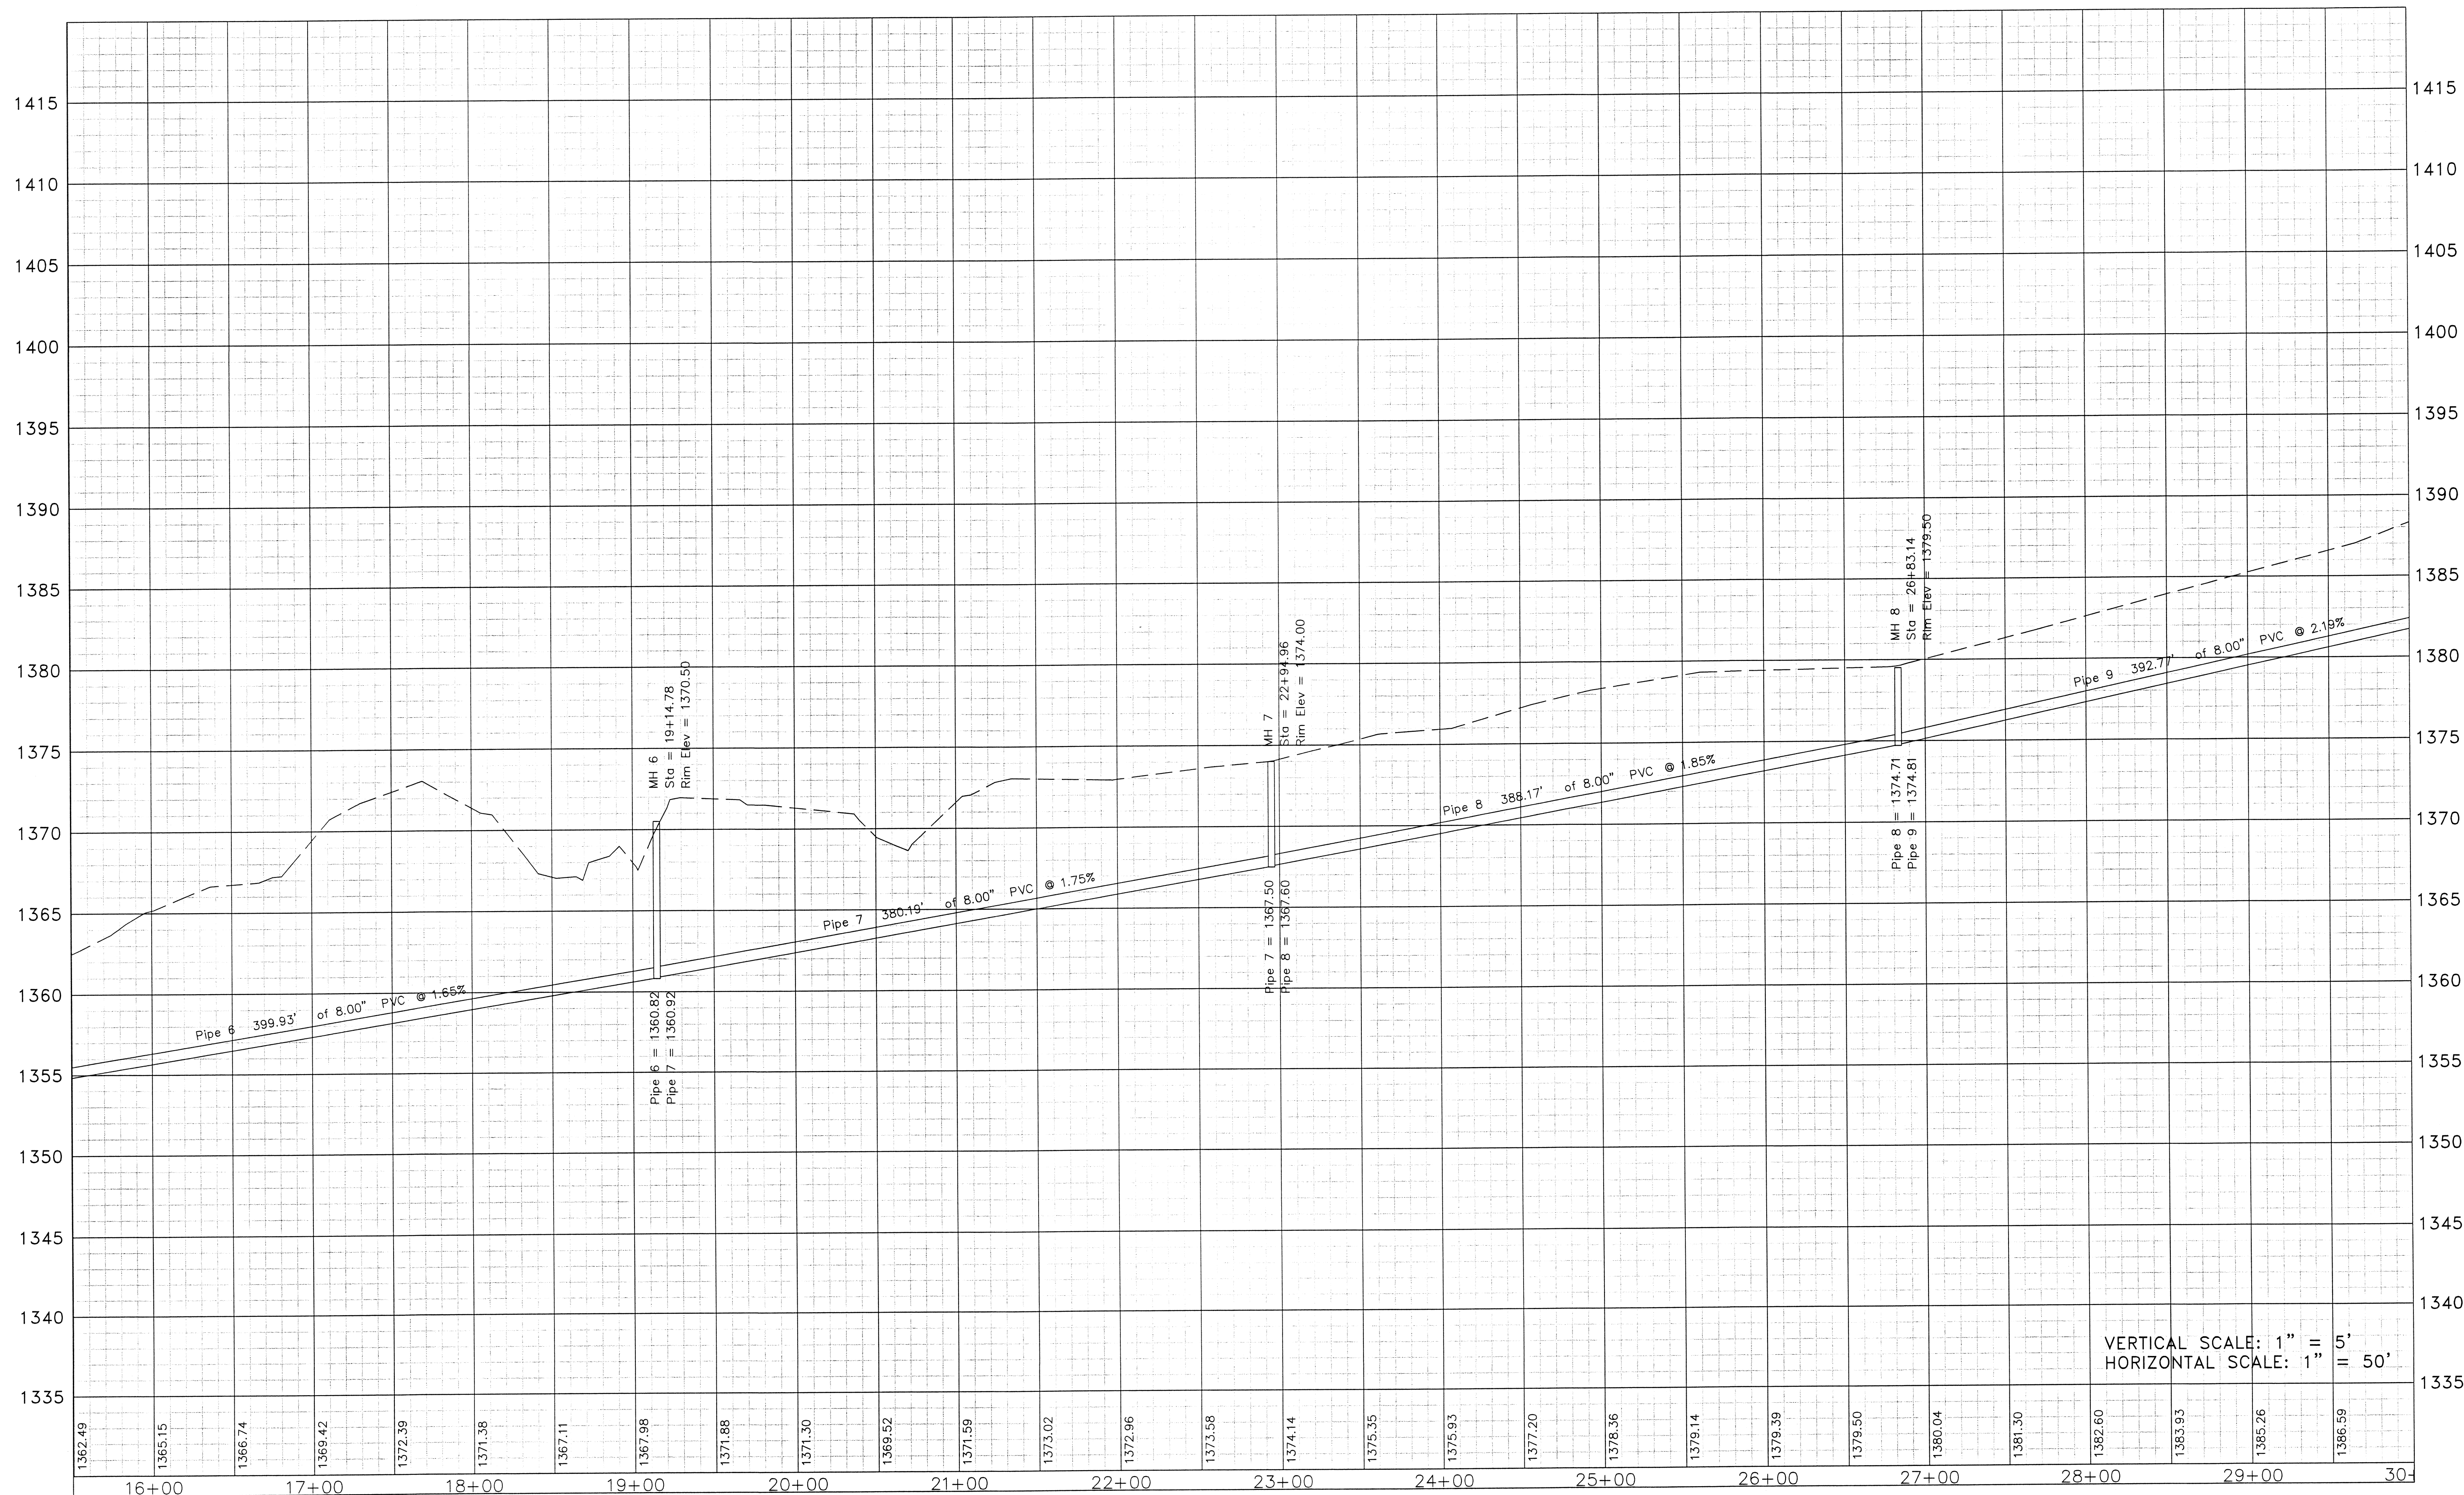

AS-BUILTS

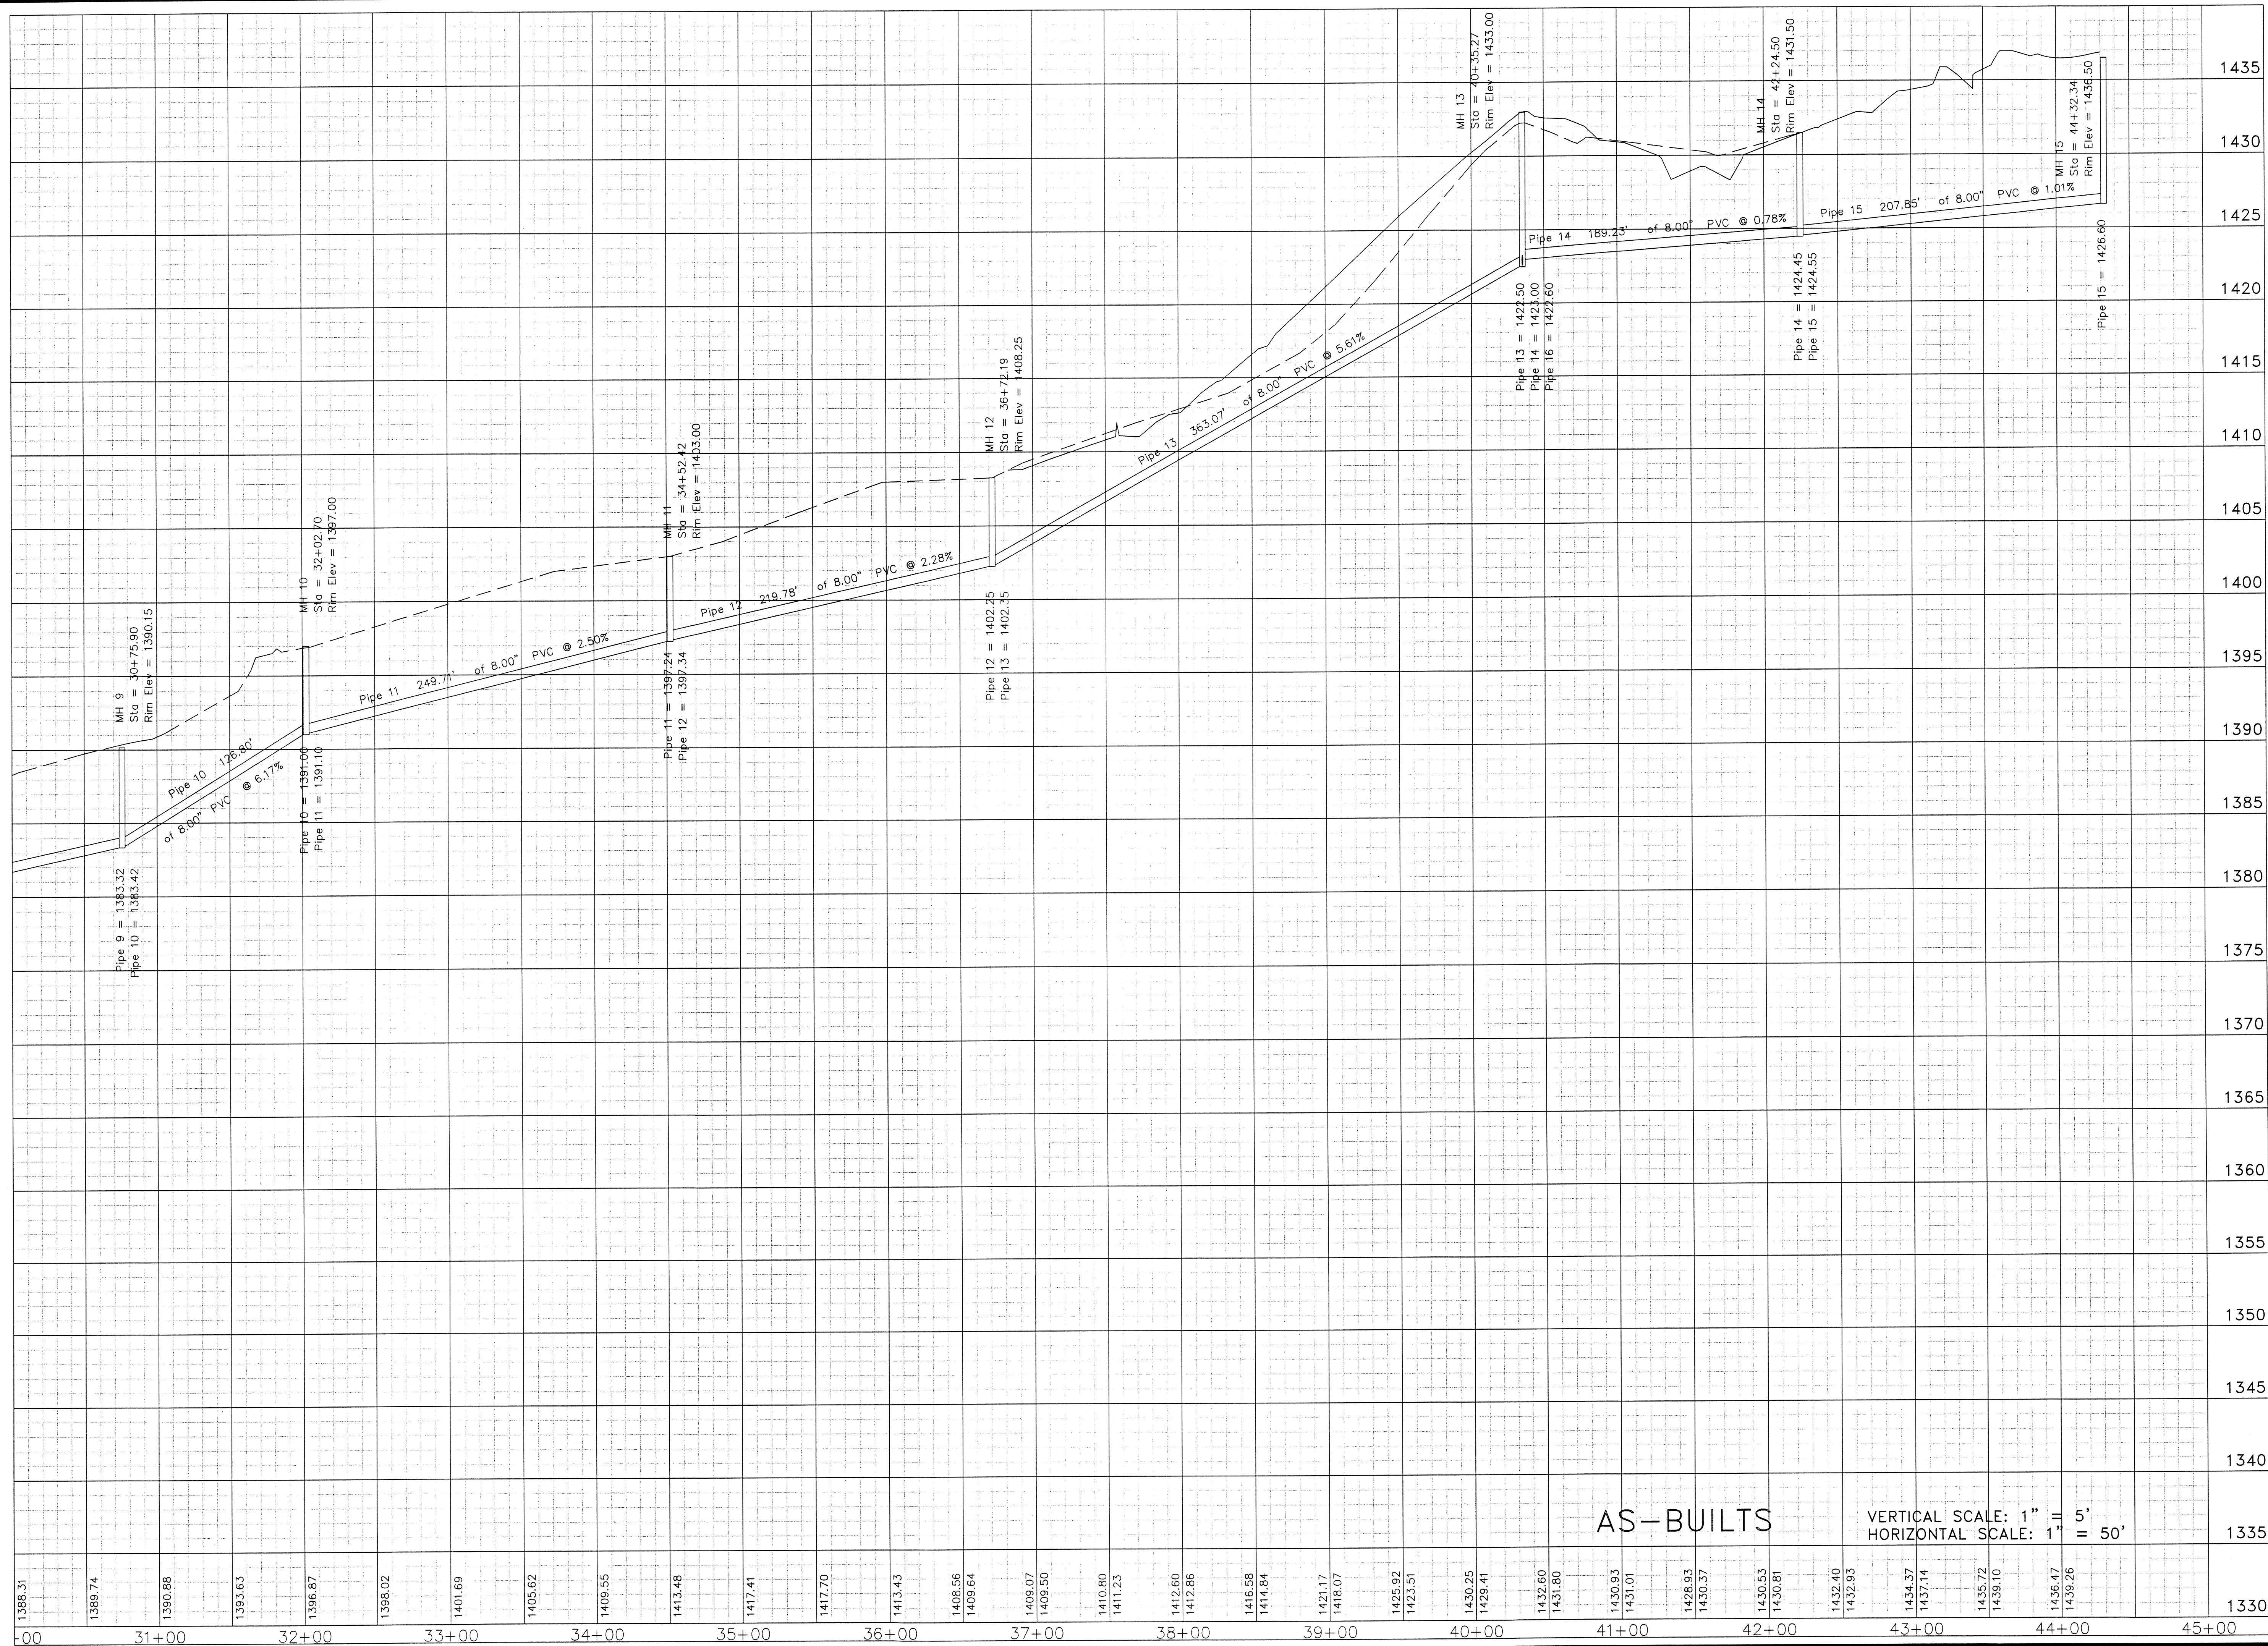

DATE:	01-30-07
REVISIONS	

PIERSON
ENGINEERING
&
SURVEYING

P.O. BOX 311
1324 ROANOKE ROAD
DALEVILLE, VA 24083

(540) 966-3027 TEL
(540) 966-5906 FAX
e-mail: rpierson@rbnet.com

SITE PLAN FOR
ASHLEY PLANTATION-SECTION 5
PHASE I & II
TOWN OF CHRISTANSBURG, VIRGINIA

SEWER PROFILE

COMMONWEALTH OF VIRGINIA
2-5-07
RODERICK F. PIERSON
NO. 023842
PROFESSIONAL ENGINEER
COMMISSION R200471
SHEET 10

DATE:	01-30-07
REVISIONS	
△	
△	
△	
△	


PIERSON
ENGINEERING
&
SURVEYING

P.O. BOX 311
1324 ROANOKE ROAD
DALEVILLE, VA 24083





(540) 966-3027 TEL
(540) 966-5906 FAX
e-mail: rpierson@bnet.com

SITE PLAN FOR
ASHLEY PLANTATION—SECTION 5
PHASE I & II
TOWN OF CHRISTANSBURG, VIRGINIA

SEWER PROFILE

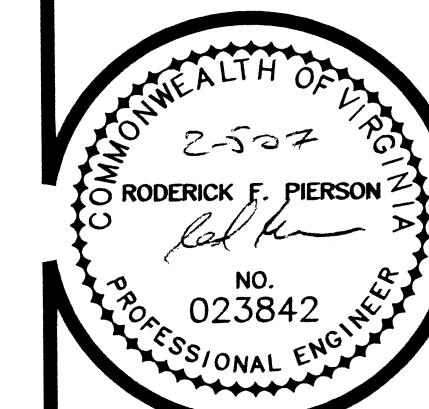

COMMISSION
R200471
SHEET
11

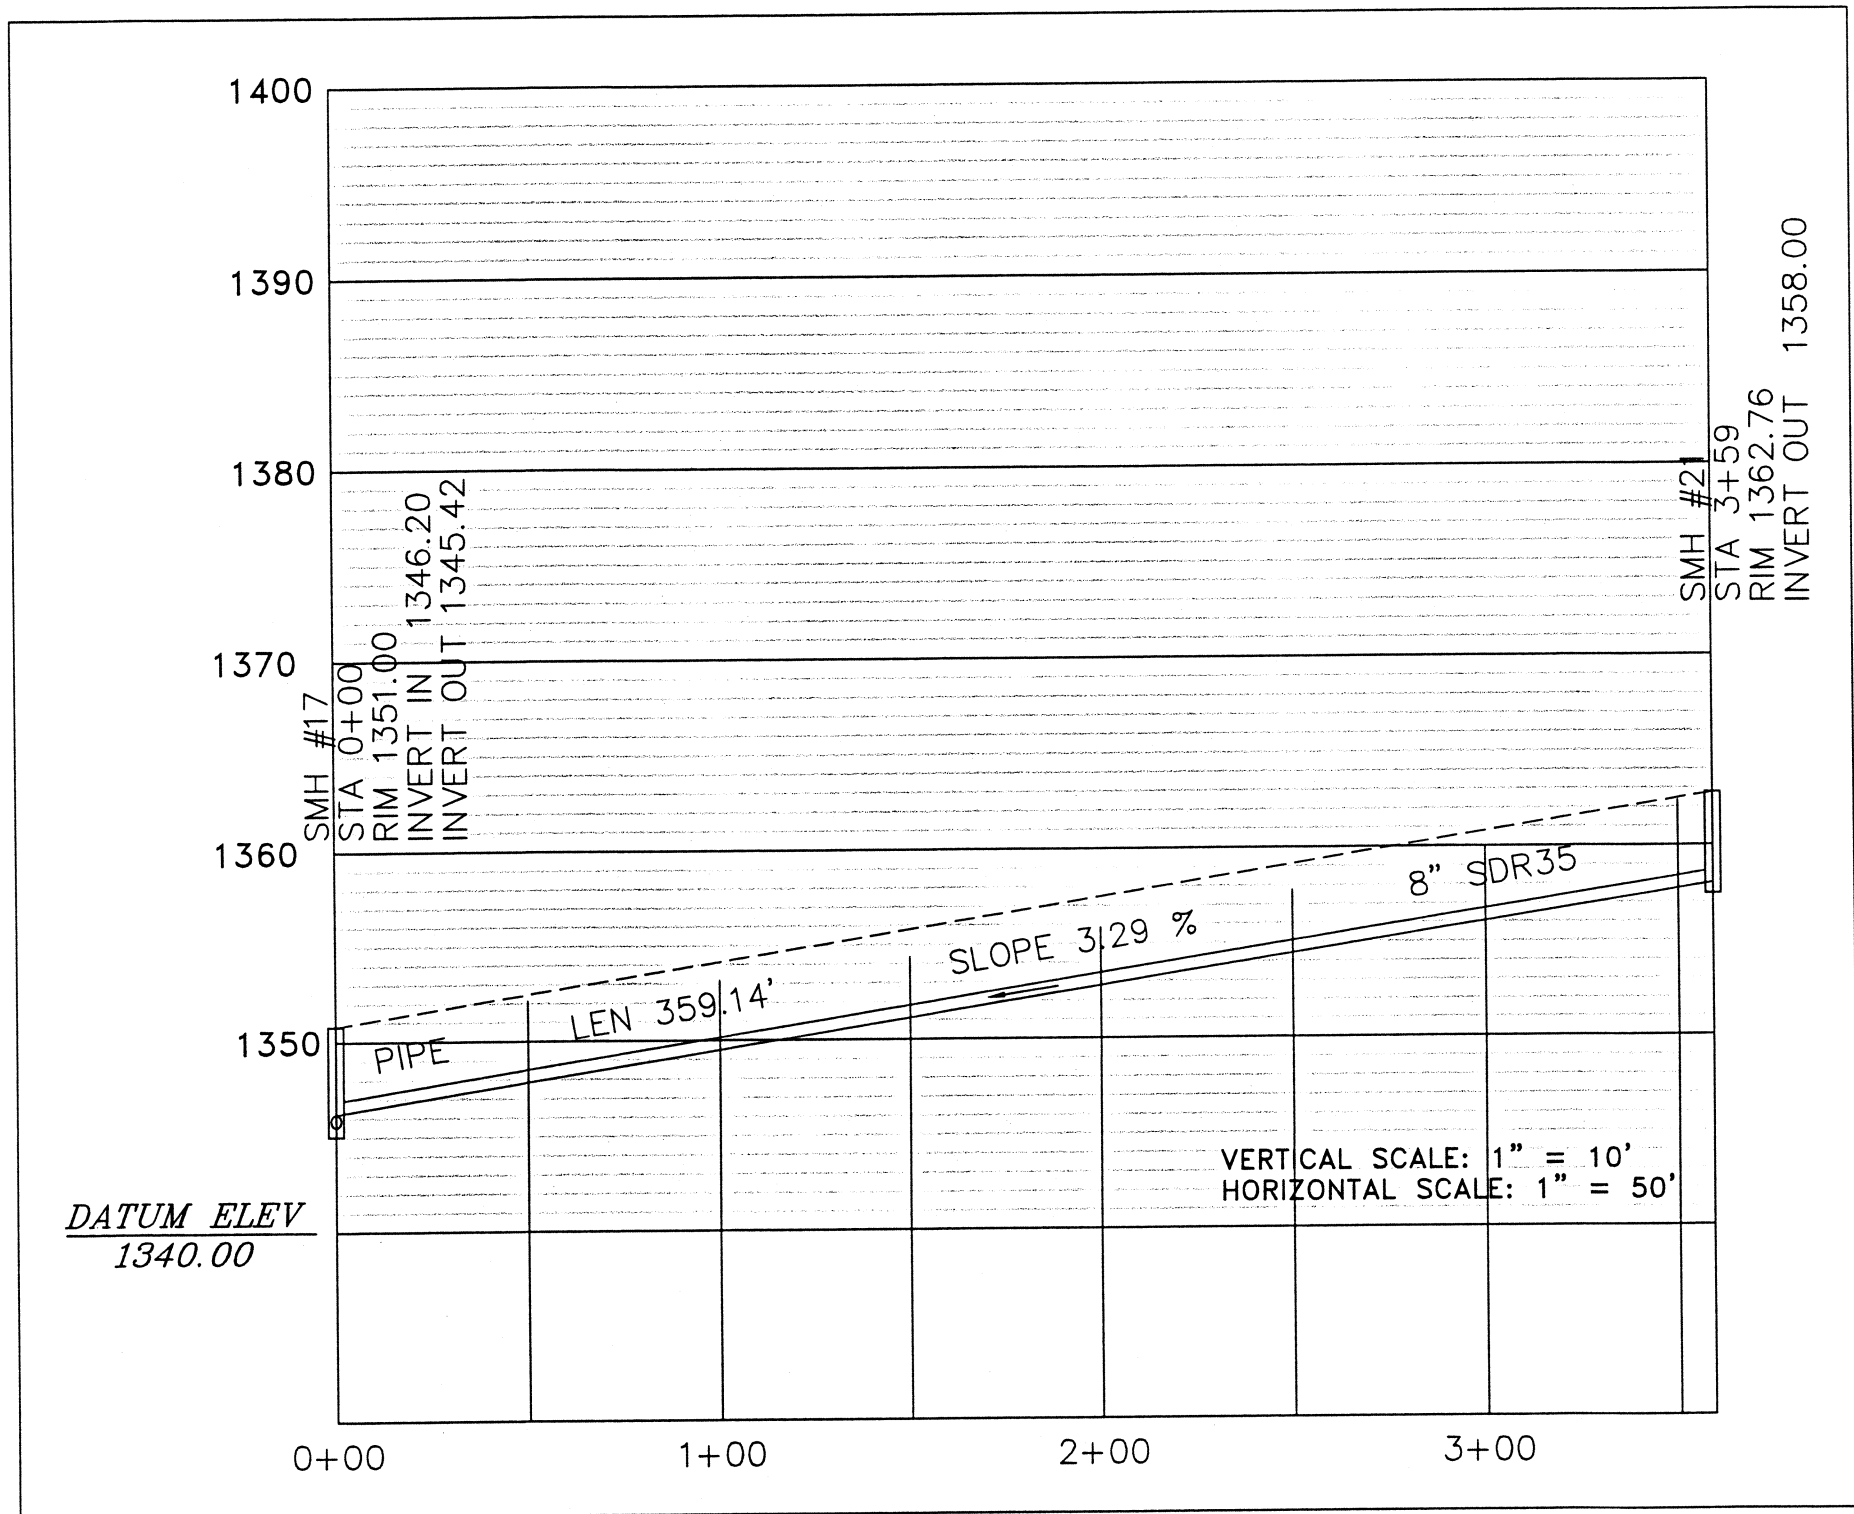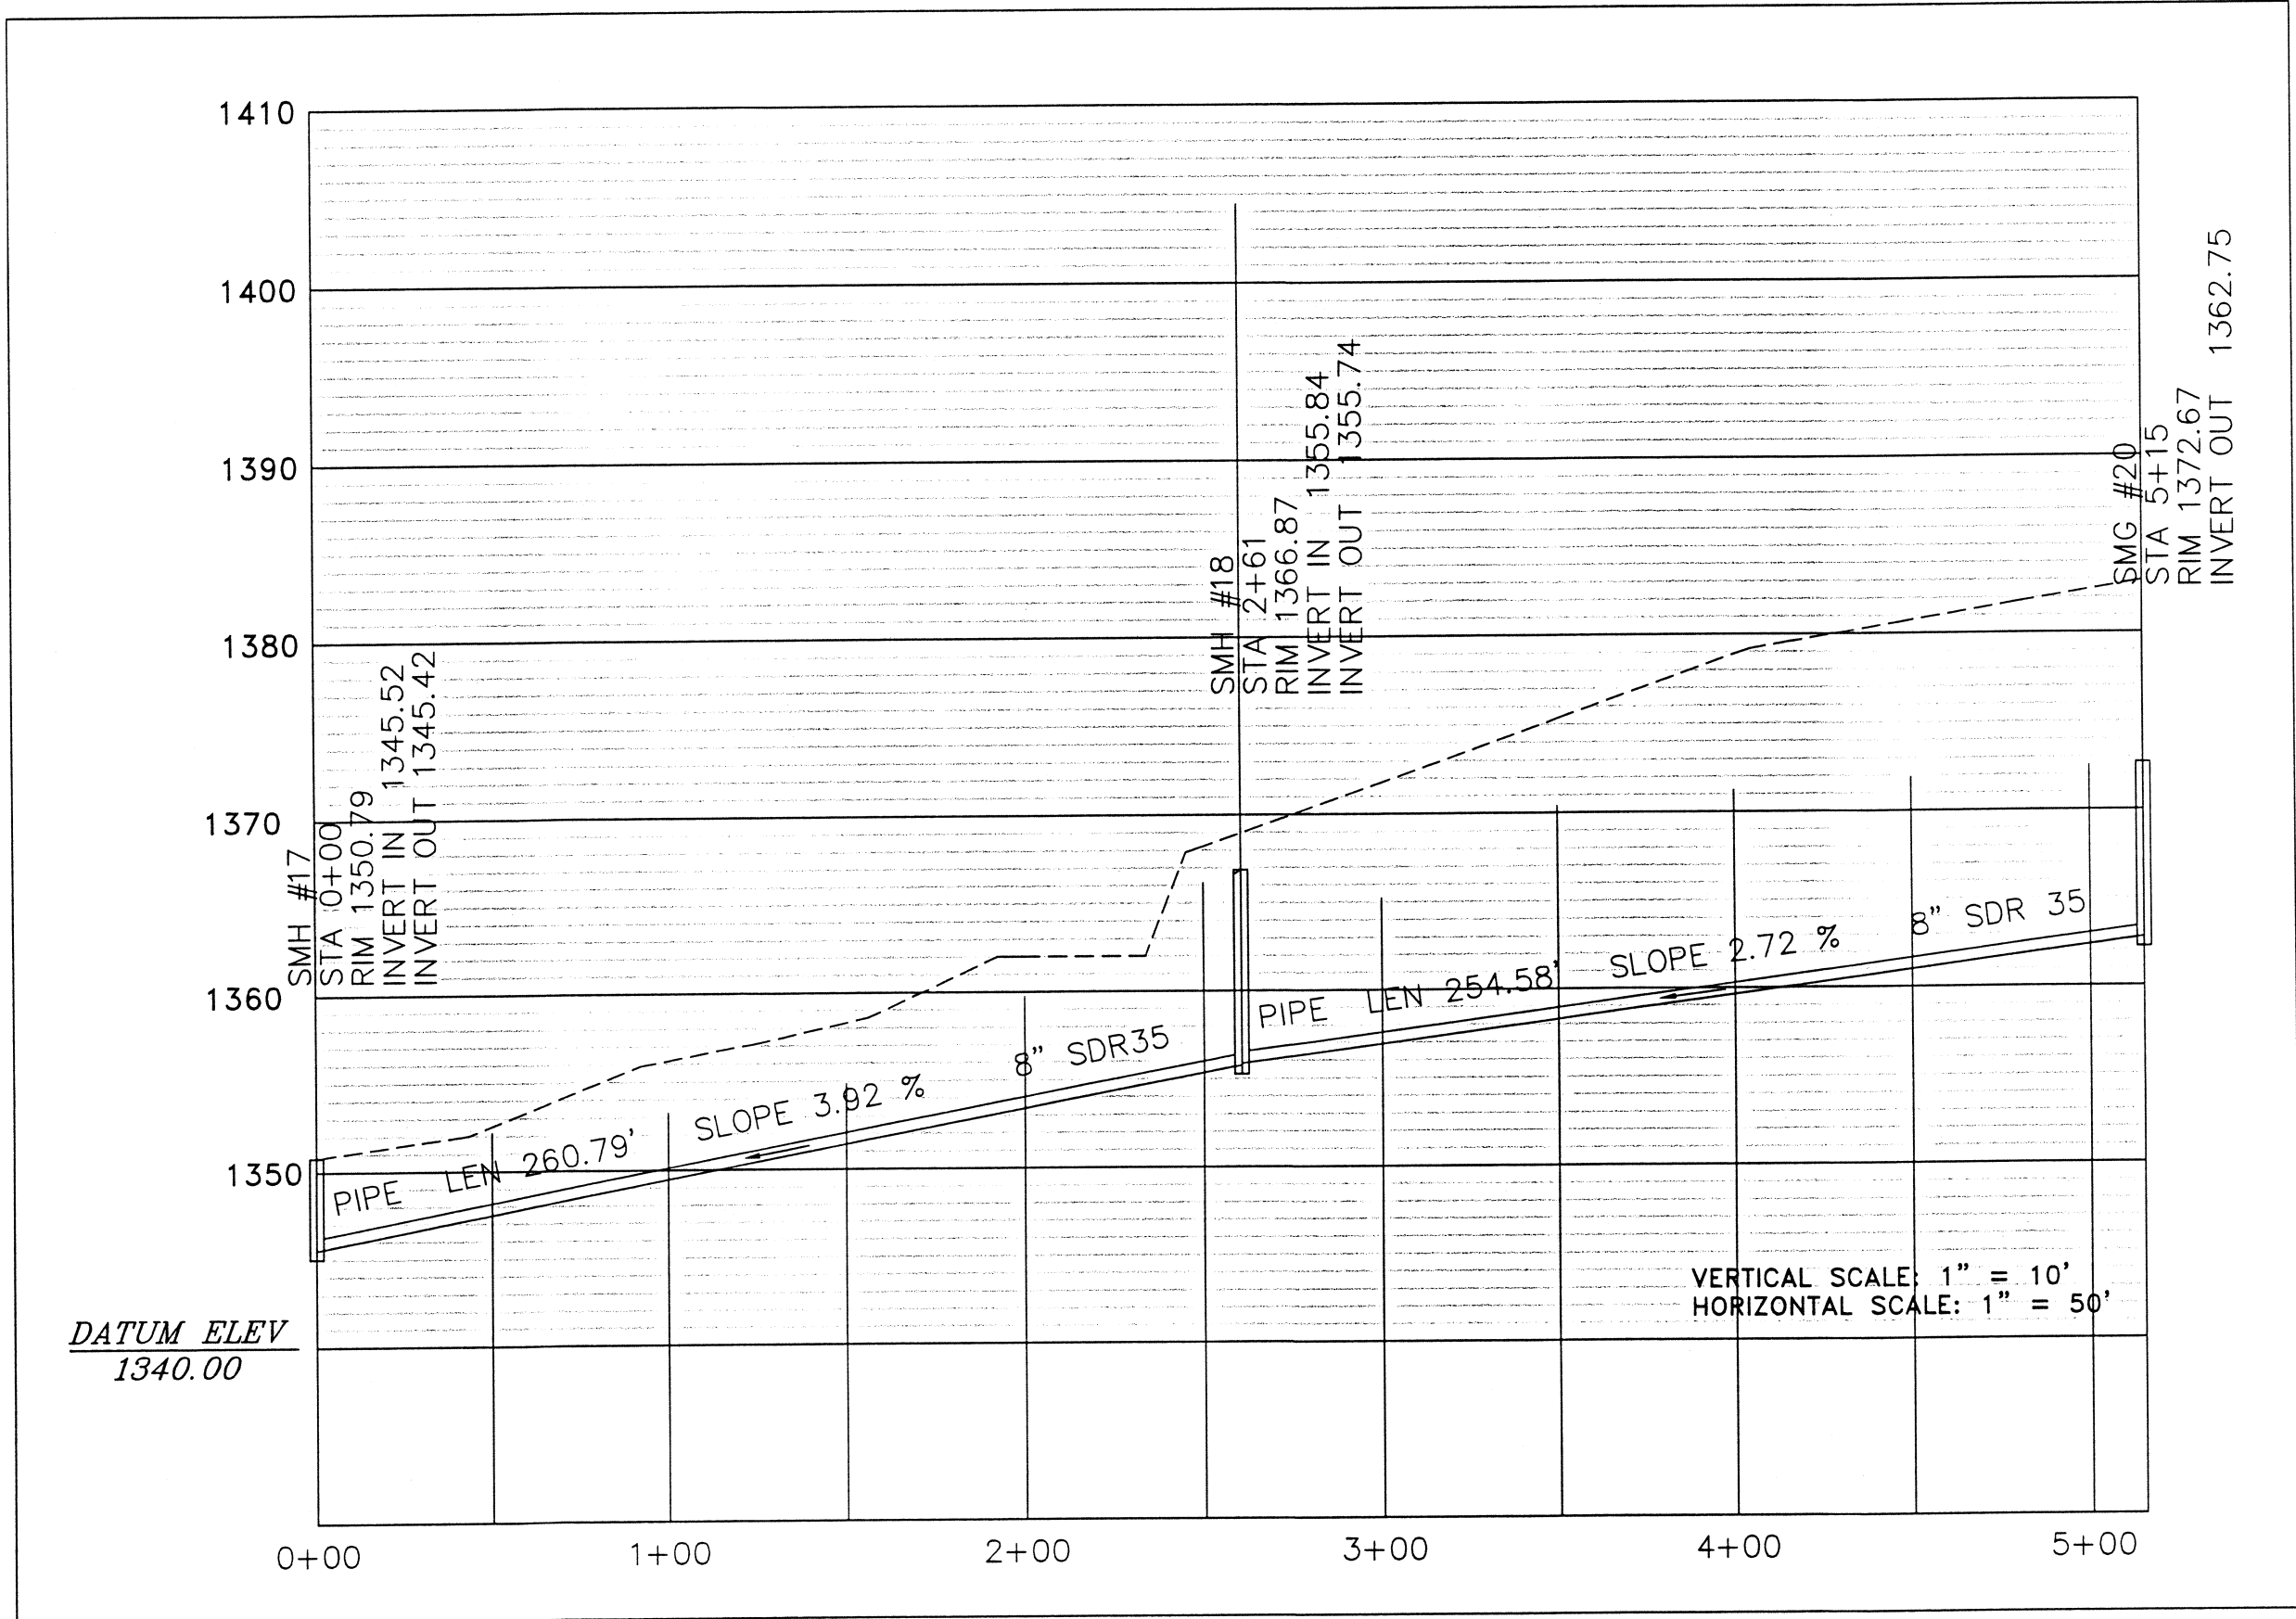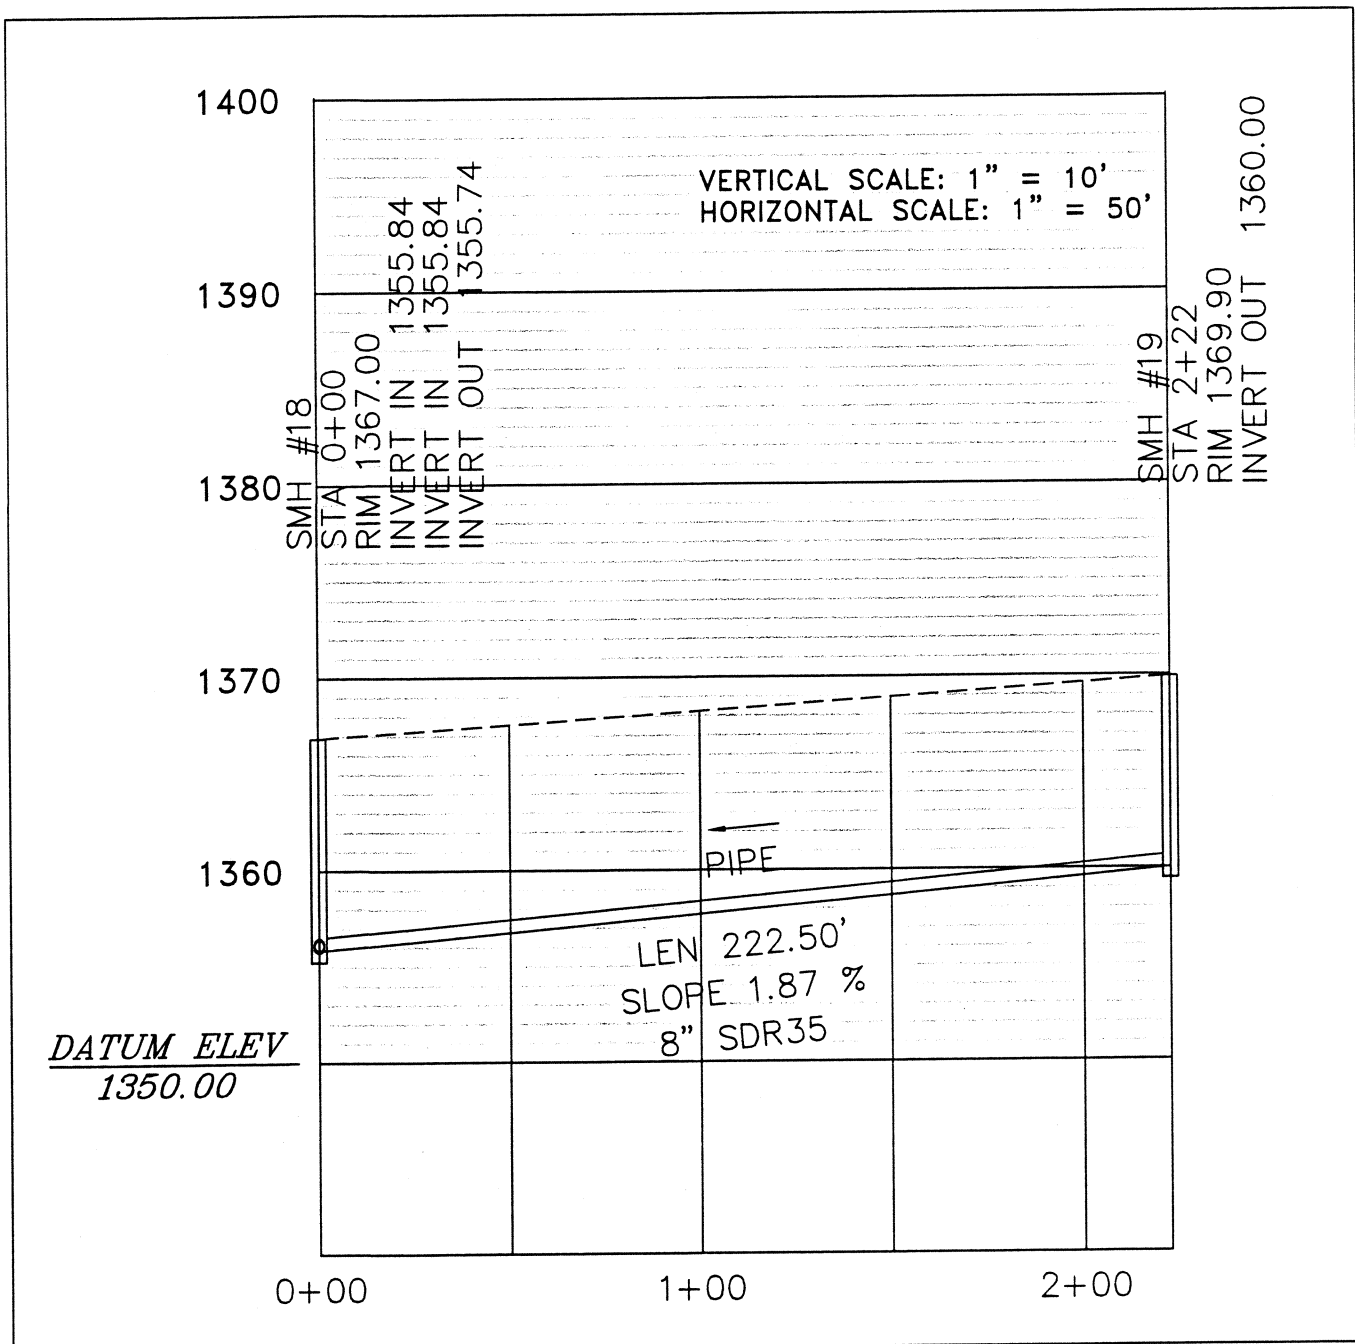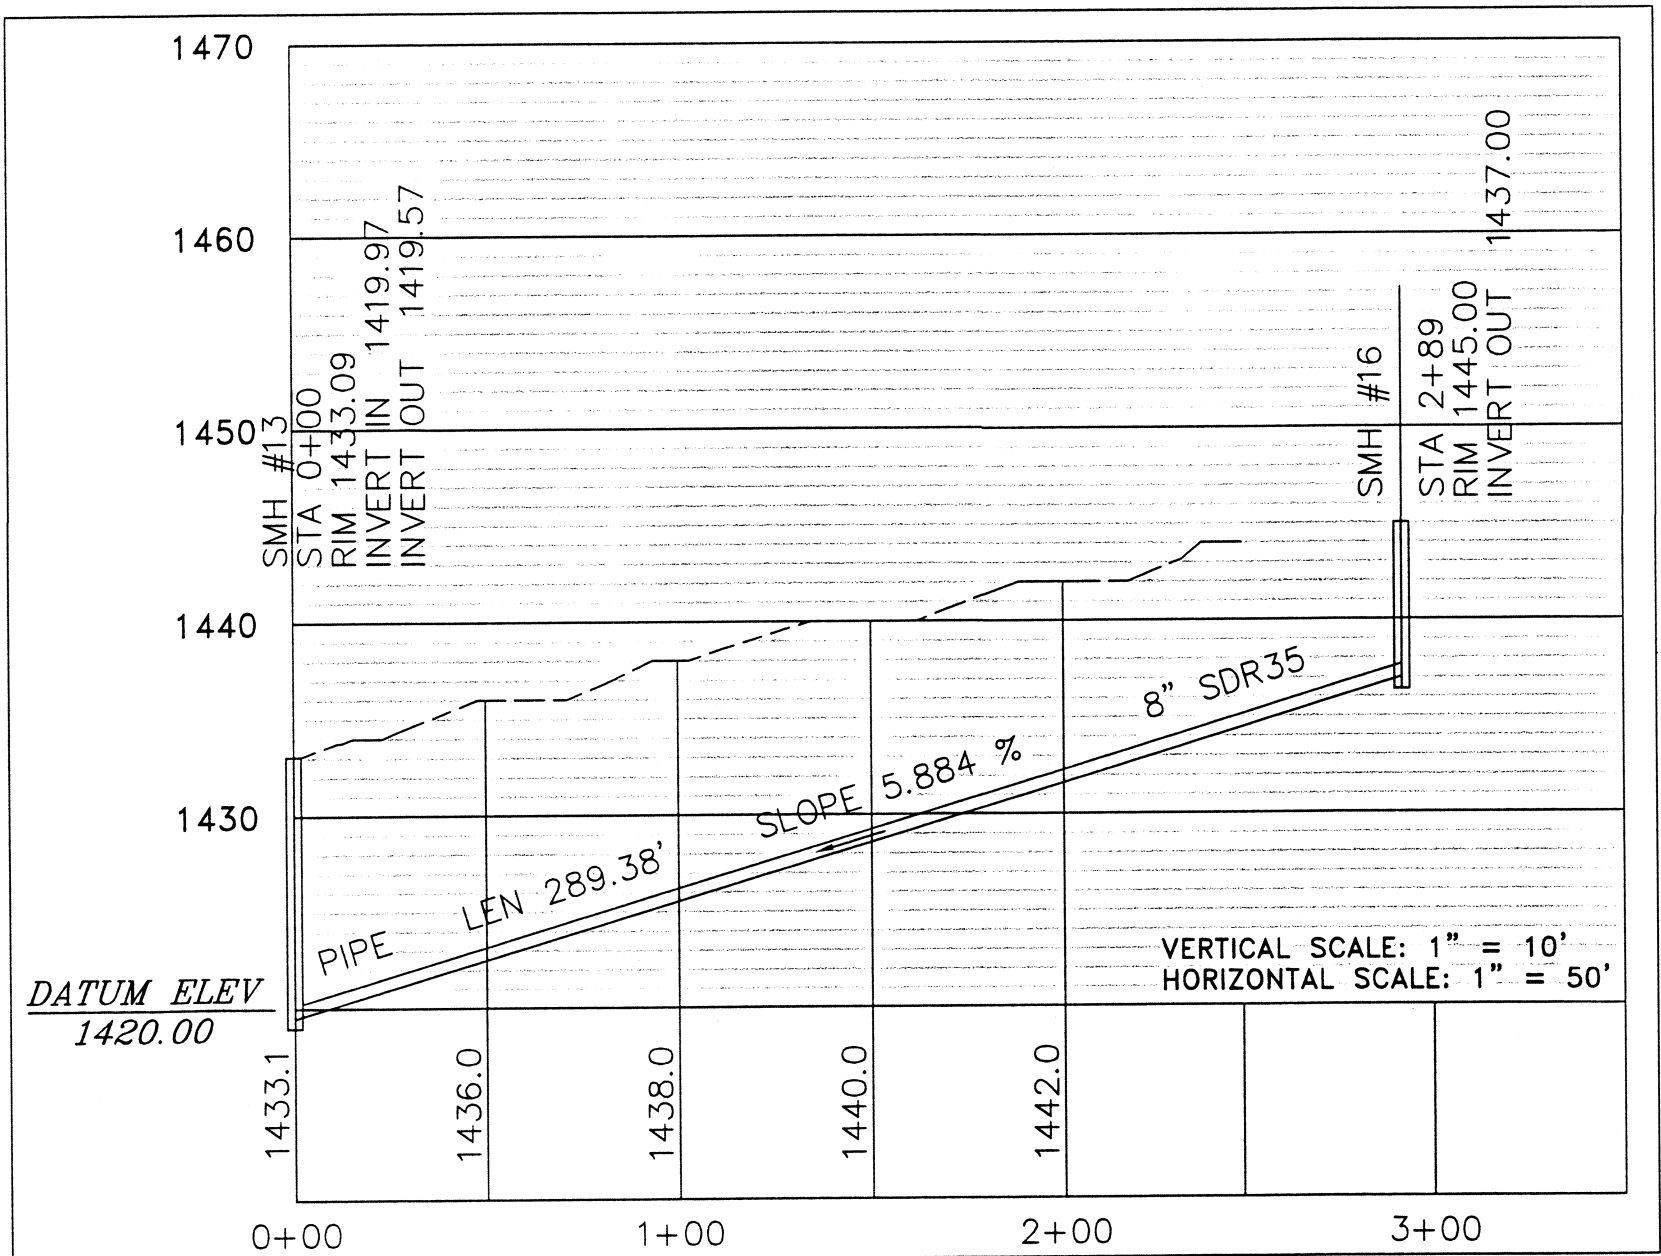

AS-BUILTS