


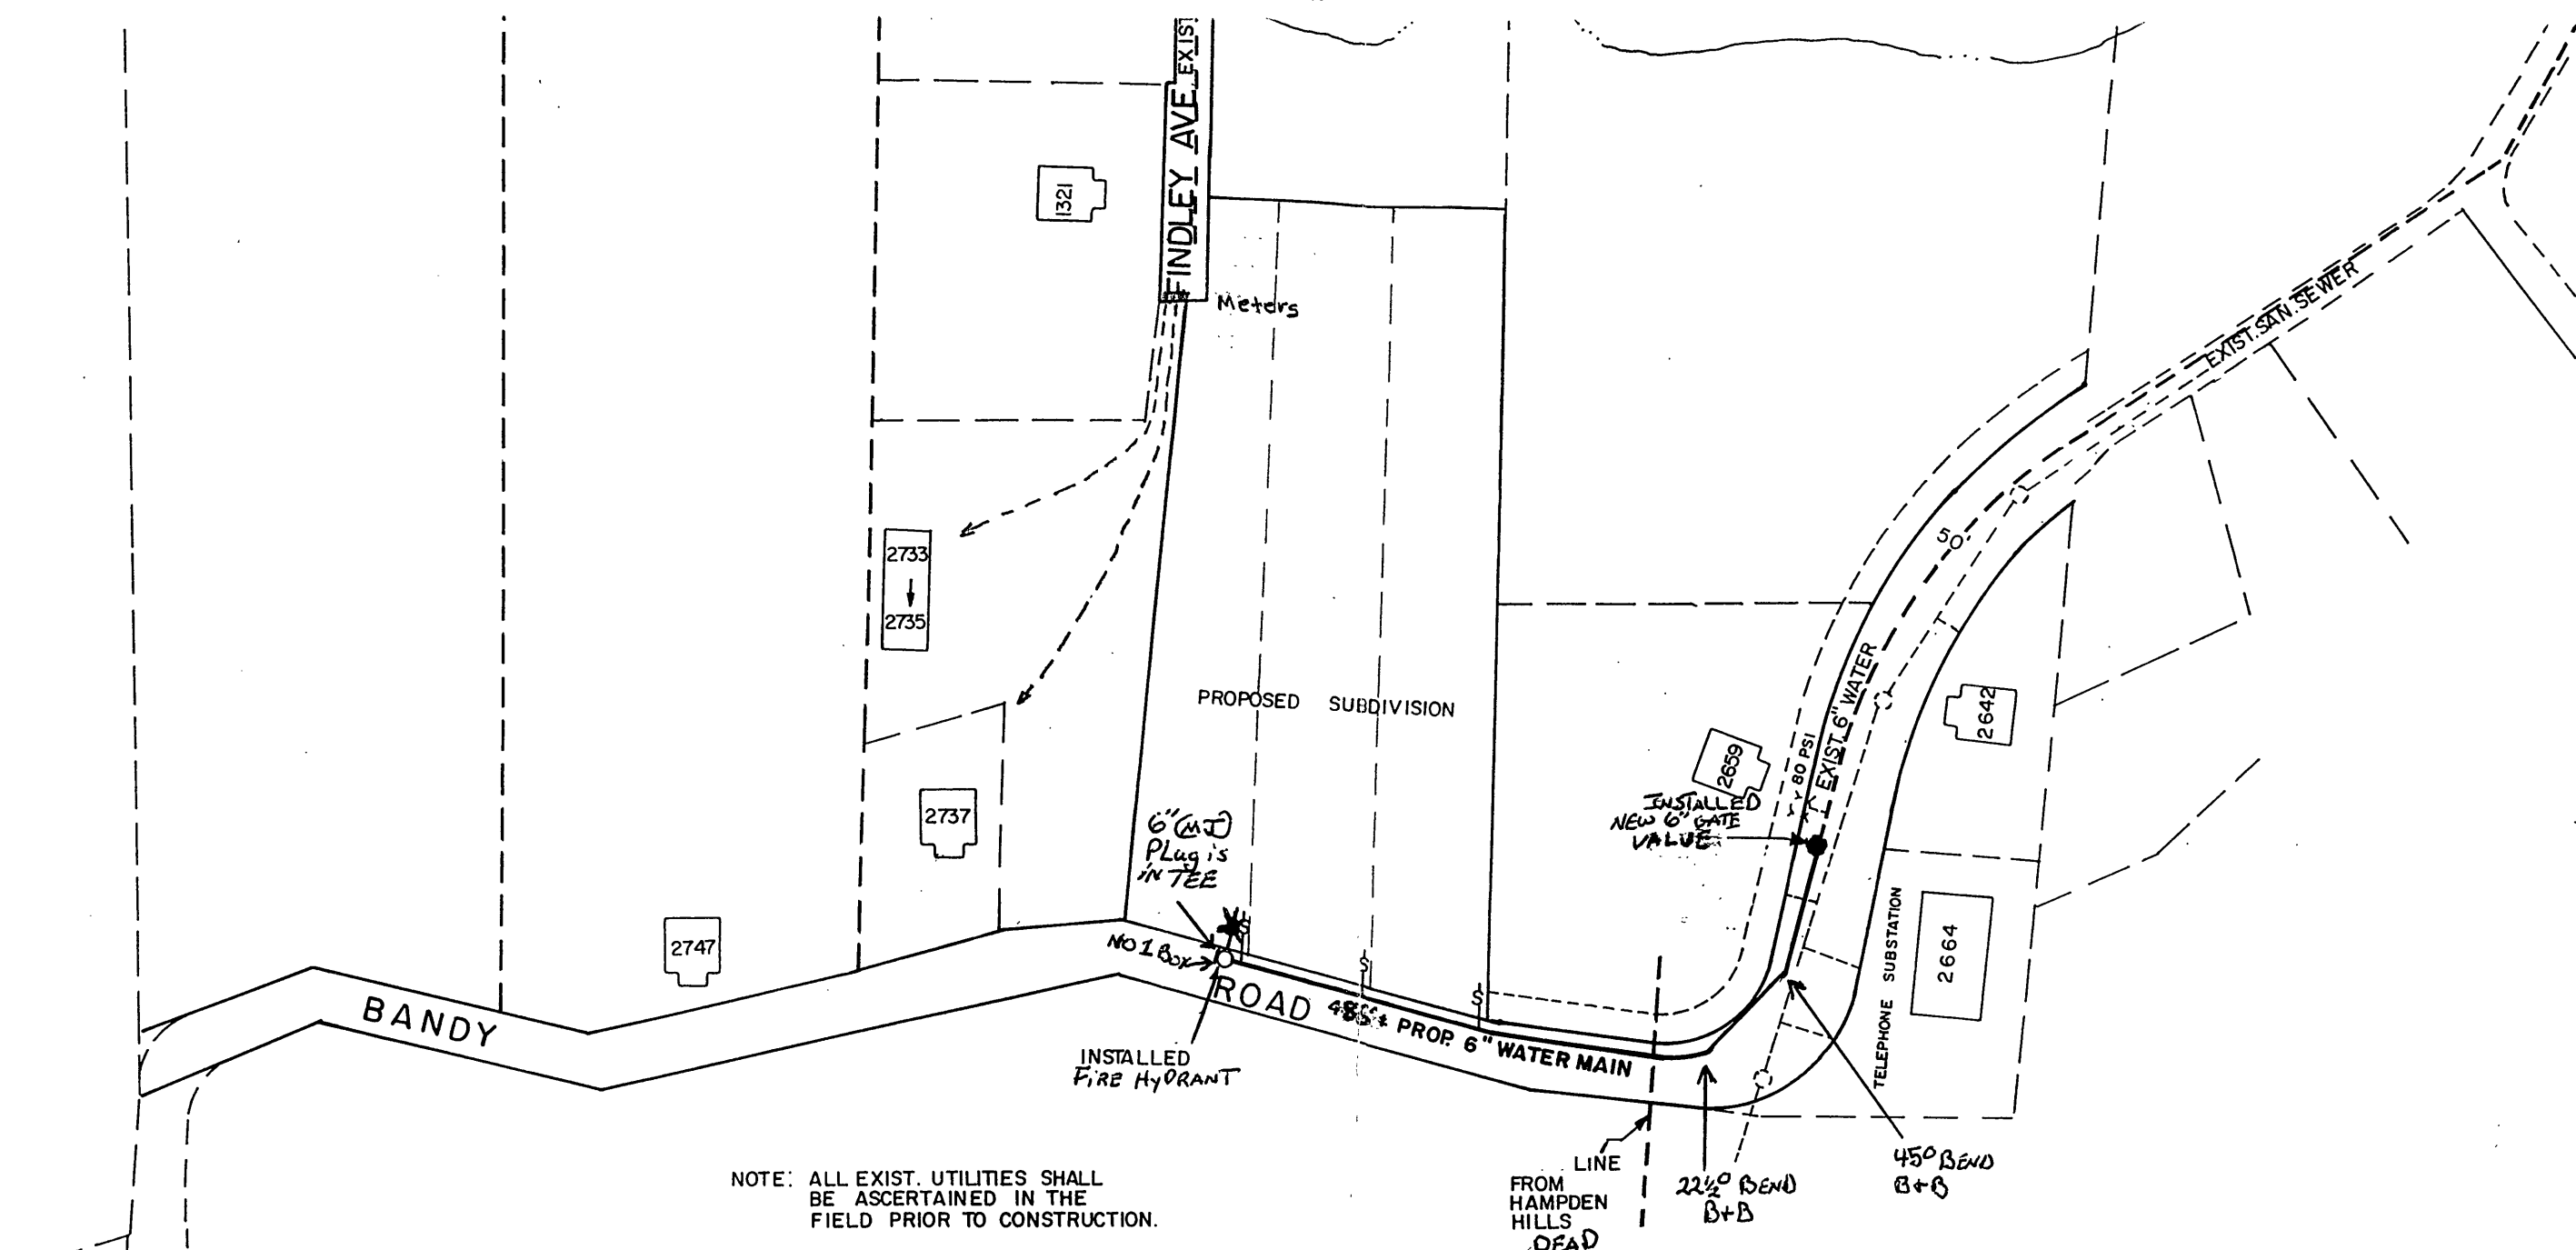

NOTE: ALL EXIST. UTILITIES SHALL BE ASCERTAINED IN THE FIELD PRIOR TO CONSTRUCTION.

DATE STARTED	12-4-98
DATE COMP	12-17-98
FEET MAIN	486'
SIZE	6" 6" L #2
F.H. COMP.	1 4 1/2 6" NO #1
W. STUB	
GEN. INS. BY	
MAIN INS. BY	col
NO. 3/4" SERV	3
CITY OR CO.	CITY
DEPT. INSP.	col

AS BUILT 12-17-98
[Signature]

WATER DEPARTMENT	
ROANOKE	VIRGINIA
2600, 2700 BLK. BANDY ROAD, S.E. HARTMAN EXTENSION	
MANAGER UTILITY LINE SERVICES	SCALE: 1"=100'
<i>[Signature]</i>	DATE: 7/20/95
MANAGER UTILITY LINE SERVICES	DIST. MAP: 426
	PLAN NO.: 98-05
	DIRECTOR UTILITIES & OPERATIONS DATE
	<i>William F. Clark</i> 8-1-95
	DIRECTOR OF PUBLIC WORKS DATE