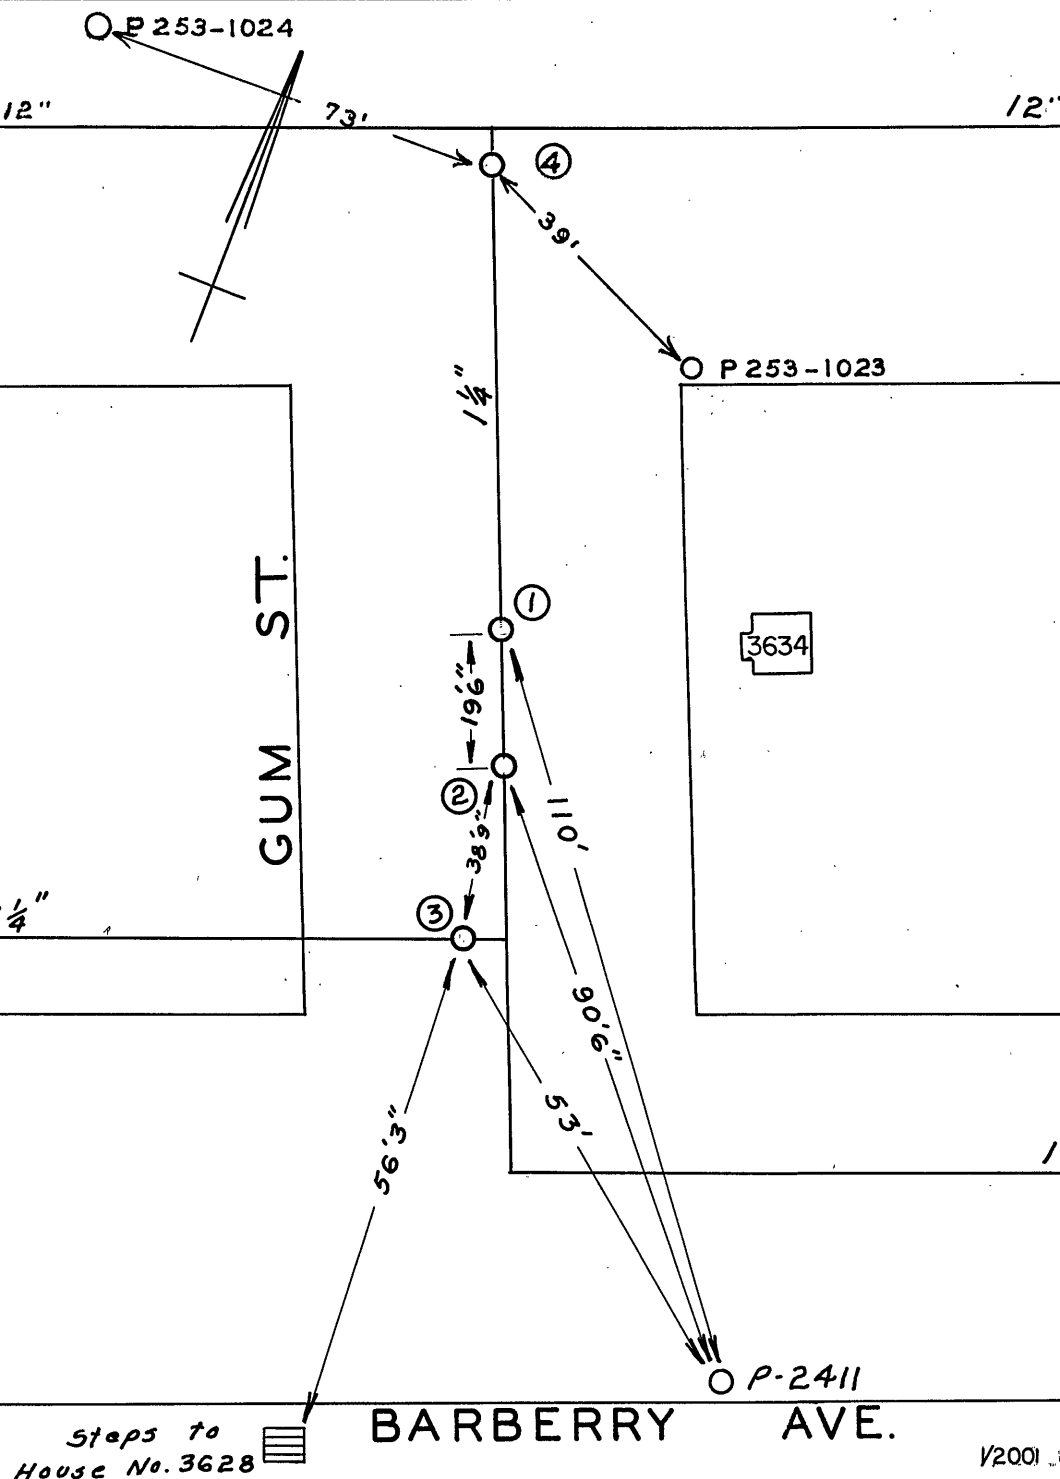


S H E N A N D O A H

AVE.

[illegible]

Gum Street Closed 01/02/1973
ordinance # 20609

CITY OF ROANOKE—WATER DEPT.
VALVE DIAGRAM

BARBERRY AVE. & 104th St.

GUM STREET &

SHENANDOAH AVE.

SEC. MAP 263

N.W.

DATE:

PAGE 10.

"IMPERIAL" TRACING CLOTH.
K & E CO., N. Y.

Steps to
House No. 3628

BARBERRY AVE.

1/2001 JH 011