


482' 1 1/4" Main abandon 10-8-73

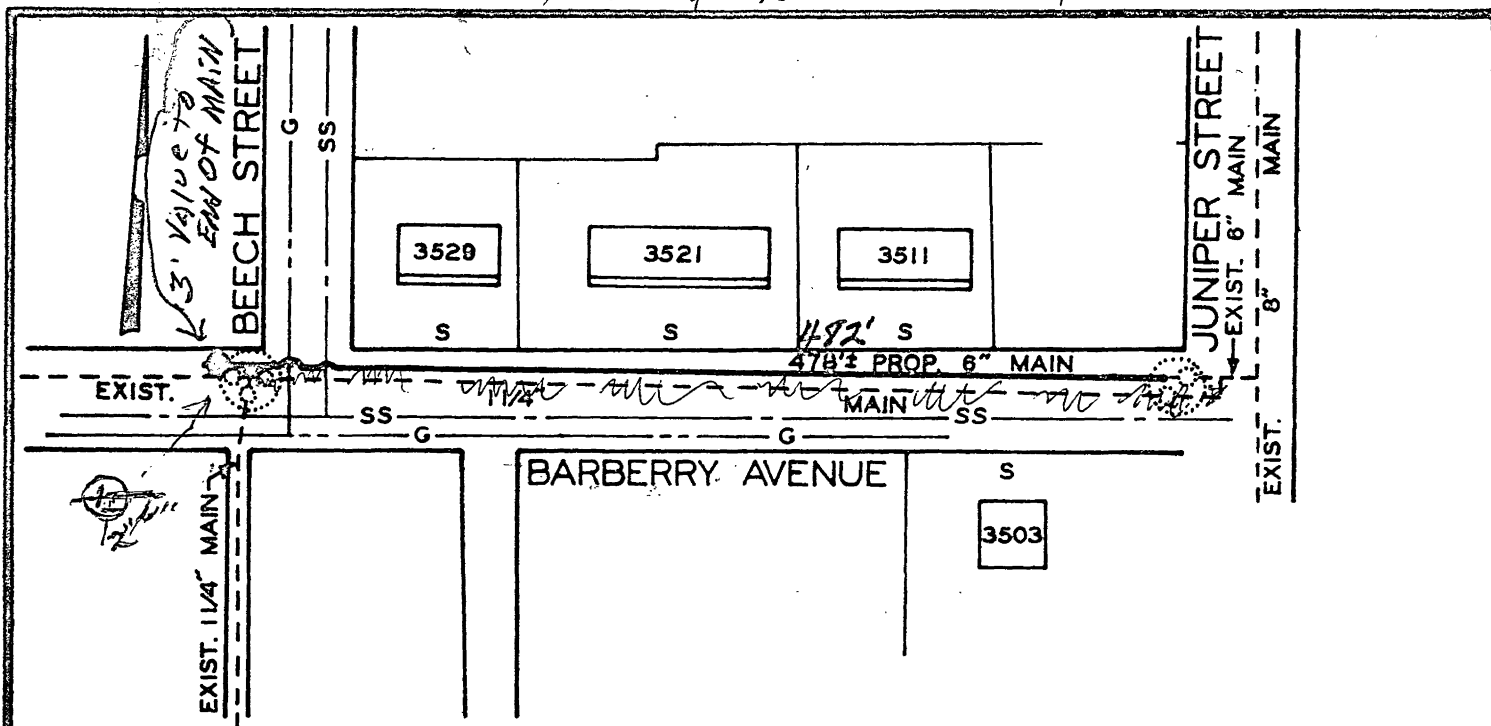

B. O. Bir
 DIRECTOR UTILITIES & OPERATIONS
Charles H. [unclear]
 CITY ENGINEER OF ROANOKE, VA.
Joseph H. Breun
 DIRECTOR OF PUBLIC WORKS

4/23/72
 DATE
8/23/73
 DATE
8/24/73
 DATE

DATE STARTED 9-19-73				
DATE COMP. 9-24-73				
FEET MAIN	SIZE	VALVE	VAULT	BOX
482'	6"	1	1	✓
		1.2"	—	—
F. H. COMP.				
F. H. STUB ONLY				
SERV. INS. BY:				
MAINS INS. BY: <i>P.W. J.</i>				
NO. 3/4" SERV. INS.				
CITY OR CO. —				
DEPT. INSP. <i>J.W.M.</i>				

WATER DEPARTMENT
 CITY OF ROANOKE, VA.
 BARBERRY AVENUE N.W.
 SCALE - 1"=100'
 DRAWN BY C.A.H. AUG. 23, 1973

scanned/linked