


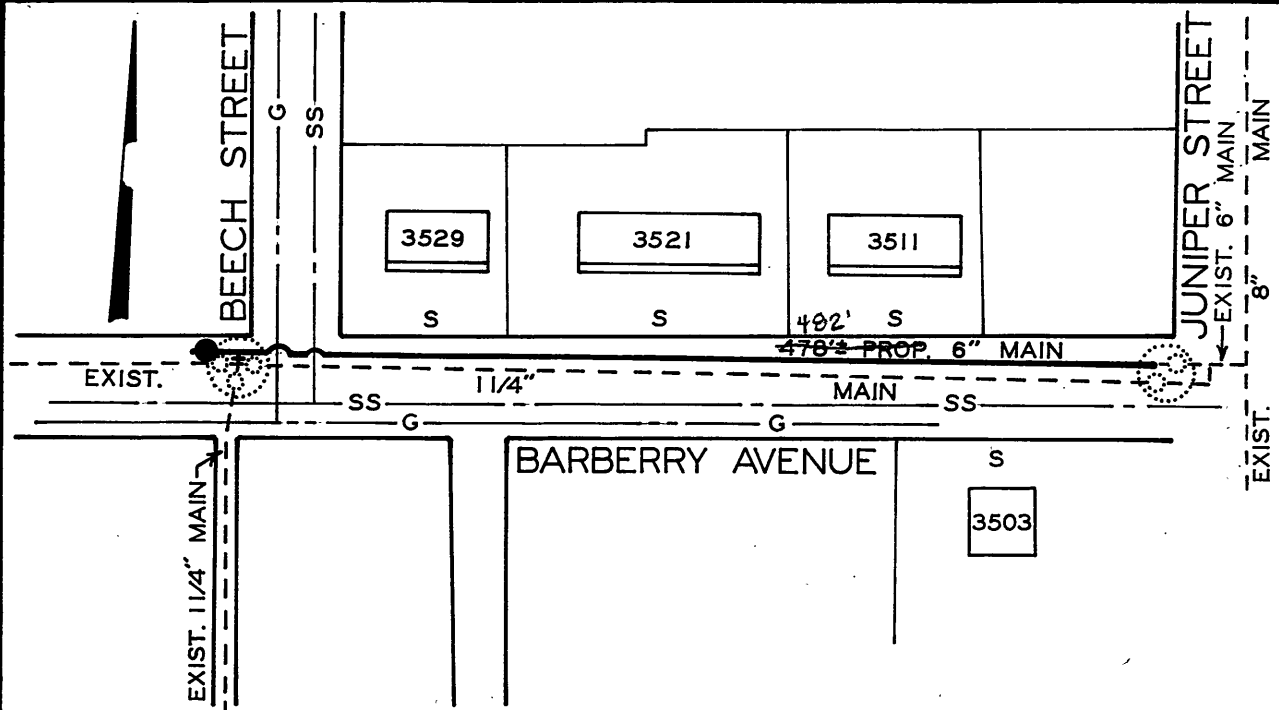

C. O. Bir
DIRECTOR UTILITIES & OPERATIONS

Charles H. Hottel
CITY ENGINEER OF ROANOKE, VA.

James H. Brown
DIRECTOR OF PUBLIC WORKS

4/23/72
DATE

8/23/73
DATE

8/24/73
DATE

1 1/4" main abandoned 10/08/1973

DATE STARTED <i>9-19-73</i>				
DATE COMP. <i>9-24-73</i>				
FEET MAIN	SIZE	VALVE	VAULT	BOX
<i>482'</i>	<i>6"</i>	<i>1</i>	<i>1</i>	<i>✓</i>
		<i>1.2"</i>	<i>—</i>	<i>—</i>
F. H. COMP.				
F. H. STUB ONLY				
SERV. INS. BY:				
MAINS INS. BY: <i>PWJ</i>				
NO. 3/4" SERV. INS.				
CITY OR CO. <i>—</i>				
DEPT. INSP. <i>JWM</i>				

WATER DEPARTMENT
CITY OF ROANOKE, VA.
BARBERRY AVENUE N.W.
SCALE - 1"=100'
DRAWN BY C.A.H. AUG. 23, 1973