


1. The first part of the paper is a review of the literature on the effects of the 1997 Asian financial crisis on the economies of the Asian countries. It shows that the crisis had a significant negative impact on the growth of the Asian economies, and that the impact was more severe in the countries that had a higher degree of financial liberalization.

3529

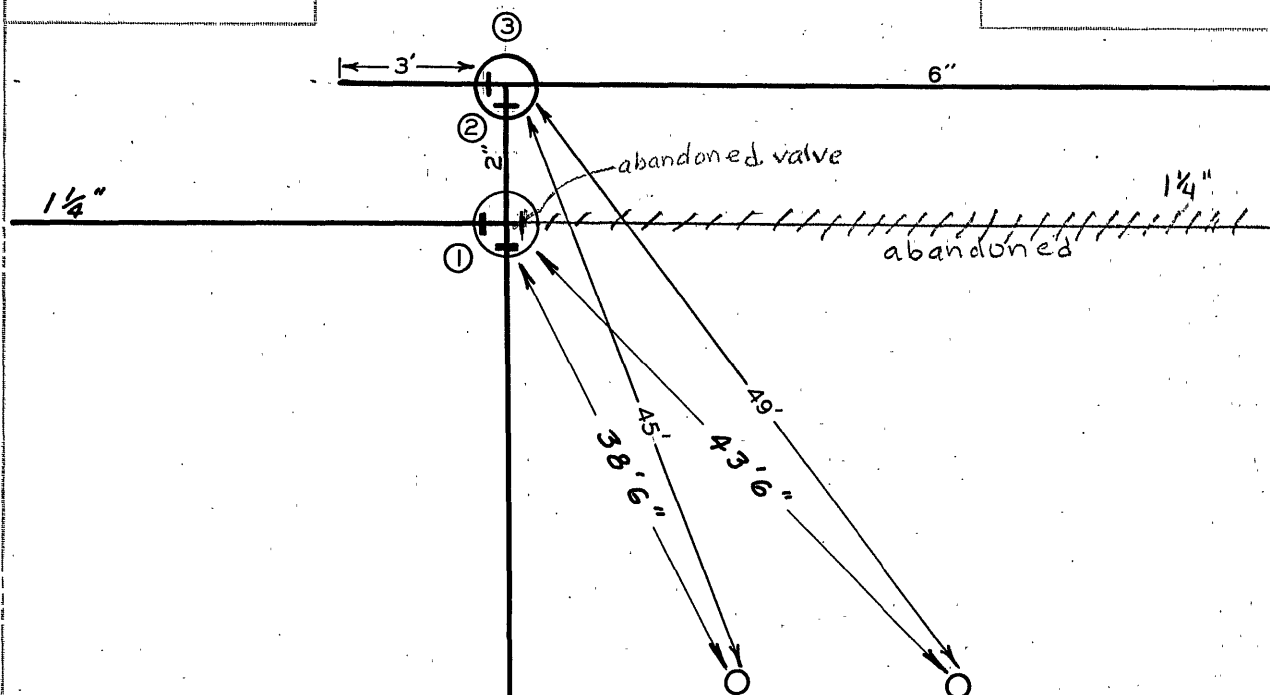

BARBERRY

STREET MARKER AVE. P-253-1020

3536

ALLEY

 $\frac{1}{2}$ "

10/2000 JK

[illegible]

CITY OF ROANOKE—WATER DEPT
VALVE DIAGRAM

BARBERRY AVENUE &
BEECH STREET

SEC. 263

N. W.

DATE

PAGE NO.