
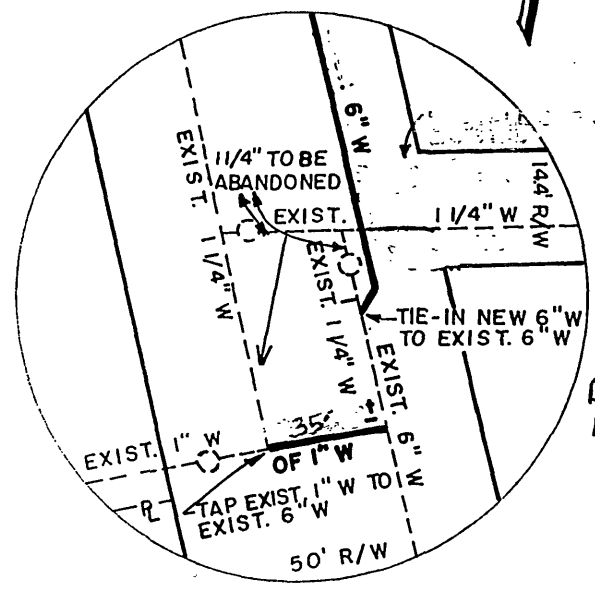


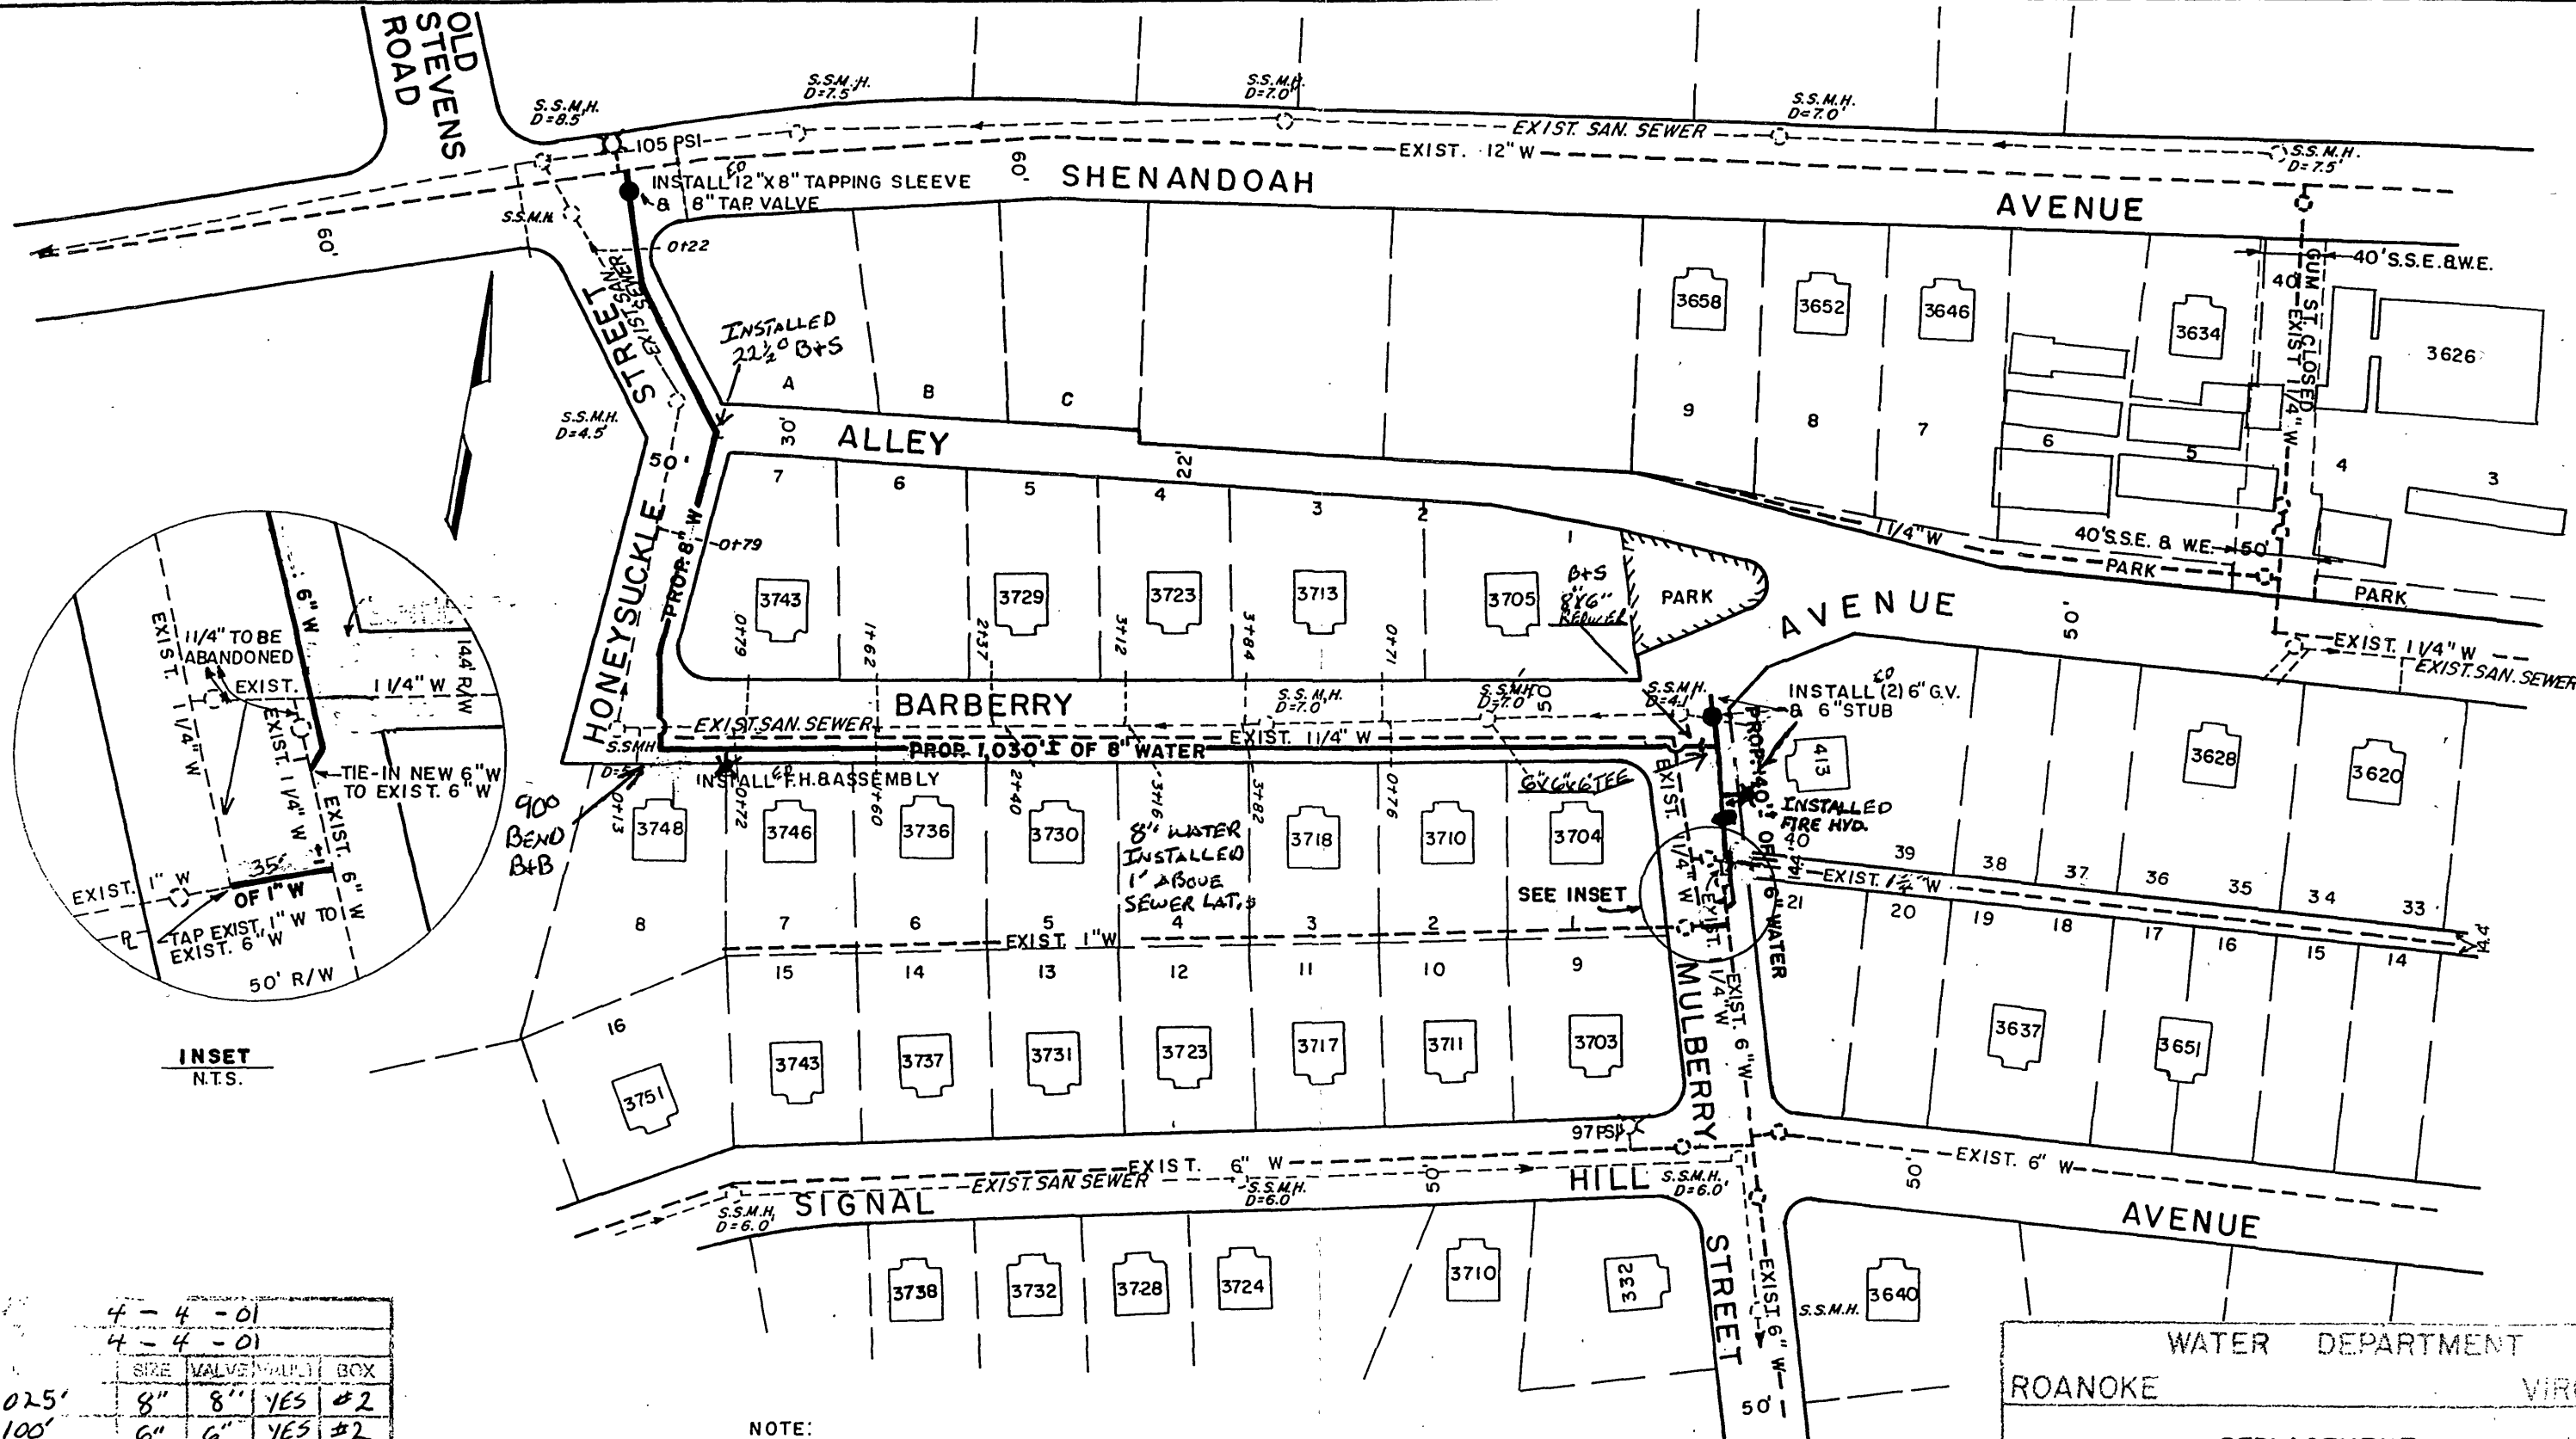

INSET
N.T.S.

4 - 4 - 01	SIZE	VALVE	DEPTH	BOX
4 - 4 - 01	8"	8"	YES	#2
1025'	8"	8"	YES	#2
100'	6"	6"	YES	#2
2	1 1/4"	6"	YES	#2
	1 1/4"	6"	YES	#2

City
CUL - CULS

NOTE:
LOCATION OF ALL UTILITIES
SHALL BE ASCERTAINED IN
FIELD PRIOR TO CONSTRUCTION.
ALL 1 1/4" ON BARBERRY
3700 BLOCK ABANDONED

As Built
[Signature]
4/4/01

MANAGER OF WATER DEPARTMENT
[Signature] 2-28-01
ACTING MANAGER OF UTILITY LINE SERVICES

WATER DEPARTMENT	
ROANOKE	VIRGINIA
REPLACEMENT BARBERRY AVENUE, HONEYSUCKLE STREET, MULBERRY STREET, N.W.	
SCALE: 1" = 100'	DIRECTOR OF PUBLIC WORKS
DATE: 2/22/2001	DIRECTOR OF UTILITY SERVICES
DIST. MAP: 263,272	
PLAN NO: 01-01	