
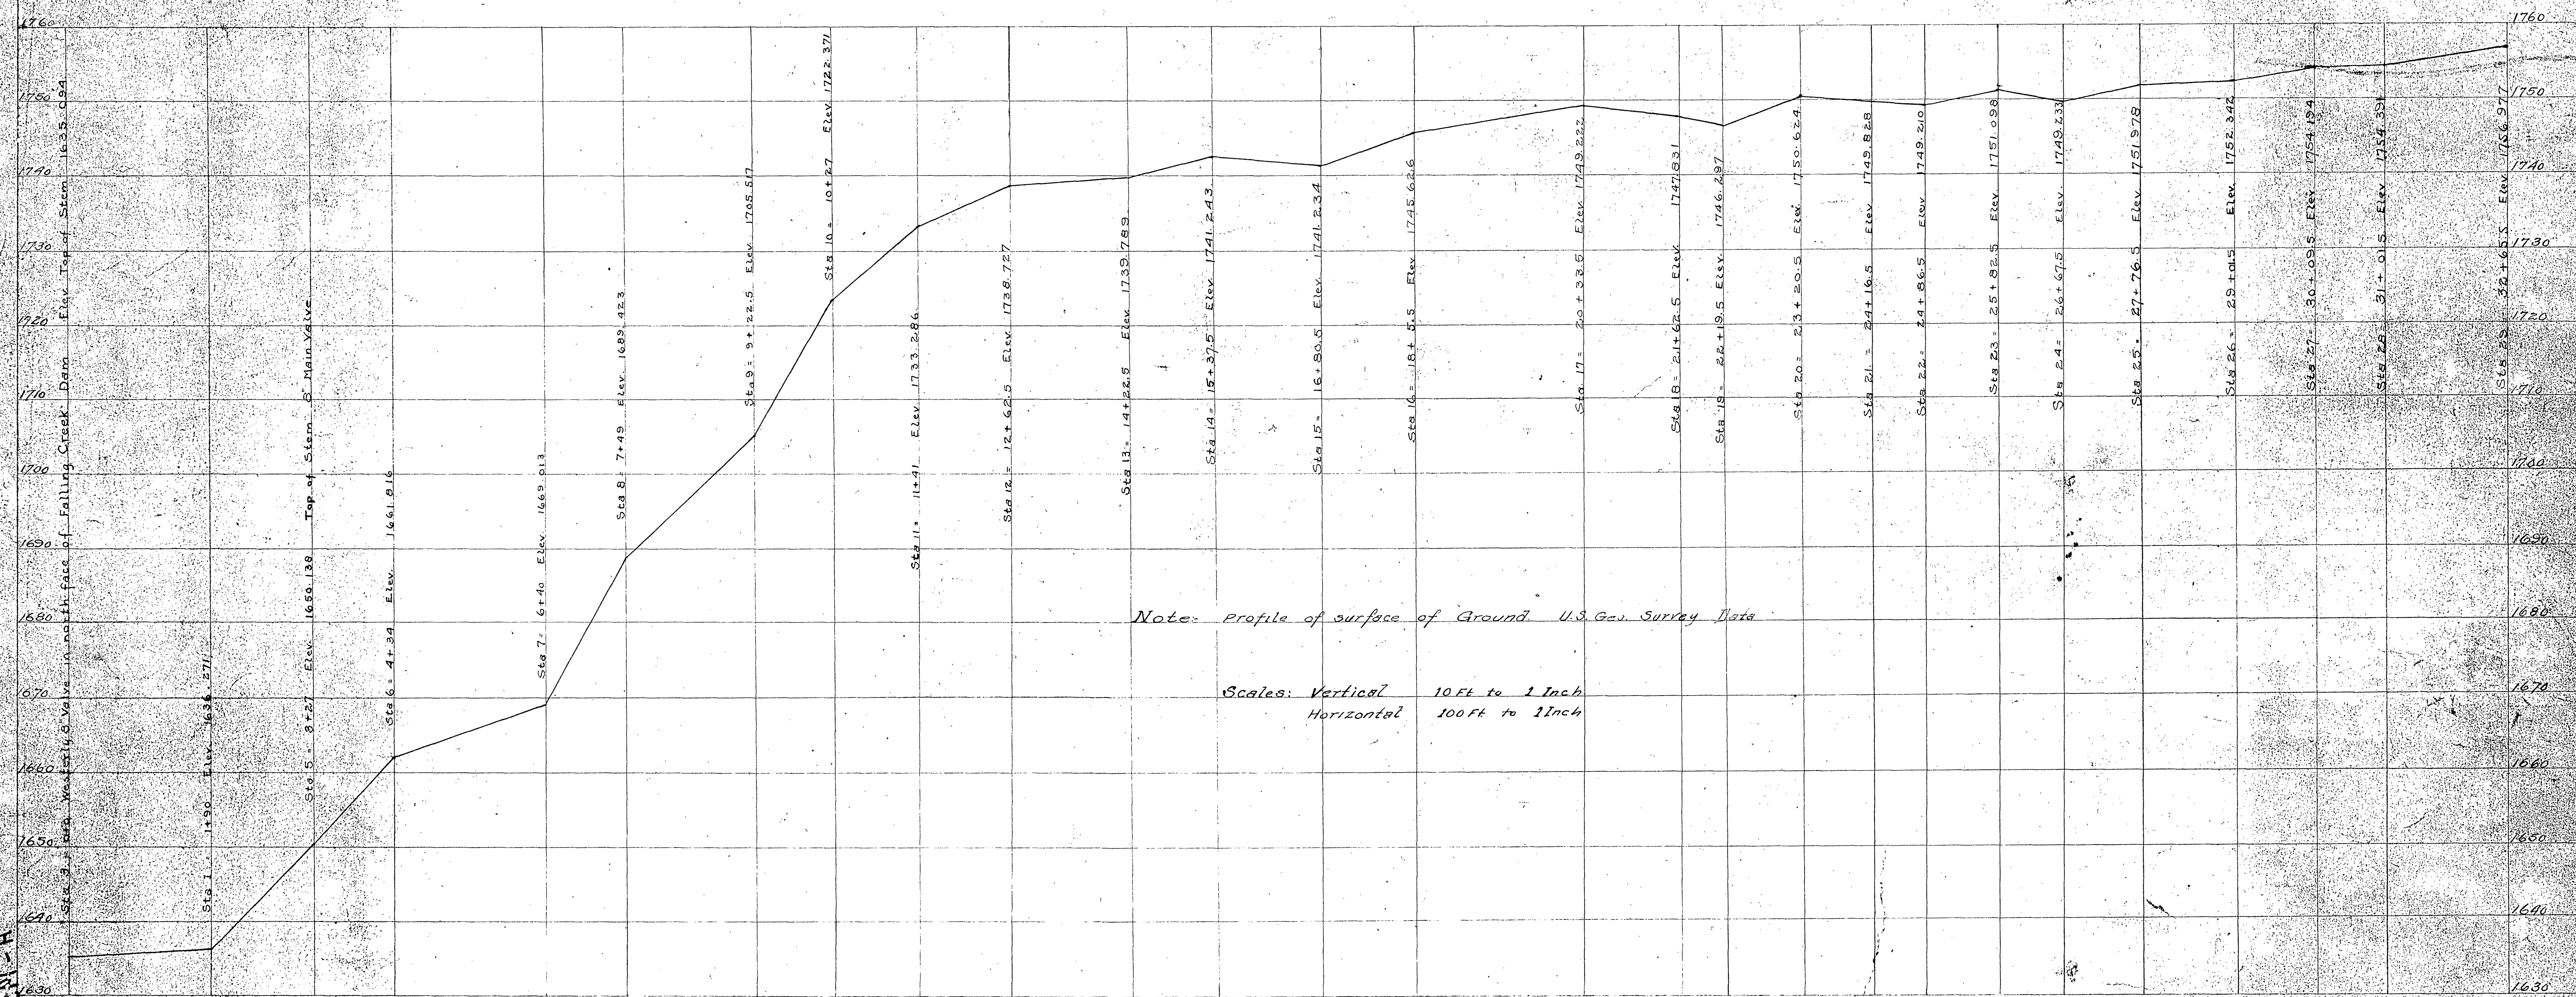


281-H

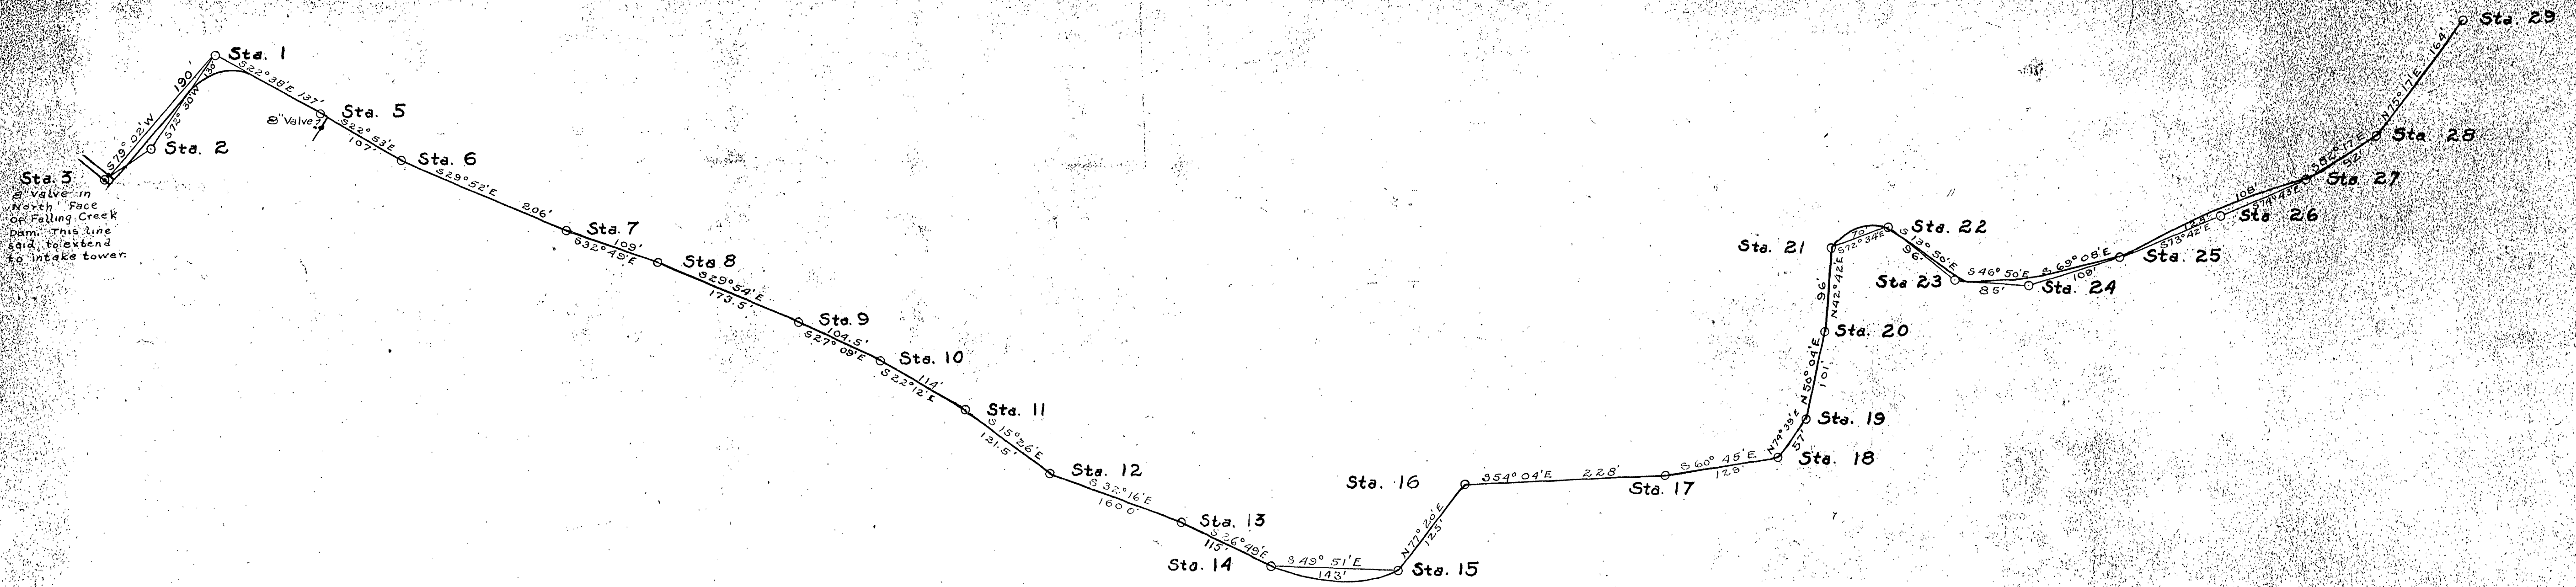

Note: Profile of surface of Ground U.S. Geo. Survey Data

Scales: Vertical 10 Ft. to 1 Inch
Horizontal 100 Ft. to 1 Inch

- Notes:
1. U.S. Geo. Datum Plane used.
 2. Sta. 2 same as 56 on 10' Line survey.
 3. Red line is survey line run by Chas. E. Moore R.D. Stoner April 1919.
 4. Black line is line of 5' Main.

F3-D3
118

SECTION 1

GRAVITY SUPPLY MAIN
FROM BEAVER DAM TO
FALLING CREEK RESERVOIR
VINTON-ROANOKE WATER CO.
ROANOKE, VIRGINIA
SCALE 100'-1" DATE 10-3-19
DRAWN BY [Signature] ISSUED [Signature]
TRACED BY [Signature]