



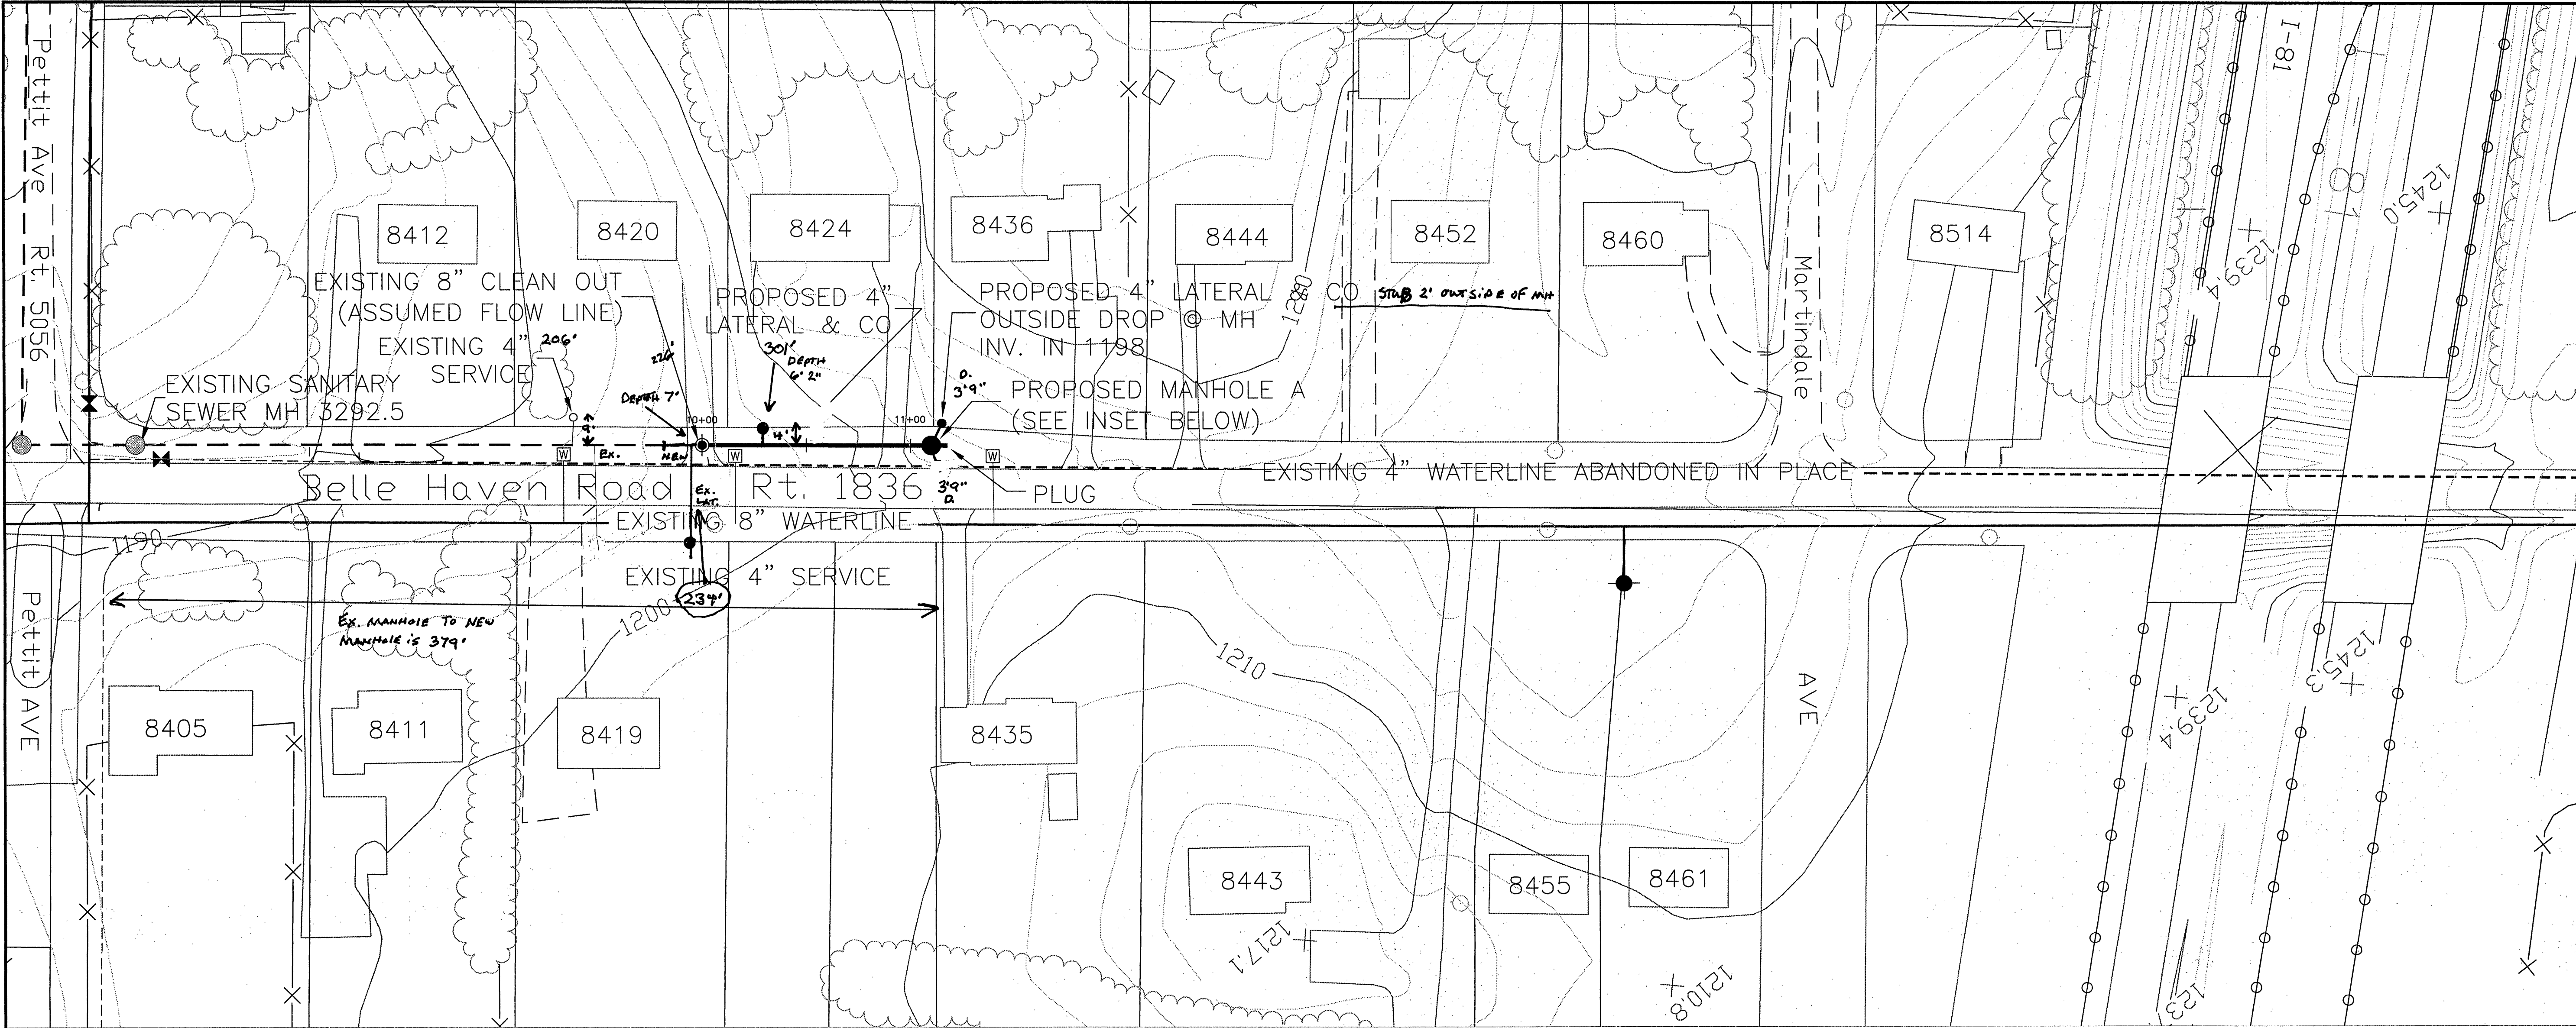

NOTES:
* Contractor to field verify slope of existing line from existing ss manhole #3292.5 to existing cleanout located at STA. 10+00.


Contractor to remove existing cleanout and maintain grade to proposed manhole A.

As Built
4-11-07

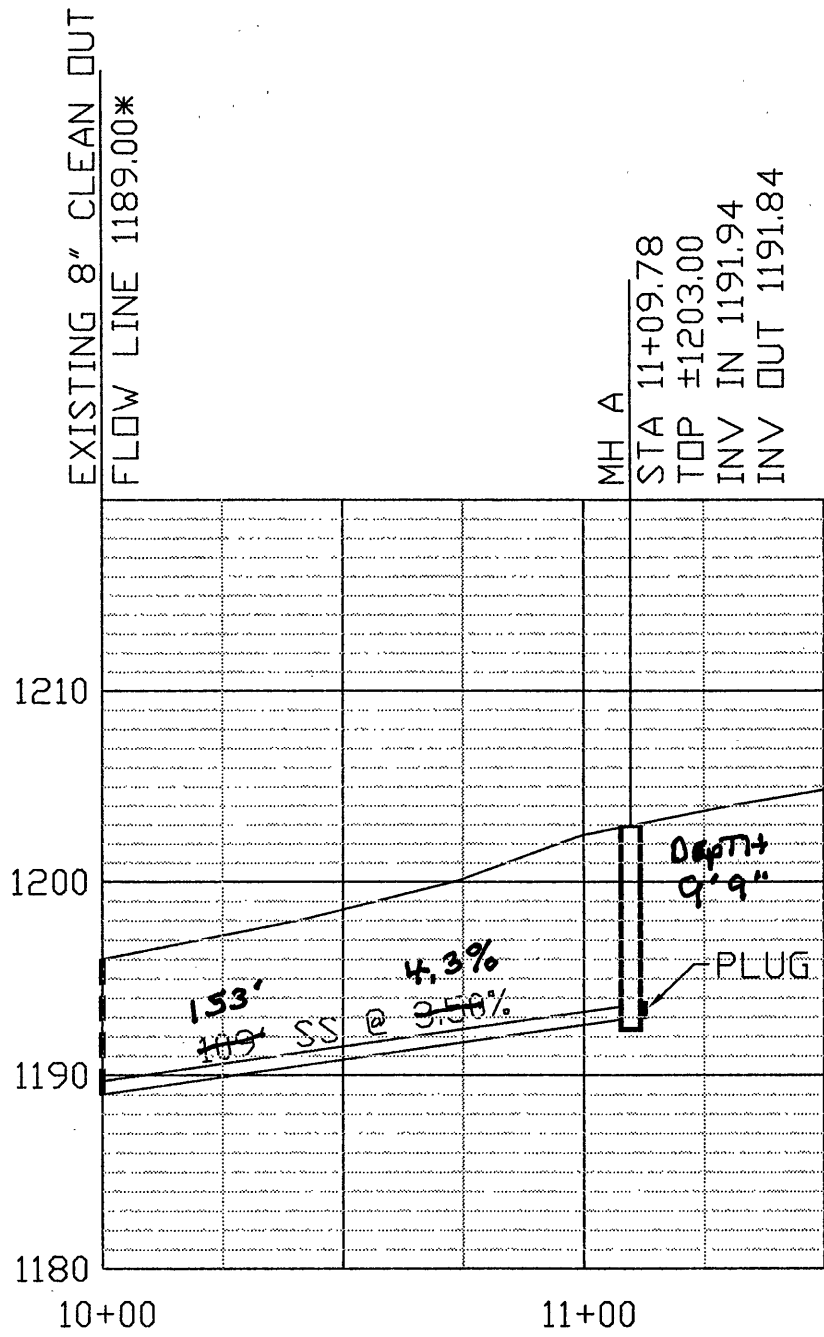

PROFILE

Scale: 1" = 40' hor
1" = 10' vert

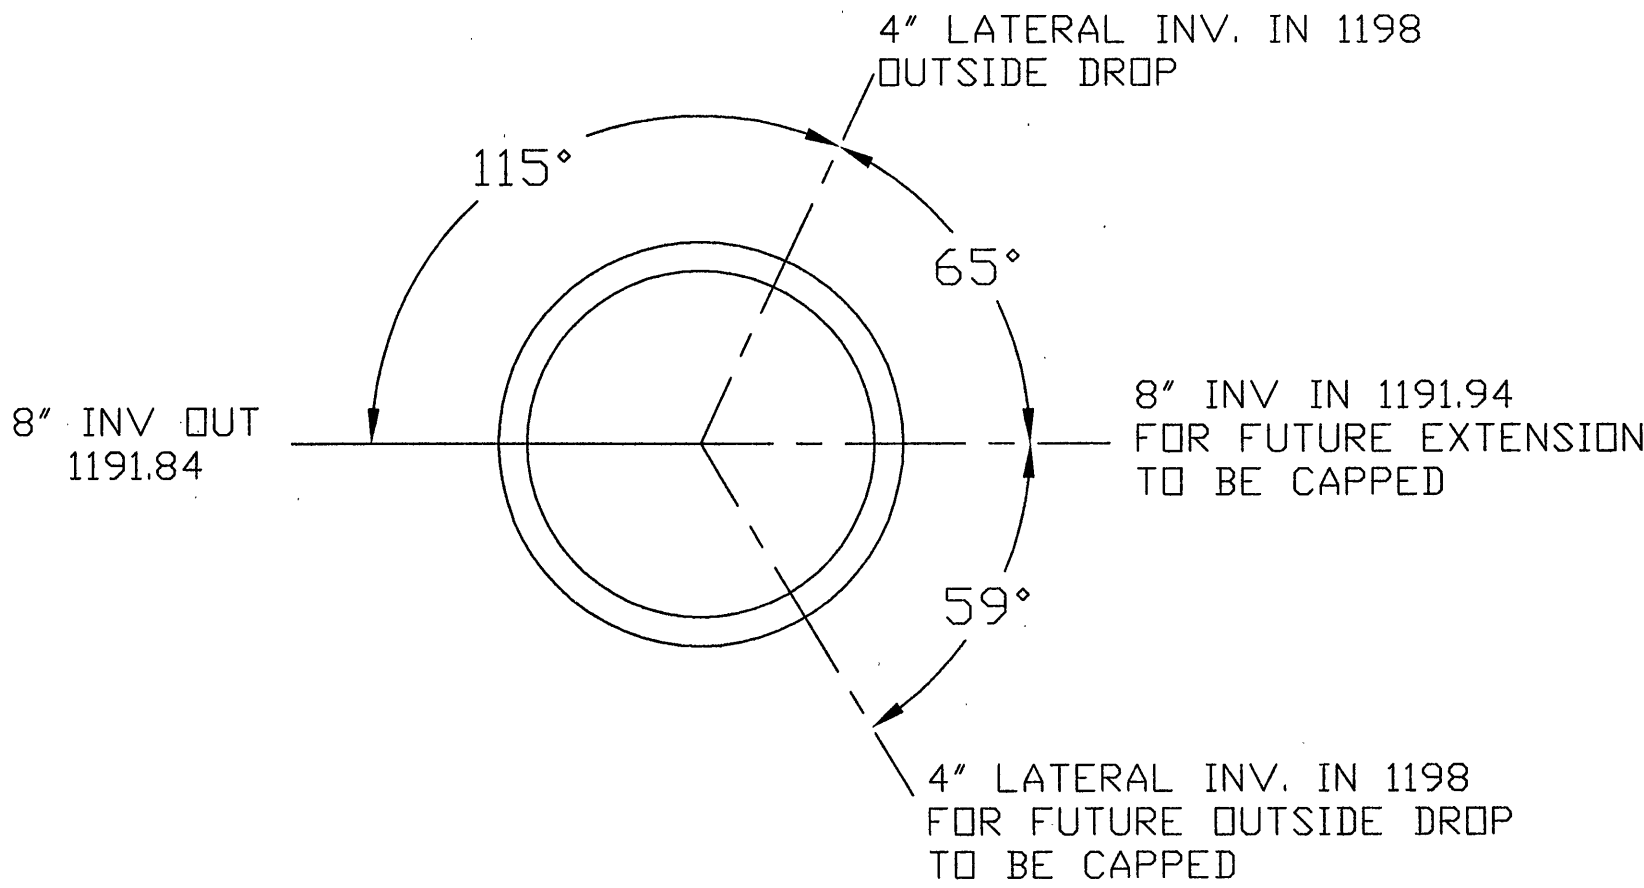


PROPOSED MANHOLE A

AS - BUILT

WWW.ID#8YVGKV

ENGINEERING SERVICES

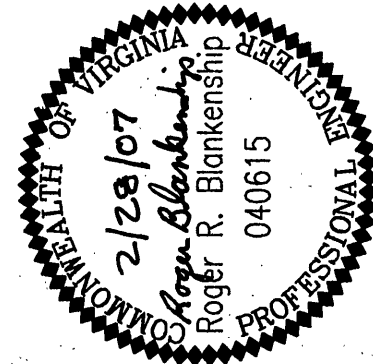

BELLE HAVEN ROAD SANITARY
SEWER EXTENSION PROJECT

Designed By:	RRB
Drawn By:	RRB
Checked By:	JGR
Date:	02/16/07
Scale:	1"=40'
Plan #:	00-00
Sheet:	1 OF 1

BELLE HAVEN - 84008LK