



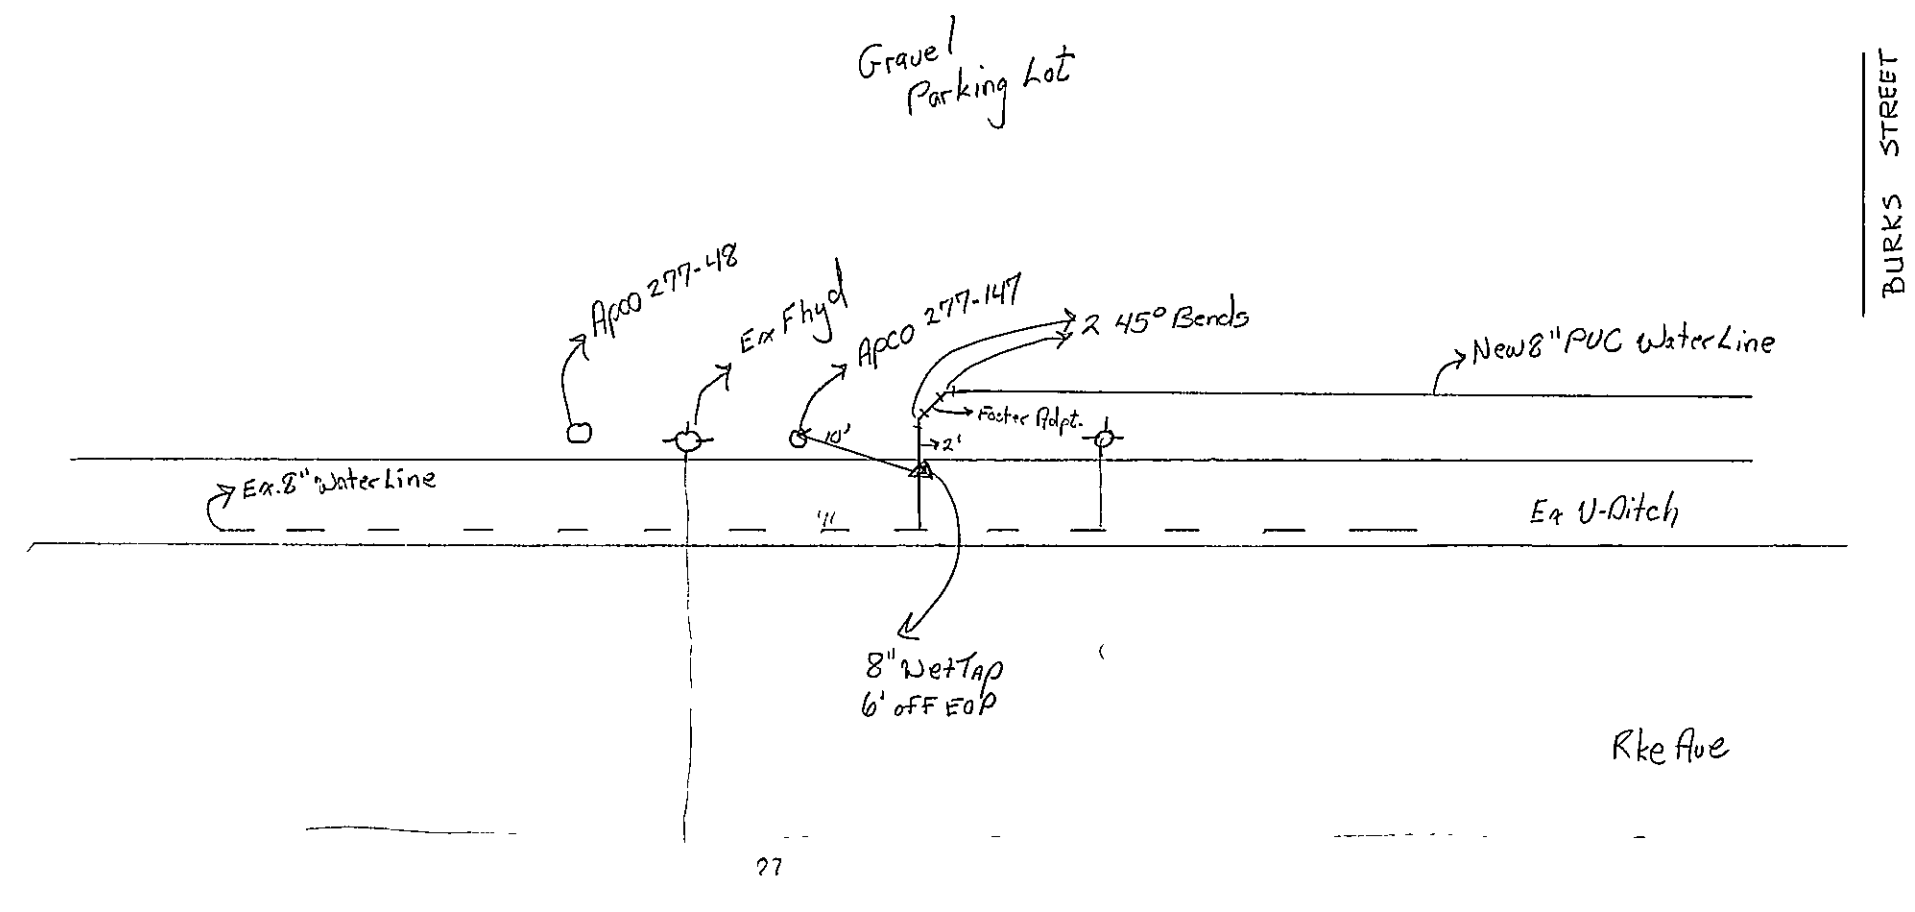


2837  
ROANOKE  
AVE.

GPSed Wet Top Valve  
8-23-05



Alzo Nobel  
Plant

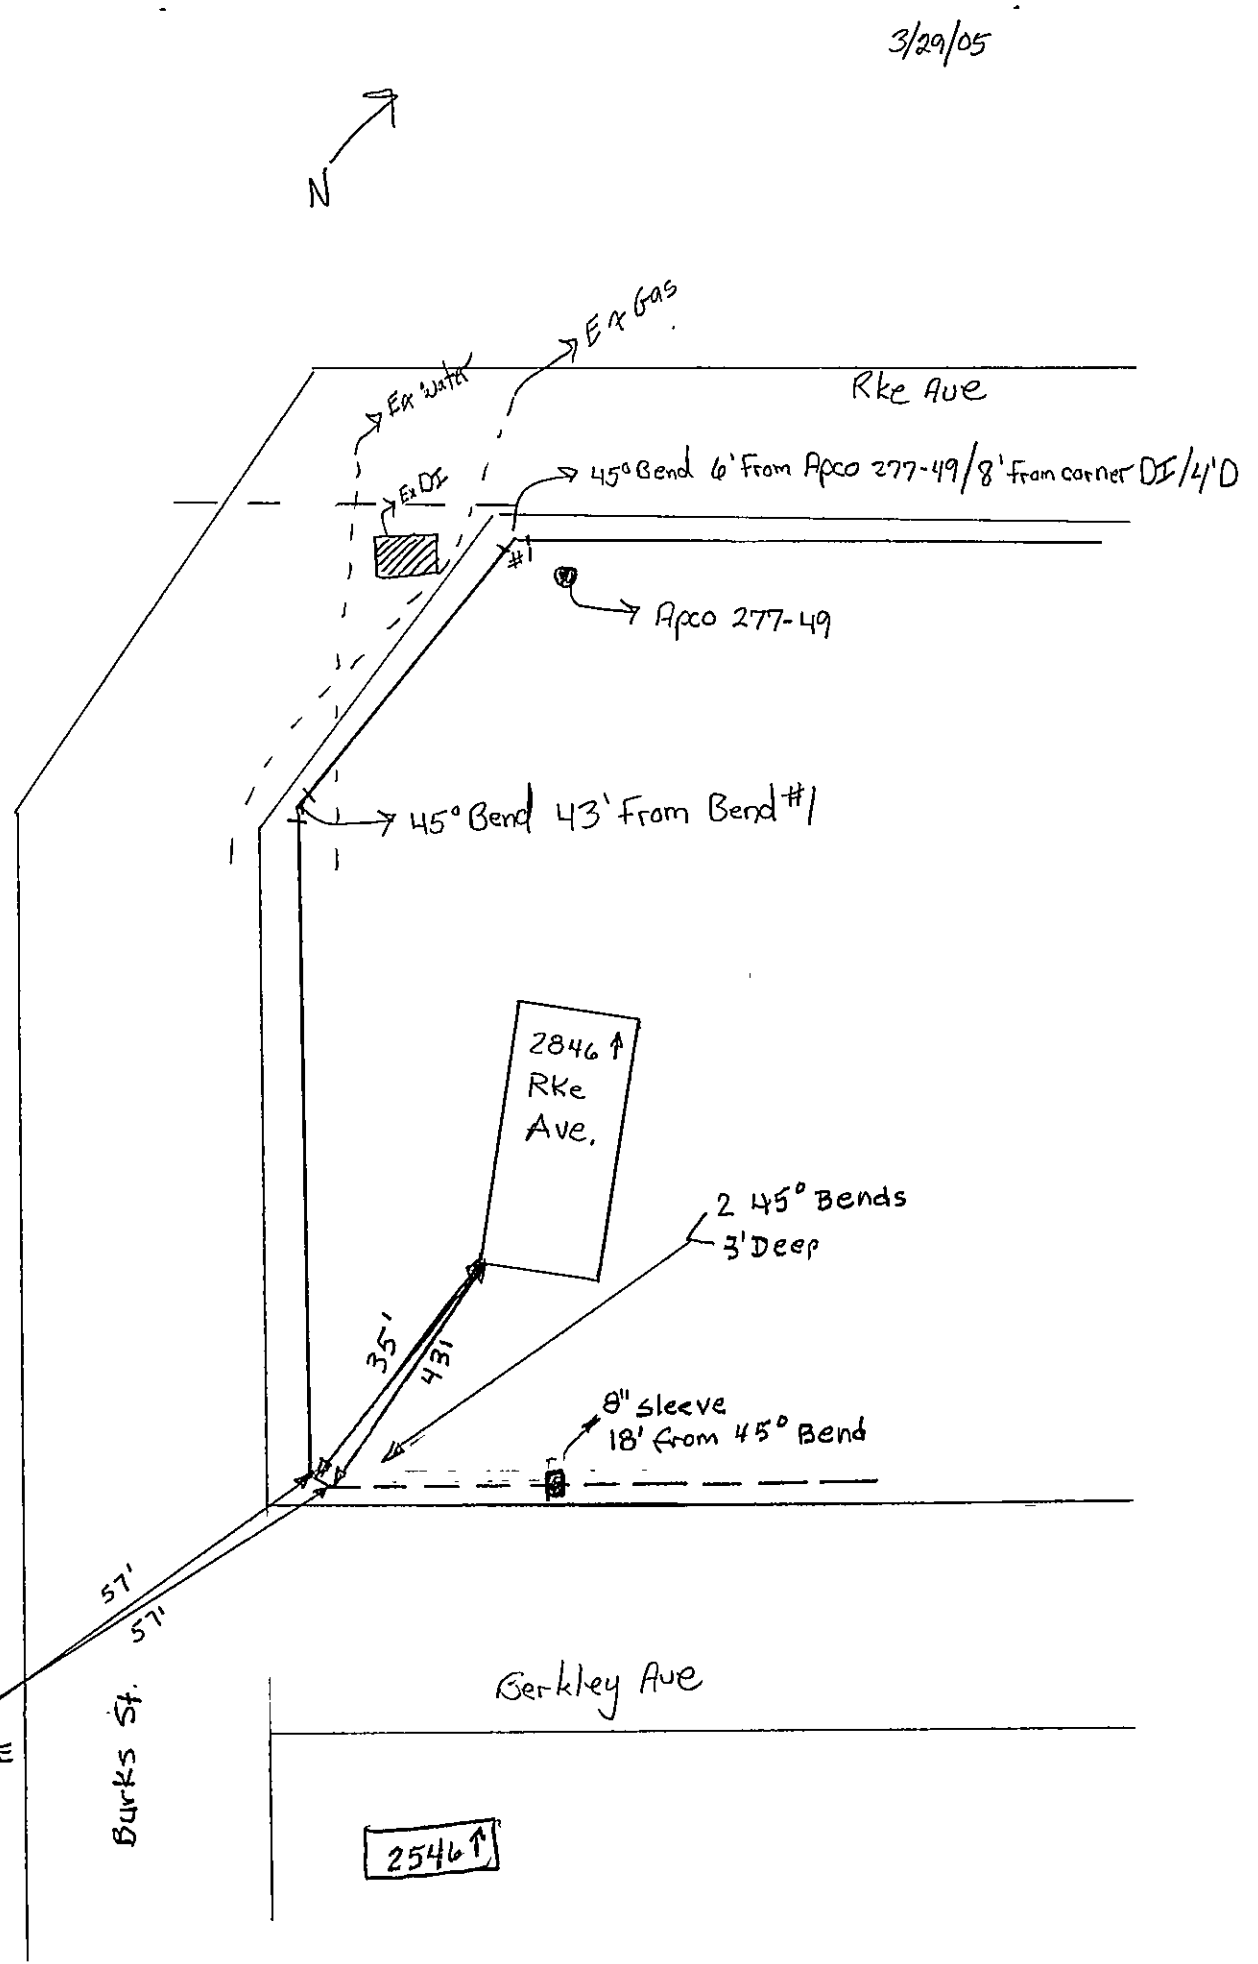

2546

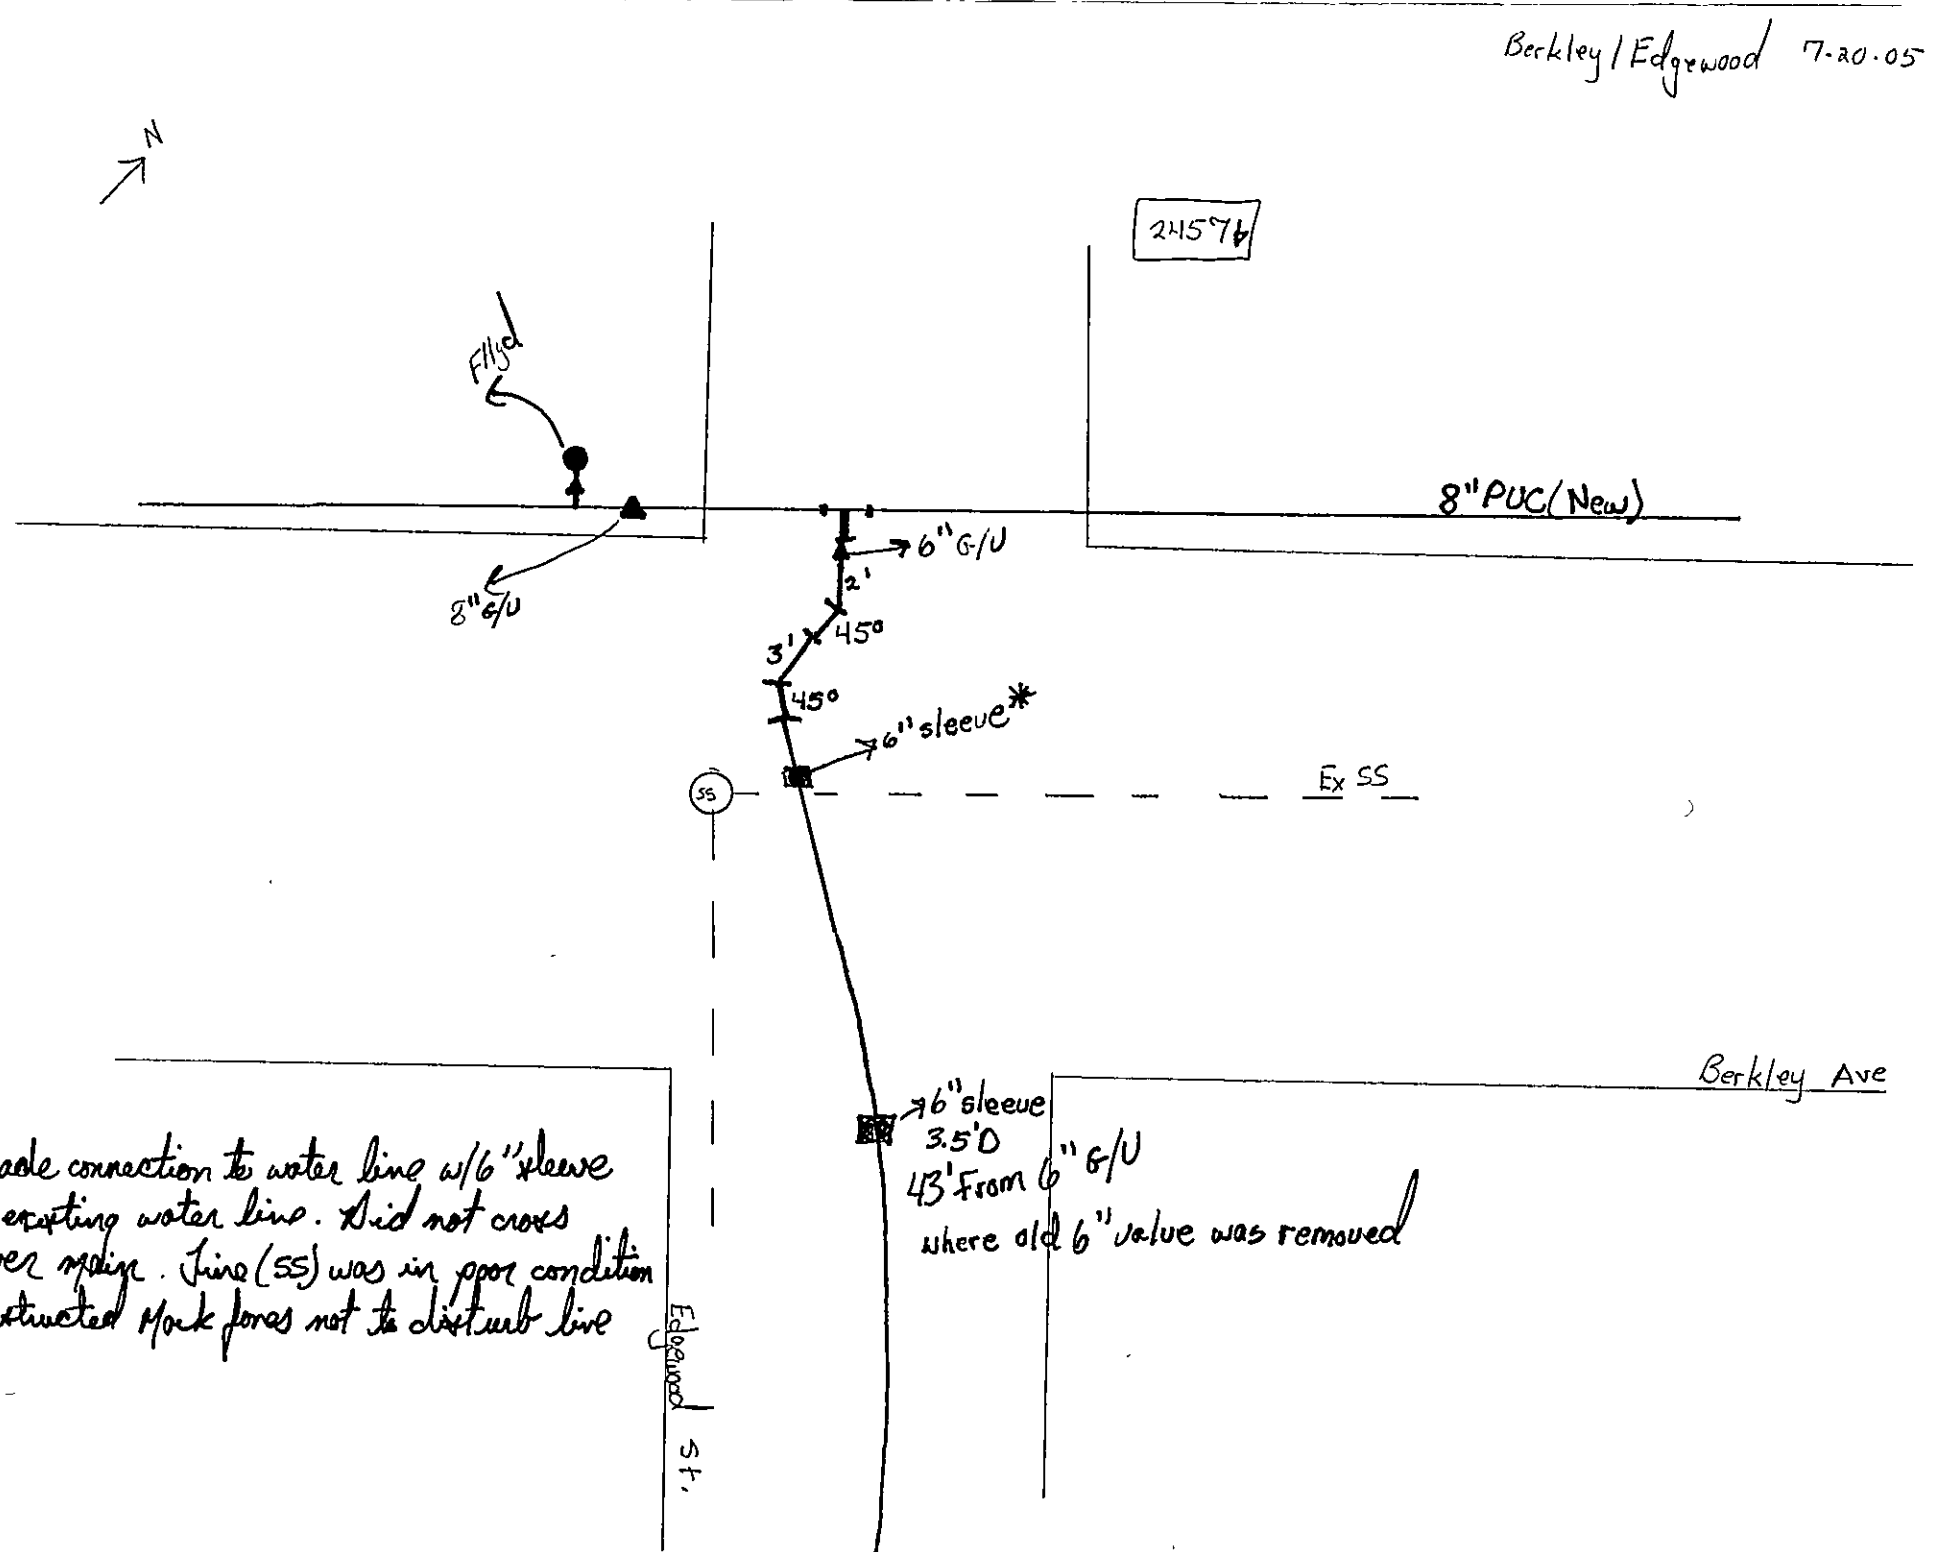

\* made connection to water line w/ 6\" sleeve  
to existing water line. Did not cross  
fence again. (line (SS) was in poor condition  
& instructed Mark Jones not to disturb line

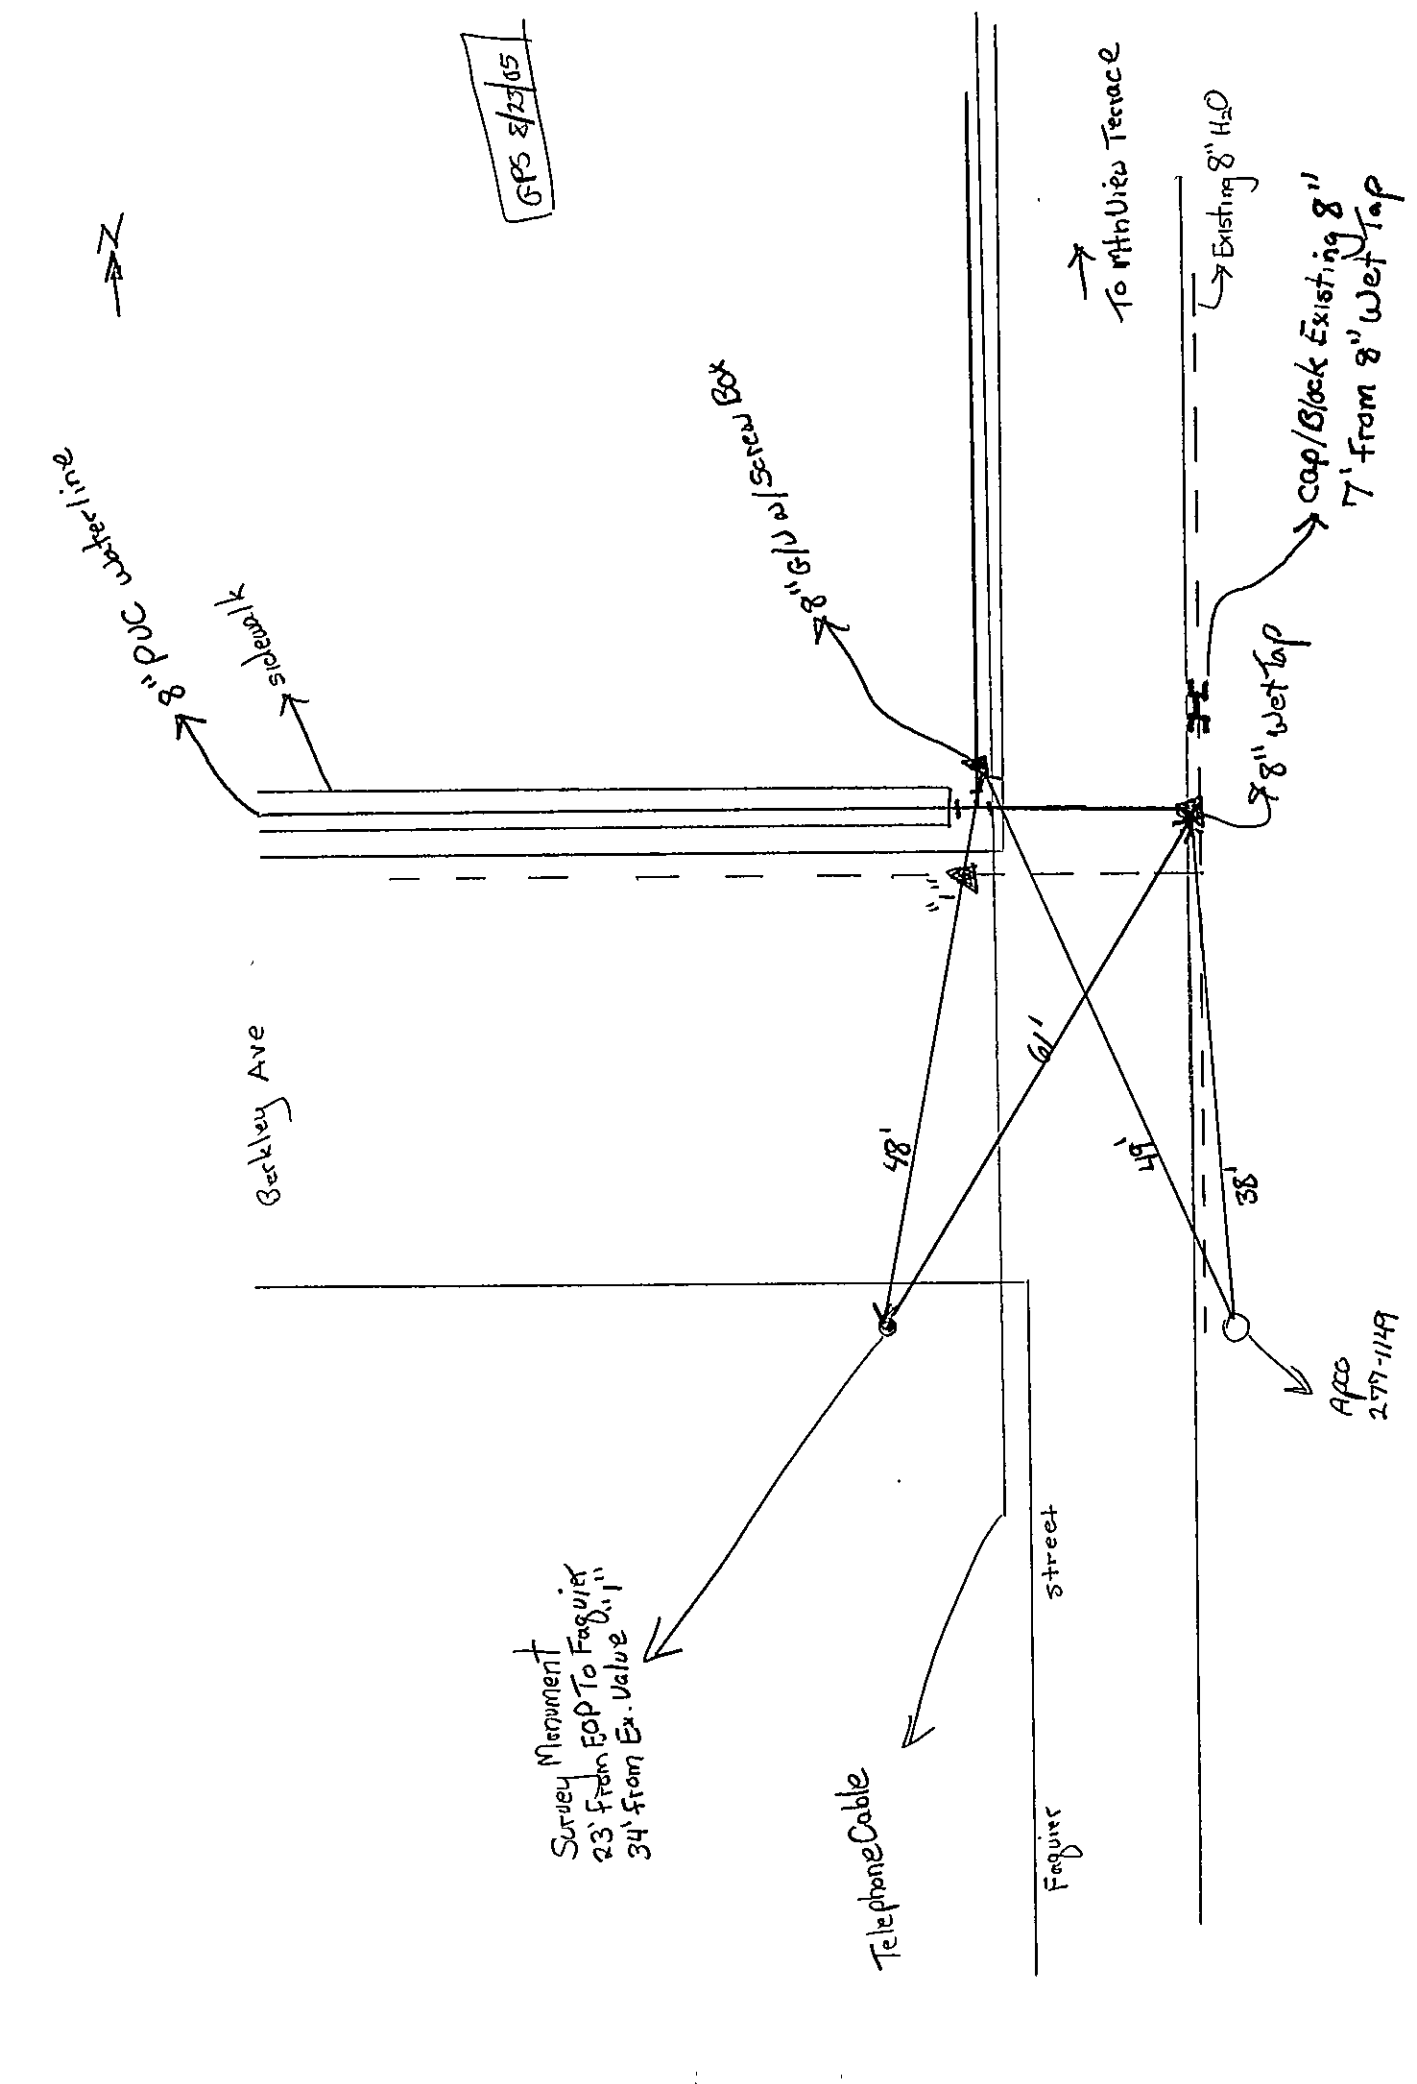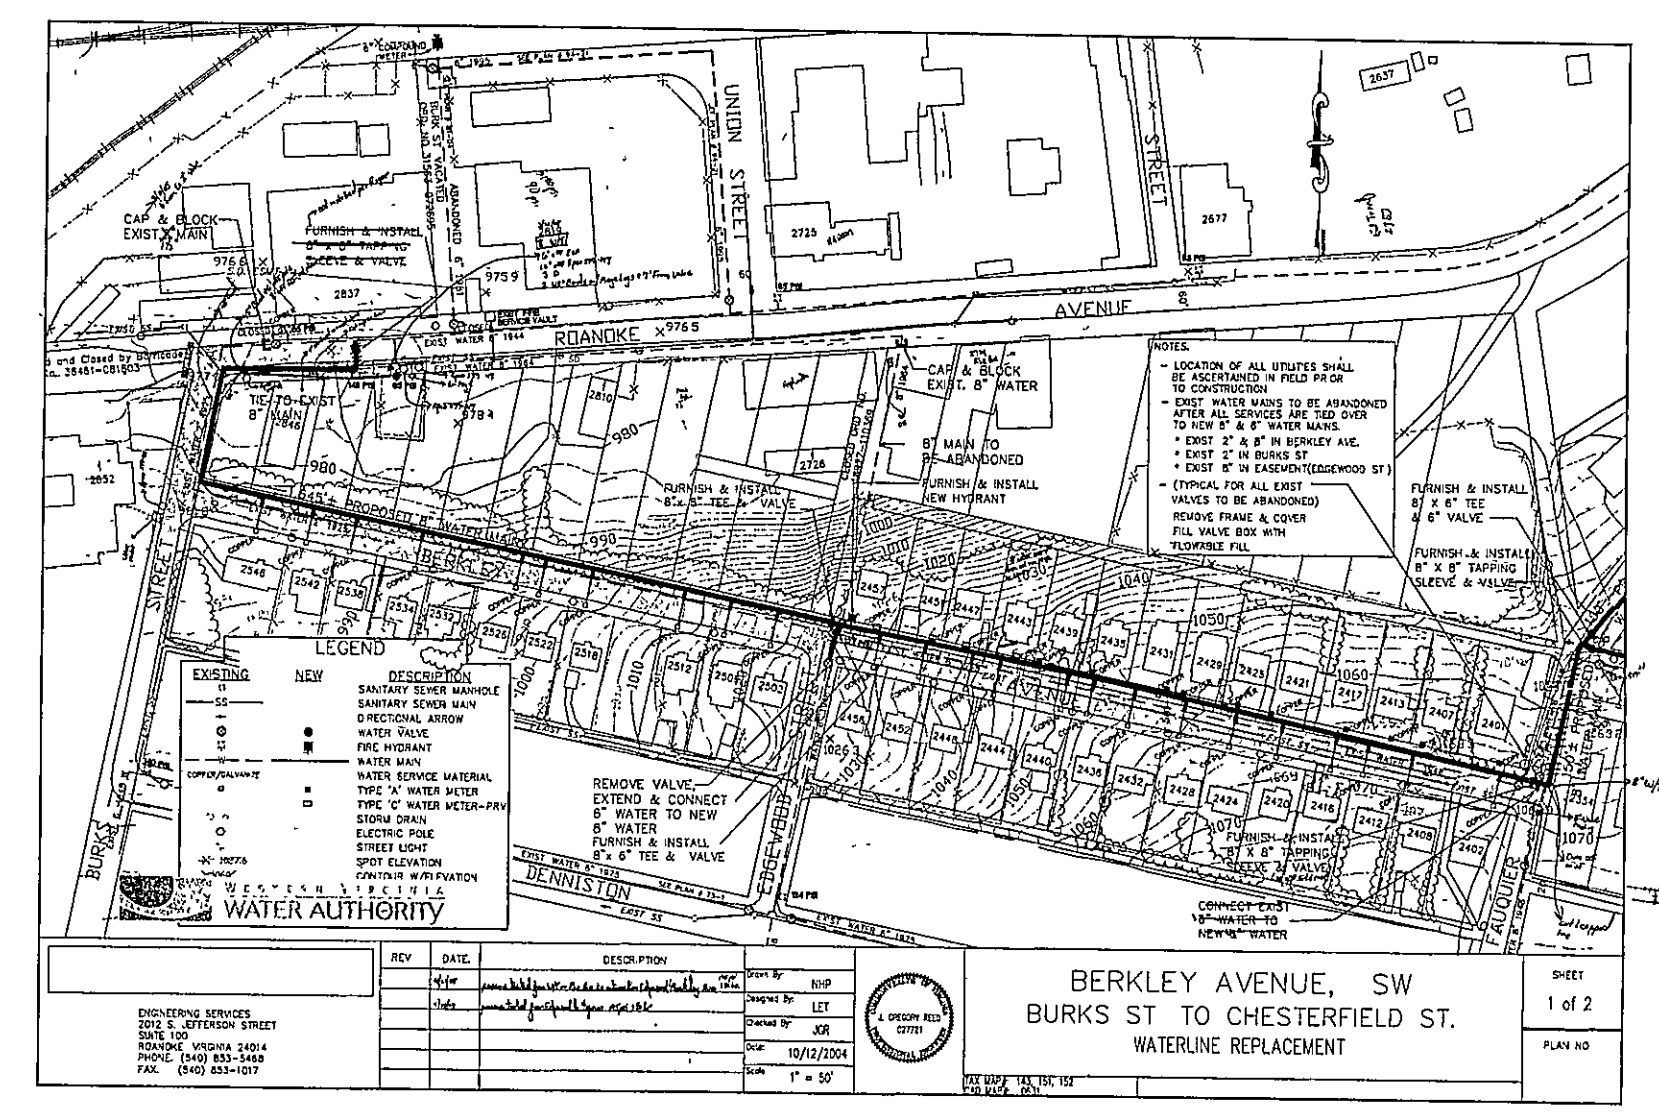

VALVE SHEETS

ROANOKE AVENUE  
BURKS STREET  
BERKLEY AVENUE  
EDGEWOOD STREET  
FAUQUIER STREET