
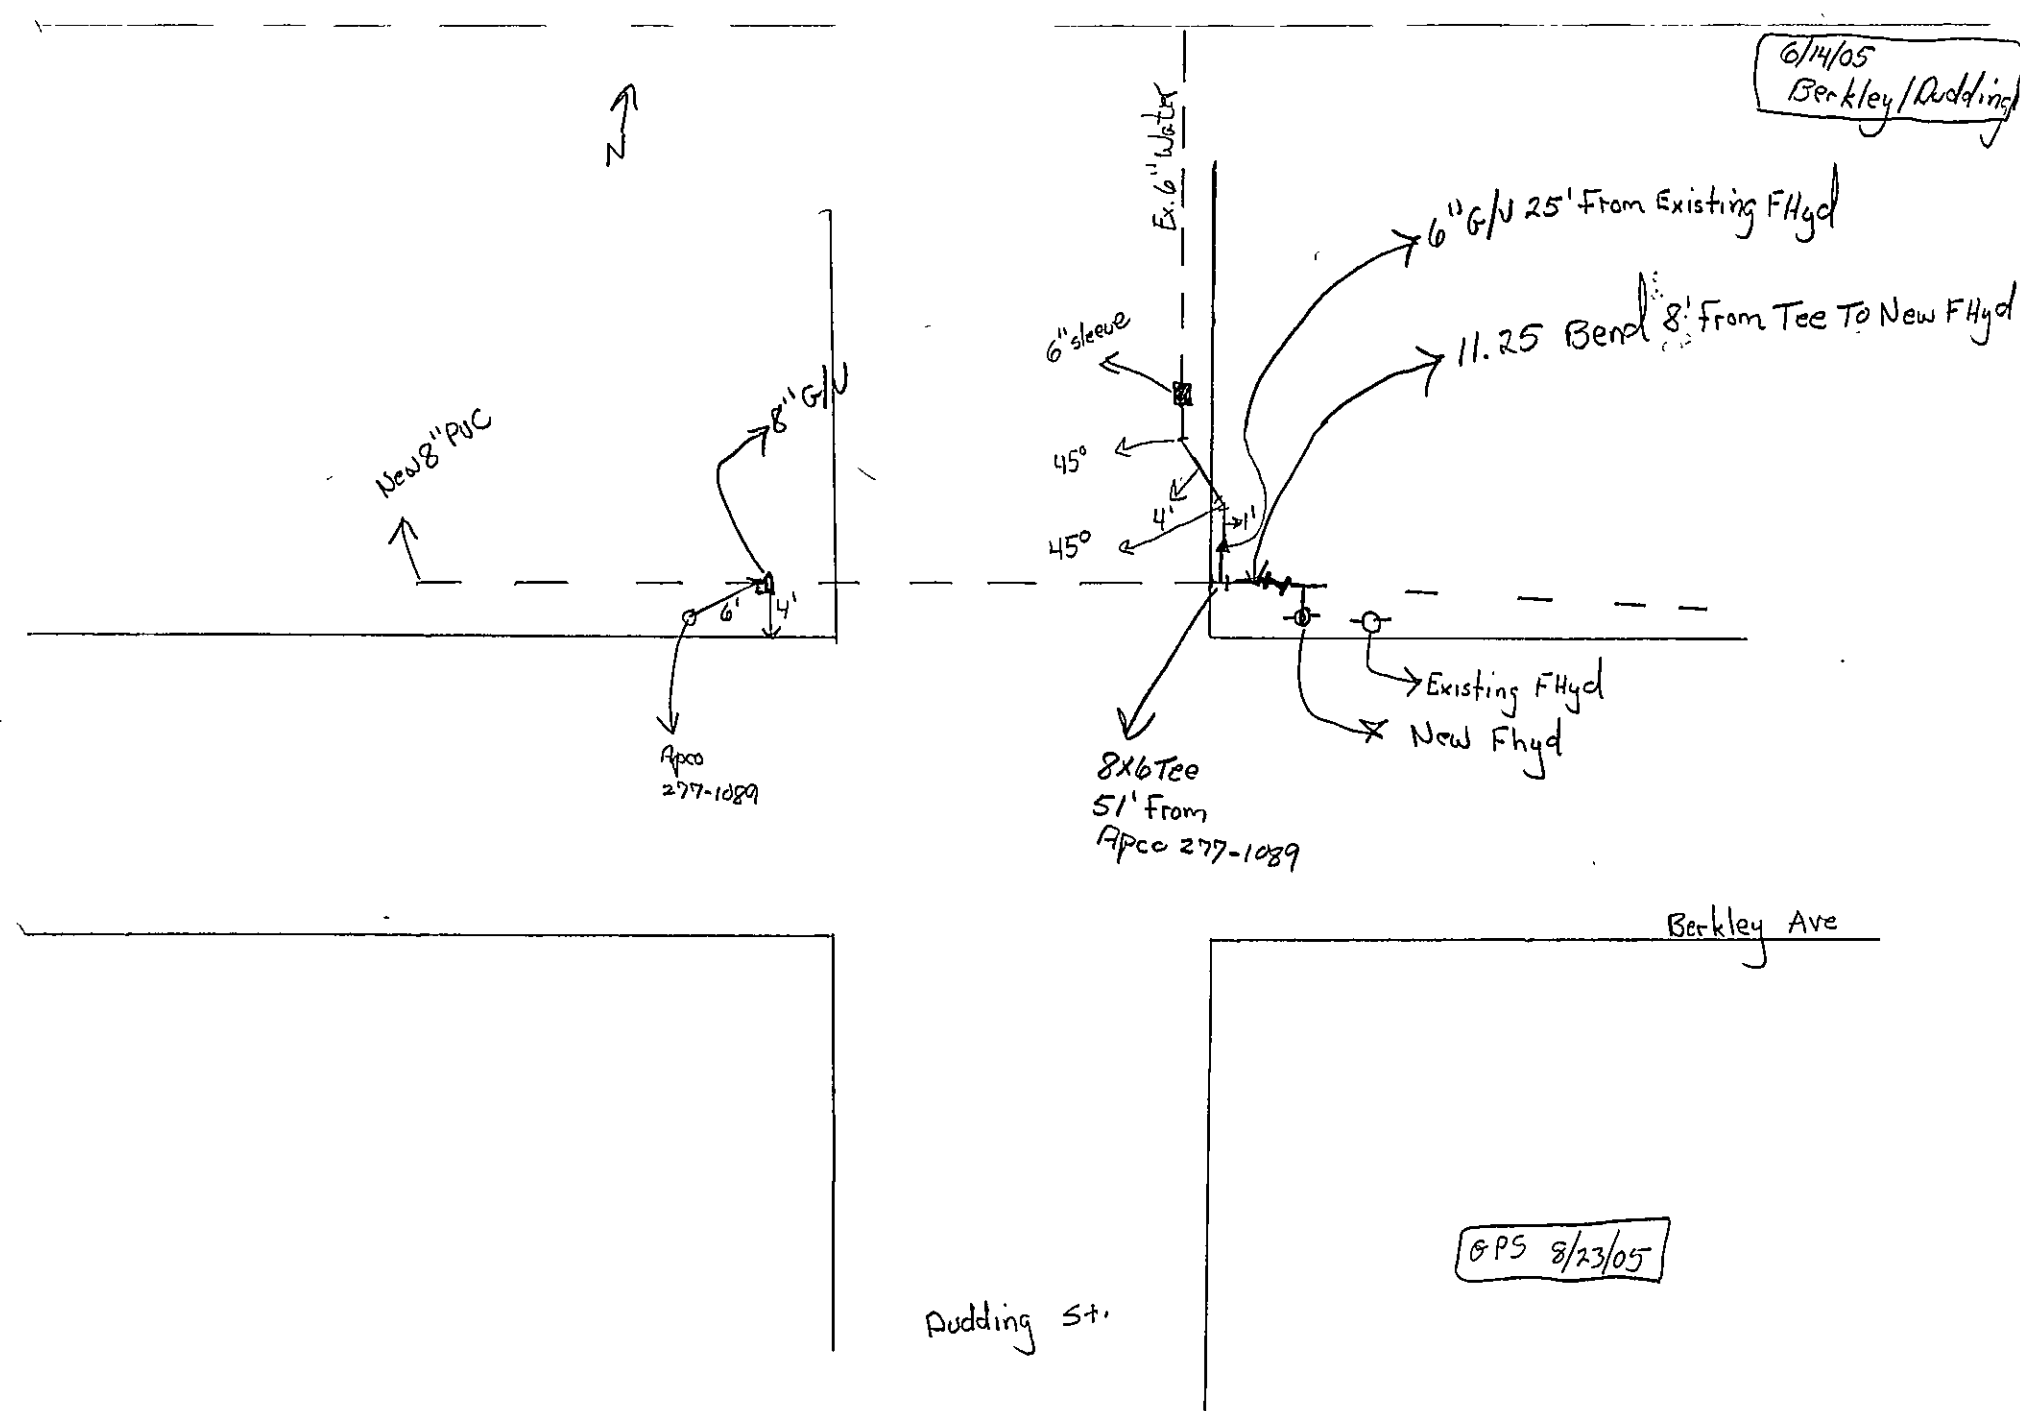


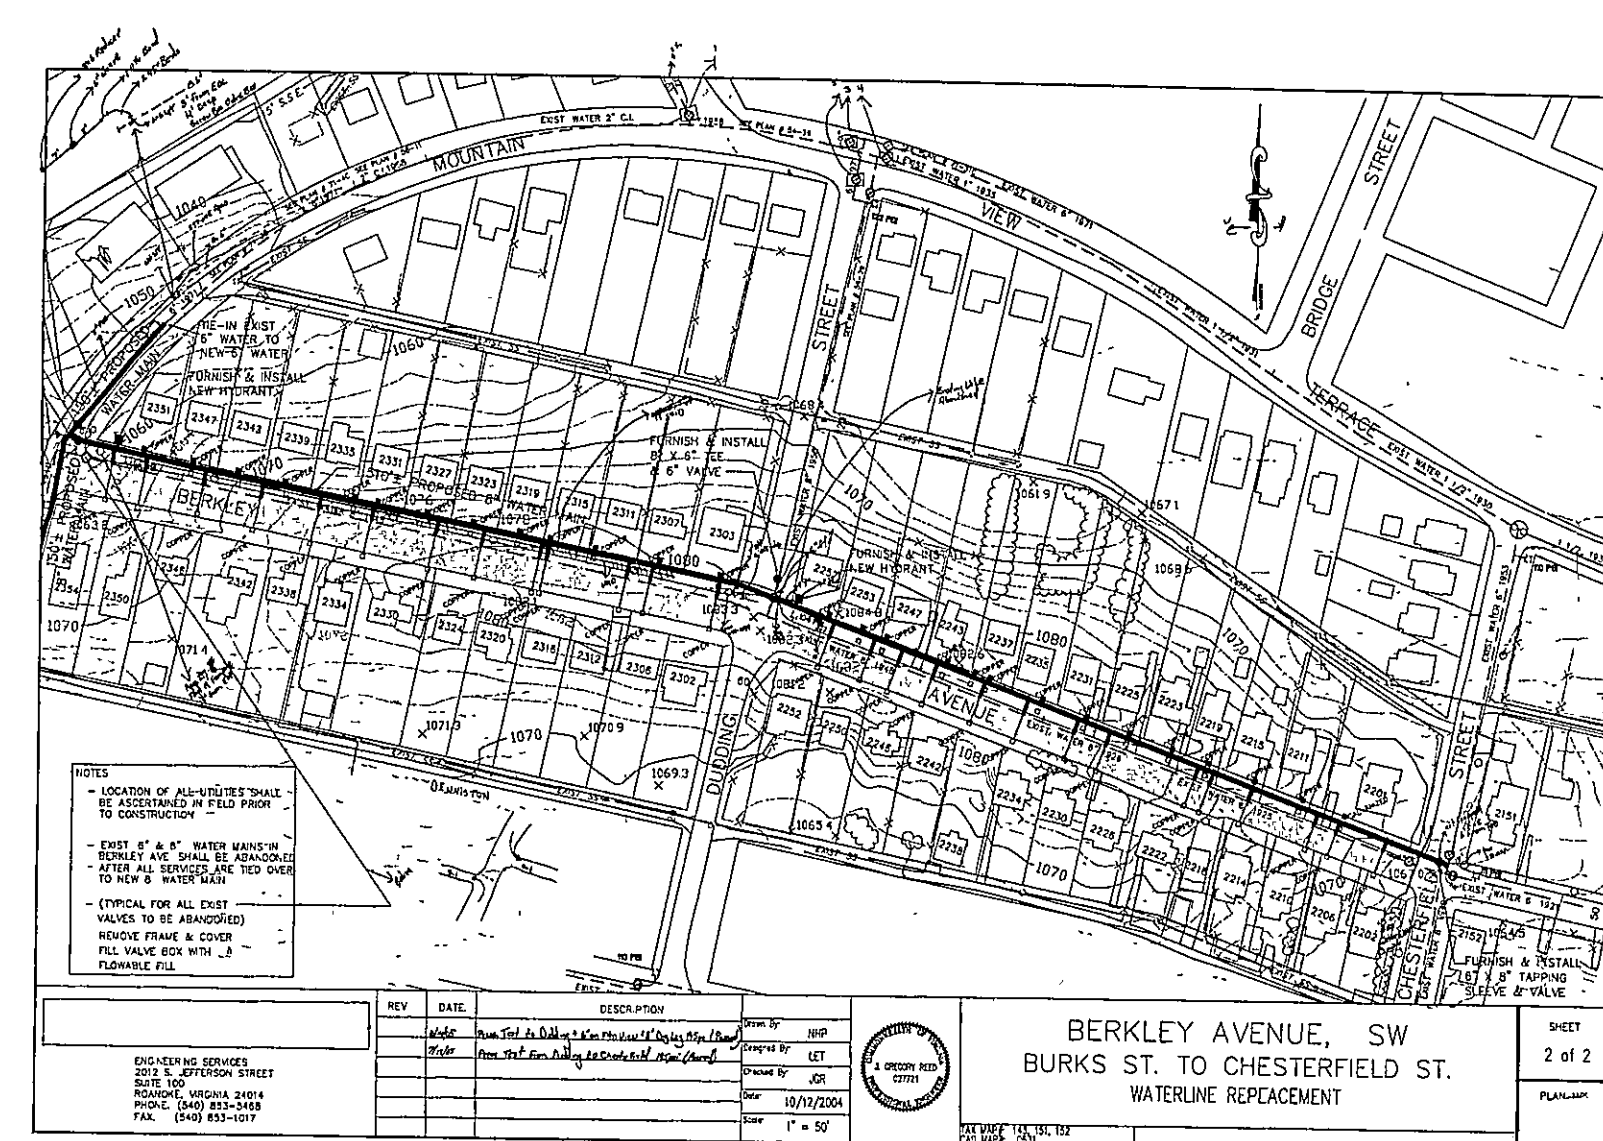

FAUQUIER STREET
MOUNTAIN VIEW TERRACE
BERKLEY AVENUE
DUDDING STREET
CHESTERFIELD STREET

BERKLEY AVENUE, SW BURKS ST. TO CHESTERFIELD ST. WATERLINE REPLACEMENT	SHEET 2 of 2 PLAN NO.
100 600' 145 130' 150'	