


CONSTRUCTION PLANS FOR
WATER MAIN EXTENSION
FROM KING STREET S.E.
ROANOKE • VIRGINIA
TO WOLF CREEK
VINTON • VIRGINIA

OFFICE OF CITY ENGINEER
RICHARD B. BURROW • CITY ENGINEER
PROJECT NUMBER 7903
MARCH • 1980
AS BUILT • DEC. 18, 1980

LEGEND	
	STREET RIGHT-OF-WAY (INCLUSIVE)
	NEW WATER MAIN
	EXISTING WATER MAIN
	SANITARY SEWER MAIN
	UNDERGROUND ELECTRICAL CABLE
	UNDERGROUND GAS MAIN
	UNDERGROUND TELEPHONE CABLE
	NEW WATER MAIN VALVE AND VAULT
	EXISTING WATER MAIN VALVE AND VAULT
	SANITARY SEWER MANHOLE
	SANITARY SEWER CLEAN OUT
	HYDRANT LATERAL 6" DUCTILE IRON PIPE
	HYDRANT LATERAL WITH HYDRANT
	EXISTING METER BOX (SERVICE AS REQ'D)
	AIR RELEASE VALVE AND VAULT

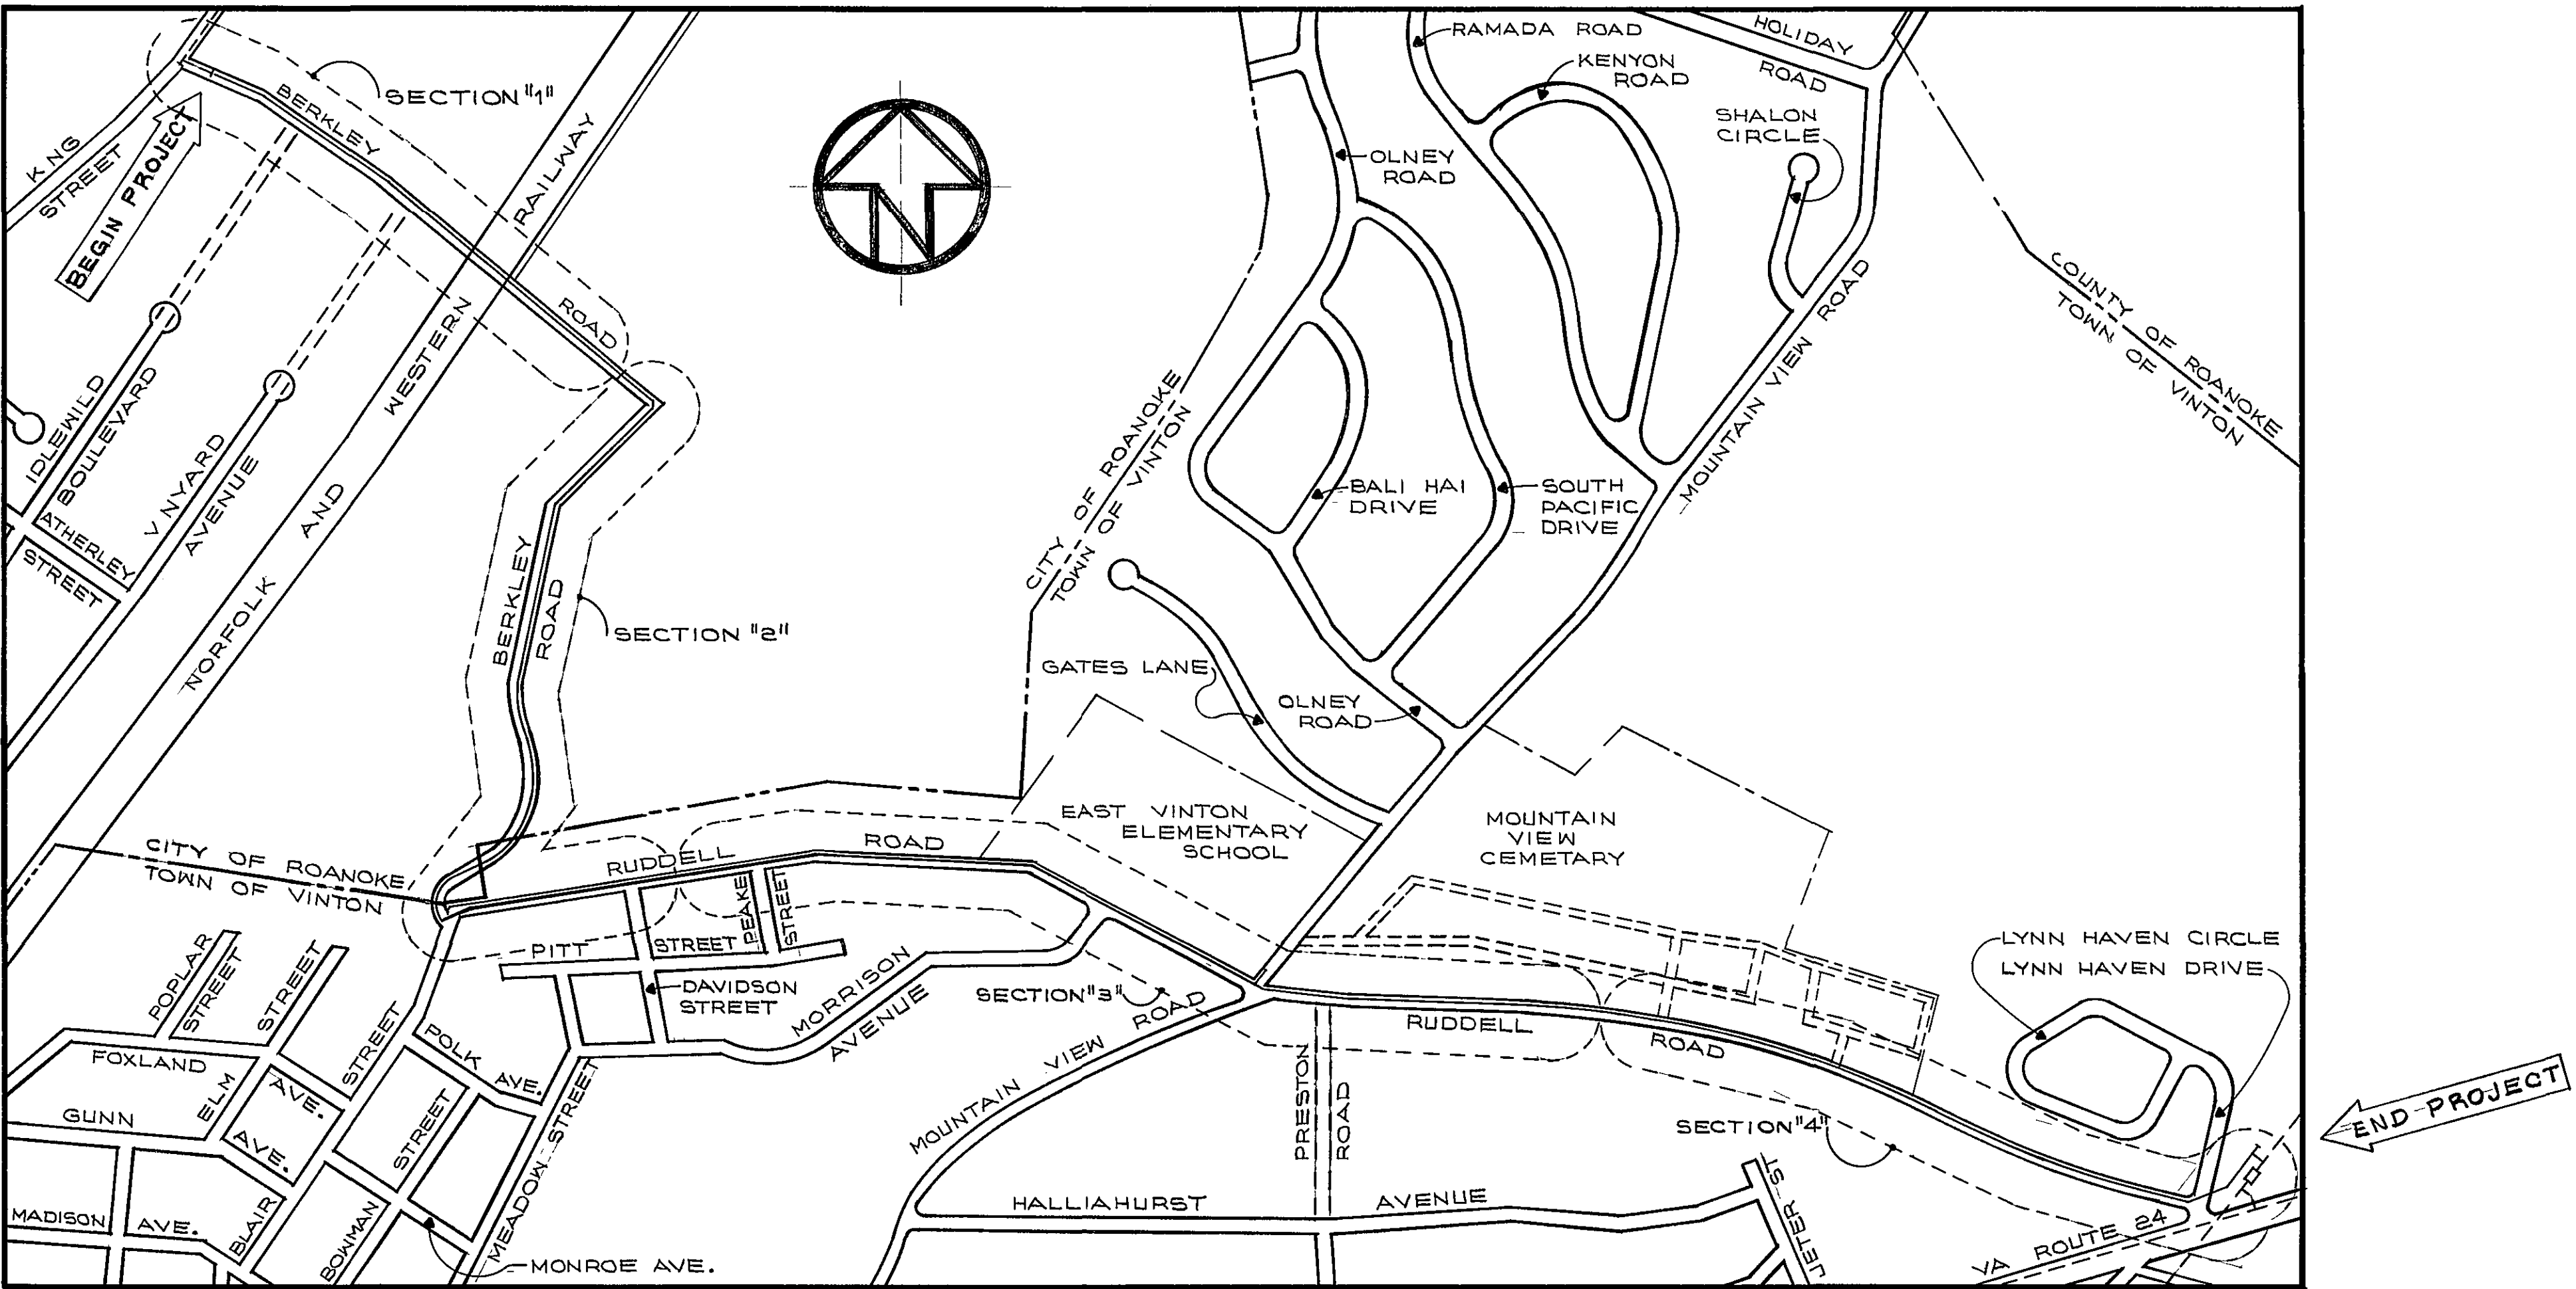

VICINITY MAP
500' 0' 500' 1000'

AS BUILT