


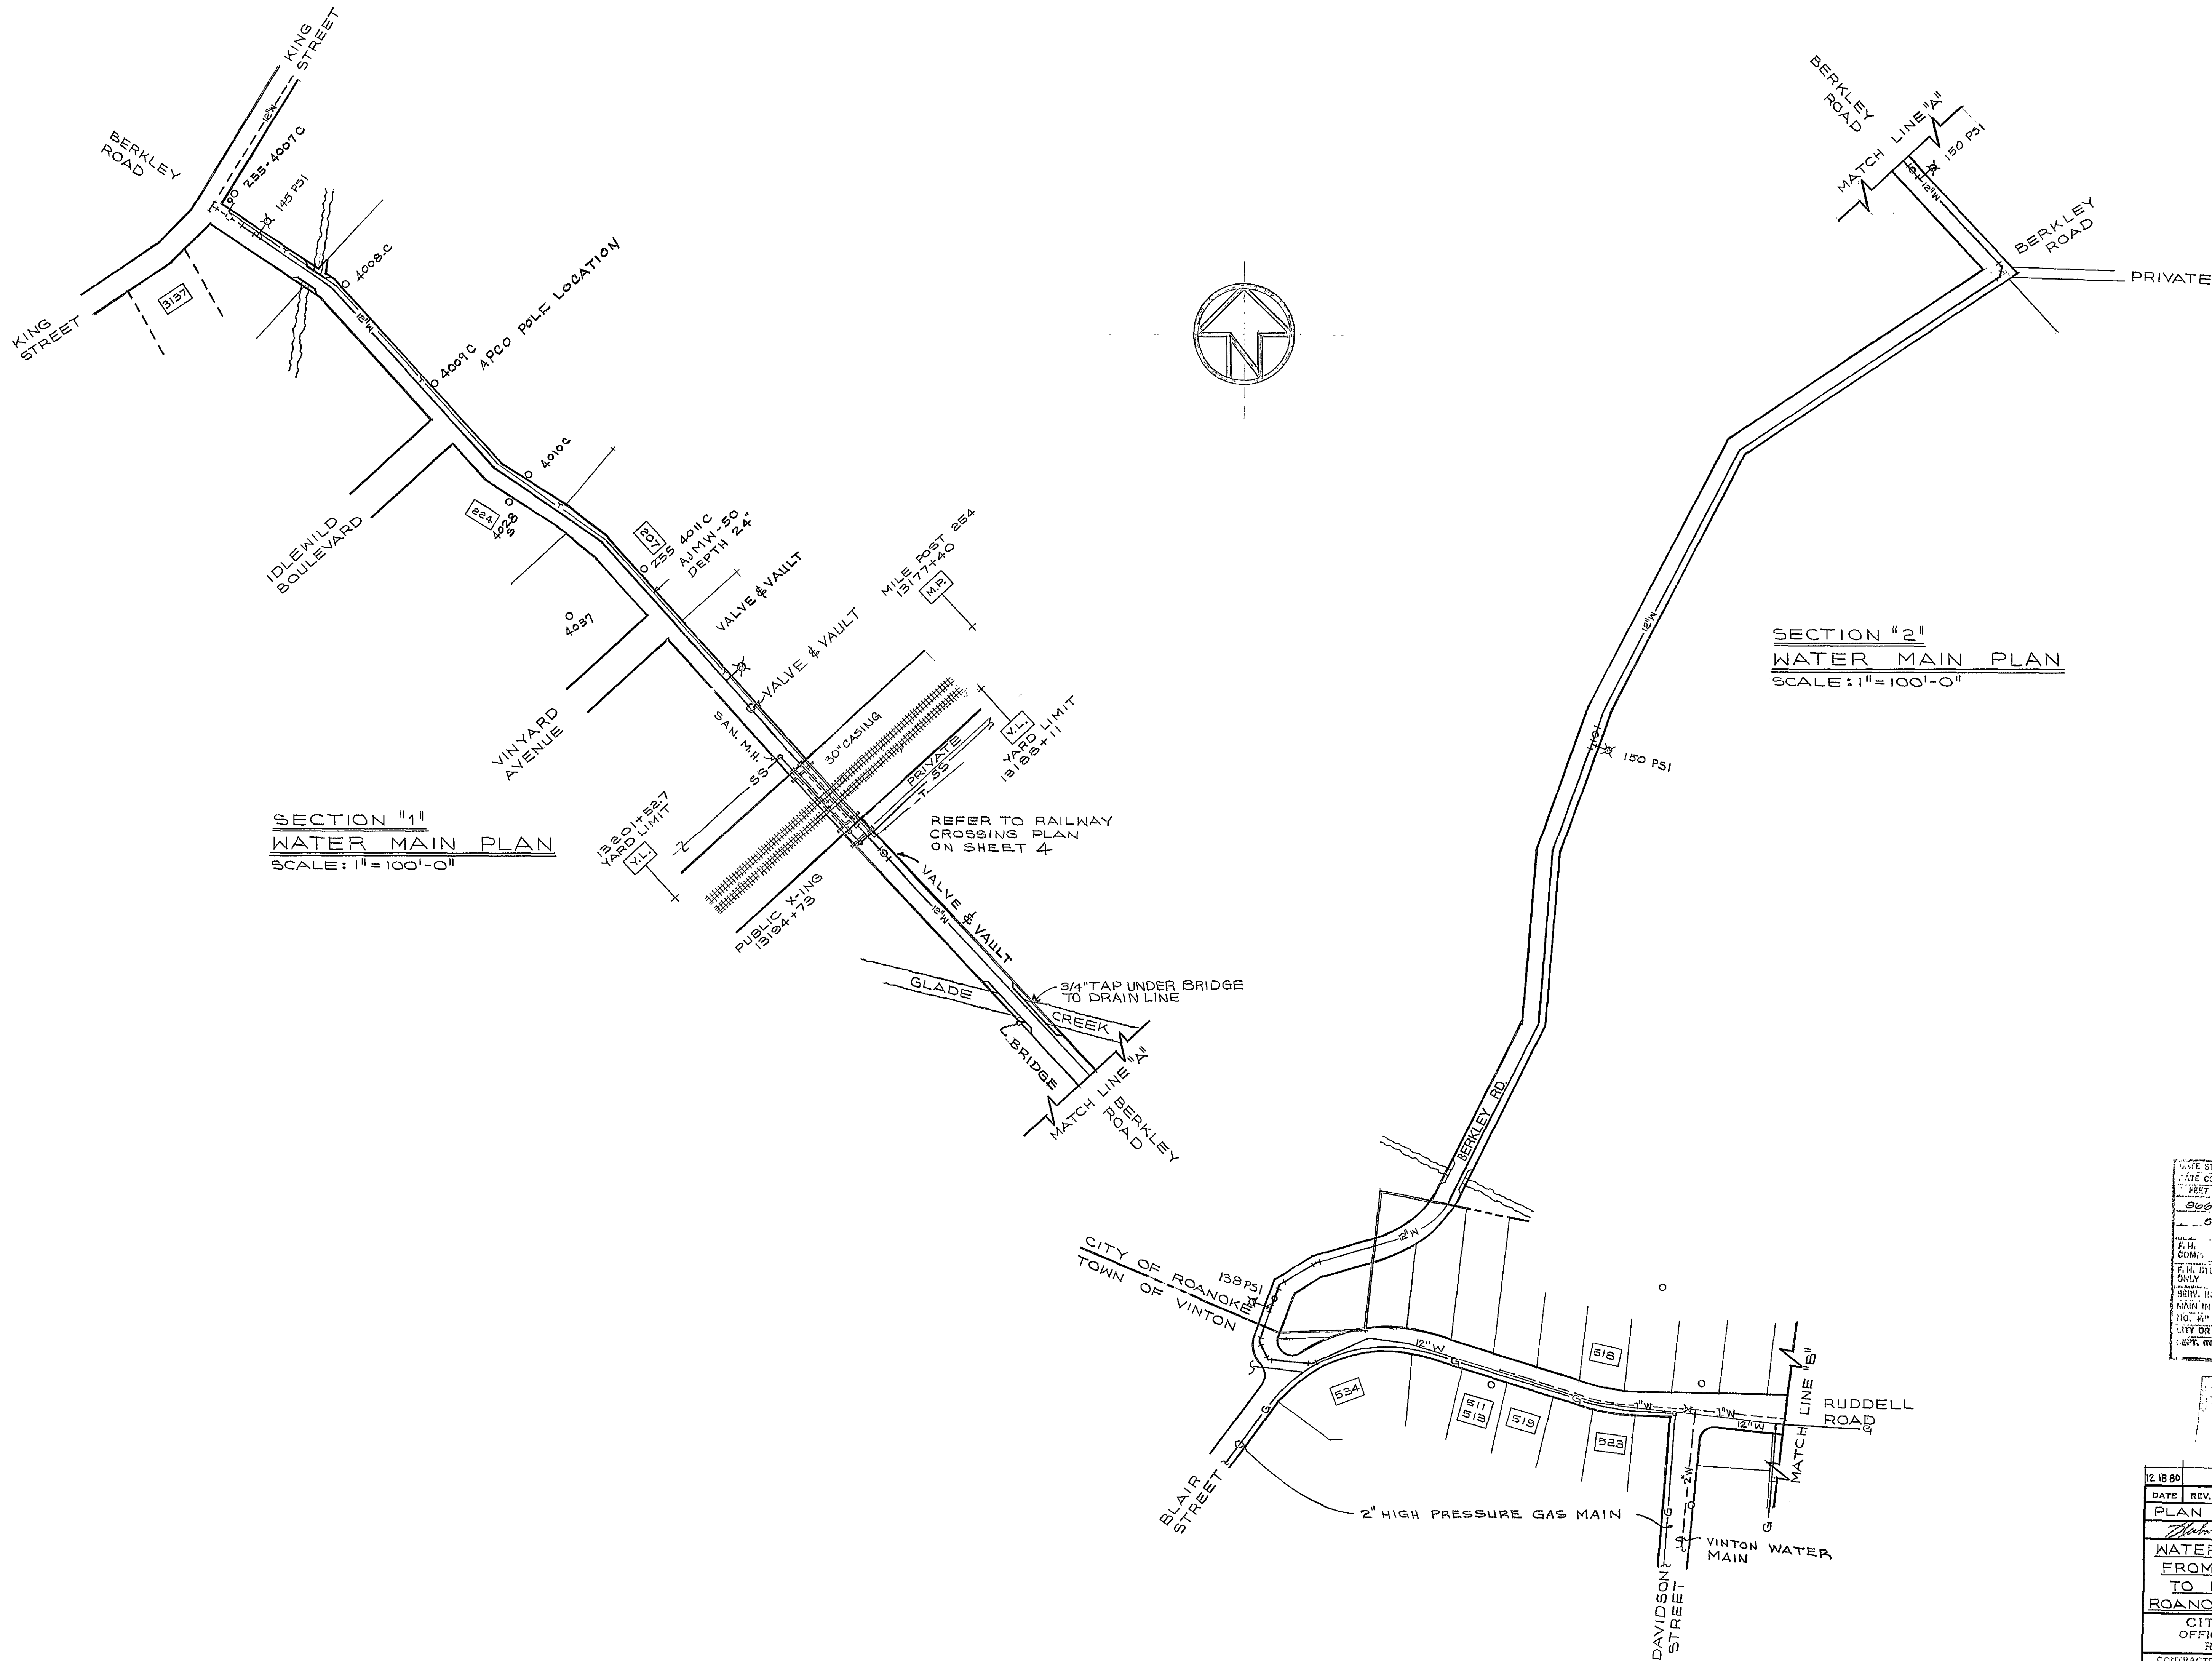

DATE STARTED 5-27-80				
DATE COMP.				
FEET MAIN	SIZE	VALVE	VAULT	BOX
9669'	12"	7	7	7
64'	8"	1	1	1
F.H. COMP.				
5	5	5	5	5
F.H. UNIT ONLY				
SERV. IN. 1				
MAIN INS. BY E.C. PAGE CO.				
NO. 4" SERV. IN.				
CITY OR CO. CITY-VINTON				
EPT. INSP. NOTLEY				

DATE	REV.	DESCRIPTION	BY
12-18-80		AS BUILT DRAWINGS	LBC
PLAN WATER MAIN			
WATER MAIN EXTENSION FROM KING STREET TO WOLF CREEK			DRAWN LBY
ROANOKE-VINTON, VIRGINIA			CHECKED LBC
CITY OF ROANOKE			APPROV MCS
OFFICE OF CITY ENGINEER			DATE MAR 80
ROANOKE, VIRGINIA			JOB NO. 7903
CONTRACTOR MUST VERIFY ALL DIMENSIONS AT PROJECT BEFORE PROCEEDING WITH WORK			SHEET 2

suspended water main