



EXISTING BUILDING STORM SYSTEM WITH GUTTERS AND DOWNSPOUTS DISCHARGING ABOVE GRADE TO REMAIN.

DO NOT INSTALL (FCO) FLOOR CLEANOUTS IN SHEET VINYL/CARPET FLOORS.  
THE CONTRACTOR IS RESPONSIBLE TO INSTALL (WCO) WALL CLEANOUTS IN THE LOCATIONS  
INDICATED ON THE DRAWINGS.  
REFER TO ARCH. DRAWINGS FOR FLOOR FINISHES.

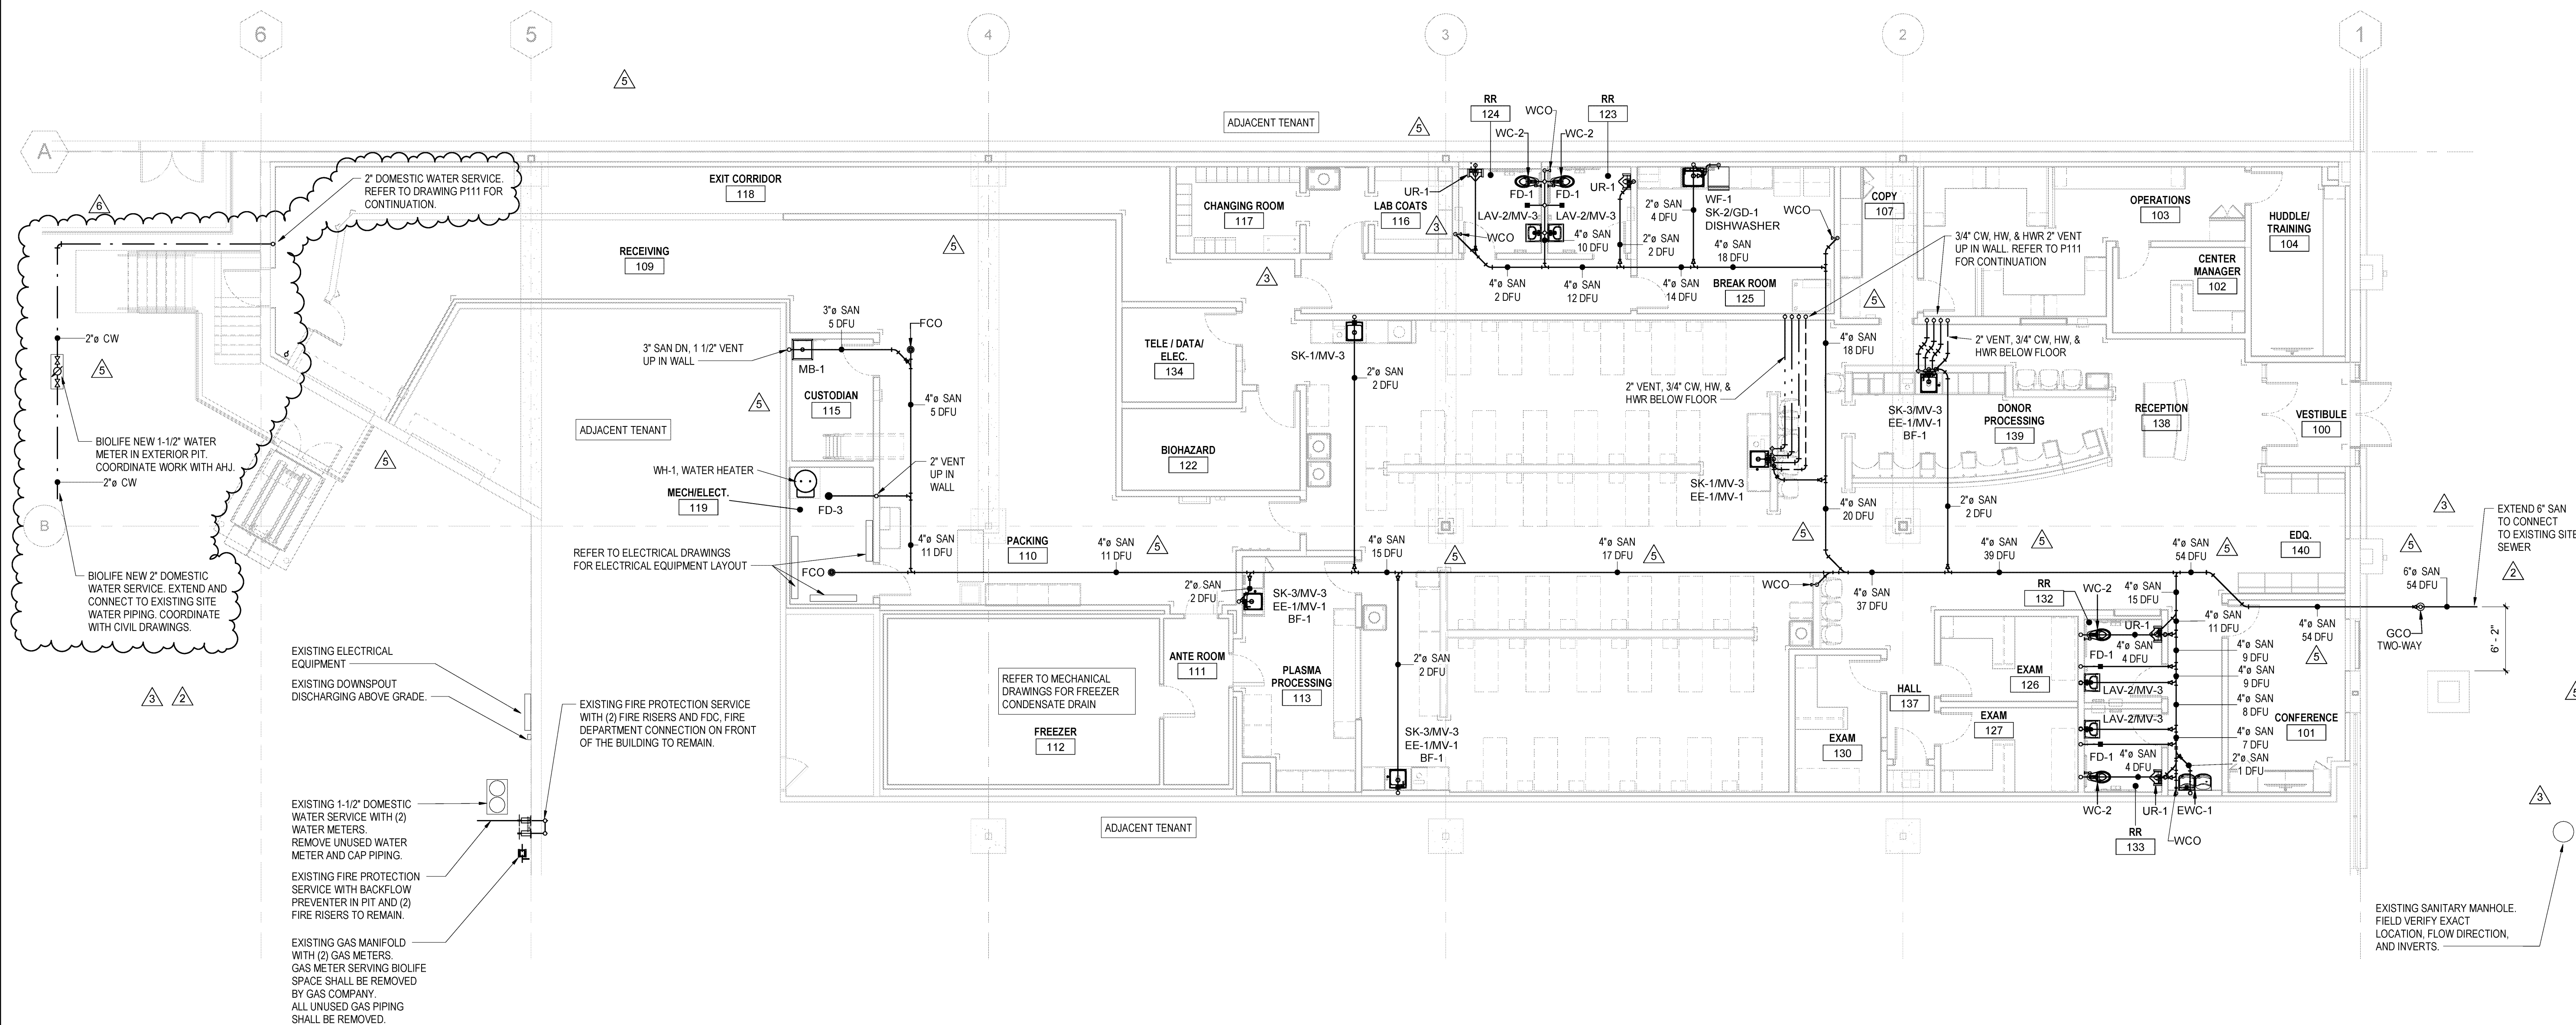


1 UNDERFLOOR PLAN - PLUMBING  
SCALE: 1/8" = 1'-0"

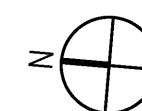

Design and construction documents as instruments of service are given in confidence and remain the property of Onyx Creative. The use of this design and these construction documents for purposes other than the specific project named herein is strictly prohibited without expressed written consent of Onyx Creative.





**These Plans Have Been Reviewed For Code Compliance**

This Plan Review does not relieve the contractor of his responsibility to comply with all applicable codes.

The issuance of a permit based on these plans shall not prevent the Building Official from thereafter requiring a correction of errors in plans, construction, or violations of the code.

This copy of the plans must be kept at the site of work and shall be open to inspection by the Building Official or his authorized representative.

Approved by Tommy Hahn  
05/19/2023 7:03:49 AM

**BioLife® PLASMA SERVICES**



Project No.:	20474
Drawn By:	IEU
Date	Issue
2022-11-18	FOR PERMIT
2023-01-20	2 ADDENDUM
2023-02-24	3 ITC 2
2023-04-03	5 ITC 4
2023-04-28	6 ITC 5

P110

### UNDERFLOOR PLAN - PLUMBING