



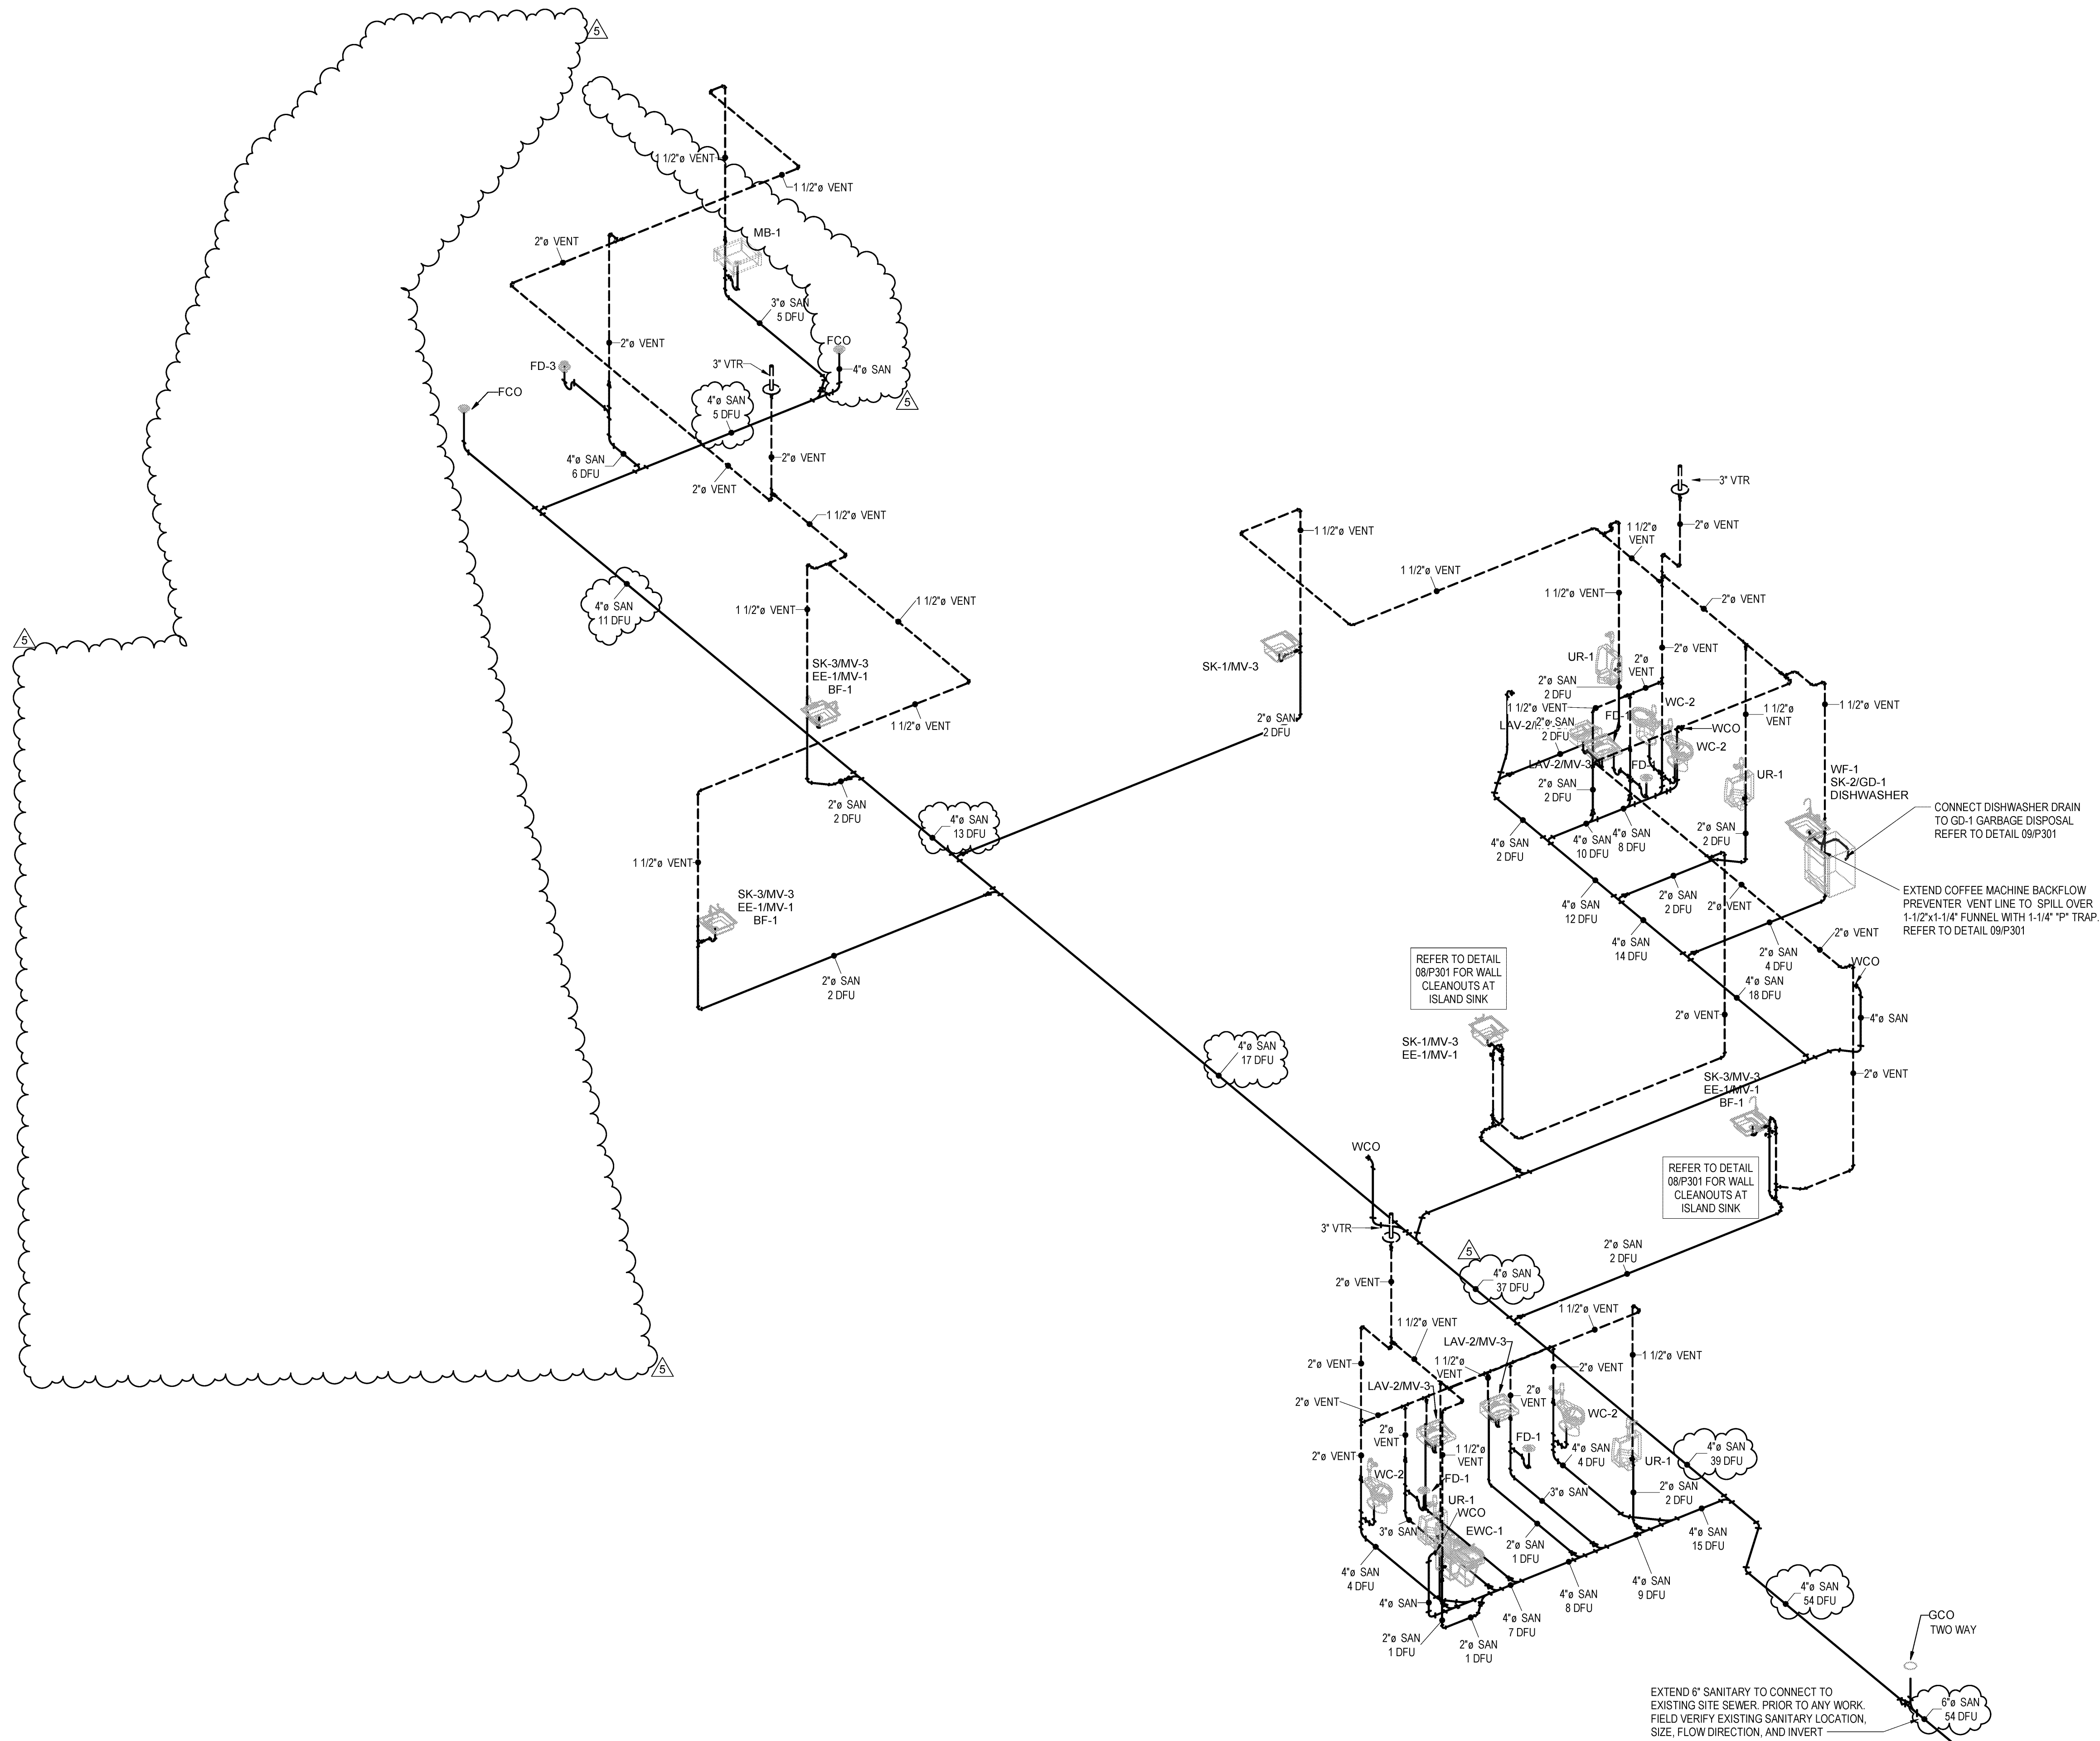

1 RISER DIAGRAM - SANITARY/VENT
NOT TO SCALE

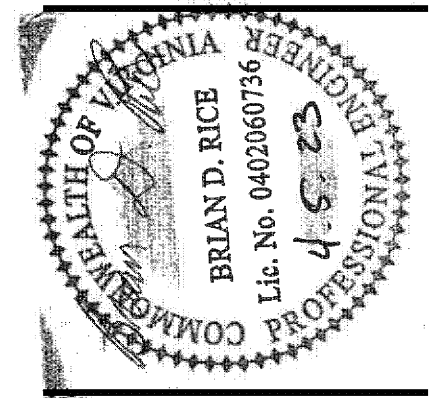

Design and construction documents as instruments of service are given in confidence and remain the property of Onyx Creative. The use of this design and these construction documents for purposes other than the specific project named herein is strictly prohibited without expressed written consent of Onyx Creative.

These Plans Have Been Reviewed For Code Compliance
This Plan Review does not relieve the contractor of his responsibility to comply with all applicable codes.
The issuance of a permit based on these plans shall not prevent the Building Official from thereafter requiring a correction of errors in plans, construction, or violations of the code.
This copy of the plans must be kept at the site of work and shall be open to inspection by the Building Official or his authorized representative.

Approved by Tommy Hahn
04/12/2023 7:43:16 AM

BioLife® PLASMA SERVICES
BIOLIFE
4731 VALLEY VIEW BLVD.
NW ROANOKE, VA 24012

Project No.:	20474
Drawn By:	IEU
Date	Issue
2022-11-18	FOR PERMIT
2023-01-20	2 ADDENDUM
2023-02-24	3 ITC 2
2023-04-03	5 ITC 4

P201

SANITARY - VENT
RISER DIAGRAM