

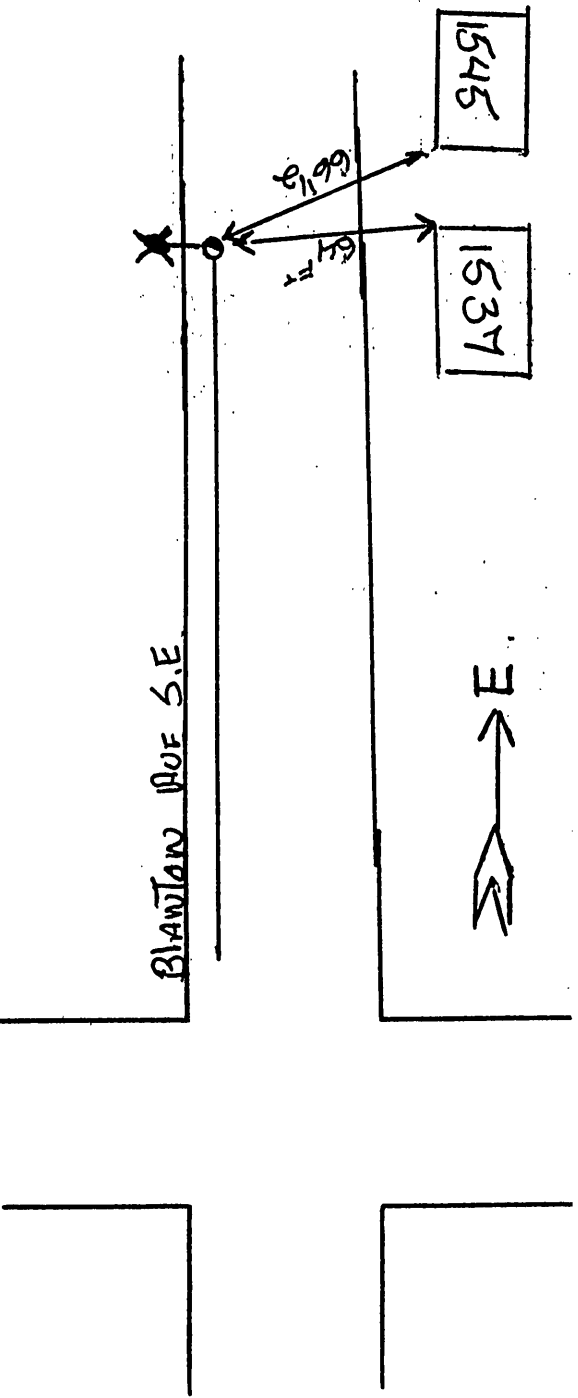
FIRE. HYDRANT RECORD

CORNER

LOCATION 1540 BLANFORD AVE. S.E.

[illegible]

LOCATION 1500 BIRK BLVD SE

**SKETCH SHOWING HYDRANT LOCATION**