


1.19.09
Grease Trap = 4' x 8' x 4.5' (deep) (1077 gals.)
Has vent hole,
Rattle to top.

NOTE: USE VERSA-LOK OR EQUAL SEGMENTAL
UNITS FOR RETAINING WALLS SHOWN. CONTRACTOR
SHALL PROVIDE ENGINEERED DRAWINGS.
COORDINATE MATERIAL AND COLOR WITH ARCHITECT.


NOTE: WATER LINE EXTENSION FOR FUTURE
CONNECTIONS TO BE DRY-CLOSE VALVES.

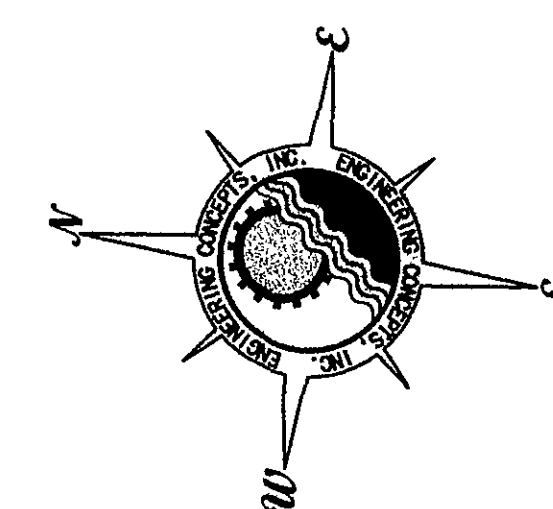

revisions	date	project	designed	drawn	checked
3	10.04.07	09.06.07	07.30.07		
2					
1					



May 30, 2007	05/20/07	JDE	DRB	JDE
date	project	designed	drawn	checked

RODRIGUEZ
RIPLEY
MADDUX
MOTLEY
ARCHITECTS

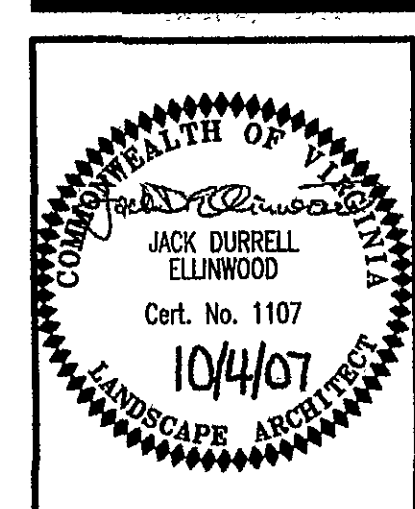

BRBH - HOLLINS ROAD PROJECT
project
drawing
sheet 4
of

C1.02

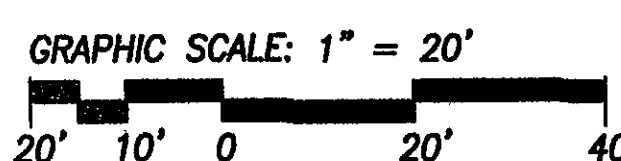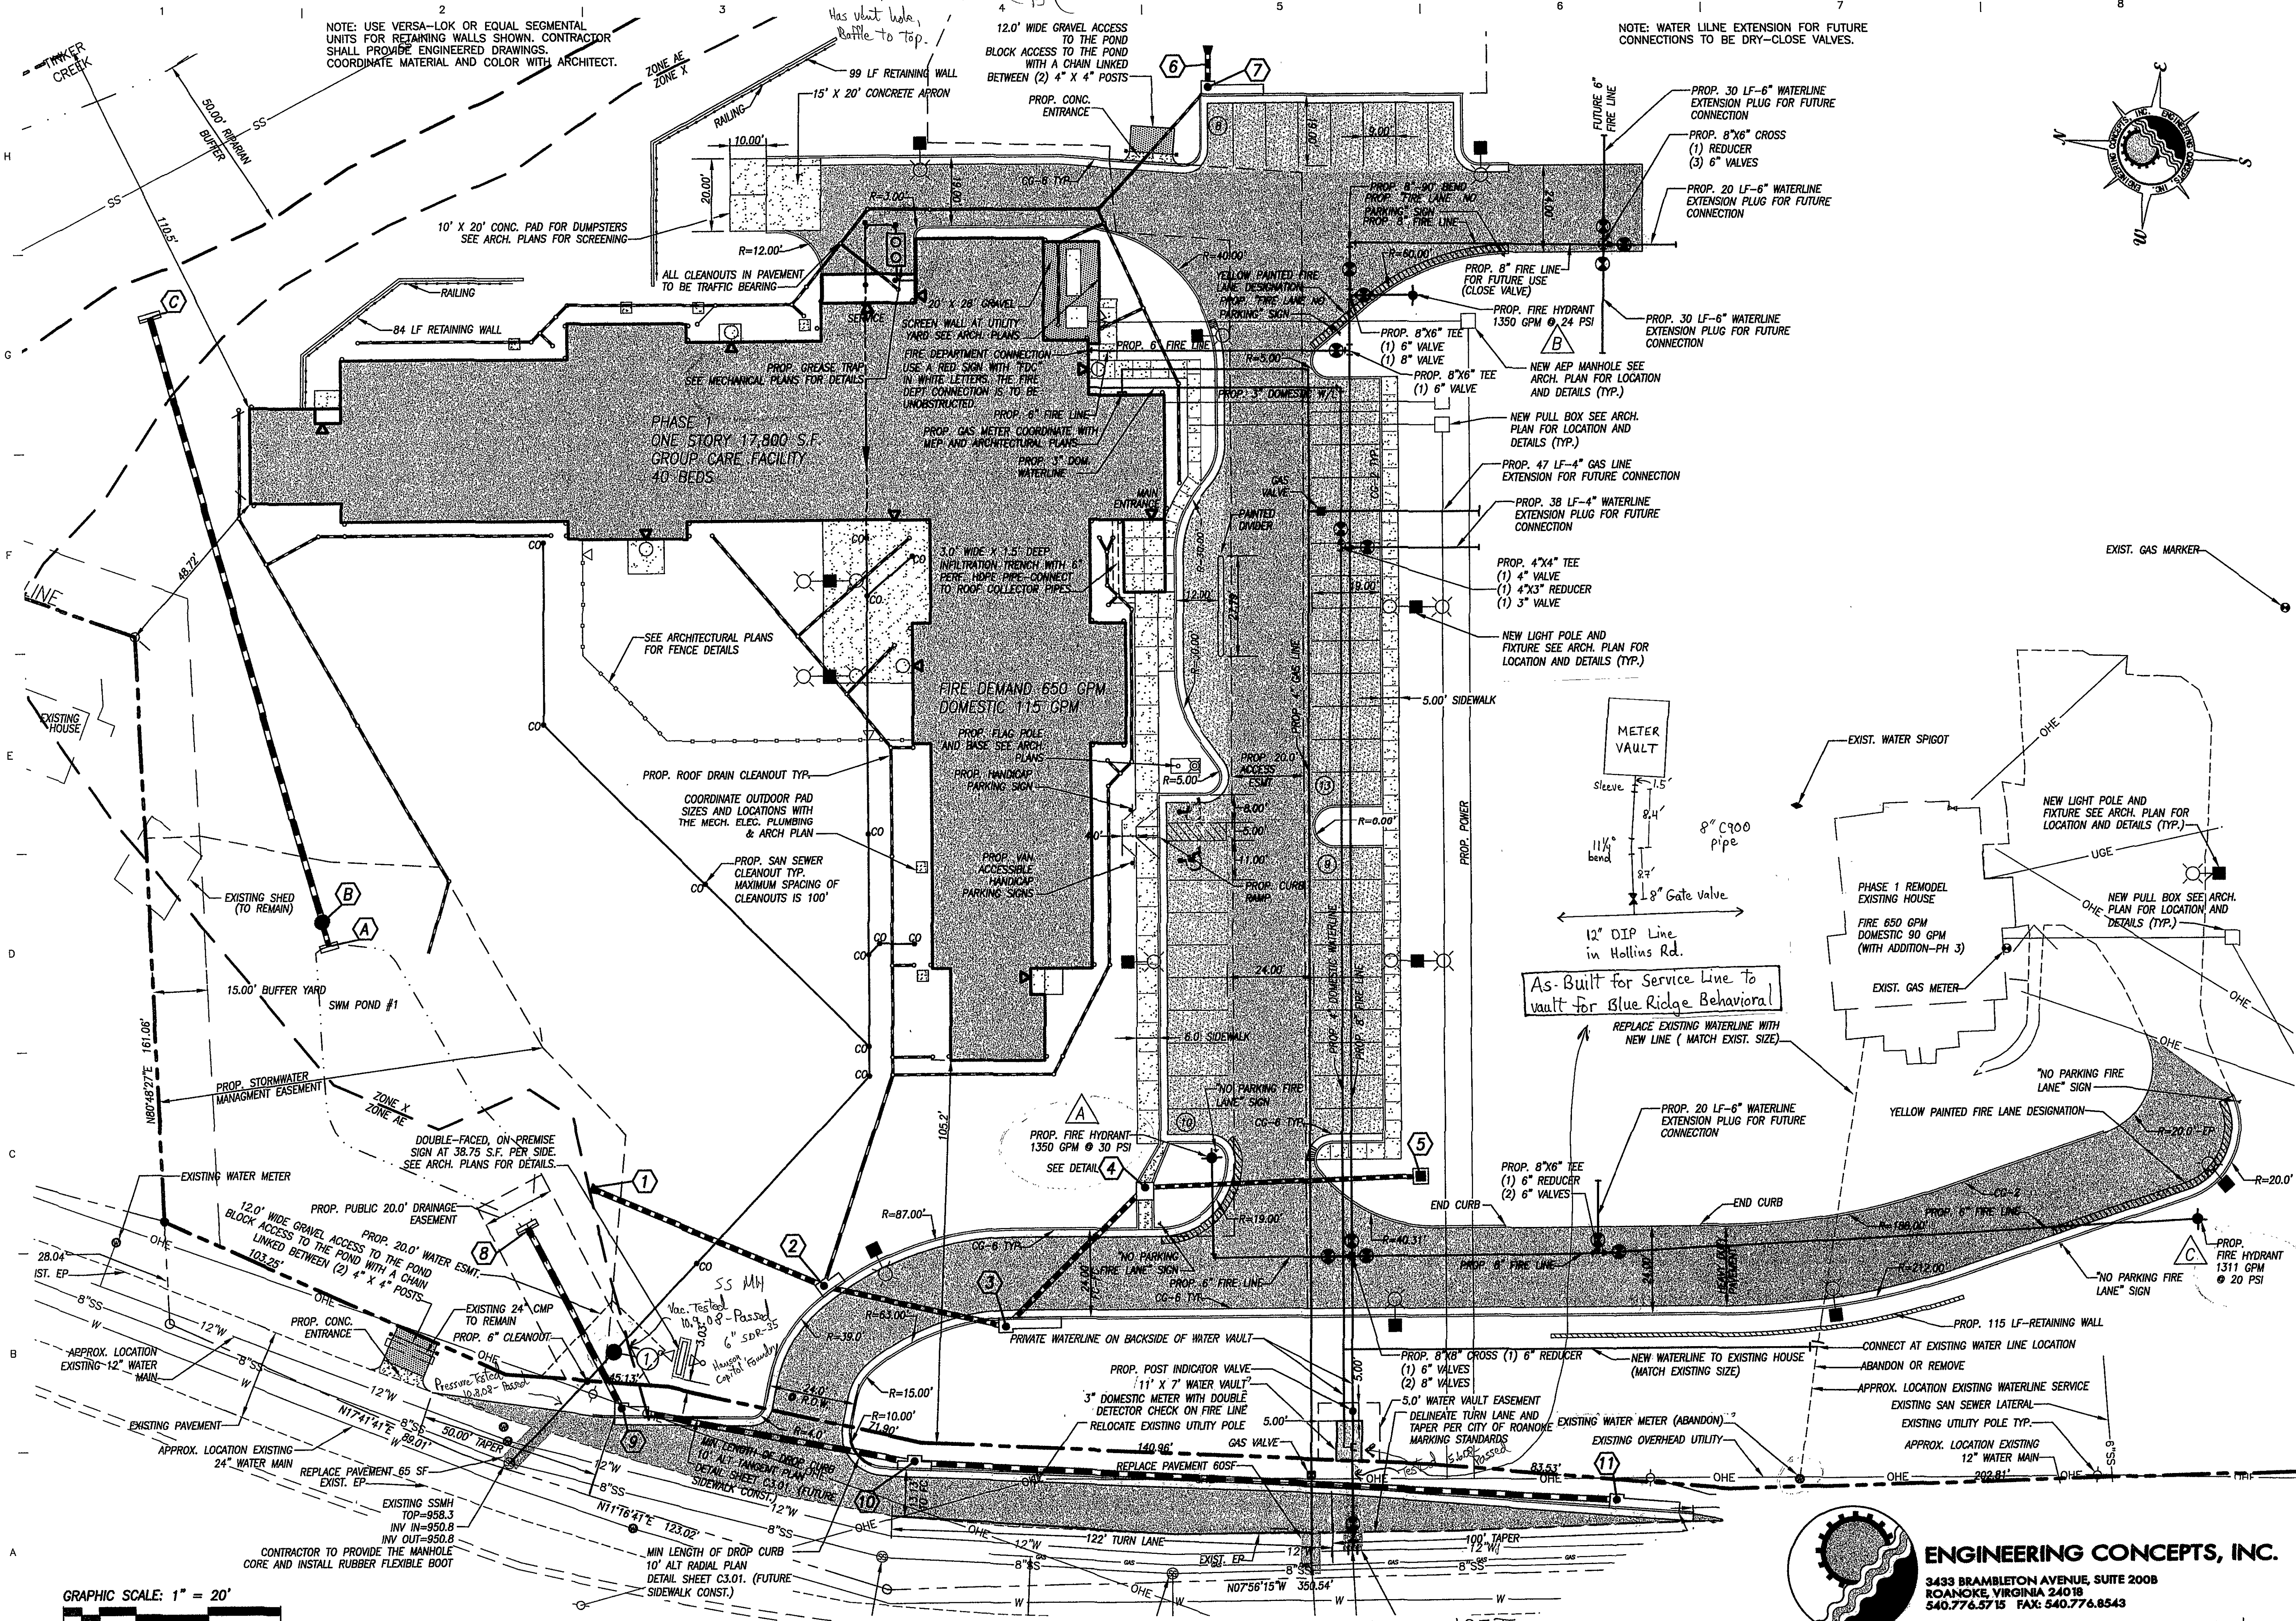

SEE INSET
For AS-BUILT

ENGINEERING CONCEPTS, INC.

3433 BRAMBLETON AVENUE, SUITE 200B
ROANOKE, VIRGINIA 24018
540.776.5715 FAX: 540.776.8543

As-Built 2.17.09 K.Winslow