



BALZER & ASSOCIATES
PLANNERS / ARCHITECTS
ENGINEERS / SURVEYORS

Roanoke / Richmond
New River Valley / Staunton
Harrisonburg / Lynchburg
www.balzer.cc

1298 Corporate Circle
Roanoke, VA 24019
(404) 773-9900



THE VIEW AT BLUE RIDGE COMMONS


2801 HERSHBARGER ROAD NW

UTILITY PROFILES IV


CITY OF ROANOKE, VIRGINIA

DRAWN BY SMD
DESIGNED BY BTC
CHECKED BY BTC
DATE 5/6/2020
SCALE AS SHOWN
REVISIONS
6/15/2020
7/6/2020


WATERLINE 1 (PUBLIC) PROFILE

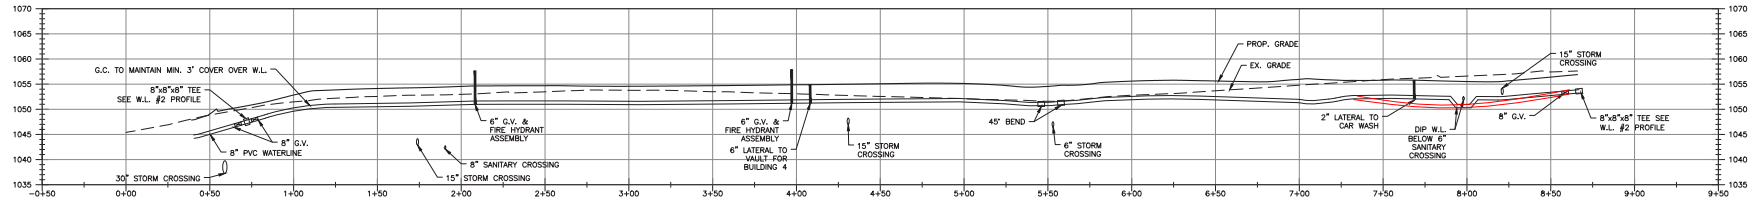


WATERLINE 2 (PUBLIC) PROFILE

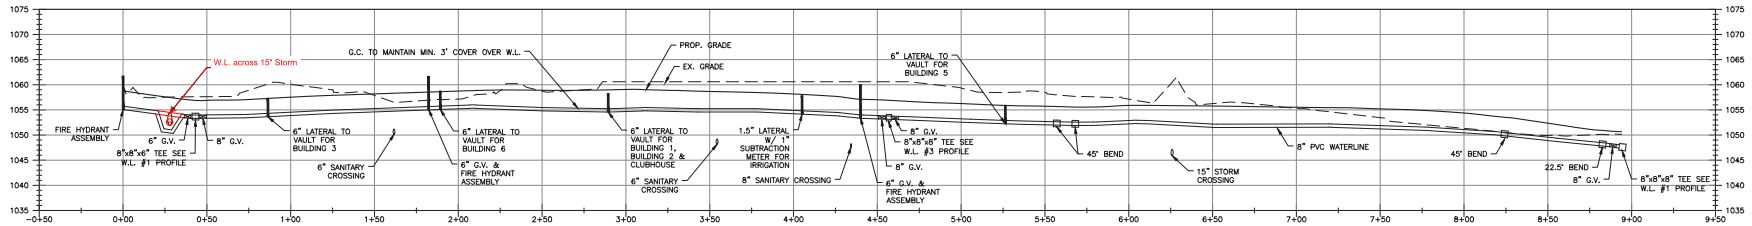

WATERLINE 3 (PUBLIC) PROFILE

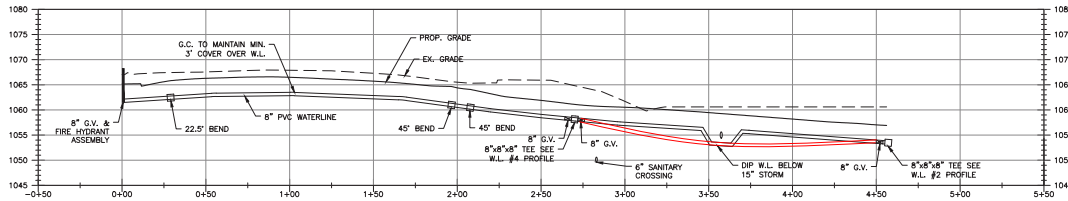



WATERLINE 4 (PUBLIC) PROFILE

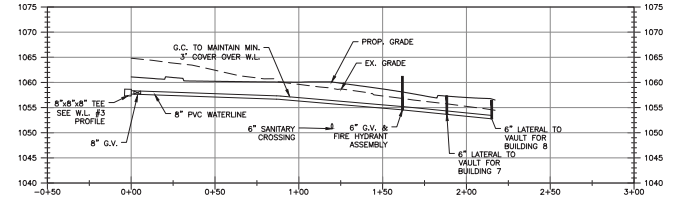

I hereby certify that, to the best of my knowledge and belief, the locations of the water and sewer facilities shown on these record drawings have been constructed in accordance with approved plans and specs.

Devin J. Bowman
Name:
Date: September 19, 2022

Devin J. Bowman
Signature:

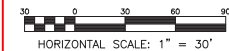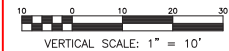

C17
PROJECT NO. 0420003.00