


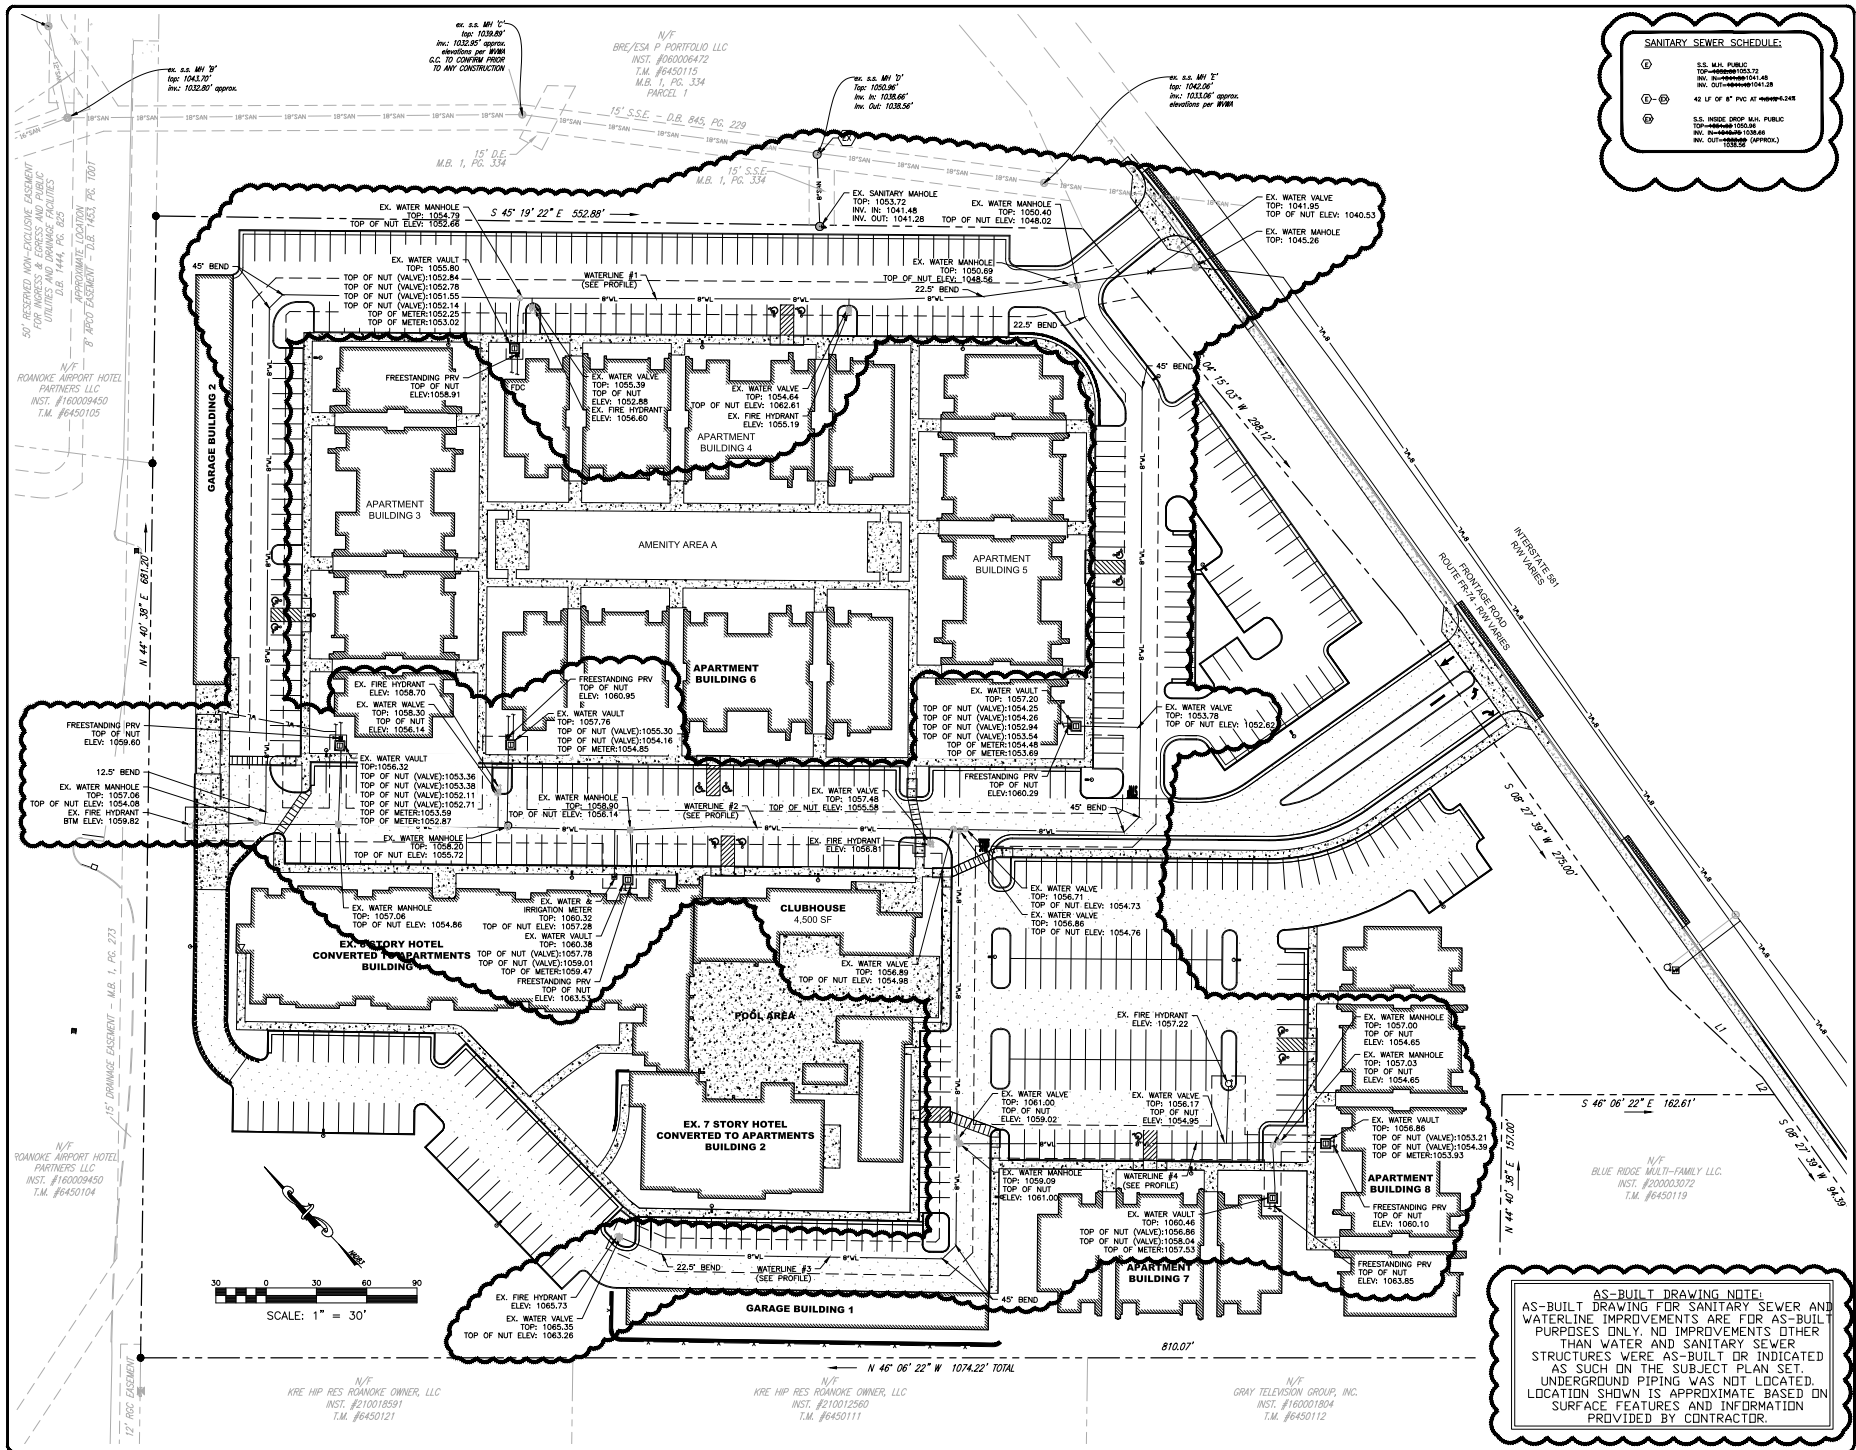

BALZER ASSOCIATES
PLANNERS / ARCHITECTS
ENGINEERS / SURVEYORS
Roanoke / Richmond
New River Valley / Staunton
Harrisonburg / Lynchburg
www.balzer.cc

1308 Corporate Circle
Roanoke, VA 24018
540.712.9580

THE VIEW AT BLUE RIDGE COMMONS
2801 HERSHBERGER ROAD NW
WATER & SANITARY SEWER AS-BUILT

CITY OF ROANOKE, VIRGINIA

DRAWN BY: EJP
DESIGNED BY: EJP
CHECKED BY: DSH
DATE: 09/19/2022
SCALE: 1"=30'
REVISIONS: 1"=30'
05/09/2023 PHASE 2 AS-BUILT

AS-BUILT
PROJECT NO. 2400003072
DATE 05/09/2023