


SANITARY SEWER SCHEDULE:

E S.S. M.H. PUBLIC
TOP = ~~1052.00~~ 1053.72
INV. IN = ~~1041.10~~ 1041.48
INV. OUT = ~~1041.10~~ 1041.28

E-Ex 42 LF OF 8" PVC AT ~~1041.10~~ 6.24%

Ex S.S. INSIDE DROP M.H. PUBLIC
TOP = ~~1050.96~~ 1050.96
INV. IN = ~~1038.66~~ 1038.66
INV. OUT = ~~1038.66~~ (APPROX.)
1038.56

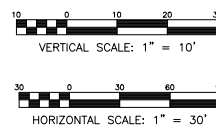

AS-BUILT DRAWING NOTE:
AS-BUILT DRAWING FOR SANITARY SEWER AND WATERLINE IMPROVEMENTS ARE FOR AS-BUILT PURPOSES ONLY. NO IMPROVEMENTS OTHER THAN WATER AND SANITARY SEWER STRUCTURES WERE AS-BUILT OR INDICATED AS SUCH ON THE SUBJECT PLAN SET. UNDERGROUND PIPING WAS NOT LOCATED. LOCATION SHOWN IS APPROXIMATE BASED ON SURFACE FEATURES AND INFORMATION PROVIDED BY CONTRACTOR.