


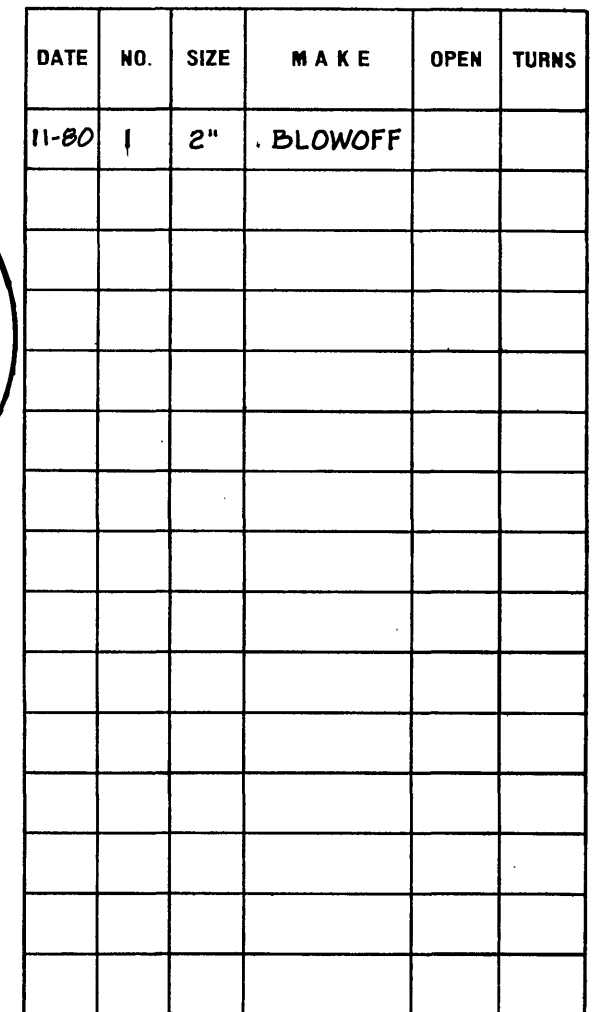

DATE EC. 15, 1980 PAGE NO.