


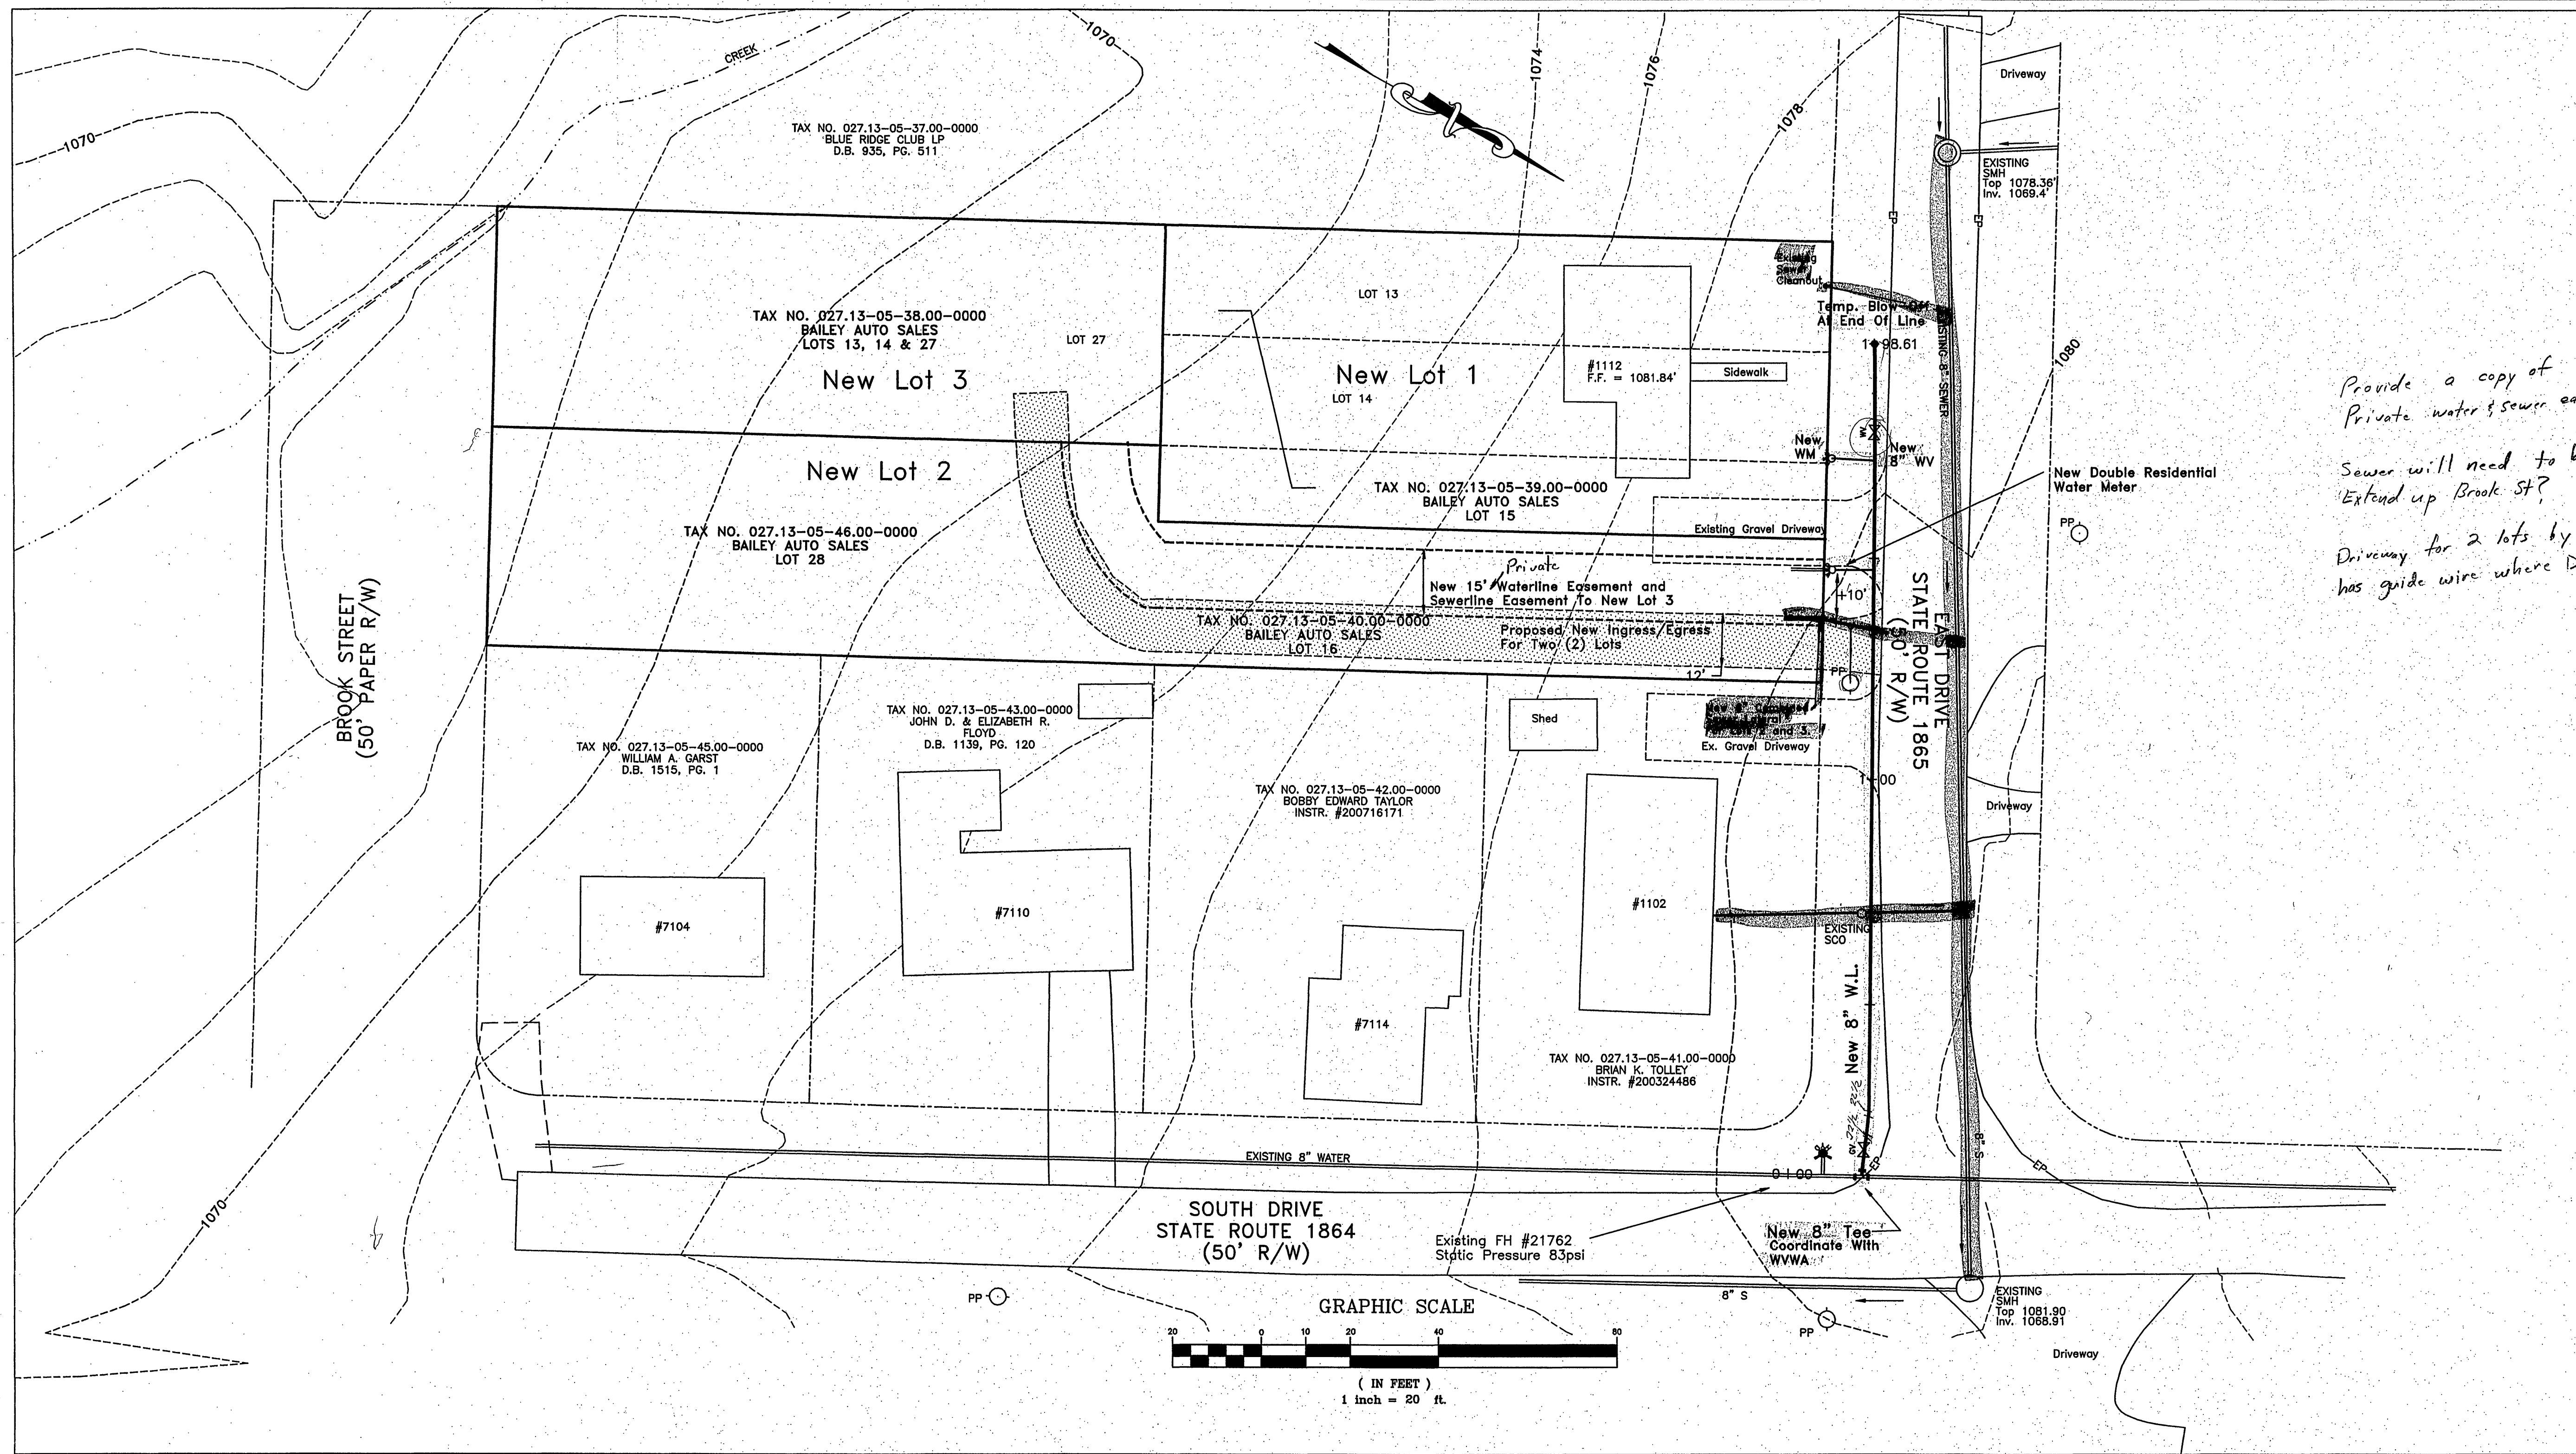

Provide a copy of
Private water & sewer easements
Sewer will need to be pumped.
Extend up Brook St?
Driveway for 2 lots by PP
has guide wire where DW proposed

DATE:	02/22/2010
REVISIONS	03/18/2010
	04/07/2010
	04/28/2011

**PIERSON
ENGINEERING
&
SURVEYING**


P.O. BOX 311
1324 ROANOKE ROAD
DALEVILLE, VA 24083

(540) 966-3027 TEL
(540) 966-5906 FAX
e-mail: rpierson@rcnet.com

WATERLINE EXTENSION PROJECT
FOR
BOBBY BAILEY
ROANOKE COUNTY, VIRGINIA

OVERVIEW SHEET

As-Built
4/24/2012

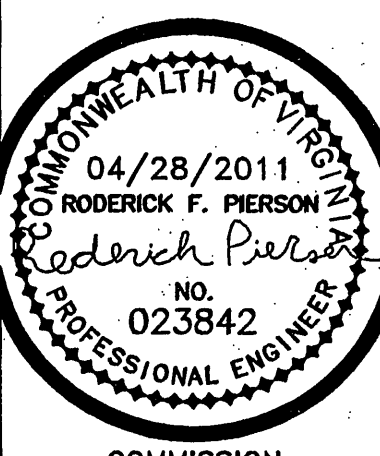

SHEET
1

