


LANDSCAPE MATERIAL

COMMON NAME	BOTANICAL NAME	QUANT.	SIZE	REMARKS
RED MAPLE 'RED SUNSET'	ACER RUBRUM	4	3'-3.5"	SPECIMAN
SERVICEBERRY 'AUTUMN BR.'	AMELANCHIER GRANDIFLORA	8	6'-7'	MULTI-STEM, IN MULCH BED
FLOWERING DOGWOOD	CORNUS FLORIDA	7	6'-7'	MULTI-STEM, IN MULCH BED
EASTERN REDBUD	CERCIS CANADENSIS	10	6'-7'	MULTI-STEM, IN MULCH BED
AMERICAN HOLLY 'GREENLEAF'	ILEX OPACA	7	6'-7'	SPECIMAN
LEYLAND CYPRESS	X CUPRESSOCYPARIS LEYLANDII	10	5'-6'	MATCHING, IN MULCH BED
NELLIE STEVENS HOLLY	ILEX 'NELLIE R. STEVENS'	7	6'-7'	SPECIMAN, FULL TO GROUND, 12' O.C.
DWARF NANDINA	NANDINA DOM. 'FIRE POWER'	64	3 gal.	SPACE 30" O.C.
SEDUM 'AUTUMN JOY'	DENNSTAEDIA PUNCTILOBULA	80	1 Qt.	SPACE 18" O.C.
RED SILVER GRASS	MISCANTHUS S. 'PURPURASCENS'	90	1 Qt.	SPACE 30" O.C.
BLACK EYED SUSAN 'GOLDSTURM'	RUDBEKIA 'GOLDSTURM'	90	1 Qt.	SPACE 24" O.C.
SHREDDED HARDWOOD MULCH		60	CY	



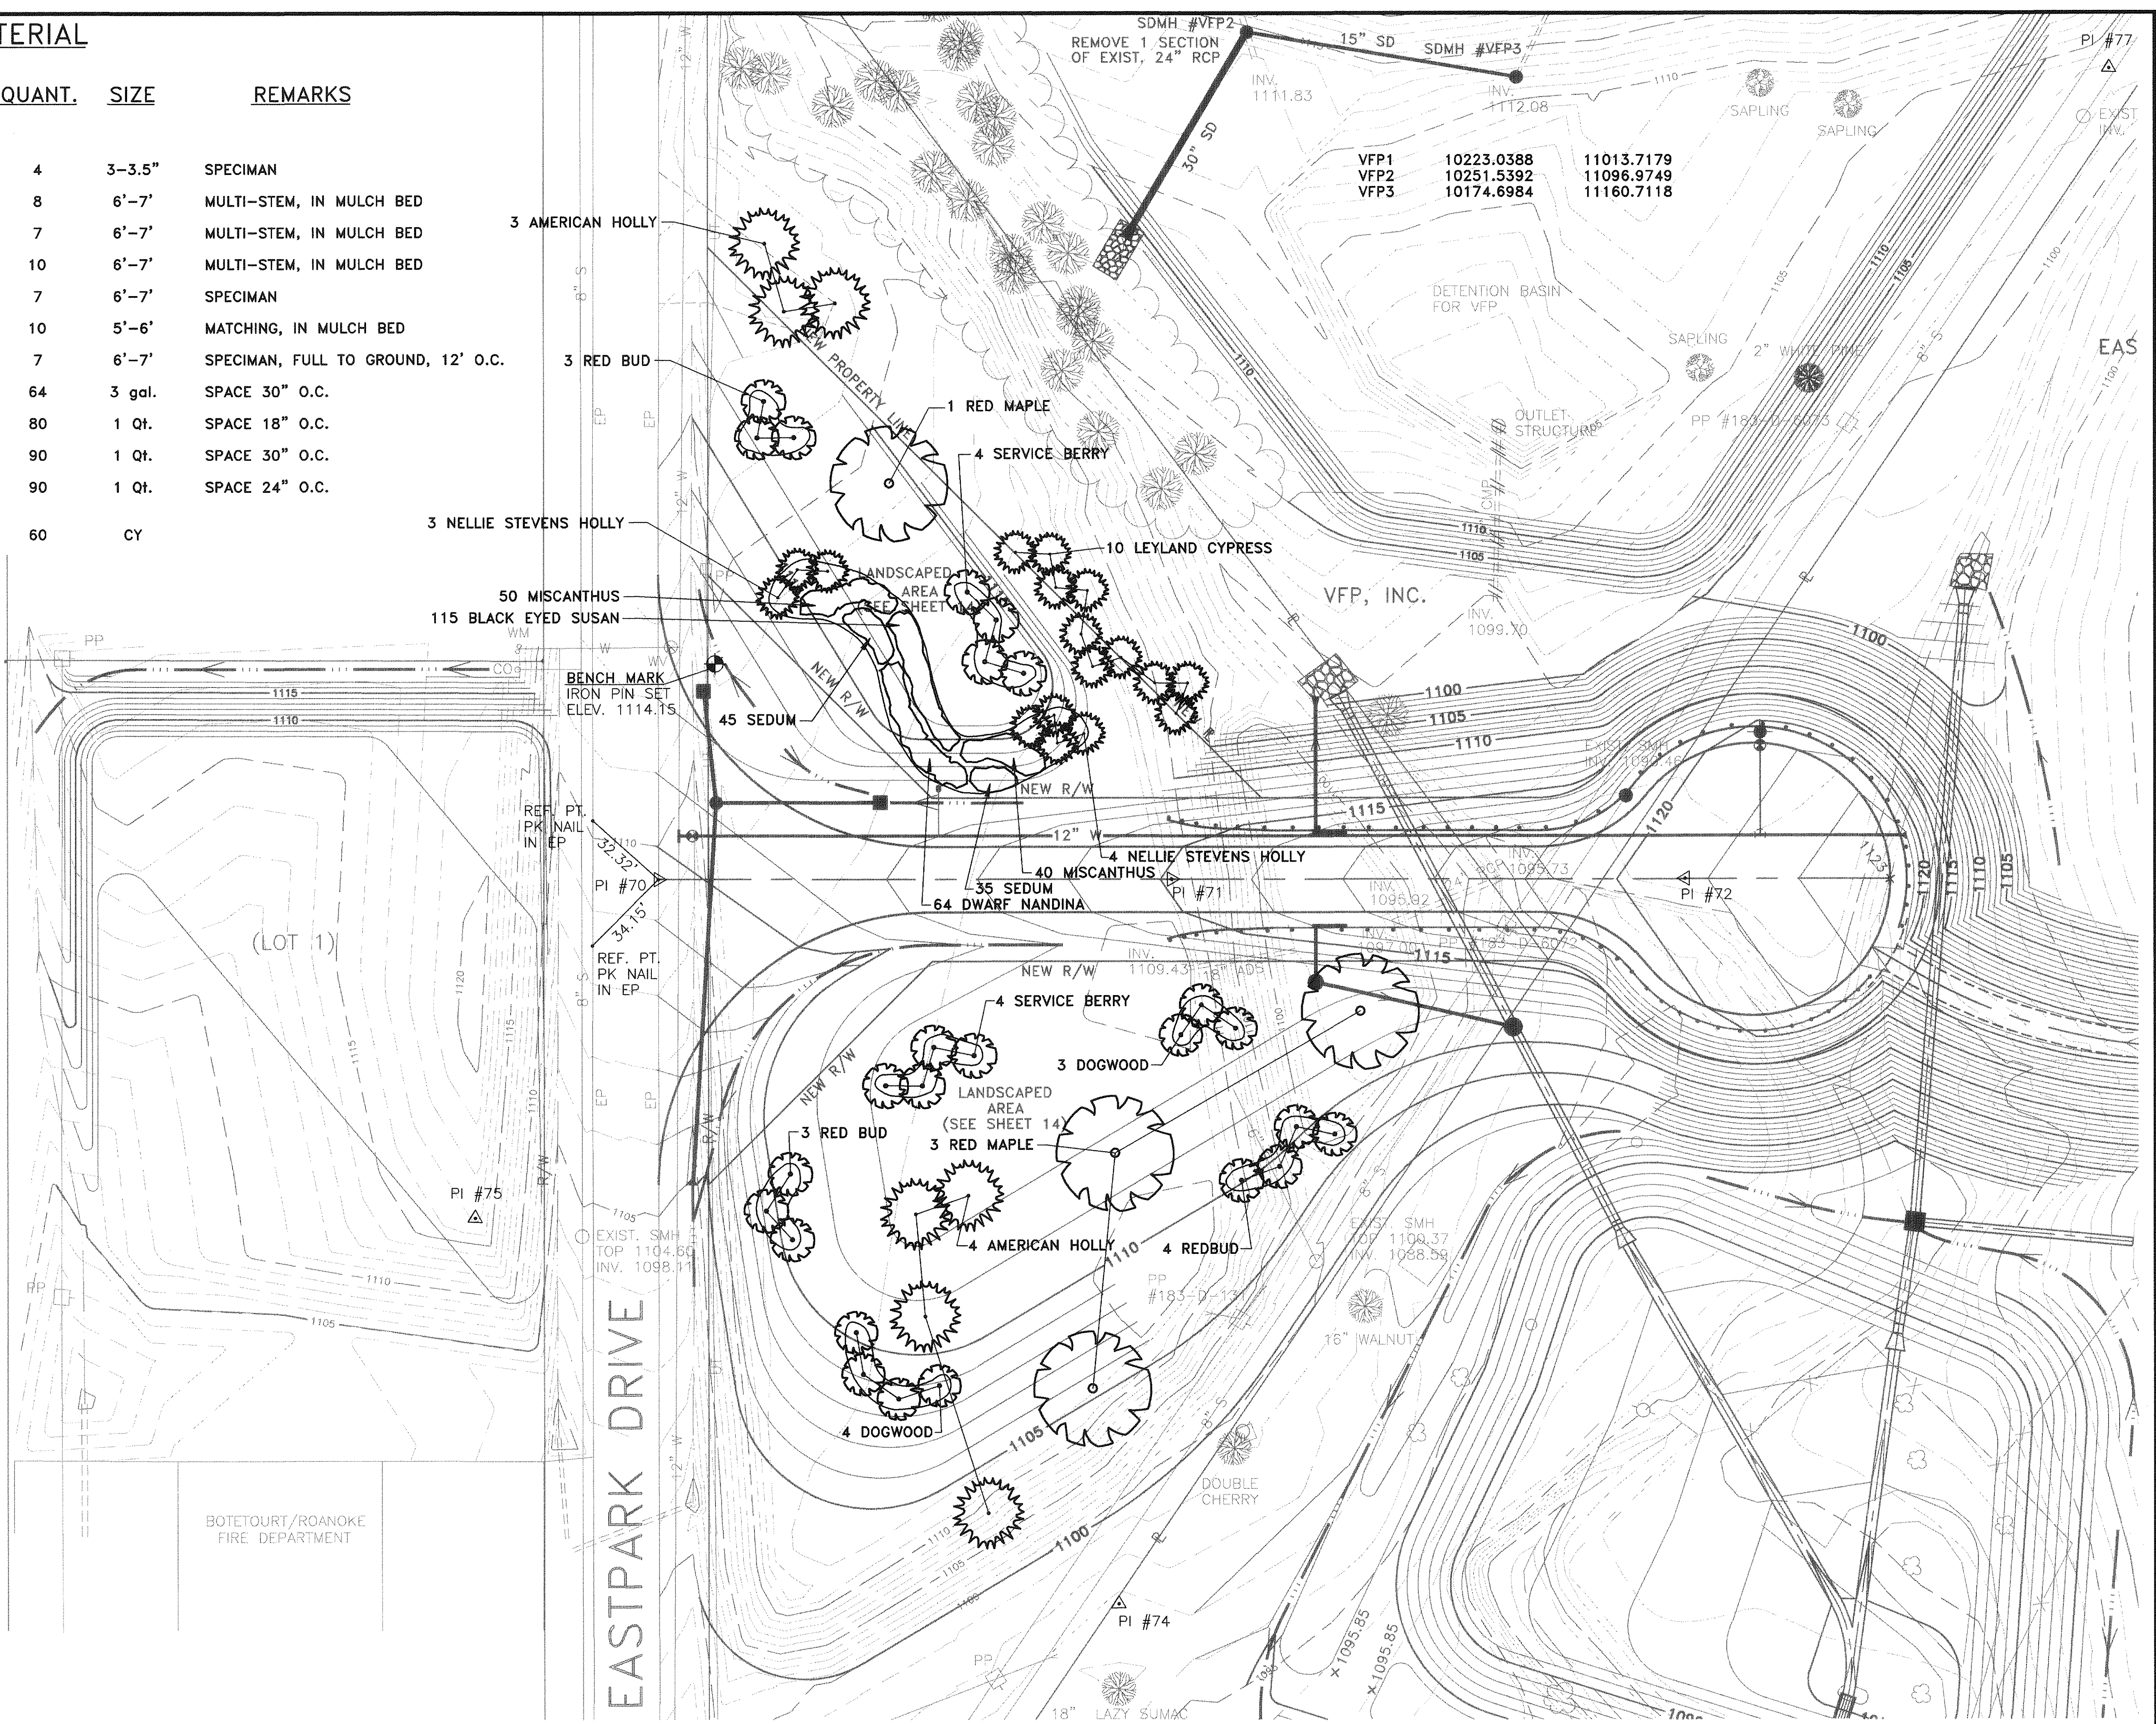

Mattern & Craig, Inc.
CONSULTING ENGINEERS • SURVEYORS
701 FIRST STREET, S.W.
ROANOKE, VIRGINIA 24016
(540) 345-9342
(540) 345-7691 FAX

DSGN	REV	DATE	DESCRIPTION	BY	APP
	1	NOV. 1997	RECORD DRAWINGS	DSG	
DRAWN					
CHKD					

EASTPARK COMMERCE CENTER - PHASE III
LANDSCAPE PLAN
BY WHITESELL ORRISON, INC.
BOTETOURT COUNTY, VIRGINIA

SCALE: 1"=30'

COMM. NO. 1034FD

DATE: FEB., 1997

SHEET 14 OF 14